


MONUMENT TIE MAP OF SYCAMORE RIDGE - UNIT 4


A PLANNED COMMUNITY AND COMMON INTEREST COMMUNITY
BEING A SUBDIVISION OF A PORTION OF LOT 3 IN BLOCK B OF "THE CROSSING AT SUMMERLIN VILLAGE 8 - UNIT NO. 3" AS SHOWN BY MAP THEREOF ON FILE IN BOOK 69, PAGE 99 OF PLATS IN THE CLARK COUNTY RECORDER'S OFFICE, CLARK COUNTY, NEVADA, LYING WITHIN SECTION 25, TOWNSHIP 20 SOUTH, RANGE 59 EAST, M.D.M., CITY OF LAS VEGAS, CLARK COUNTY, NEVADA

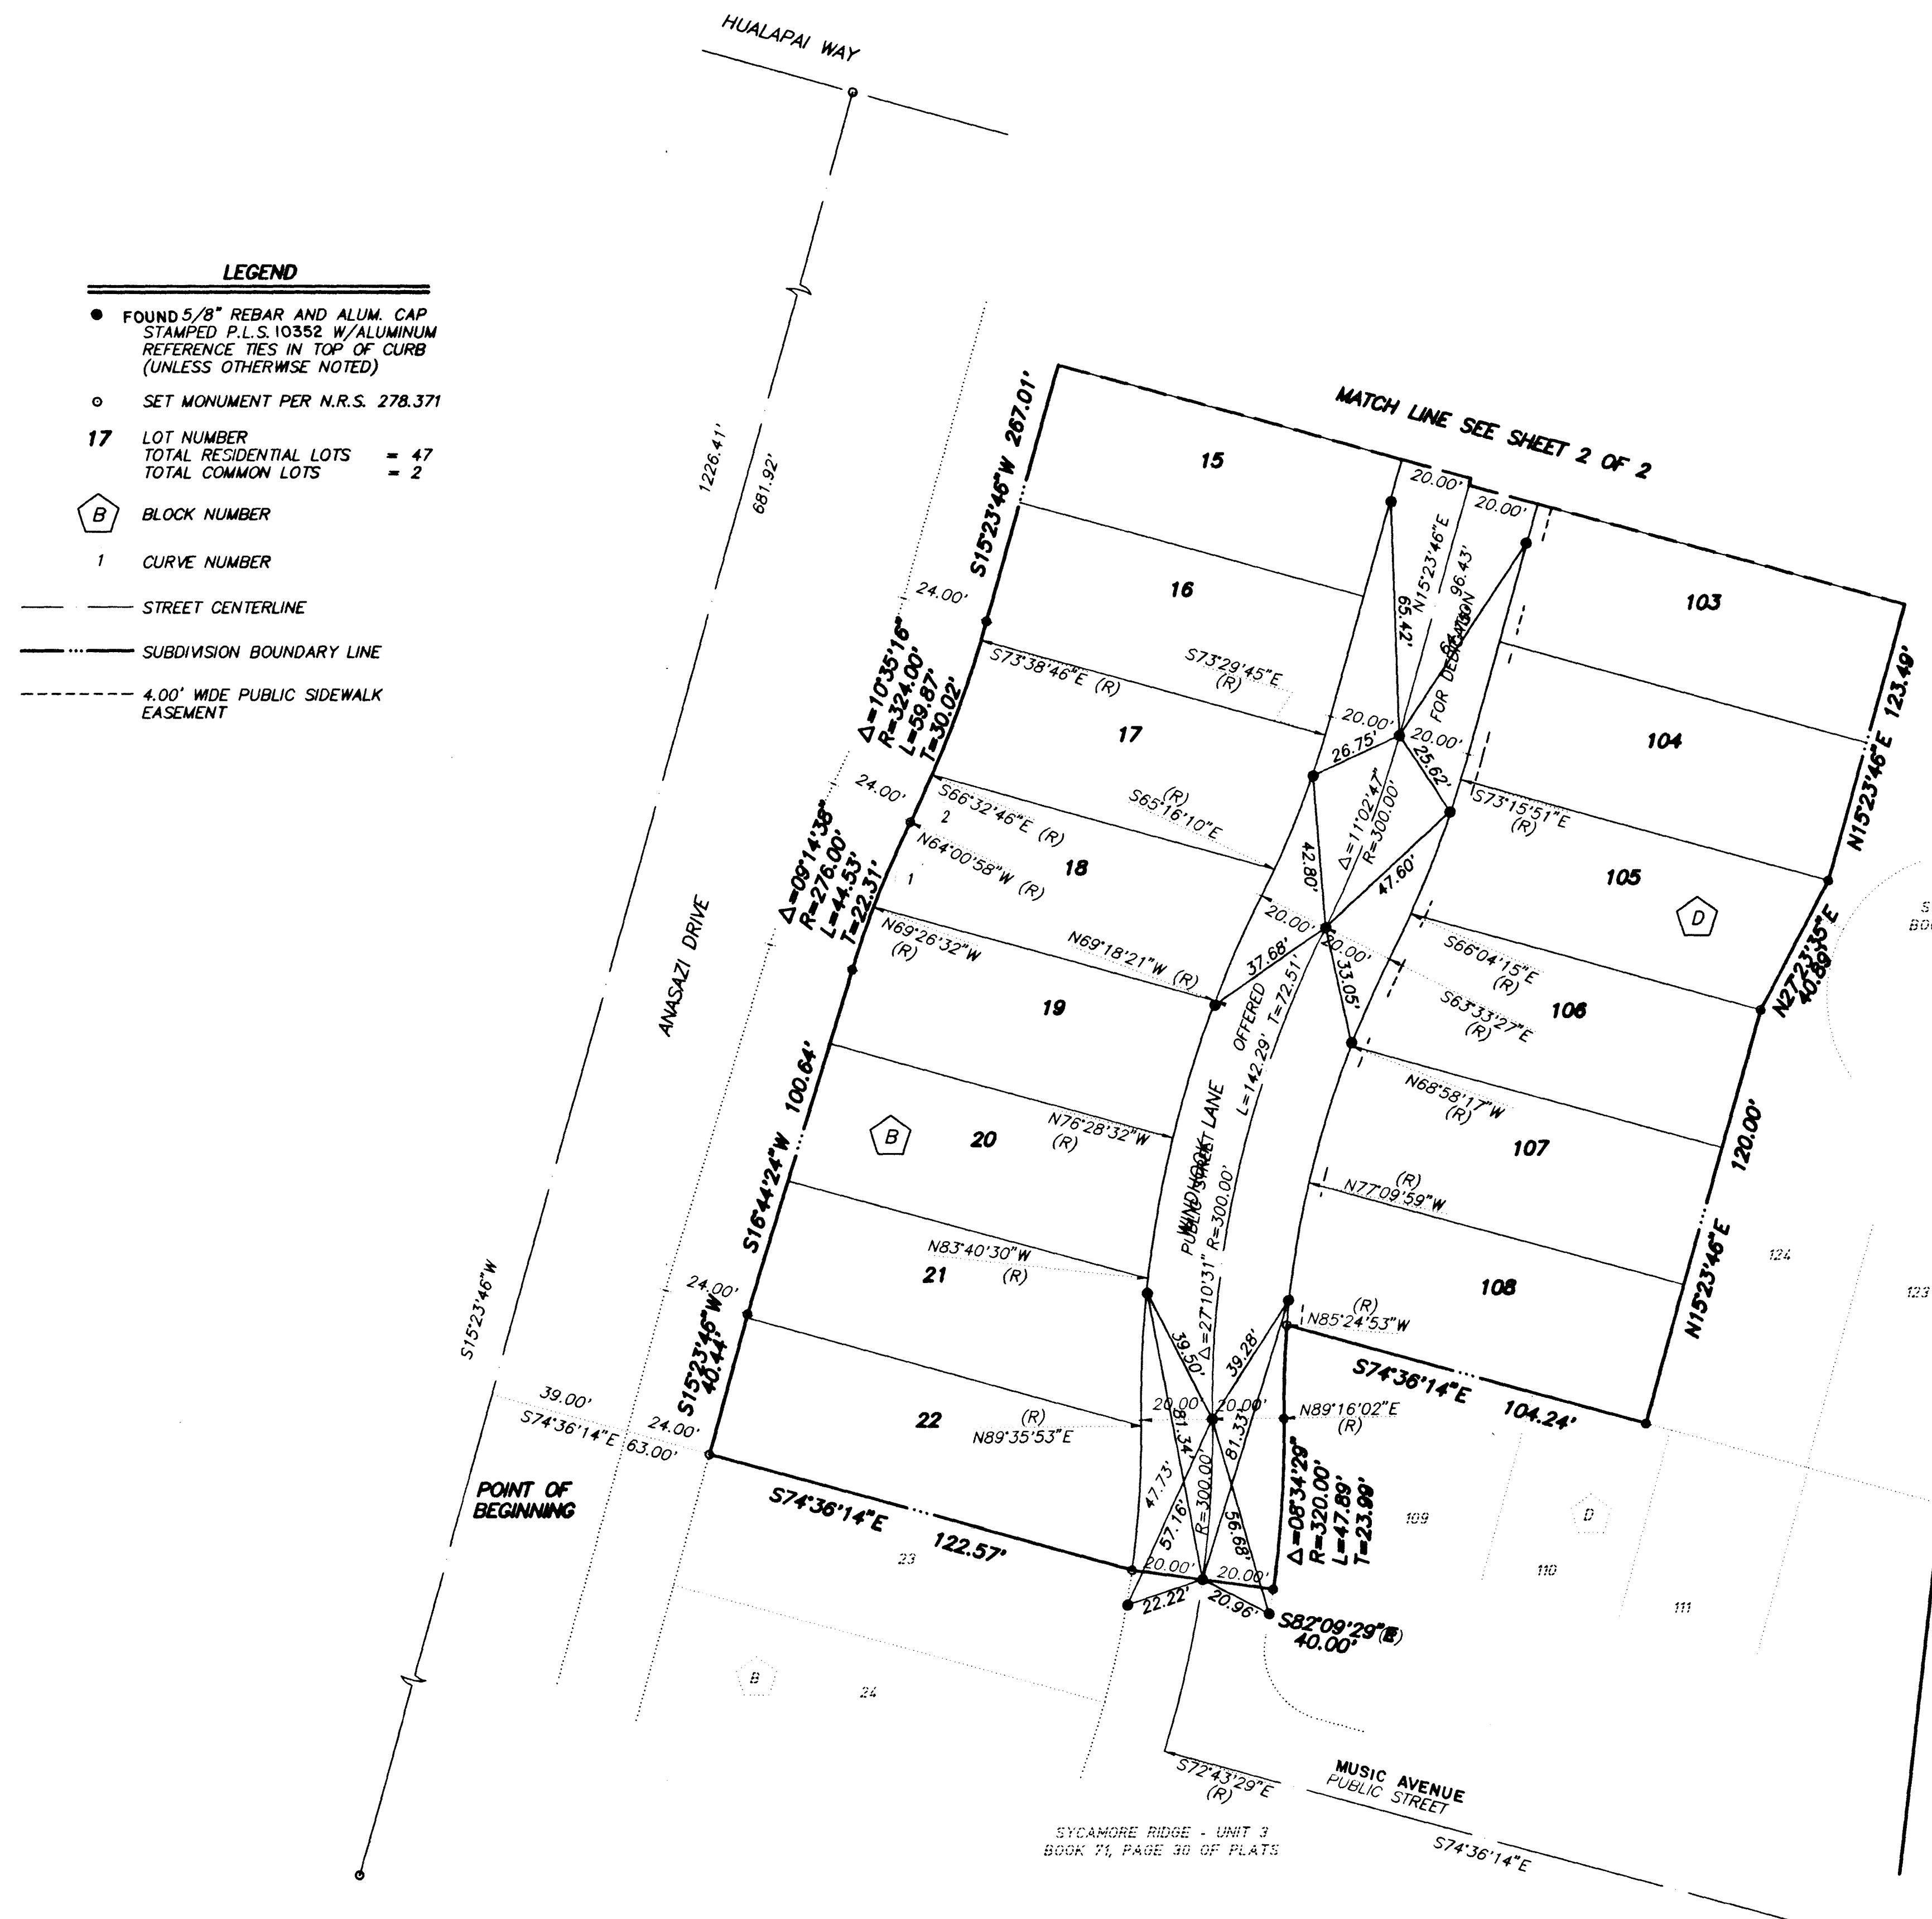

- LEGEND**
- FOUND 5/8" REBAR AND ALUM. CAP STAMPED P.L.S. 10352 W/ALUMINUM REFERENCE TIES IN TOP OF CURB (UNLESS OTHERWISE NOTED)
 - SET MONUMENT PER N.R.S. 278.371
 - 17 LOT NUMBER
TOTAL RESIDENTIAL LOTS = 47
TOTAL COMMON LOTS = 2
 - B BLOCK NUMBER
 - 1 CURVE NUMBER
 - STREET CENTERLINE
 - SUBDIVISION BOUNDARY LINE
 - 4.00' WIDE PUBLIC SIDEWALK EASEMENT

SURVEYOR'S CERTIFICATE

I, STEPHEN P. GATES, A PROFESSIONAL LAND SURVEYOR REGISTERED IN THE STATE OF NEVADA, DO HEREBY CERTIFY THAT THE TIE MONUMENTS HAVE BEEN SET AND THE TIE DISTANCES ESTABLISHED AS SHOWN HEREON. THIS SURVEY WAS COMPLETED ON AUGUST 25, 1999

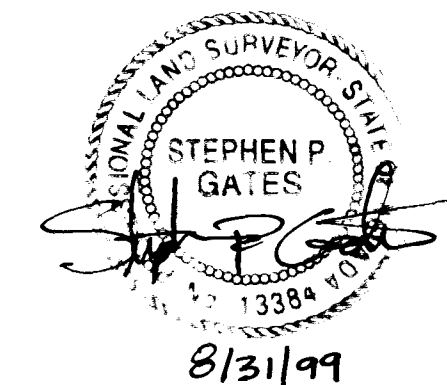

STEPHEN P. GATES
PROFESSIONAL LAND SURVEYOR
CERTIFICATE NO. 13384

NOTE

FOR SIDE PROPERTY LINES: SET CONCRETE NAIL AND BRASS TAG STAMPED PLS 10352 IN THE REAR WALL ALONG THE PROPERTY LINE PROJECTED. SET SAWCUT IN THE BACK OF CURB AT THE FRONT OF THE LOT ON THE PROPERTY LINE PROJECTED. SET HUB AND TACK WHERE THERE IS NO BLOCK WALL

A PLANNED COMMUNITY AND COMMON INTEREST COMMUNITY

BEING A SUBDIVISION OF A PORTION OF LOT 3 IN BLOCK 8 OF "THE CROSSING AT SUMMERLIN VILLAGE 8 - UNIT NO. 3" AS SHOWN BY MAP THEREOF ON FILE IN BOOK 63, PAGE 99 OF PLATS IN THE CLARK COUNTY RECORDERS' OFFICE, CLARK COUNTY, NEVADA, LYING WITHIN SECTION 25, TOWNSHIP 20 SOUTH, RANGE 04 EAST, M.D.M., CITY OF LAS VEGAS, CLARK COUNTY, NEVADA



LETTERS TO THE EDITOR, A PROFESSIONAL AND PERSONAL JOURNAL OF THE
JOURNAL OF THE AMERICAN SOCIETY OF CLIMATE ENGINEERS, MAY BE SUBMITTED TO THE
JOURNAL OF THE AMERICAN SOCIETY OF CLIMATE ENGINEERS, MAY BE SUBMITTED TO THE



STEWART & SUTHER
PROFESSIONAL LAND SURVEYORS
CHICAGO, ILL.

[illegible]