


MONUMENT TIE MAP OF SYCAMORE RIDGE — UNIT 4

A PLANNED COMMUNITY AND COMMON INTEREST COMMUNITY
BEING A SUBDIVISION OF A PORTION OF LOT 3 IN BLOCK B OF "THE CROSSING AT SUMMERLIN VILLAGE 8 — UNIT NO. 3"
AS SHOWN BY MAP THEREOF ON FILE IN BOOK 69, PAGE 99 OF PLATS IN THE CLARK COUNTY RECORDER'S OFFICE, CLARK COUNTY, NEVADA,
LYING WITHIN SECTION 25, TOWNSHIP 20 SOUTH, RANGE 59 EAST, M.D.M.,
CITY OF LAS VEGAS, CLARK COUNTY, NEVADA

NOTE
ALL COMMON LOTS SHOWN AND/OR
DESCRIBED ON THIS FINAL MAP SHALL
BE MAINTAINED BY THE SUMMERLIN
COMMUNITY ASSOCIATES

NOTE
FOR SIDE PROPERTY LINES: SET CONCRETE NAIL AND
BRASS TAG STAMPED PLS 10352 IN THE REAR WALL ALONG
THE PROPERTY LINE PROJECTED. SET SAWCUT IN THE
BACK OF CURB AT THE FRONT OF THE LOT ON THE
PROPERTY LINE PROJECTED. SET HUB AND TACK
WHERE THERE IS NO BLOCK WALL

SCALE: 1" = 30'

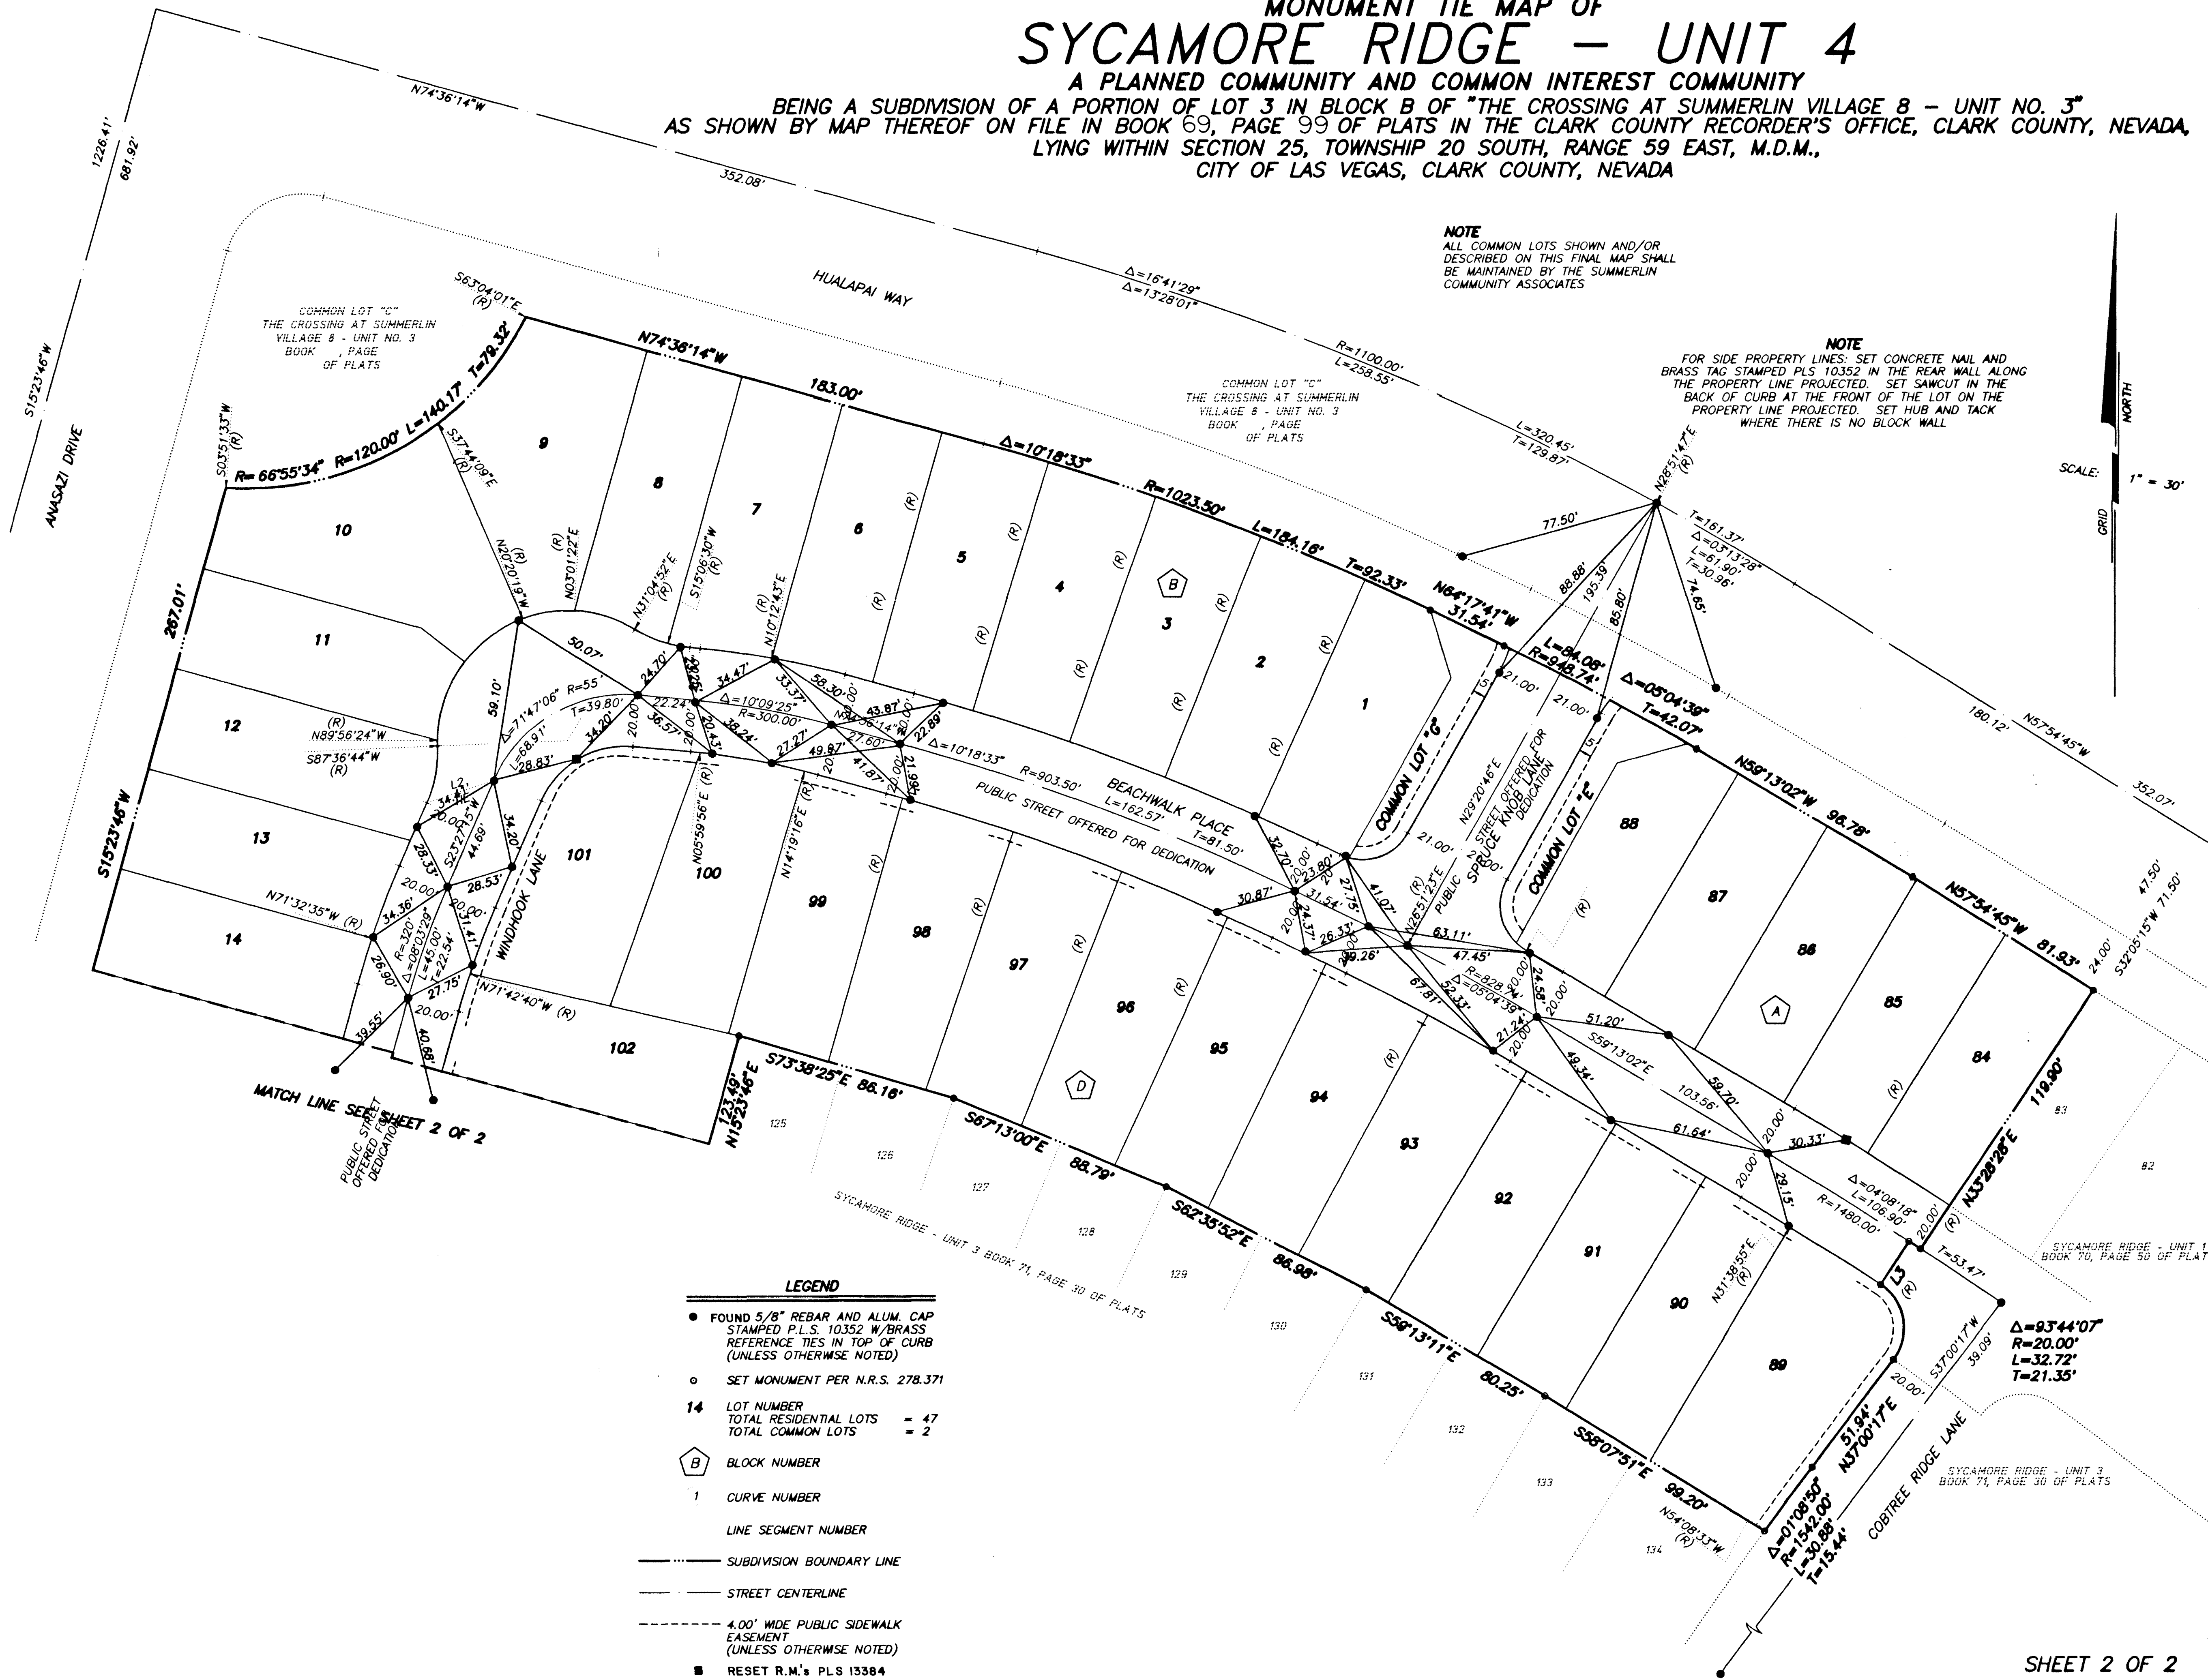

LEGEND

- FOUND 5/8" REBAR AND ALUM. CAP
STAMPED PLS. 10352 W/BRASS
REFERENCE TIES IN TOP OF CURB
(UNLESS OTHERWISE NOTED)
- SET MONUMENT PER N.R.S. 278.371
- 14 LOT NUMBER
TOTAL RESIDENTIAL LOTS = 47
TOTAL COMMON LOTS = 2
- B BLOCK NUMBER
- 1 CURVE NUMBER
- LINE SEGMENT NUMBER
- SUBDIVISION BOUNDARY LINE
- STREET CENTERLINE
- 4.00' WIDE PUBLIC SIDEWALK
EASEMENT
(UNLESS OTHERWISE NOTED)
- RESET R.M.'s PLS 13384

SHEET 2 OF 2

SYCAMORE RIDGE - UNIT 4

A PLANNED COMMUNITY AND COMMON INTEREST COMMUNITY
BEING A SUBDIVISION OF A PORTION OF LOT 3 IN BLOCK 8 OF THE CROSSING AT SUMMERLIN VILLAGE II - UNIT NO. J
AS SHOWN BY MAP THEREON ON FILE IN BOOK 858, PAGE 1915 OF PLATS IN THE CLARK COUNTY RECORDERS' OFFICE, CLARK COUNTY, NEVADA,
LYING WITHIN THE SECTION 20, TOWNSHIP 20 SOUTH, RANGE 22 EAST, N.E.1/4,
CITY OF LAS VEGAS, CLARK COUNTY, NEVADA

