


SUMMERLIN

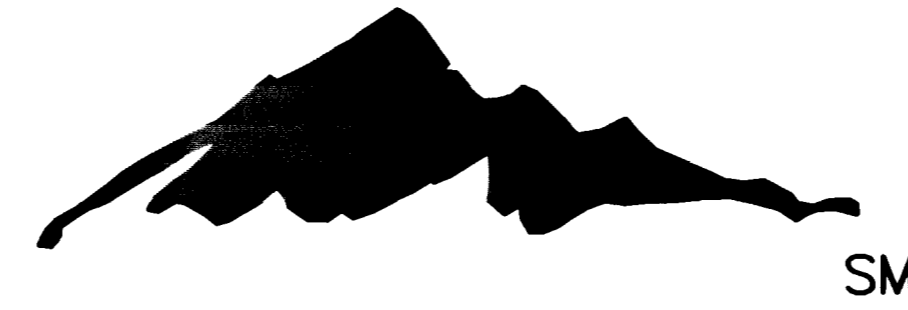

VILLAGE 3 ALTA DRIVE IMPROVEMENTS FROM TOWN CENTER DRIVE TO HUALAPAI WAY 1996


DEVELOPER

HOWARD HUGHES PROPERTIES,
LIMITED PARTNERSHIP, a
Delaware limited partnership.
By its sole general partner,
The HOWARD HUGHES CORPORATION,
a Delaware Corporation.

1645 VILLAGE CENTER CIRCLE, SUITE 200
LAS VEGAS, NEVADA 89134
OFFICE PHONE NO. 791-4300
OFFICE FAX NO. 791-4450

RECORD DRAWINGS
THESE PLANS SHOW RECORD INFORMATION RECEIVED FROM:
CONTRACTOR: WELLS CARGO, INC. (WET UTILITY IMP.) 3/2/98
CONTRACTOR: WELLS CARGO, INC. (ROADWAY IMPROVEMENTS) 3/2/98
THIS DATA MAY OR MAY NOT REFLECT THE ACTUAL FIELD LOCATIONS.
ALL DATA SHOULD BE CONFIRMED PRIOR TO USE ON DEVELOPMENT OR
ENGINEERING PLANS.

ENGINEER

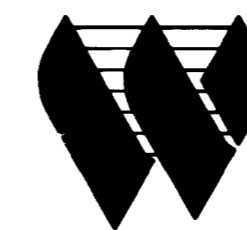

G.C. WALLACE, INC.
Engineering/Architecture
1555 SOUTH RAINBOW BLVD./LAS VEGAS, NEVADA 89102

2. 3/16/98 ADD RECORD DRAWING INFO.
1. 06/05/96 REVISE SEWER FROM 18" TO 21". ADD SEWER MANHOLE, REVISE
WATER LATERAL LOCATIONS AND ADD IRRIGATION SLEEVES
bbj/lc/gc

ISSUE FOR CONSTRUCTION MAY 28, 1996
VILLAGE 3 ALTA DRIVE IMPROVEMENTS - FROM TOWN CENTER DRIVE TO HUALAPAI WAY

SHEET 1 OF 16

JOB NO. 82003.207

S.T.S., ALTA-GOV.DWG, 04/12/96

714

S.I.D. 707 PROJECT NO. 8B, 8C, 8D 107-V2509

SUMMERLIN



VILLAGE 3

ALTA DRIVE IMPROVEMENTS FROM TOWN CENTER DRIVE TO HUALAPAI WAY

1996

DEVELOPER

HOWARD HUGHES PROPERTIES,
LIMITED PARTNERSHIP, a
Delaware limited partnership.

By its sole general partner,
The HOWARD HUGHES CORPORATION,
a Delaware Corporation.

3645 VILLAGE CENTER CIRCLE, SUITE 300
LAS VEGAS, NEVADA 89154
OFFICE PHONE NO. 709-43200
OFFICE FAX NO. 709-44450



ENGINEER



G.C. WALLACE, INC.
Engineering/Architecture

1200 SOUTH HANSEN BLVD., LAS VEGAS, NEVADA 89102

SHEET 1 OF 16