
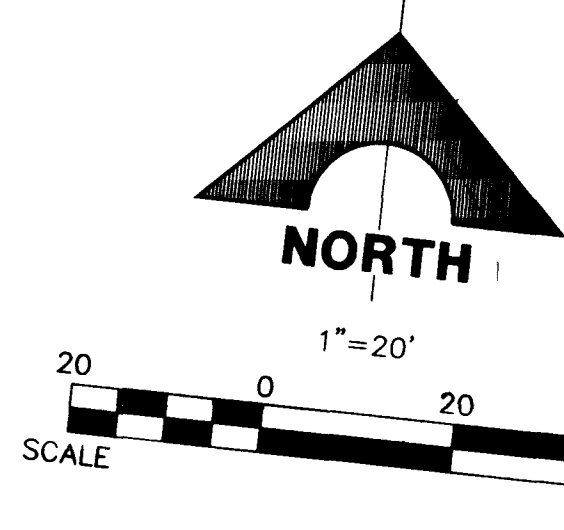


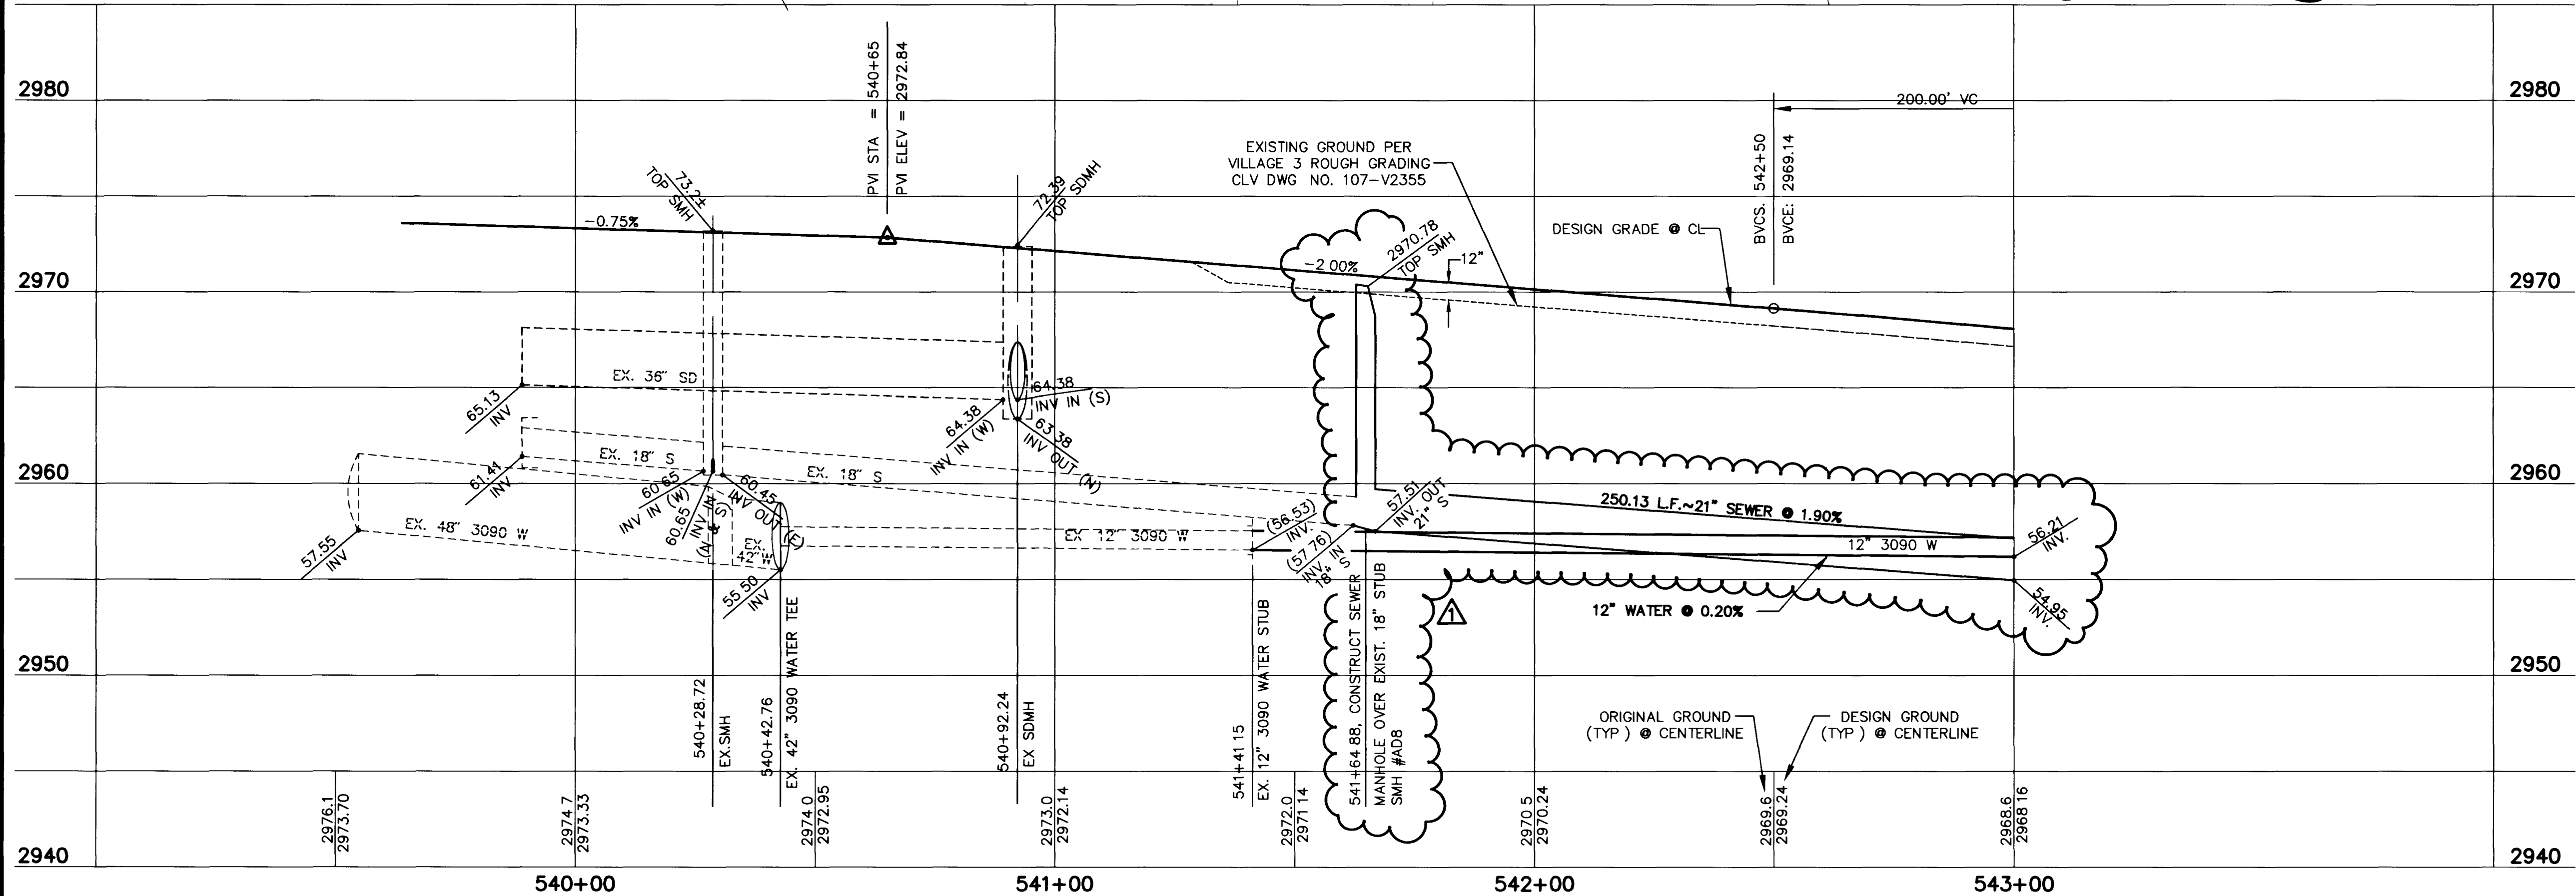

RECORD DRAWINGS

THESE PLANS SHOW RECORD INFORMATION RECEIVED FROM:
 CONTRACTOR: WELLS, CARGO, INC. (WET UTILITY IMP.) 3/2/98
 CONTRACTOR: WELLS, CARGO, INC. (ROADWAY IMPROVEMENTS) 3/2/98

THIS DATA MAY OR MAY NOT REFLECT THE ACTUAL FIELD LOCATIONS.
 ALL DATA SHOULD BE CONFIRMED PRIOR TO USE ON DEVELOPMENT OR
 ENGINEERING PLANS.

- CONSTRUCTION NOTES**
- IMPROVEMENTS**
1. INSTALL "A" TYPE CURB (S-50 S)
 2. INSTALL "L" TYPE CURB & GUTTER (S-47 S)
 3. INSTALL 4" A.C. PAVEMENT OVER 8" TYPE II BASE (S-78 S)
 4. INSTALL CROSSWALK (A 13)
 5. INSTALL DEPRESSED CURB (A 13)
- WATER**
1. W INSTALL 12" DIA. WATER PIPE (U-20 S)
 2. W INSTALL 8" DIA. WATER PIPE (U-20 S)
 3. W INSTALL 12" DIA. GATE VALVE & BOX (U-34 S)
 4. W INSTALL 16" DIA. GATE VALVE & BOX (U-34 S)
 5. W INSTALL 2" TEMP. BLOW-OFF (U-32 S)
- STORM DRAIN** - ALL S.D. PIPE CLASS 1350-D
1. SD INSTALL 24" DIA. STORM DRAIN PIPE (U-20 S)
 2. SD INSTALL 30" DIA. STORM DRAIN PIPE (U-20 S)
 3. SD INSTALL 36" DIA. STORM DRAIN PIPE (U-20 S)
 4. SD INSTALL 54" DIA. STORM DRAIN PIPE (U-20 S)
 5. SD INSTALL 60" DIA. STORM DRAIN PIPE (U-20 S)
 6. SD INSTALL STORM DRAIN MANHOLE (D1.D5 S)
 7. SD INSTALL 6" TYPE "A" DROP INLET (D-12 S)
- SEWER**
1. S INSTALL 8" DIA. SEWER PIPE (U-20 S)
 2. S INSTALL 60" DIA. SEWER MANHOLE (SD1-B CLV)
 3. S INSTALL 21" DIA. SEWER PIPE (U-20 S)
- STREET LIGHTING**
1. SL INSTALL STREET LIGHT, SEE ELECTRICAL PLANS (E-2 S)
 2. SL STREET LIGHT OR COMMON TRENCH, SEE ELECTRICAL PLANS
- TRAFFIC**
1. S/G INSTALL 1-3" CONDUIT
 2. S/G INSTALL NO. 5 PULLBOX (E-32 S)
- IRRIGATION**
1. IR BANK 'A': 1-6" & 2-4" SLEEVES SDR 35 PVC (U-18 S)
 2. IR BANK 'B': 2-4" SLEEVES SDR 35 PVC
 3. IR BANK 'C': 1-6" & 3-4" SLEEVES SDR 35 PVC
- NOTE: ALL COMMON LOTS AS SHOWN HEREIN TO BE PRIVATELY MAINTAINED BY THE H.O.A.
- SHEET INDEX MAP**
-

APPROVAL:
 1ST 111 2 2/22/96
 LAS VEGAS VALLEY WATER DISTRICT
 DATE 4/06/96

RECOMMENDATION

RECOMMENDED BY: [Signature]
 DATE: 4/06/96

APPROVAL

APPROVED BY: [Signature]
 DATE: 4/06/96

PROJECT INFORMATION

PROJECT: SUMMERLIN
 ALTA DRIVE - TOWN CENTER DR. TO HUALAPAI
 PLAN & PROFILE
 641+36.15 TO 643+00

REVISIONS

NO.	DATE	DESCRIPTION
1	3/14/96	ADD RECORD DRAWING INFO
2	06/05/98	REVISE SEWER FROM 18" TO 21" AND
3	7/21/96	ADD SEWER MANHOLE

DATE 4/06/96

APPROVAL

SHEET 5 OF 16

