


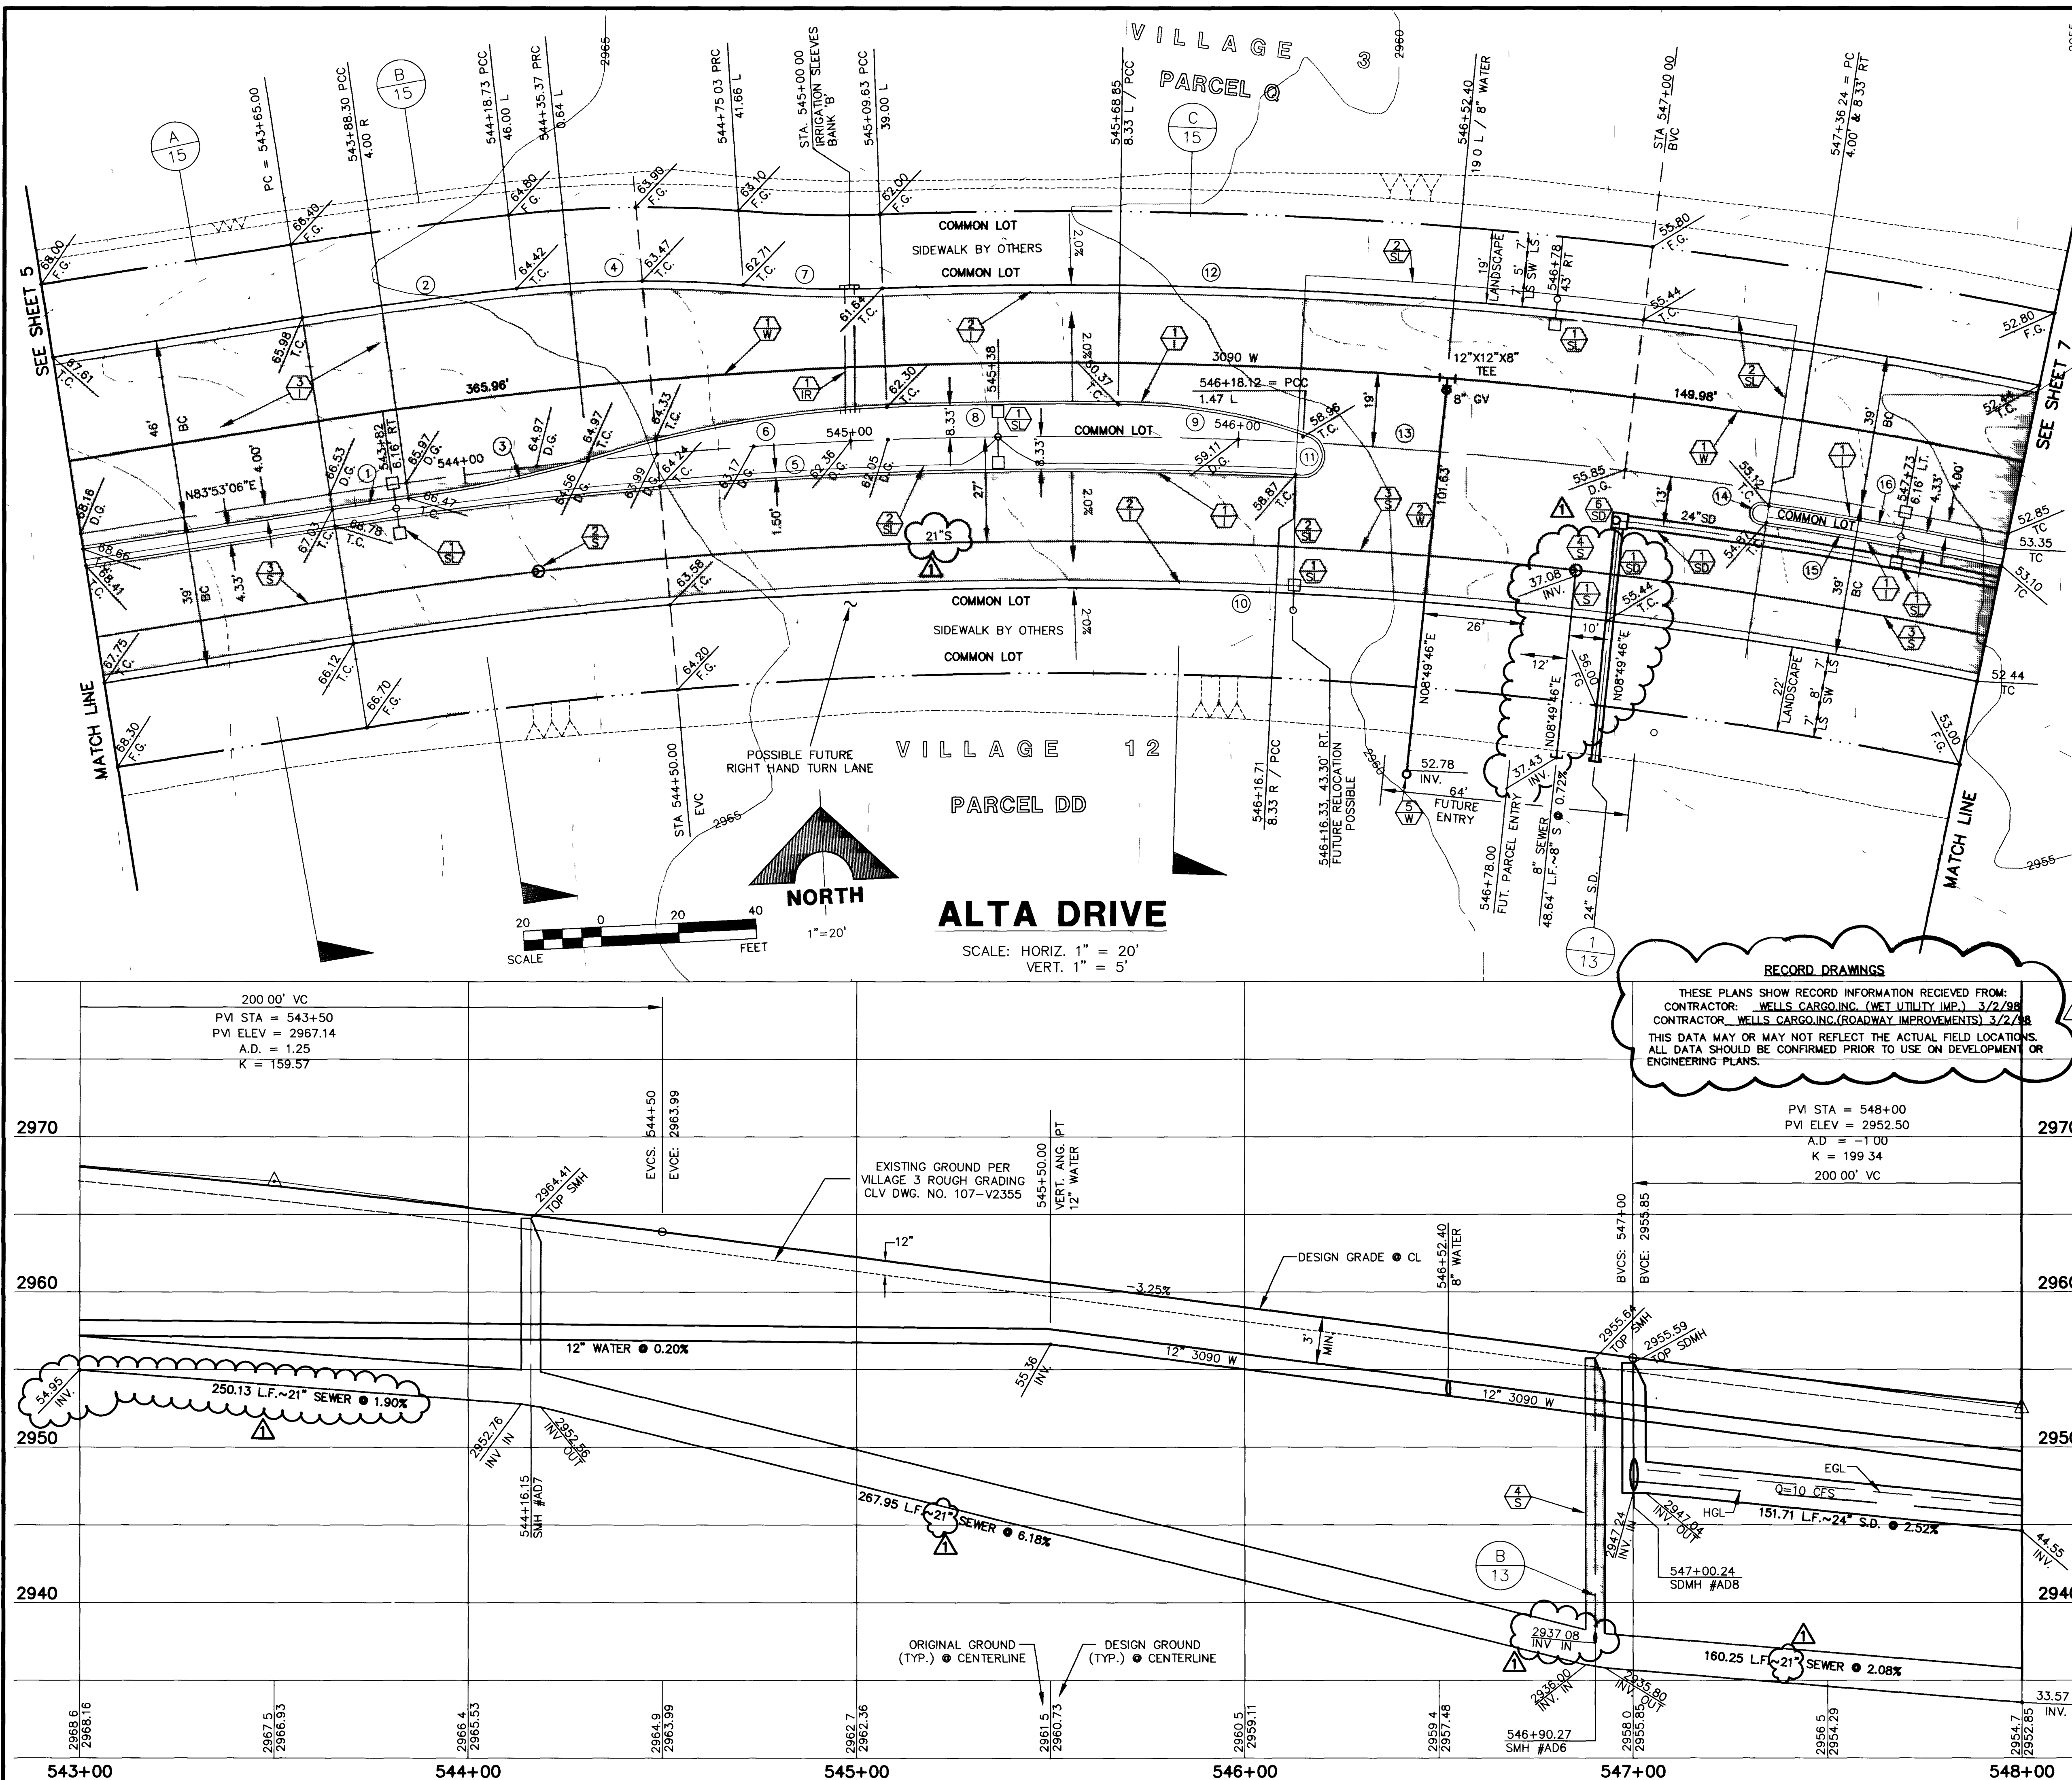

CURVE DATA

① INDICATES CURVE NUMBER

CURVE	DELTA	RADIUS	LENGTH	TANGENT
1	07°36'45"	1196.00	23.27'	11.61'
2	02°33'54"	1246.00	53.76'	27.89'
3	09°01'47"	300.00	47.28'	23.69'
4	11°11'37"	300.00	58.61'	29.40'
5	11°51'08"	1191.67	249.98'	125.44'
6	14°58'49"	300.00	78.44'	39.44'
7	06°51'11"	300.00	35.88'	17.96'
8	02°44'36"	1208.33	57.86'	28.93'
9	18°34'27"	150.00	48.63'	24.53'
10	20°45'52"	1161.00	420.76'	212.71'
11	16°38'21"	5.00	14.28'	34.78'
12	13°52'57"	1239.00	299.90'	150.69'
13	20°48'10"	1200.00	424.98'	219.91'
14	18°00'00"	2.17	6.82'	---
15	03°02'36"	1191.67	63.30'	31.66'
16	03°02'37"	1196.00	63.53'	31.77'

CONSTRUCTION NOTES

IMPROVEMENTS

- ① INSTALL "A" TYPE CURB (S-50 S)
- ② INSTALL "L" TYPE CURB & GUTTER (S-47 S)
- ③ INSTALL 4" A.C. PAVEMENT OVER 8" TYPE II BASE
- ④ INSTALL CROSSWALK (S-78 S)
- ⑤ INSTALL DEPRESSED CURB (A-13)

WATER

- ① W INSTALL 12" DIA. WATER PIPE (U-20 S)
- ② W INSTALL 8" DIA. WATER PIPE (U-20 S)
- ③ W INSTALL 12" DIA. GATE VALVE & BOX (U-34 S)
- ④ W INSTALL 16" DIA. GATE VALVE & BOX (U-34 S)
- ⑤ W INSTALL 2" TEMP. BLOW-OFF (U-32 S)

STORM DRAIN - ALL S.D. PIPE CLASS 1350-D

- ① SD INSTALL 24" DIA. STORM DRAIN PIPE (U-20 S)
- ② SD INSTALL 30" DIA. STORM DRAIN PIPE (U-20 S)
- ③ SD INSTALL 36" DIA. STORM DRAIN PIPE (U-20 S)
- ④ SD INSTALL 54" DIA. STORM DRAIN PIPE (U-20 S)
- ⑤ SD INSTALL 60" DIA. STORM DRAIN PIPE (U-20 S)
- ⑥ SD INSTALL STORM DRAIN MANHOLE (D-2 S)
- ⑦ SD INSTALL 6" TYPE "A" DROP INLET (D-12 S)

SEWER

- ① S INSTALL 8" DIA. SEWER PIPE (U-20 S)
- ② S INSTALL 60" DIA. SEWER MANHOLE (SDI-B CLV)
- ③ S INSTALL 21" DIA. SEWER PIPE (U-20 S)
- ④ S INSTALL 60" DIA. T-LOCK PVC LINED PRECAST MANHOLE

STREET LIGHTING

- ① SL INSTALL STREET LIGHT, SEE ELECTRICAL PLANS (E-2 S)
- ② SL STREET LIGHT OR COMMON TRENCH, SEE ELECTRICAL PLANS


TRAFFIC

- ① SIF INSTALL 1-3" CONDUIT
- ② SIF INSTALL NO. 5 PULLBOX (E-32 S)

IRRIGATION

- ① IB BANK 'A'. 1-6" & 2-4" SLEEVES SDR 35 PVC (U-18 S)
- BANK 'B'. 2-4" SLEEVES SDR 35 PVC
- BANK 'C'. 1-6" & 3-4" SLEEVES SDR 35 PVC

NOTE: ALL COMMON LOTS AS SHOWN HEREIN TO BE PRIVATELY MAINTAINED BY THE H.O.A.

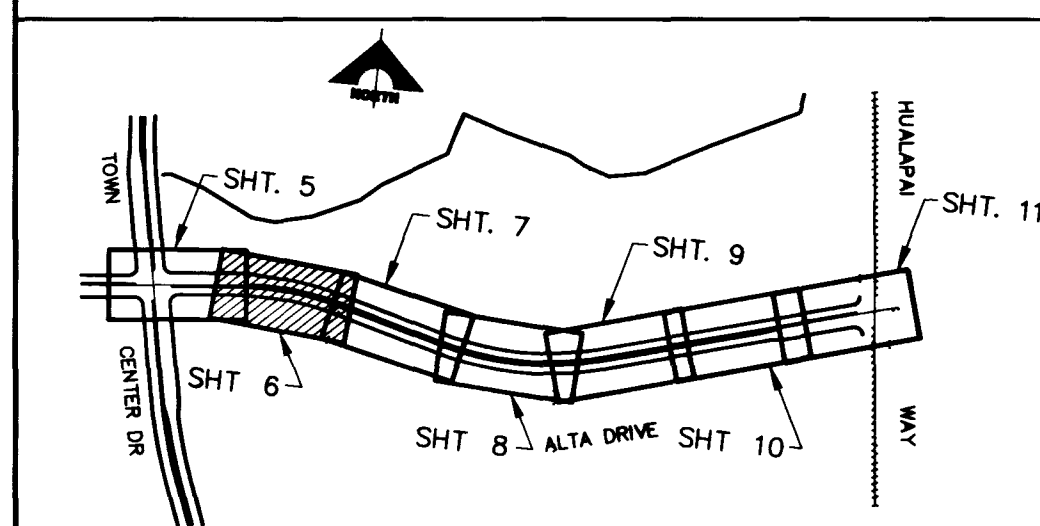

SHEET INDEX MAP

APPROVAL:

1ST APP - 2/22/96

LAS VEGAS VALLEY WATER DISTRICT

4/06/96

SHEET

6

SHT 6 OF 16

G.C. WALLACE, INC.
Engineering/Architecture
1535 SOUTH HANDEY BLVD./LAS VEGAS, NEVADA 89102

SUMMERLIN
ALTA DRIVE
ALTA DR. - TOWN CENTER DR. TO HUALAPAI
PLAN & PROFILE
643+00 TO 648+00

