


**G.C. WALLACE, INC.** Engineering/Architecture  
 MAIN 1555 SOUTH RAINBOW BLVD LAS VEGAS, NV 89102 (702) 363-1200  
 SUMMERLIN 1645 VILLAGE CENTER CIR LAS VEGAS, NV 89134 SUITE #181 (702) 363-0991

**DRAWING CHANGE NOTICE:** DATE: 09/04/96  
 PROJECT NAME: VILLAGE 3 ALTA DRIVE (HUALAPAI WAY TO TOWN CENTER DRIVE) - SID PROJECT 707  
 JOB NO. 62003.207  
 DCN NO. V3AD-02  
 AGENCY NO. 107-V2509

GCW APPROVAL \_\_\_\_\_ DATE \_\_\_\_\_  
 SUMMERLIN APPROVAL \_\_\_\_\_ DATE \_\_\_\_\_ AGENCY APPROVAL \_\_\_\_\_ DATE \_\_\_\_\_  
 PLEASE REVIEW AND FORWARD A COPY OF SIGNED NOTICE TO GCW

REVISION DESCRIPTION: SEE BELOW

**ENTIRE PROJECT**  
 ALL CONCRETE COLLARS AROUND SEWER MANHOLES, STORM DRAIN MANHOLES AND WATER GATE VALVE COVERS WITHIN THE ROADWAY ASPHALT AREA, AS REFERENCED IN THE STANDARD PLATES:

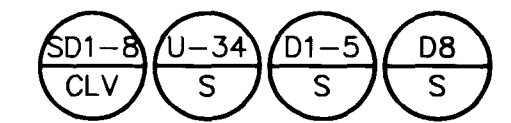

ARE TO BE OMITTED DURING THE INITIAL PAVEMENT SECTION FOR THIS PROJECT. THE CONCRETE COLLARS WILL BE REPLACED WITH ASPHALT. ALL ASPHALT COLLARS, MANHOLES AND VALVE COVERS ARE TO BE BROUGHT TO THE DESIGN GRADE OF THE INITIAL LIFT. UPON FUTURE COMPLETION OF THE FINAL LIFT, ALL MANHOLES AND VALVE COVERS SHALL BE RAISED TO THE FINAL LIFT FINISH GRADE, WITH CONCRETE COLLARS INSTALLED PER THE REFERENCED STANDARD PLATES.

S.T.S., 09/04/96, V3ADDCN1.DWG

**G.C. WALLACE, INC.** Engineering/Architecture  
 MAIN 1555 SOUTH RAINBOW BLVD LAS VEGAS, NV 89102 (702) 363-1200  
 SUMMERLIN 1645 VILLAGE CENTER CIR LAS VEGAS, NV 89134 SUITE #181 (702) 363-0991

**DRAWING CHANGE NOTICE:** DATE: 08/23/96  
 PROJECT NAME: VILLAGE 3 ALTA DRIVE  
 JOB NO. 62003.207  
 DCN NO. V3AD-01  
 AGENCY NO. 107-V2509

GCW APPROVAL \_\_\_\_\_ DATE \_\_\_\_\_  
 SUMMERLIN APPROVAL \_\_\_\_\_ DATE \_\_\_\_\_ AGENCY APPROVAL \_\_\_\_\_ DATE \_\_\_\_\_  
 PLEASE REVIEW AND FORWARD A COPY OF SIGNED NOTICE TO GCW

REVISION DESCRIPTION: NO. 1 - RELOCATE STREET LIGHTS AS SHOWN.

**RELOCATE THE FOLLOWING STREET LIGHTS AS SHOWN**

OLD STATIONS	** NEW STATIONS
554+40	554+35
556+27 (SHT 8)	555+77
556+27 (SHT 9)+	557+20
560+00	558+63
	560+05

+ INITIALLY AN INCORRECT STATION


\*\* NOTE THE ADDITION OF ONE STREET LIGHT AS A RESULT OF THIS RESPACING.

S.T.S., 08/23/96, DCNALTA.DWG

**RECORD DRAWINGS**

THESE PLANS SHOW RECORD INFORMATION RECEIVED FROM:  
 CONTRACTOR: WELLS CARGO INC. (WET UTILITY IMP.) 3/2/98  
 CONTRACTOR WELLS CARGO INC. (ROADWAY IMPROVEMENTS) 3/2/98

THIS DATA MAY OR MAY NOT REFLECT THE ACTUAL FIELD LOCATIONS. ALL DATA SHOULD BE CONFIRMED PRIOR TO USE ON DEVELOPMENT OR ENGINEERING PLANS.

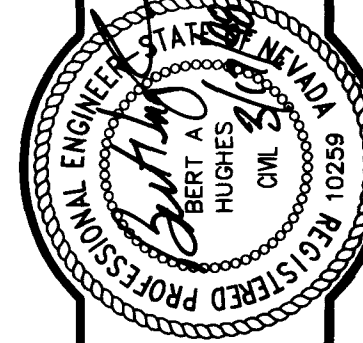

**G.C. WALLACE, INC.** Engineering/Architecture  
 1555 SOUTH RAINBOW BLVD LAS VEGAS, NEVADA 89102 (702) 363-1200  
 SUMMERLIN DIVISION (702) 363-0991

**SUMMERLIN VILLAGE 3 ALTA DRIVE DRAWING CHANGE NOTICES**

SHEET **15A**

SHT 15A OF 16

RECORD DRAWINGS  
 REV. DATE DESCRIPTION  
 3/16/98 10259 ADD THIS SHEET TO PKG  
 DATE LABEL APP. DATE GCW APP.

