



L:\DEPT\DESIGN\RAINBOW\REF\09L F01.dgn 31 11:10:30 1997 MS:UPD-FINAL

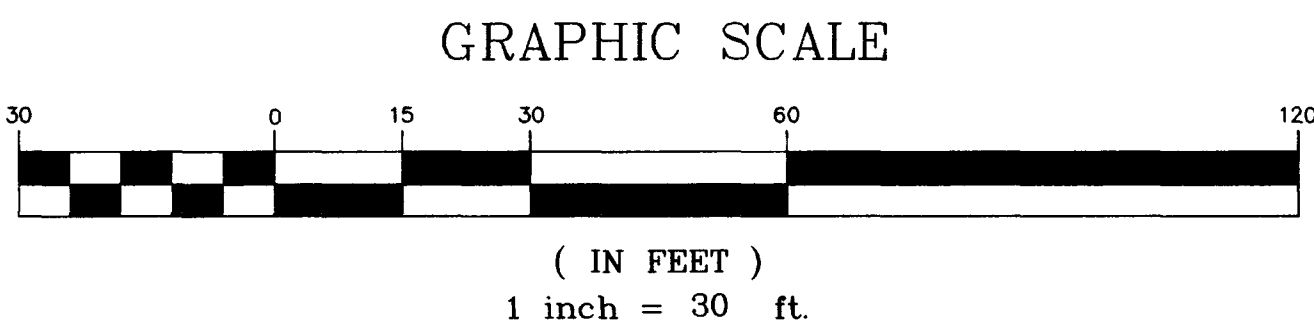

NOTE: ALL STRIPING TO BE 4" WHITE
PAINT EXCEPT WHERE NOTED

BELCASTRO STREET

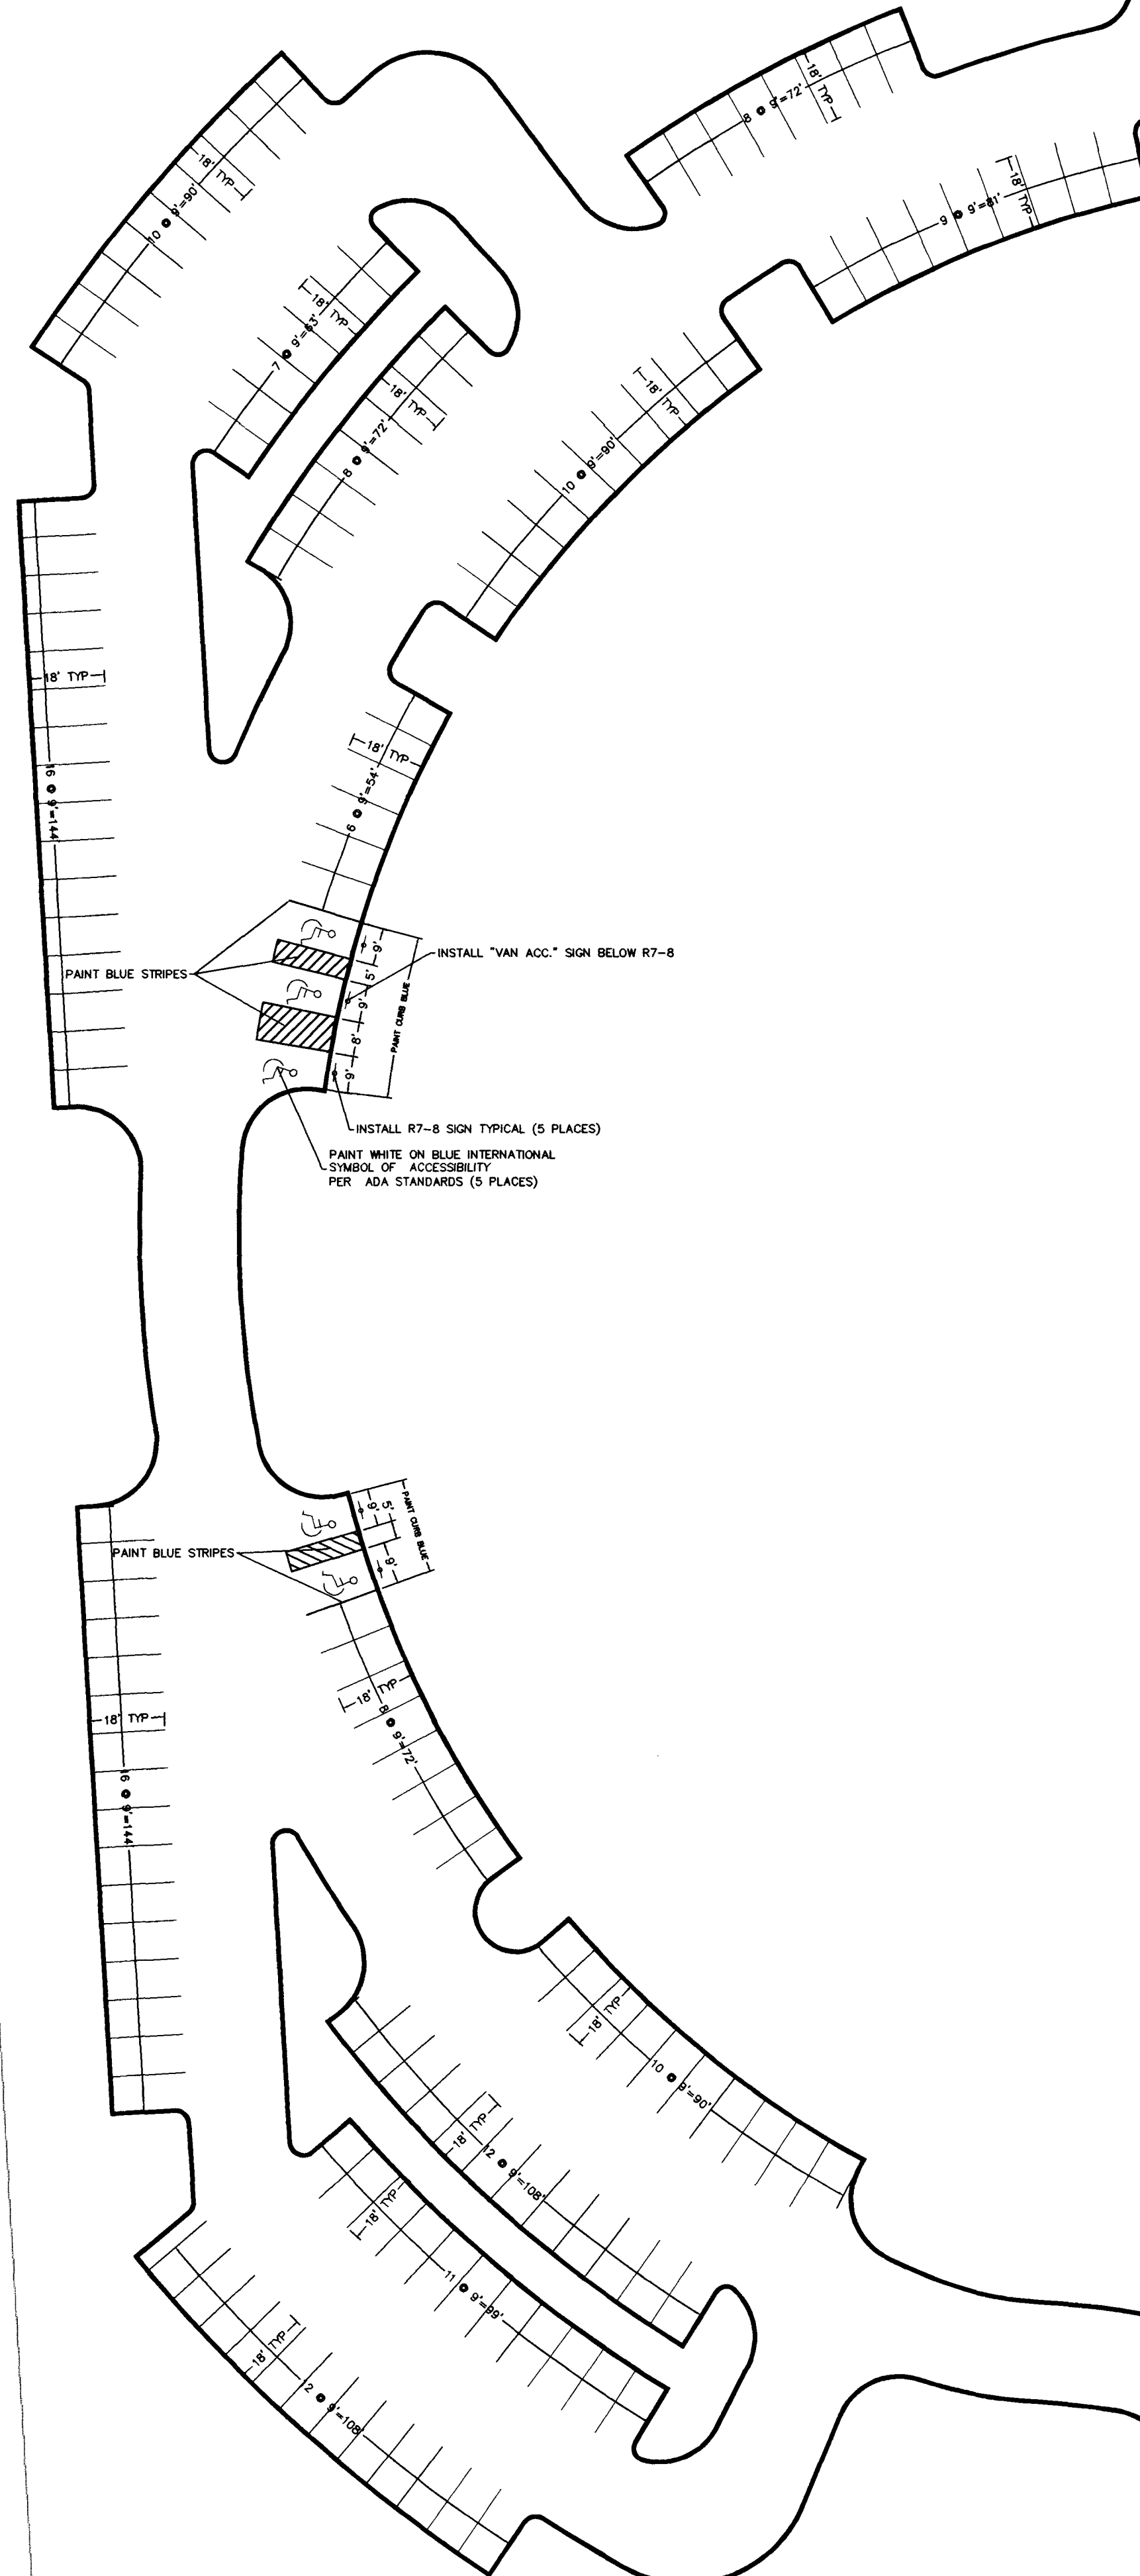

AS BUILT

DRAWING NO. 650.30-6		3B 11	
DEPARTMENT OF PUBLIC WORKS			
PROJECT: PARKING LOT STRIPING PLAN		PROJECT: RAINBOW PARK	
SHEET:			
ENGINEERING DESIGN DIVISION			
CITY ENGINEER: DENNIS ANDERSON, P.E.			
PROJECT ENGINEER: ED NETTENSTROM, P.E.			
SCALE (H) 1"=1'		SCALE (V) 1"=1'	
DATE: JANUARY 1997		DATE: JANUARY 1997	
F.D. BK. # N/A		W.A. # W00000	
DESIGN BY ABC		DESIGN BY ABC	
REVISIONS			
DATE			



NOTE: ALL STRIPING TO BE 4" WHITE
PAINT EXCEPT WHERE NOTED



EL CASTRO STREET

AS BUILT

DEPARTMENT **PARKING LOT**
STREETING PLAN

STANLEY PARK



ENGINEERING DESIGN DIVISION