


SEWER AS-BUILT MAP

FALLING WATER APARTMENTS

NOTE:
1) SEWER SERVICE LOCATIONS AS SHOWN ON THIS MAP WERE INTERPRETTED FROM IMPROVEMENT PLANS AND CLV TELEVISION REPORT. ALPHA ENGINEERING ASSUMES NO LIABILITY FOR MISPLACED SERVICES REPRESENTED ON THIS MAP.
2) ALL SEWER MAIN MATERIALS ASSUMED TO BE SDR - 35. CONTRACTOR COULD NOT BE CONTACTED TO VERIFY.

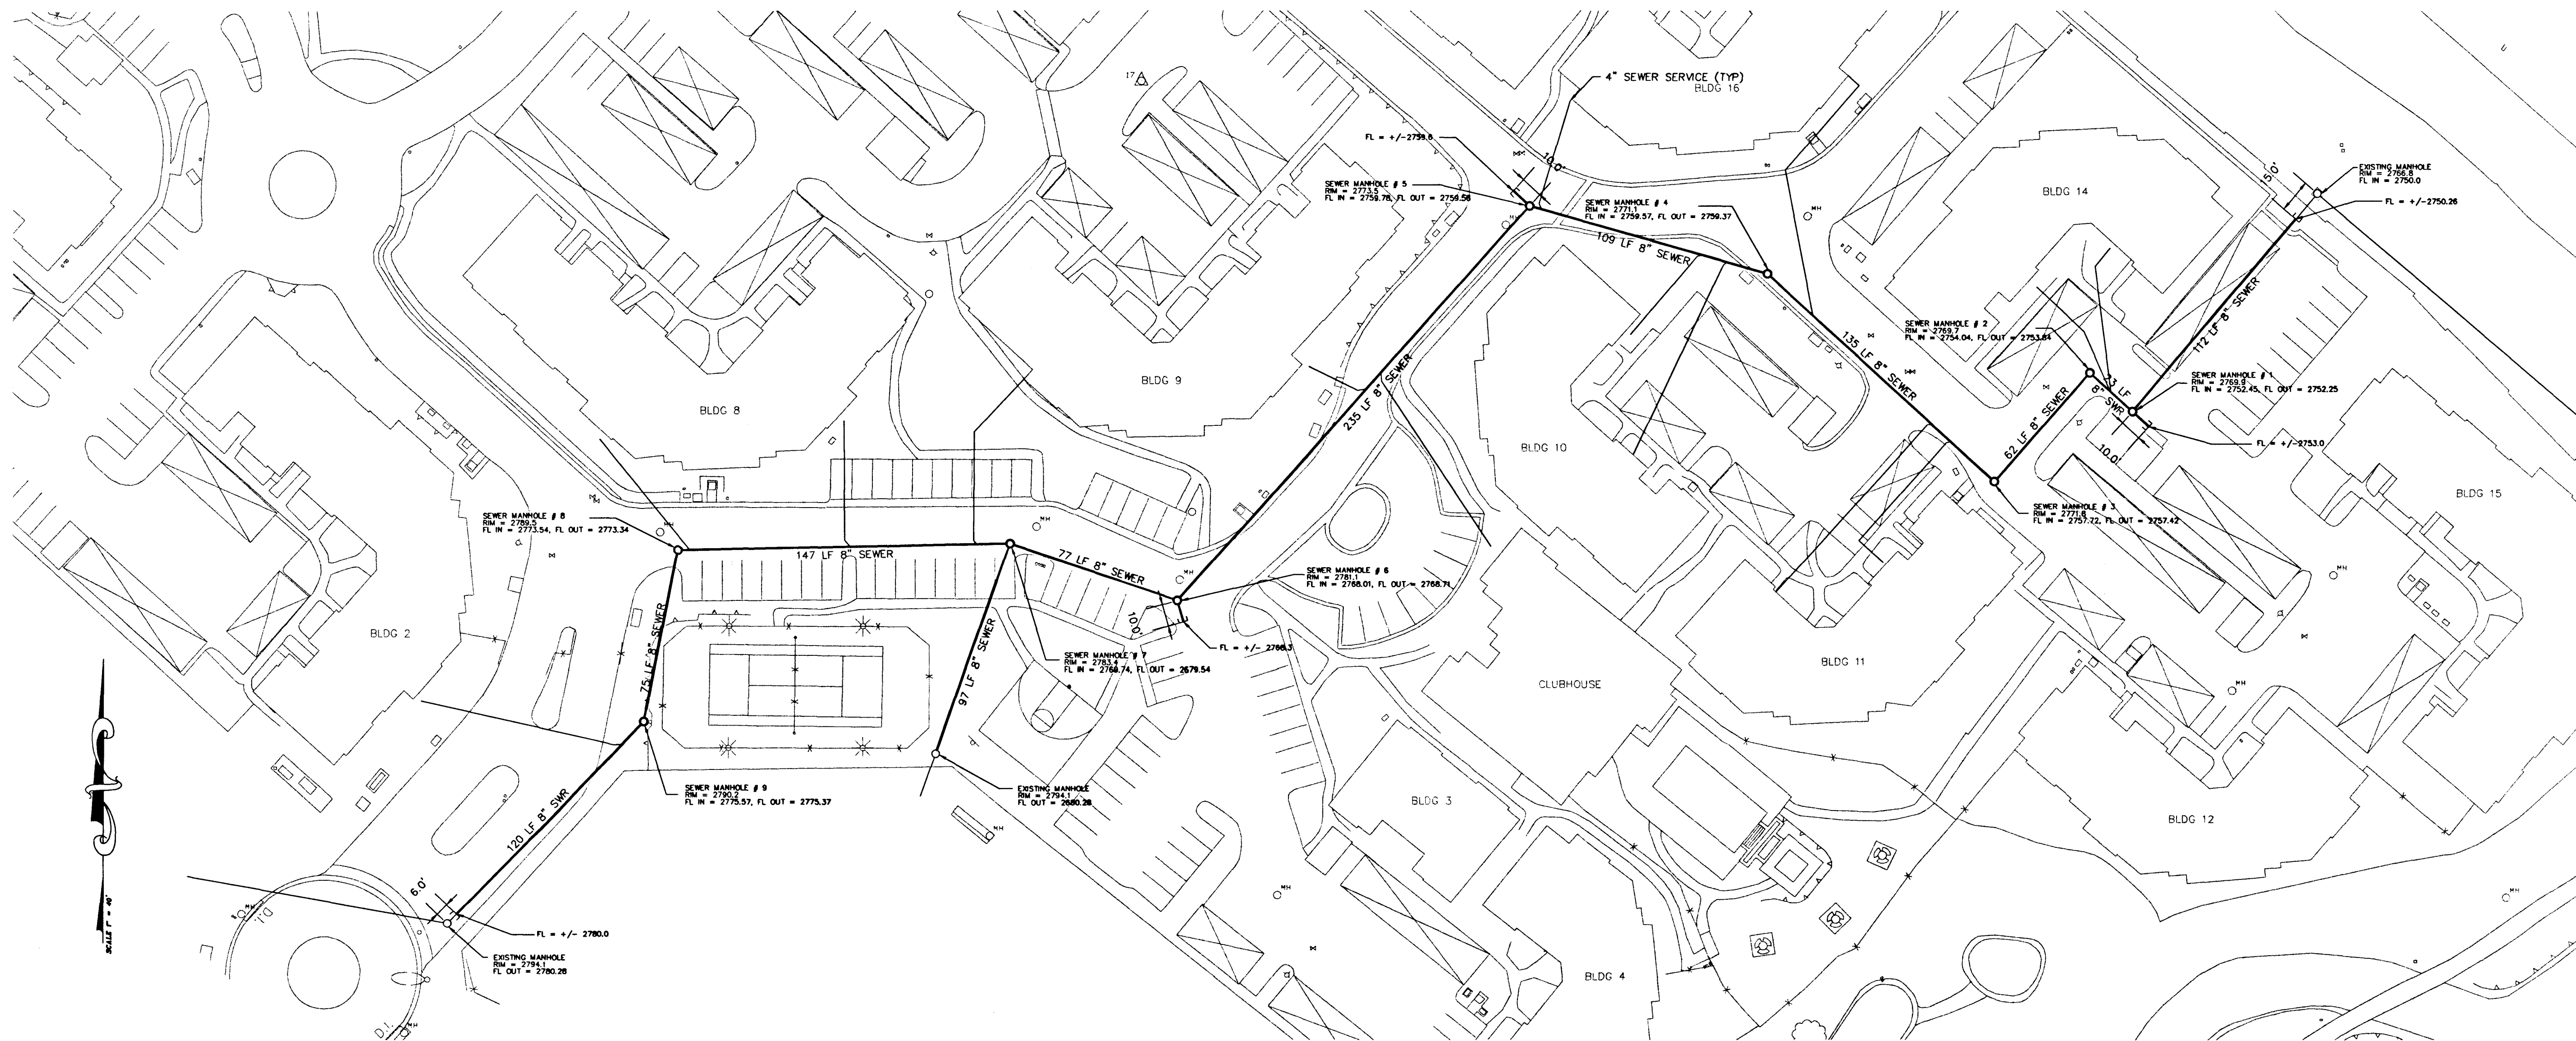

OLEN DEVELOPMENT CORP.

4550 W. SAHARA
LAS VEGAS, NV 89102

ENGINEERING
COMPANY

50 So. Jones #202, Las Vegas, NV, 89107
Telephone: (702) 877-1300

ALPHA &

SEWER AS-BUILT MAP


FALLING WATER
APARTMENTS

DRAWN BY: SMD 6.14.99

DESIGNED BY: X.X.

CHECKED BY: X.X.

PROJECT NO: 715305
SCALE: 1"=40'

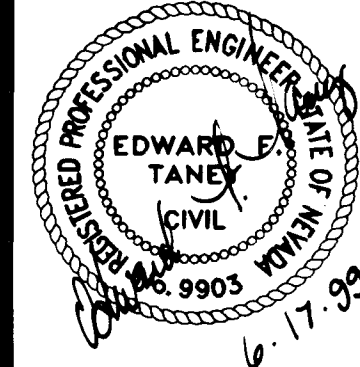

SHEET
1
OF 1 SHEETS
DRAWING NO.
307Y-4480

"As Built"

VIEW NAME:

FILE NAME:

16574

1. **UNIVERSITY OF**
 2. **MISSISSAUGA**
 3. **STUDENT IDENTIFICATION**

	NAME OF 1. _____ 2. _____ 379
--	--