



JOB NO. 701.096

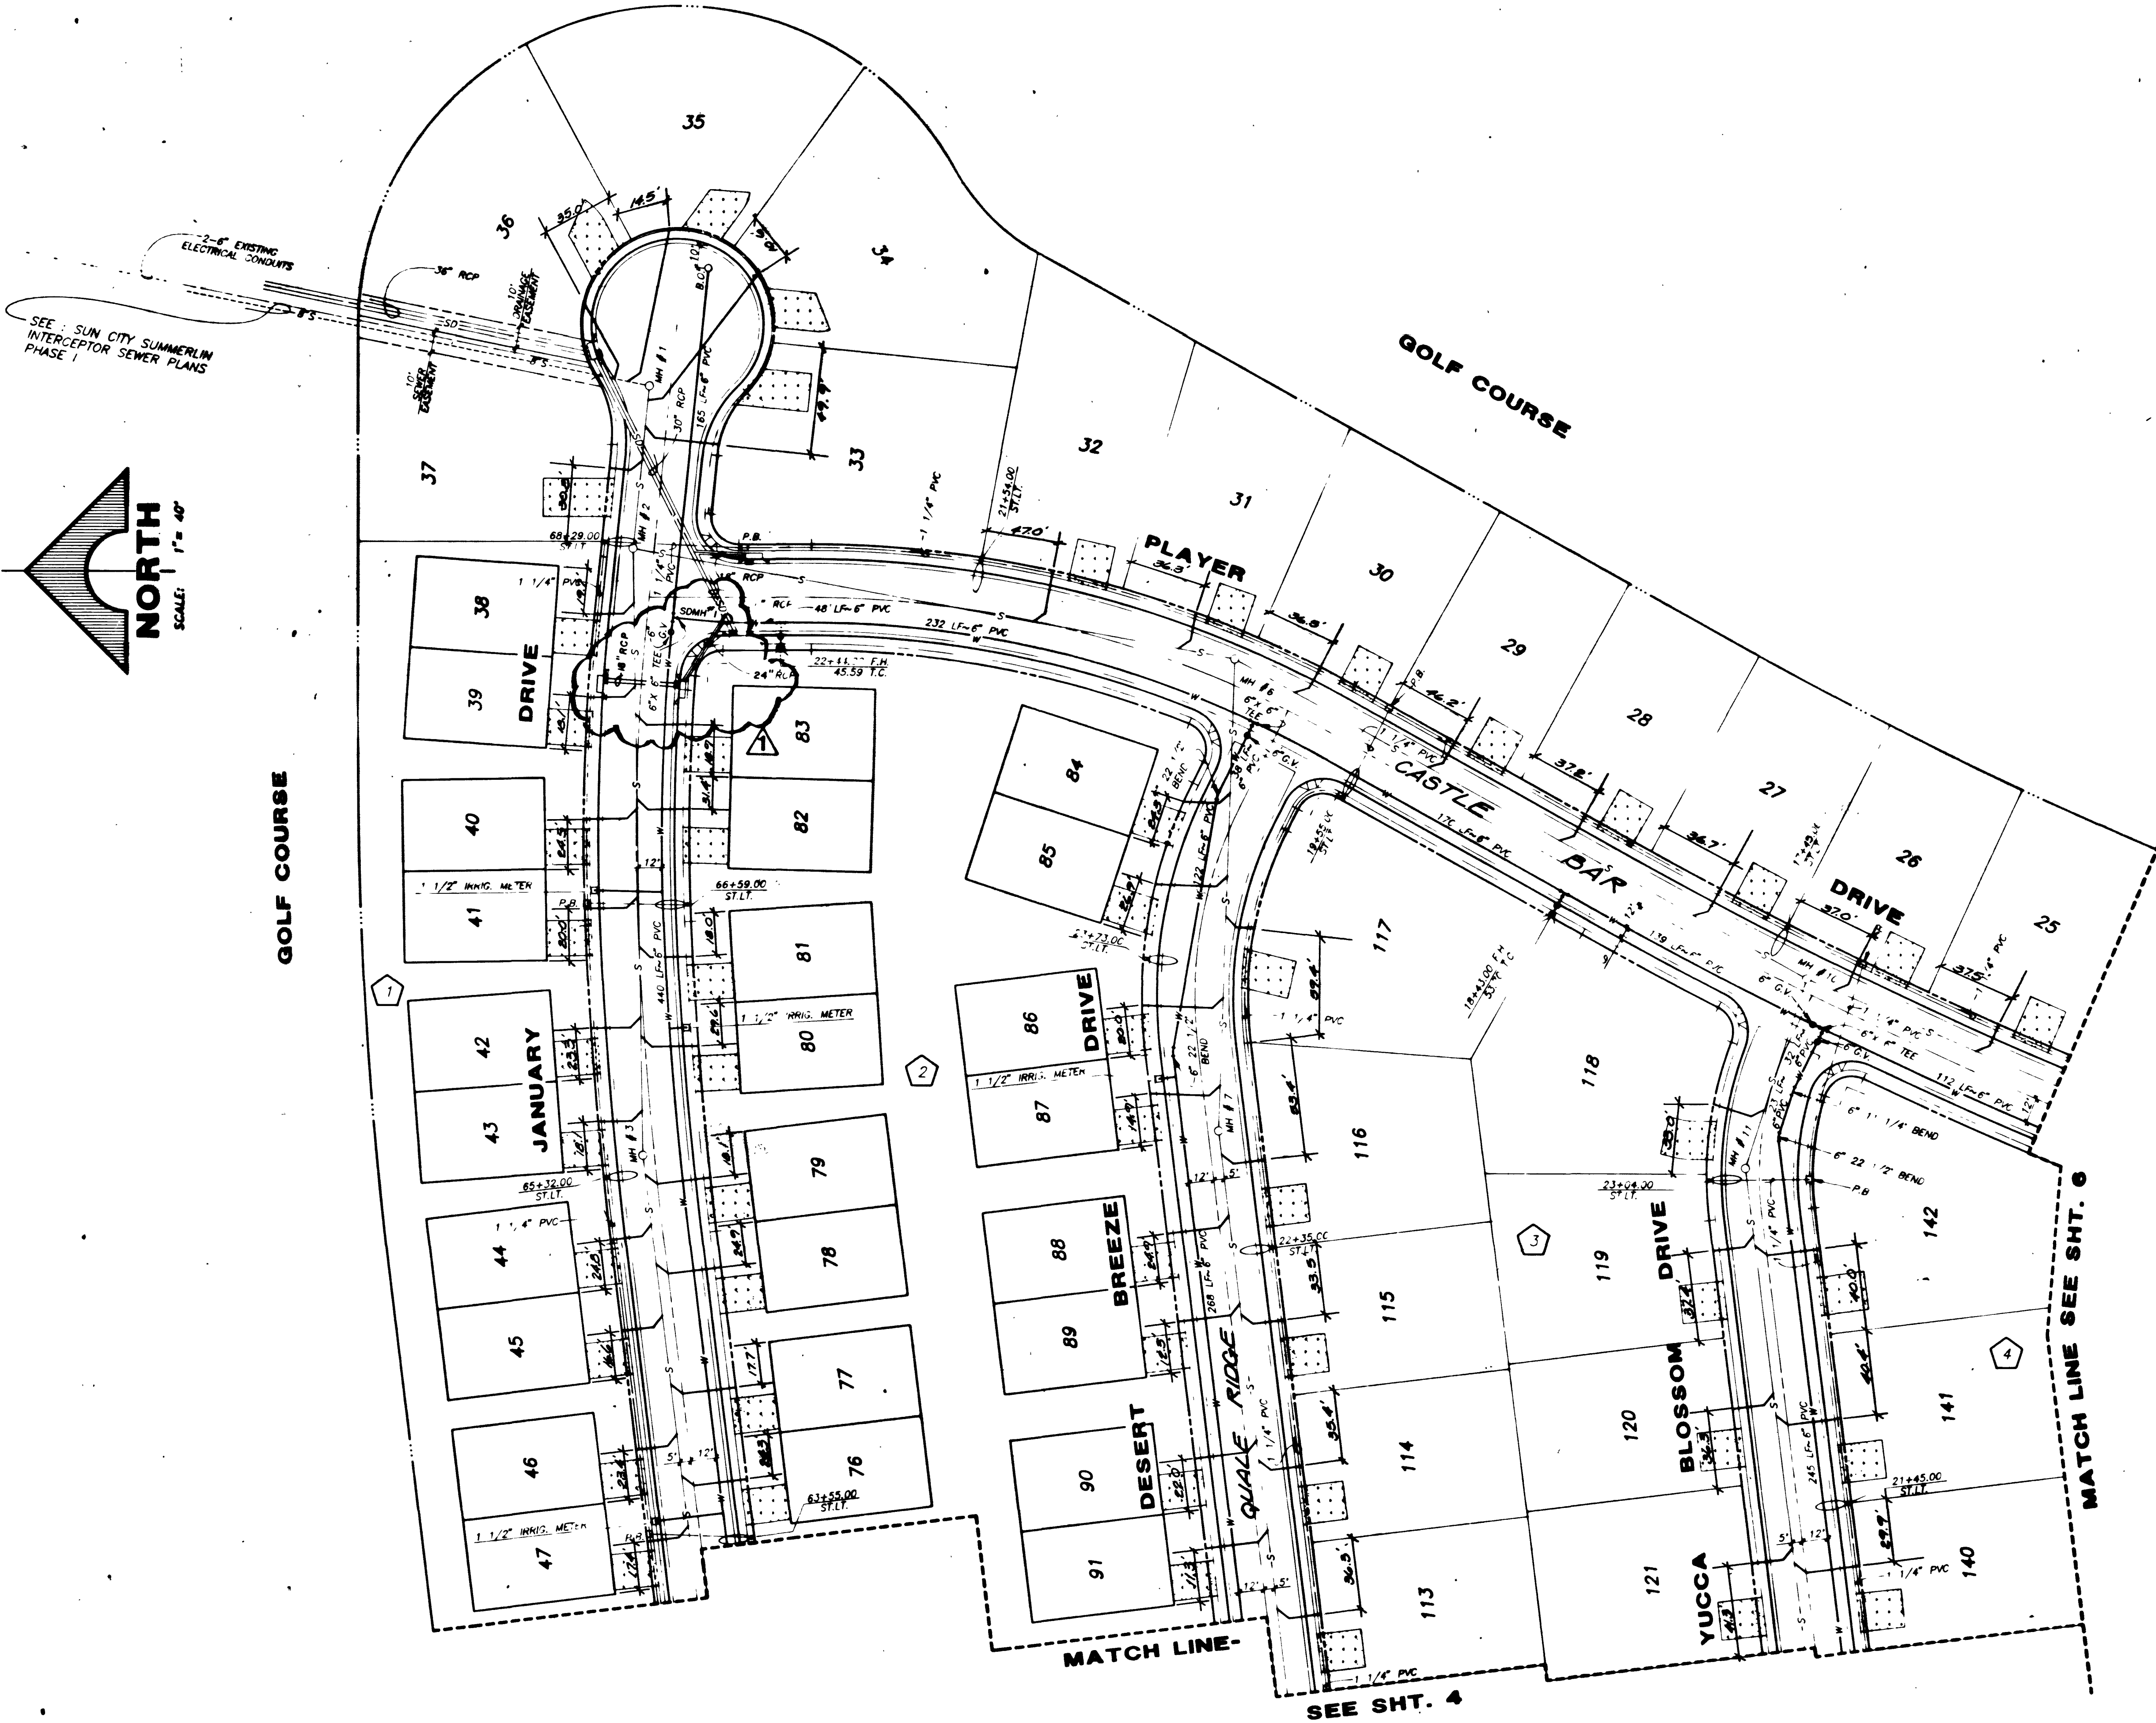

SEE: SUN CITY SUMMERLIN INTERCEPTOR SEWER PLANS PHASE I

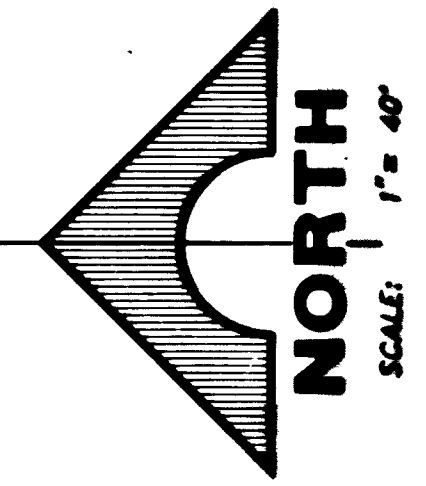


GOLF COURSE

GOLF COURSE

MATCH LINE-

SEE SHT. 4

MATCH LINE SEE SHT. 6

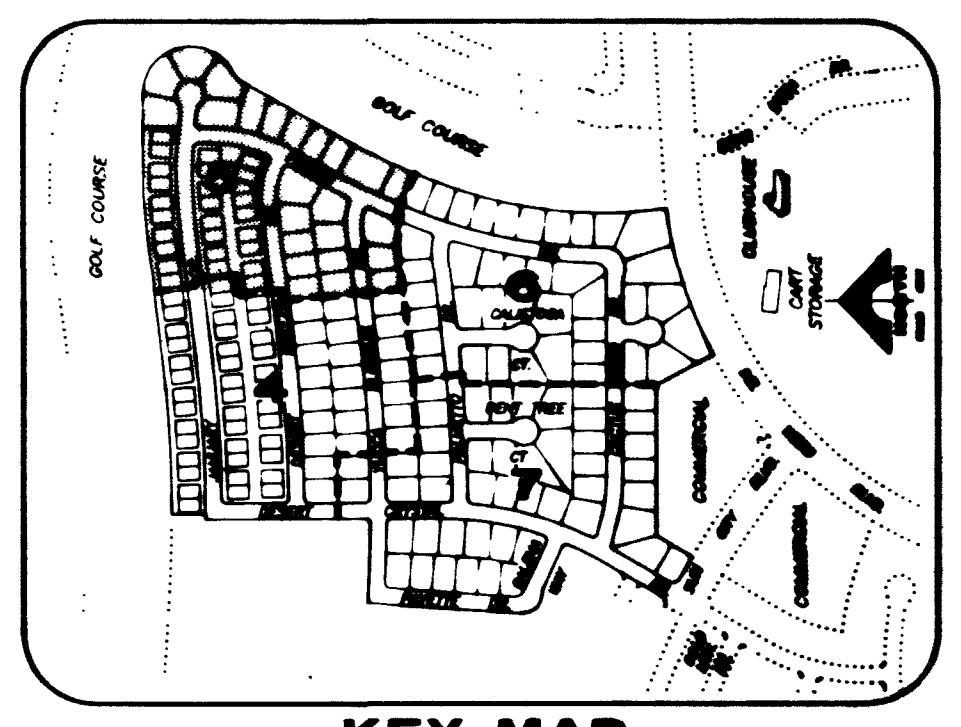

KEY MAP

APPROVED FOR CONSTRUCTION
 LAS VEGAS WATER DISTRICT
 DATE: 1-14-91

APPROVED FOR CONSTRUCTION
 DEL WEBB COMMUNITIES, INC.
 DATE:


RECORD DRAWING

| | | |
|--|------|---------------|
| RECOMMENDED | DATE | DESCRIPTION |
| Michael D. Ross | 0218 | Final |
| Michael D. Ross | | P.E. NO. DATE |
| DEL E. WEBB COMMUNITIES, INC. SUN CITY LAS VEGAS UNIT NO. 24 UTILITY PLAN II | | |
| SHEET 5 OF 26 SHEETS | | |

G. C. WALLACE, INC.
 Engineering/Architecture
 1565 SOUTH RAINBOW BLVD./LAS VEGAS, NEVADA 89102

6949 "As Built" 3074441-24

RECORD DRAWING

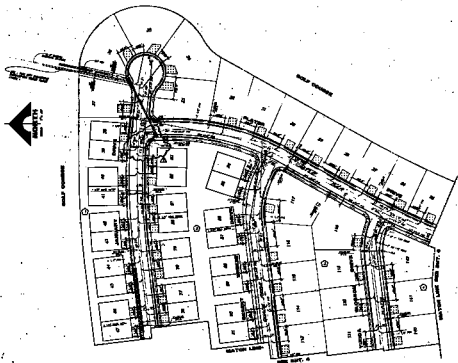

ALL RIGHTS RESERVED
UTILITY PLAN 11