
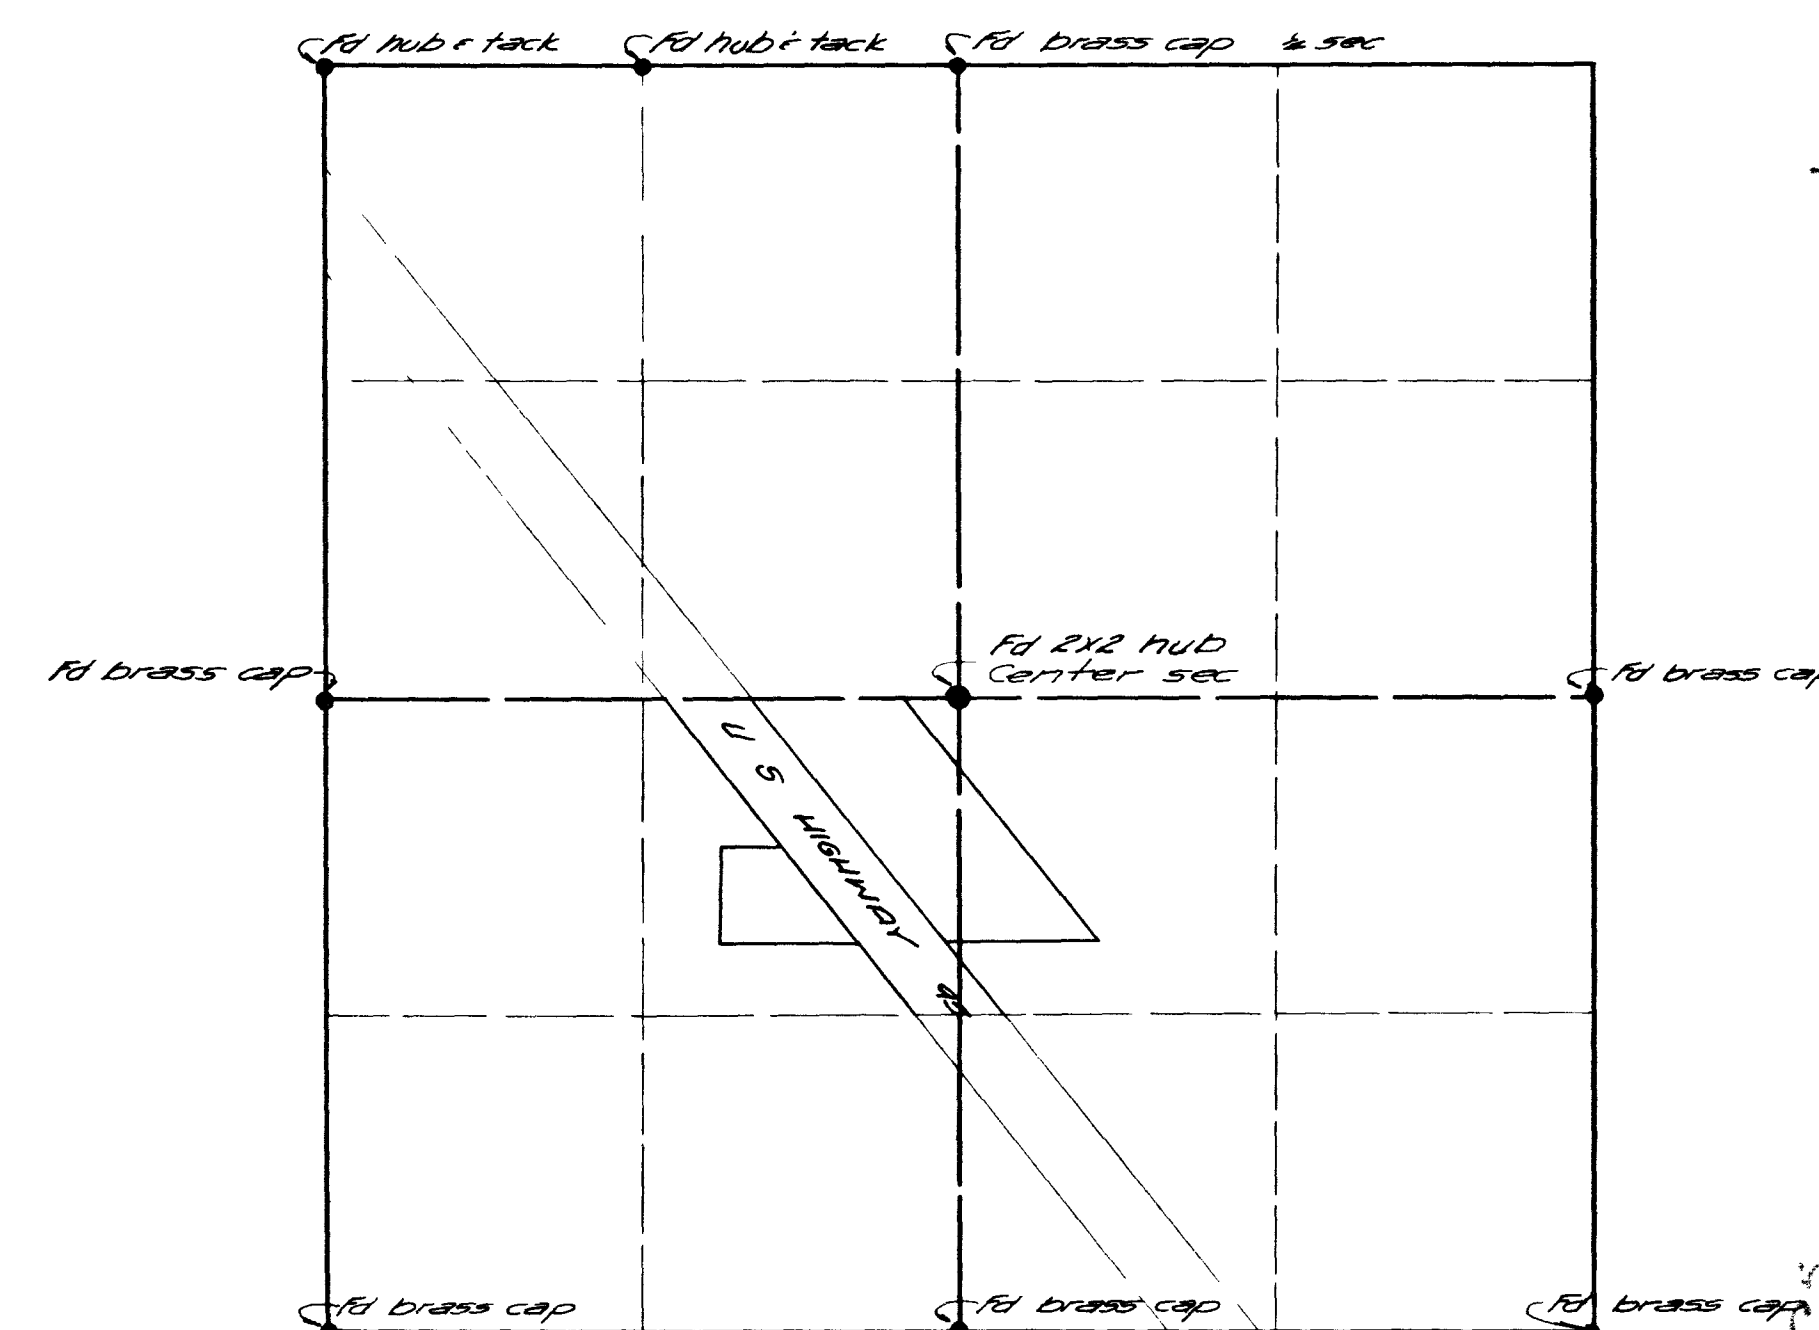


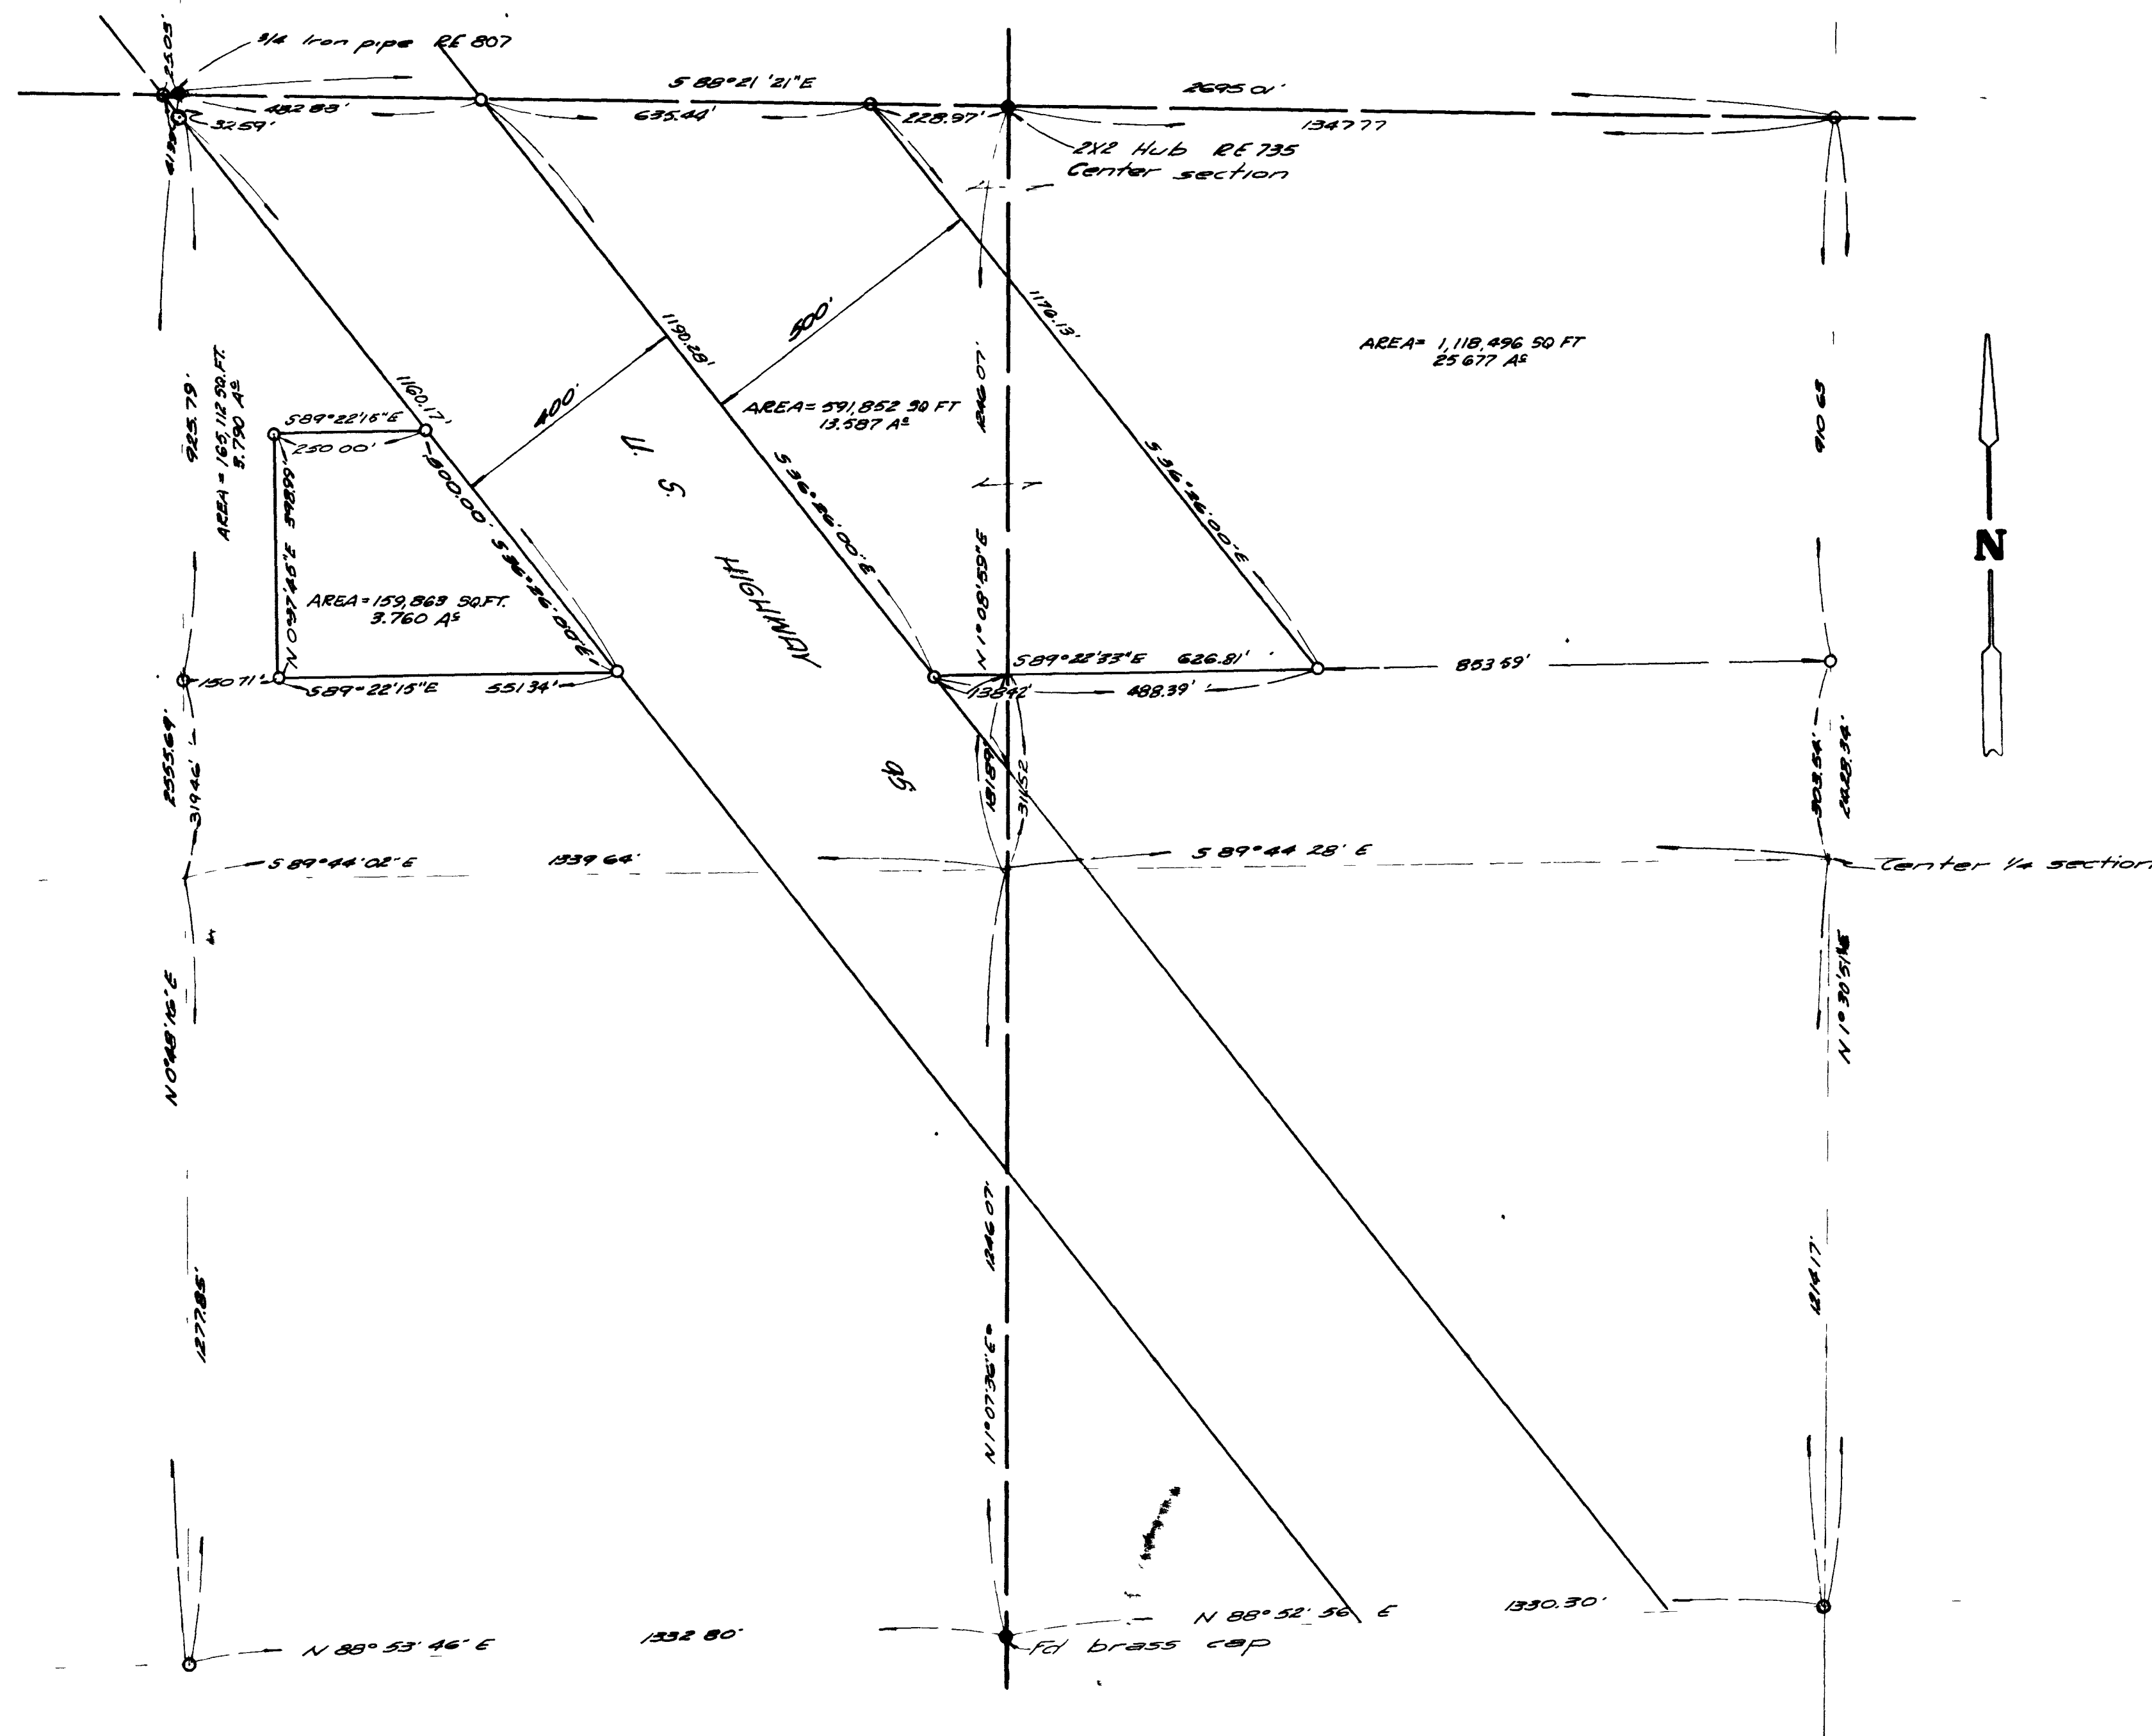

KEY MAP
SECTION 5
T.19S. R.60E

CERTIFICATE

I, Jack K. Leavitt, Registered Professional Engineer and Land Surveyor do hereby certify that this map is a true and accurate representation of the lands shown hereon. All points found or set are correctly designated. This survey was completed on October 17, 1963 at instance of George Rudjak and does not constitute a subdivision as defined by Nevada State Law.

Jack K. Leavitt
JACK K. LEAVITT
Registered Professional Engineer
Land Surveyor RLS 807

LEGEND

- Indicates point set - 2x2 Oak Hub RLS 807
- Indicates point found as shown

BASIS OF BEARING
The centerline of U.S. HIGHWAY
95 as per Nevada State Highway Dept.
plans. S 36° 26' 00" E

NO. 400280
FILED AT THE REQUEST OF
JACK K. LEAVITT
Date 12-6-63 at 1:55 PM
FILE 14 PAGE 11
OF 100
OFFICIAL RECORDS BOOK NO. 499
CLARK COUNTY, NEVADA, RECORDS
PAUL E. HORN, RECORDER
Fee \$ 2.35 TMS Deputy

SURVEY MAP
THE S 1/2, NW 1/4, SE 1/4, N 1/2, S 1/2, NW 1/4
SE 1/4 & THE N 1/2, NE 1/4, SW 1/4, N 1/2,
S 1/2, NE 1/4, SW 1/4 ALL IN SECTION 21,
T.19S. R.60E, MDB FM CLARK
COUNTY, NEVADA.



Surveyed by:
JACK K. LEAVITT
Registered Professional Engineer
Land Surveyor RLS 807

EM

FILE 14 PAGE 11

055-325

9626

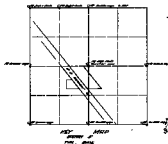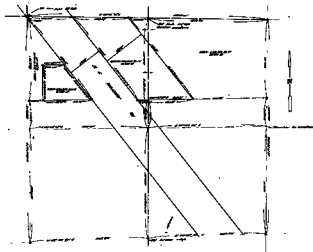

REFERENCES

It is a fact that the Government has been unable to obtain the necessary information to determine the extent of the damage to the property of the Government. The Government has been unable to obtain the necessary information to determine the extent of the damage to the property of the Government.

STATE OF NEW YORK
Department of Transportation
Office of the State Engineer

LEGEND

[illegible]

THE UNIVERSITY OF ALABAMA
IN THE DEPARTMENT OF AGRICULTURE
AND MECHANICAL INDUSTRY

[illegible]

SURVEY MAP
THE SURVEYED AND SURVEYED
IN THE N.E. NEAR SPANISH
IN AREA, SPANISH ALL BY SURVEY IN
THE AREA, AND THE CLIMATE
CLIMATE, NEWSPAPER

JOHN A. LEONETTI
SAC, NEW YORK