
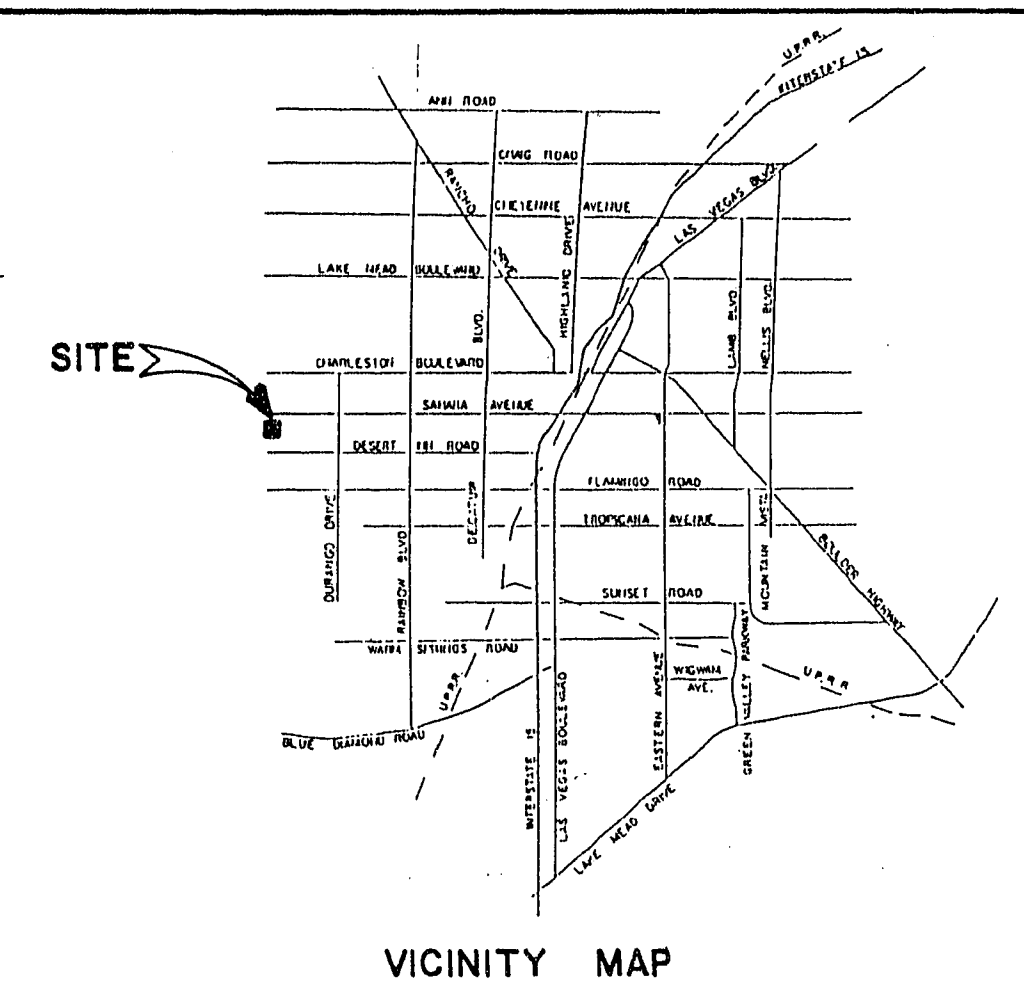


102238

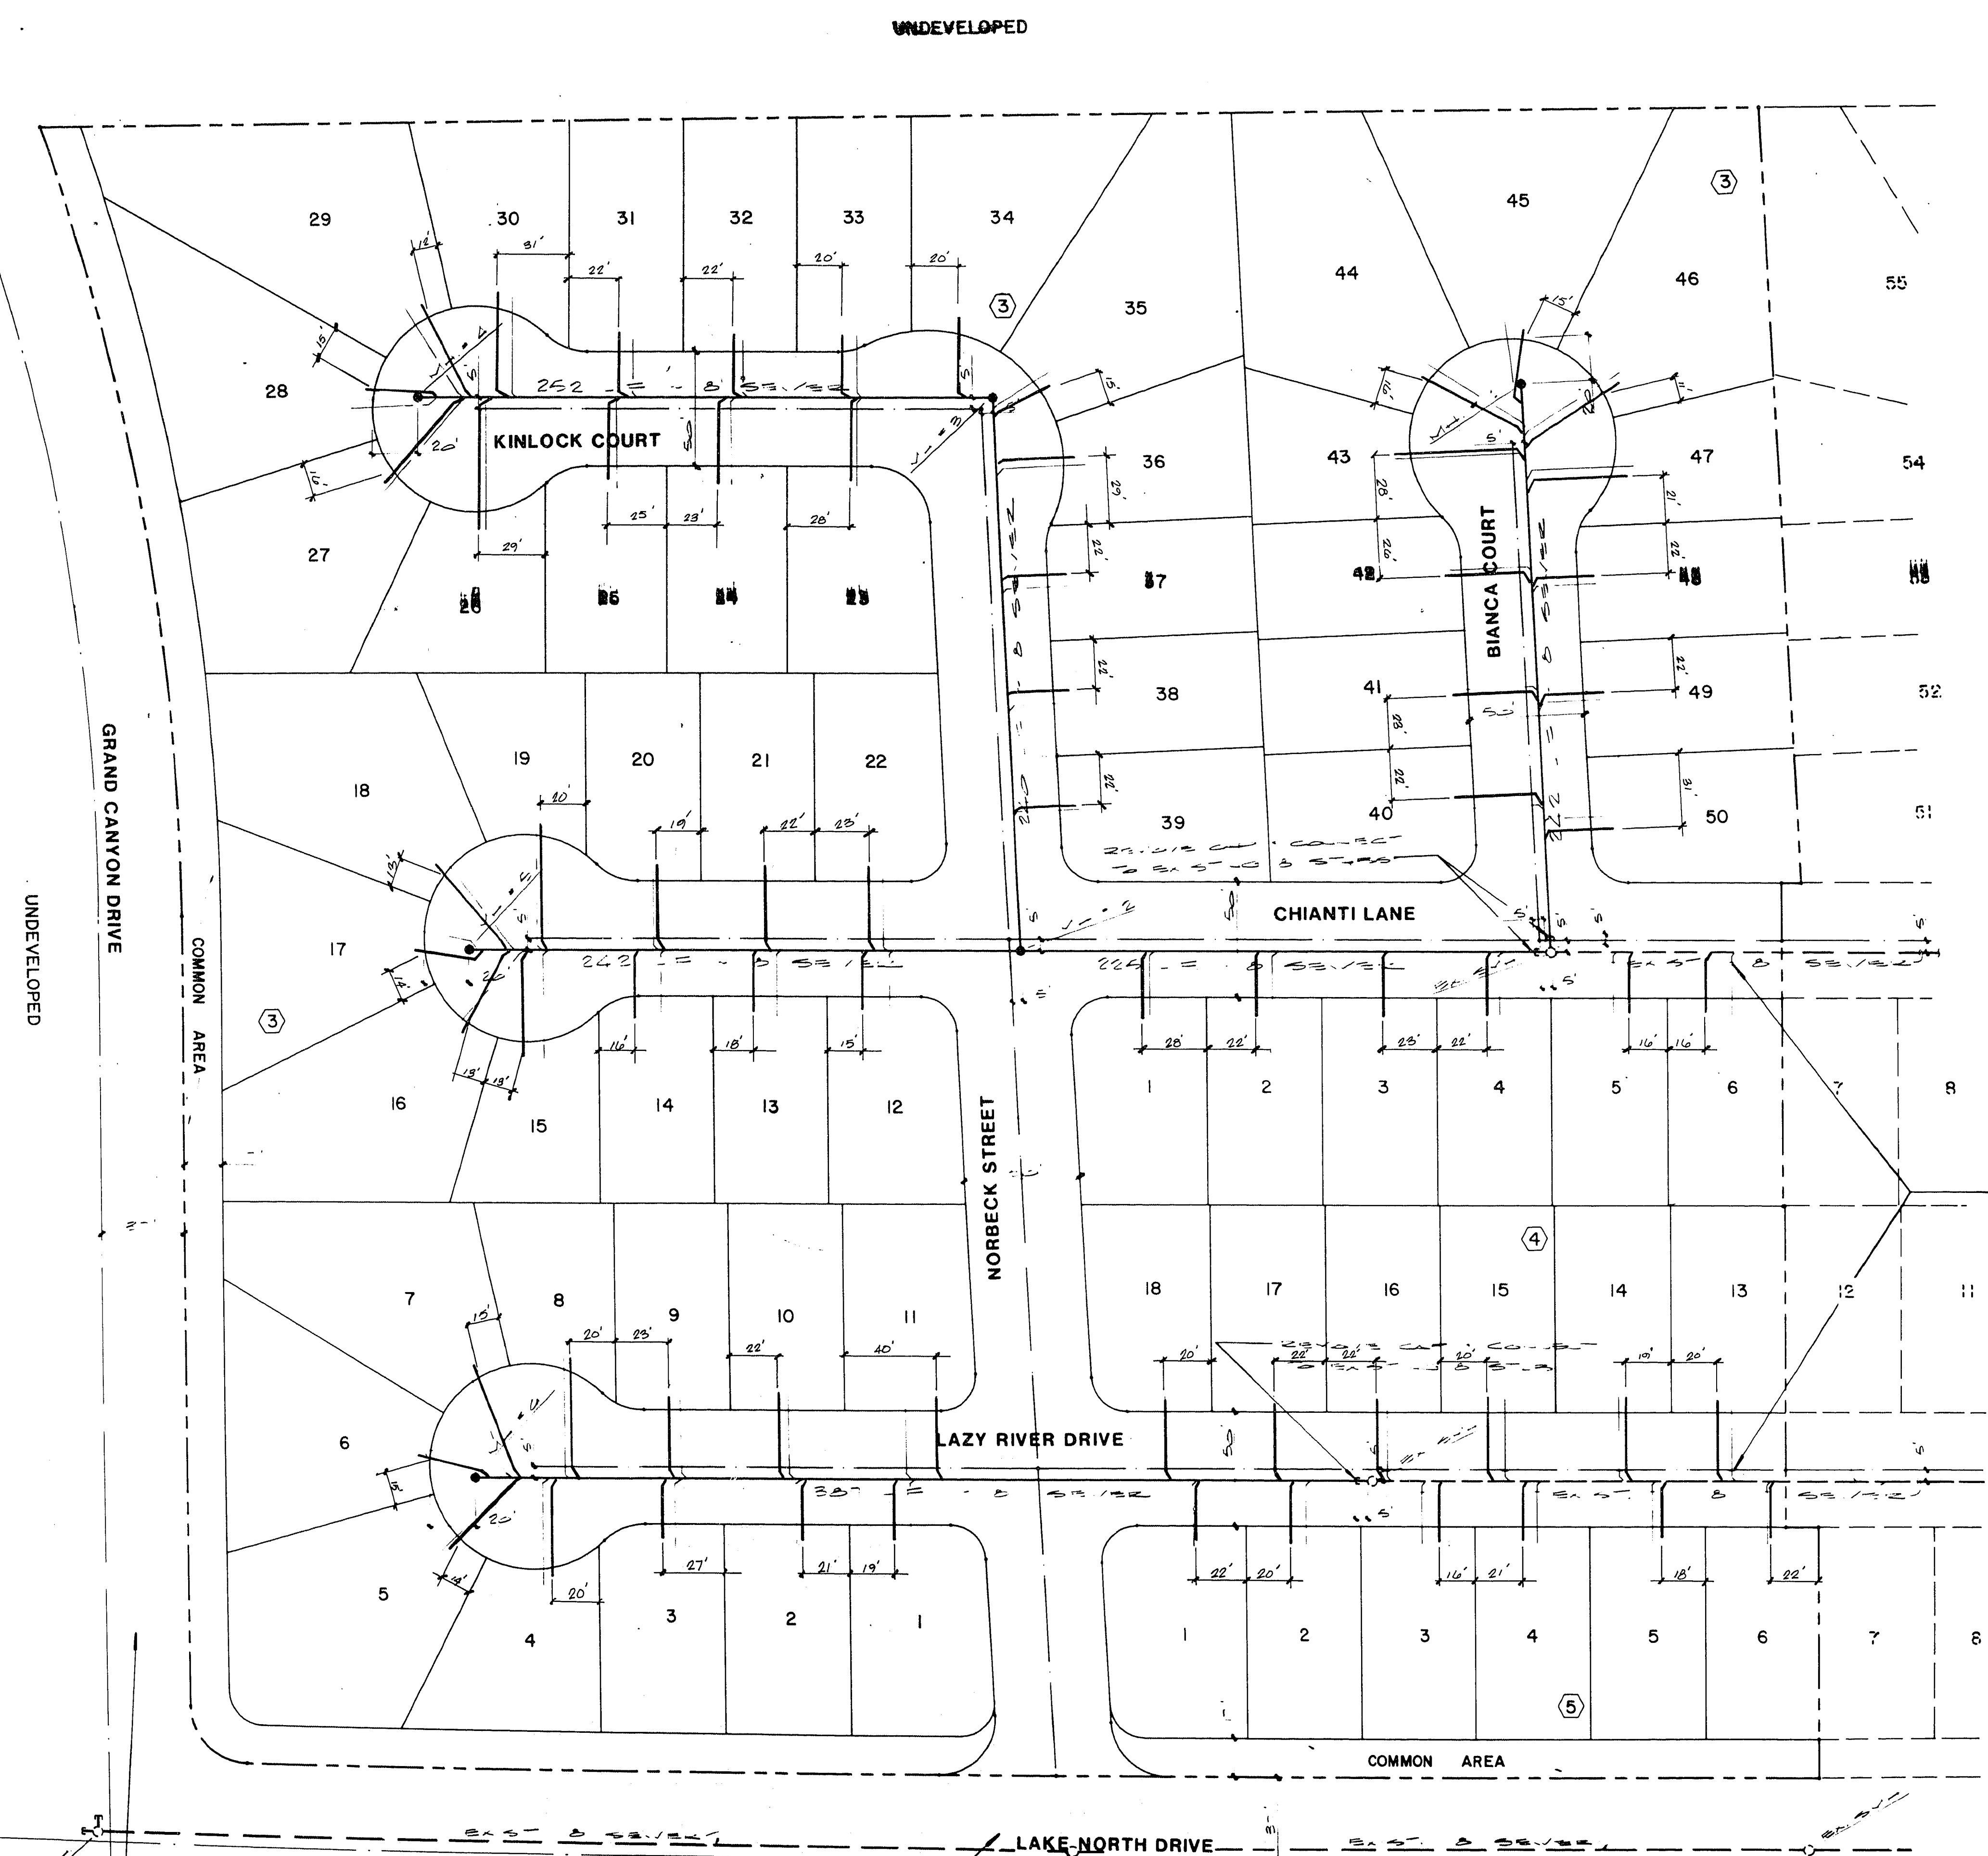

- CITY OF LAS VEGAS GENERAL NOTES**
1. HOUSE SERVICES SHALL COMPLY WITH WESTERN PLUMBING CODE AS TO SEPARATION DISTANCE.
  2. ALL HOUSES TO BE SERVED INDIVIDUALLY AS PER SECTION 313 OF THE UNIFORM PLUMBING CODE.
  3. CONTRACTOR SHALL FURNISH THE ENGINEER WITH AS-BUILT DRAWINGS SHOWING THE EXACT LOCATIONS OF ALL HOUSE CONNECTIONS.
  4. CONCRETE COLLARS TO BE CONSTRUCTED AROUND ALL MANHOLES AND WATER VALVES. CONCRETE COLLARS SHALL BE 1/8" TO 1/4" LOWER THAN ADJACENT FINISH GRADE.
  5. CHISEL S OR G WHEREVER SEWER OR GAS LINES PASS UNDER CURB.

**QUANTITY ESTIMATE**

|                      |          |
|----------------------|----------|
| 4" DIA. STD. MANHOLE | 6 EA.    |
| 8" SE 1/2" MAIN      | 1,523 LF |
| 4" SE 1/2" LATERAL   | 2,130 LF |

EXISTING "THE BLUFFS UNIT NO. 9A"  
BOOK 36 PAGE 70

CONTRACTOR TO CONNECT  
SEWER LATERALS TO  
EXISTING NYE STUB

| MANHOLE CONTROL |             |             |
|-----------------|-------------|-------------|
| M.H. #          | NORTHING    | EASTING     |
| 1               | 9585.309513 | 8288.720583 |
| 2               | 9340.704890 | 8008.073020 |
| 3               | 9580.782728 | 8058.727984 |
| 4               | 9582.925856 | 7807.070670 |
| 5               | 9342.752300 | 7820.521072 |
| 6               | 9112.757372 | 7824.955703 |

EXISTING STREET IMPROVEMENTS OF LAKE NORTH DRIVE, GRAND CANYON DRIVE AND LAKE DRIVE TO THE LAKES AT WEST BLUFFS - PHASE 1 PLANS.

PROPOSED "THE LAKES ESTATES"

REVISION  
BY  
DATE  
REV

11-6-87  
G.N.  
1  
KINLOCK SANITARIUM

ESI ENGINEERS & ARCHITECTS INC.  
1019 A CHANDLER AVENUE, SUITE 100  
LAS VEGAS, NV 89102-3033  
1019 A CHANDLER AVENUE, SUITE 100  
LAS VEGAS, NV 89102-3033

SUBMITTED BY: [Signature]  
DATE: 11/1/87

TITLE  
PROJECT

MASTER SEWER PLAN  
AS BUILT  
THE BLUFFS UNIT NO. 9B

WO NO  
BY  
DATE  
SCALE

5000  
B.L.G.  
1/87  
1" = 40'

SHEET  
OF 8 SHEETS

6