
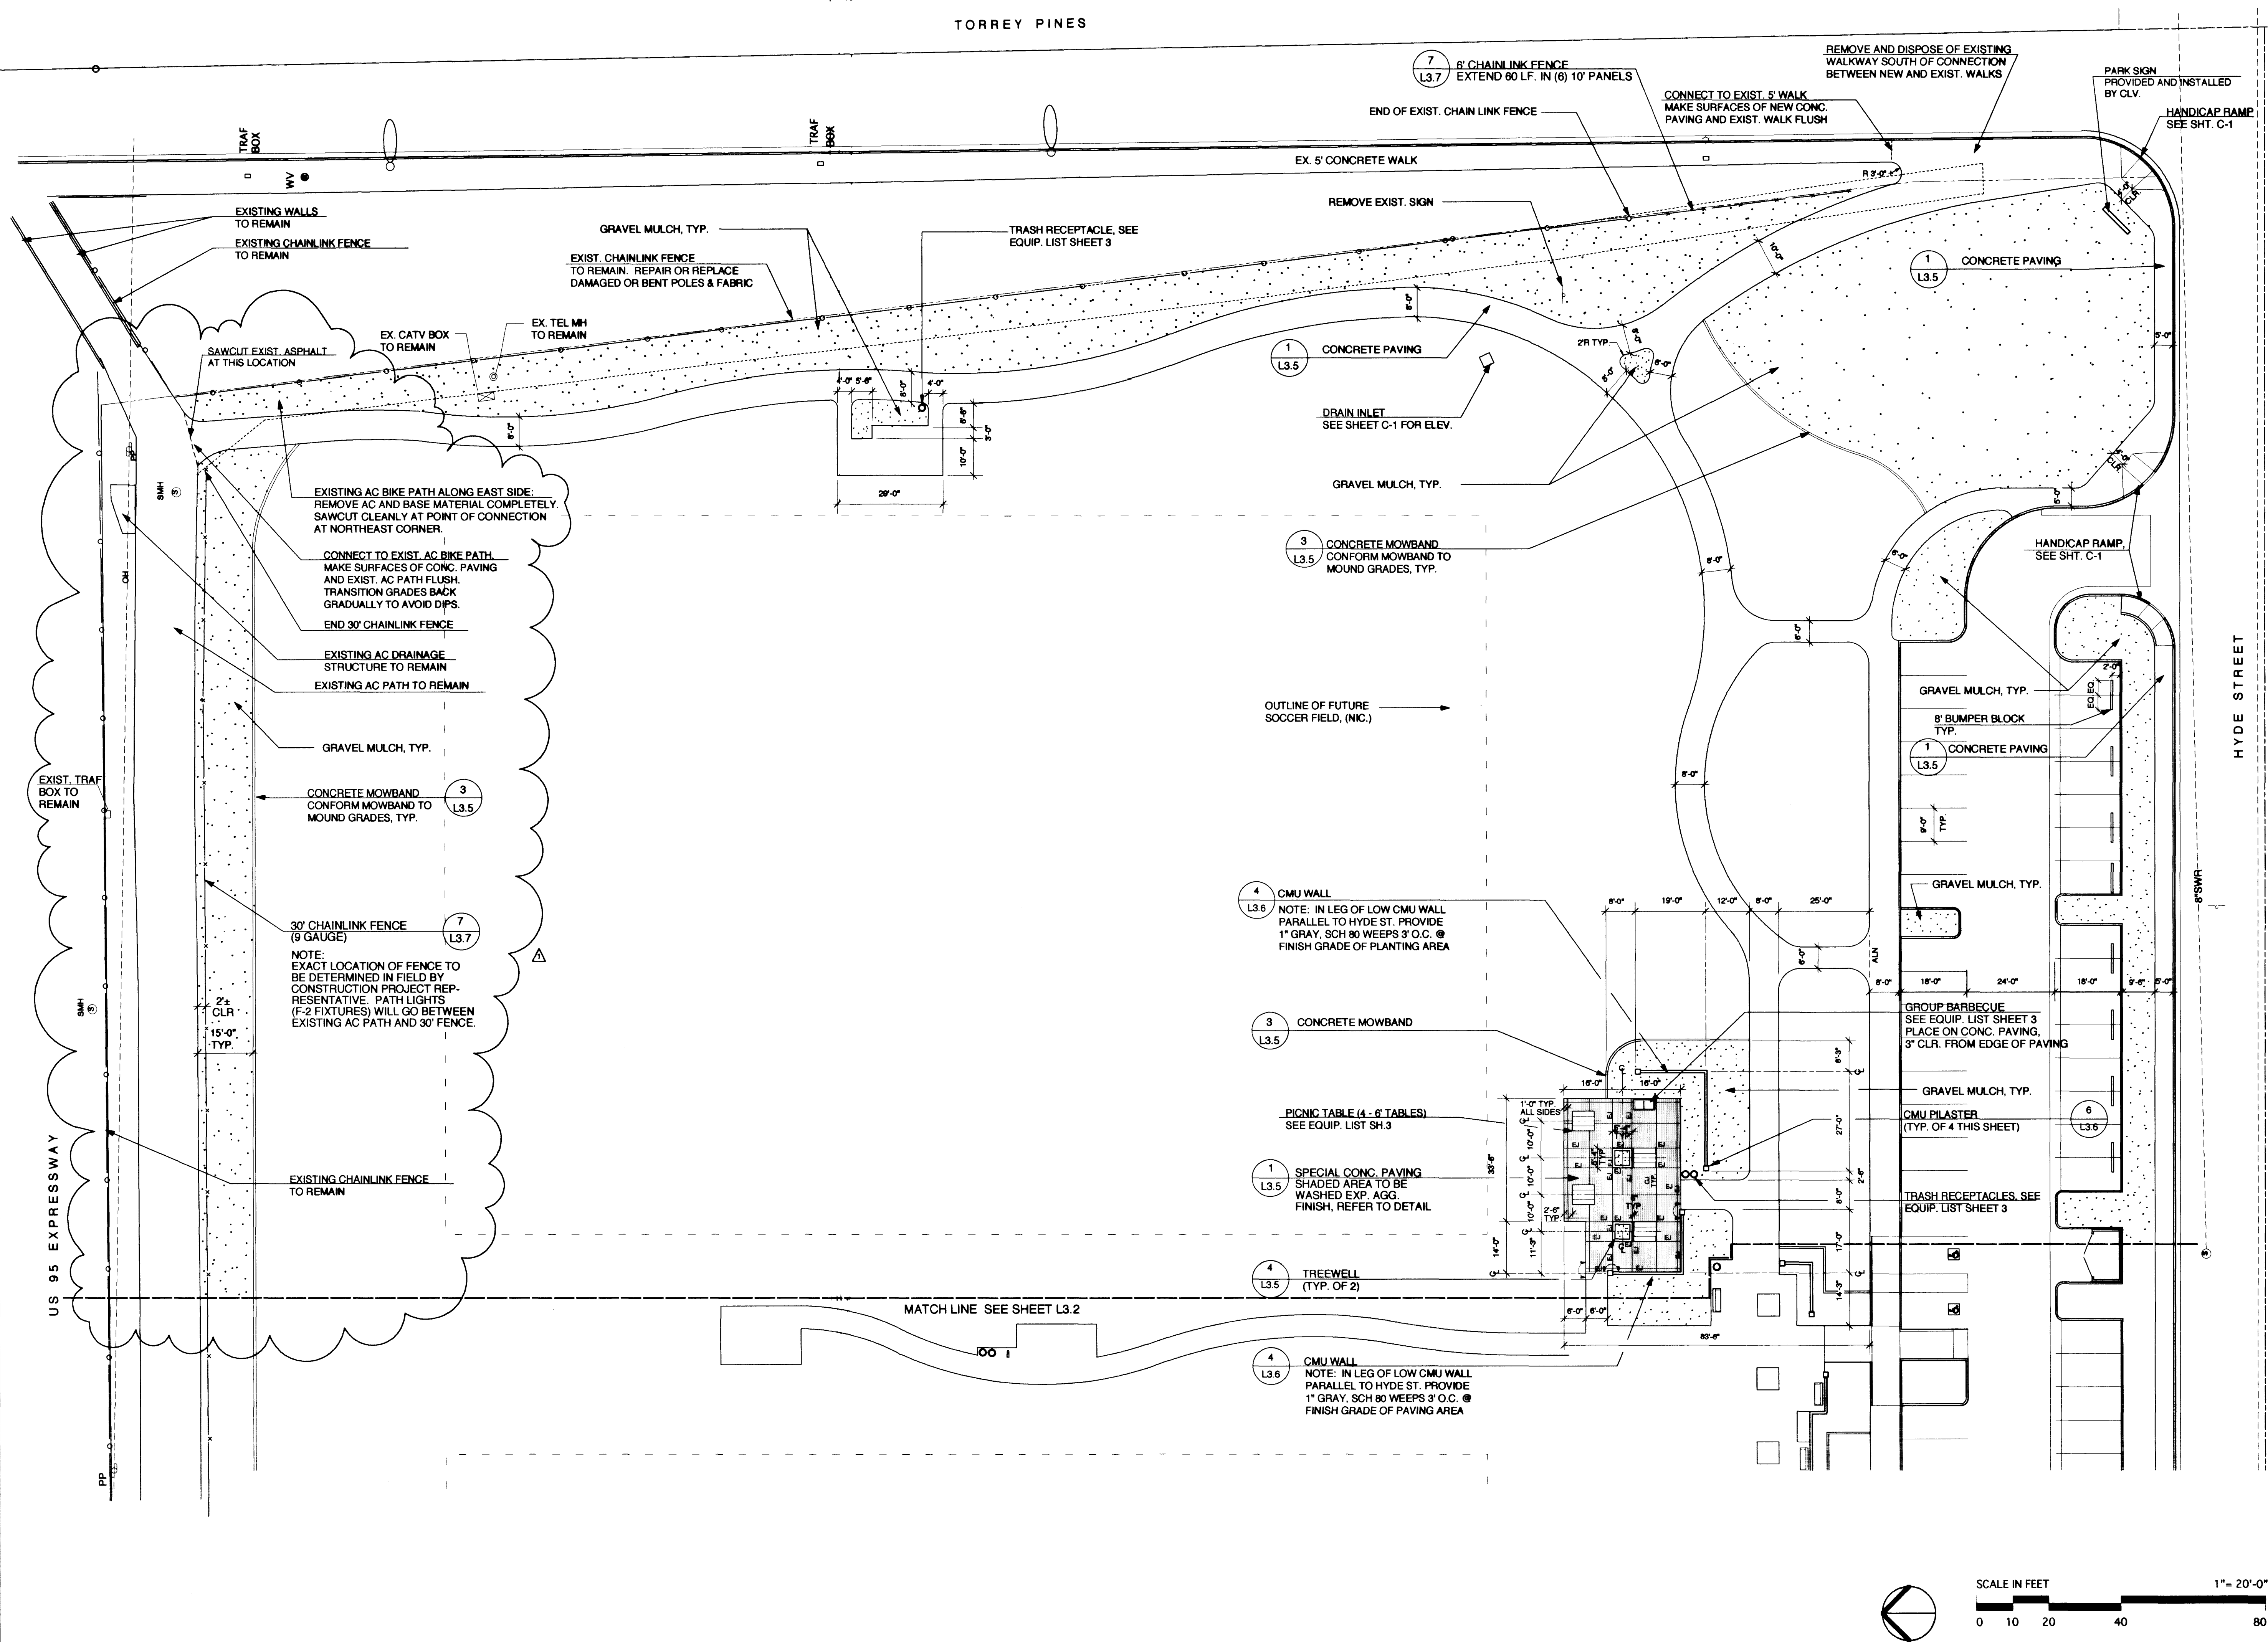


[illegible]

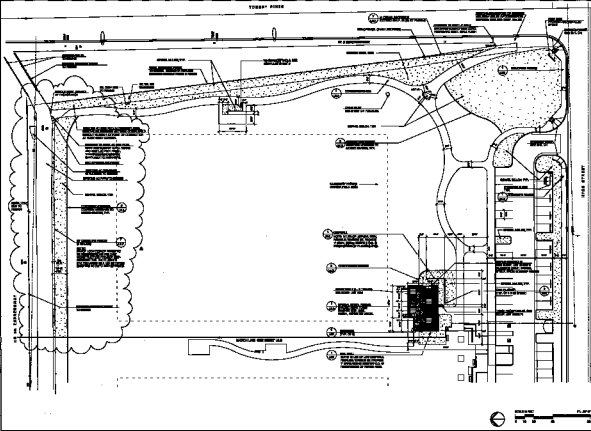

DEPARTMENT OF PARKS & LEISURE ACTIVITIES PARK TORREY PINES PARK & BALL FIELD LANDSCAPE LAYOUT		DATE 10/1/78 DRAWN BY J. L. BROWN CHECKED BY J. L. BROWN APPROVED BY J. L. BROWN	SCALE 1" = 100' NORTH
---	--	---	---------------------------------