



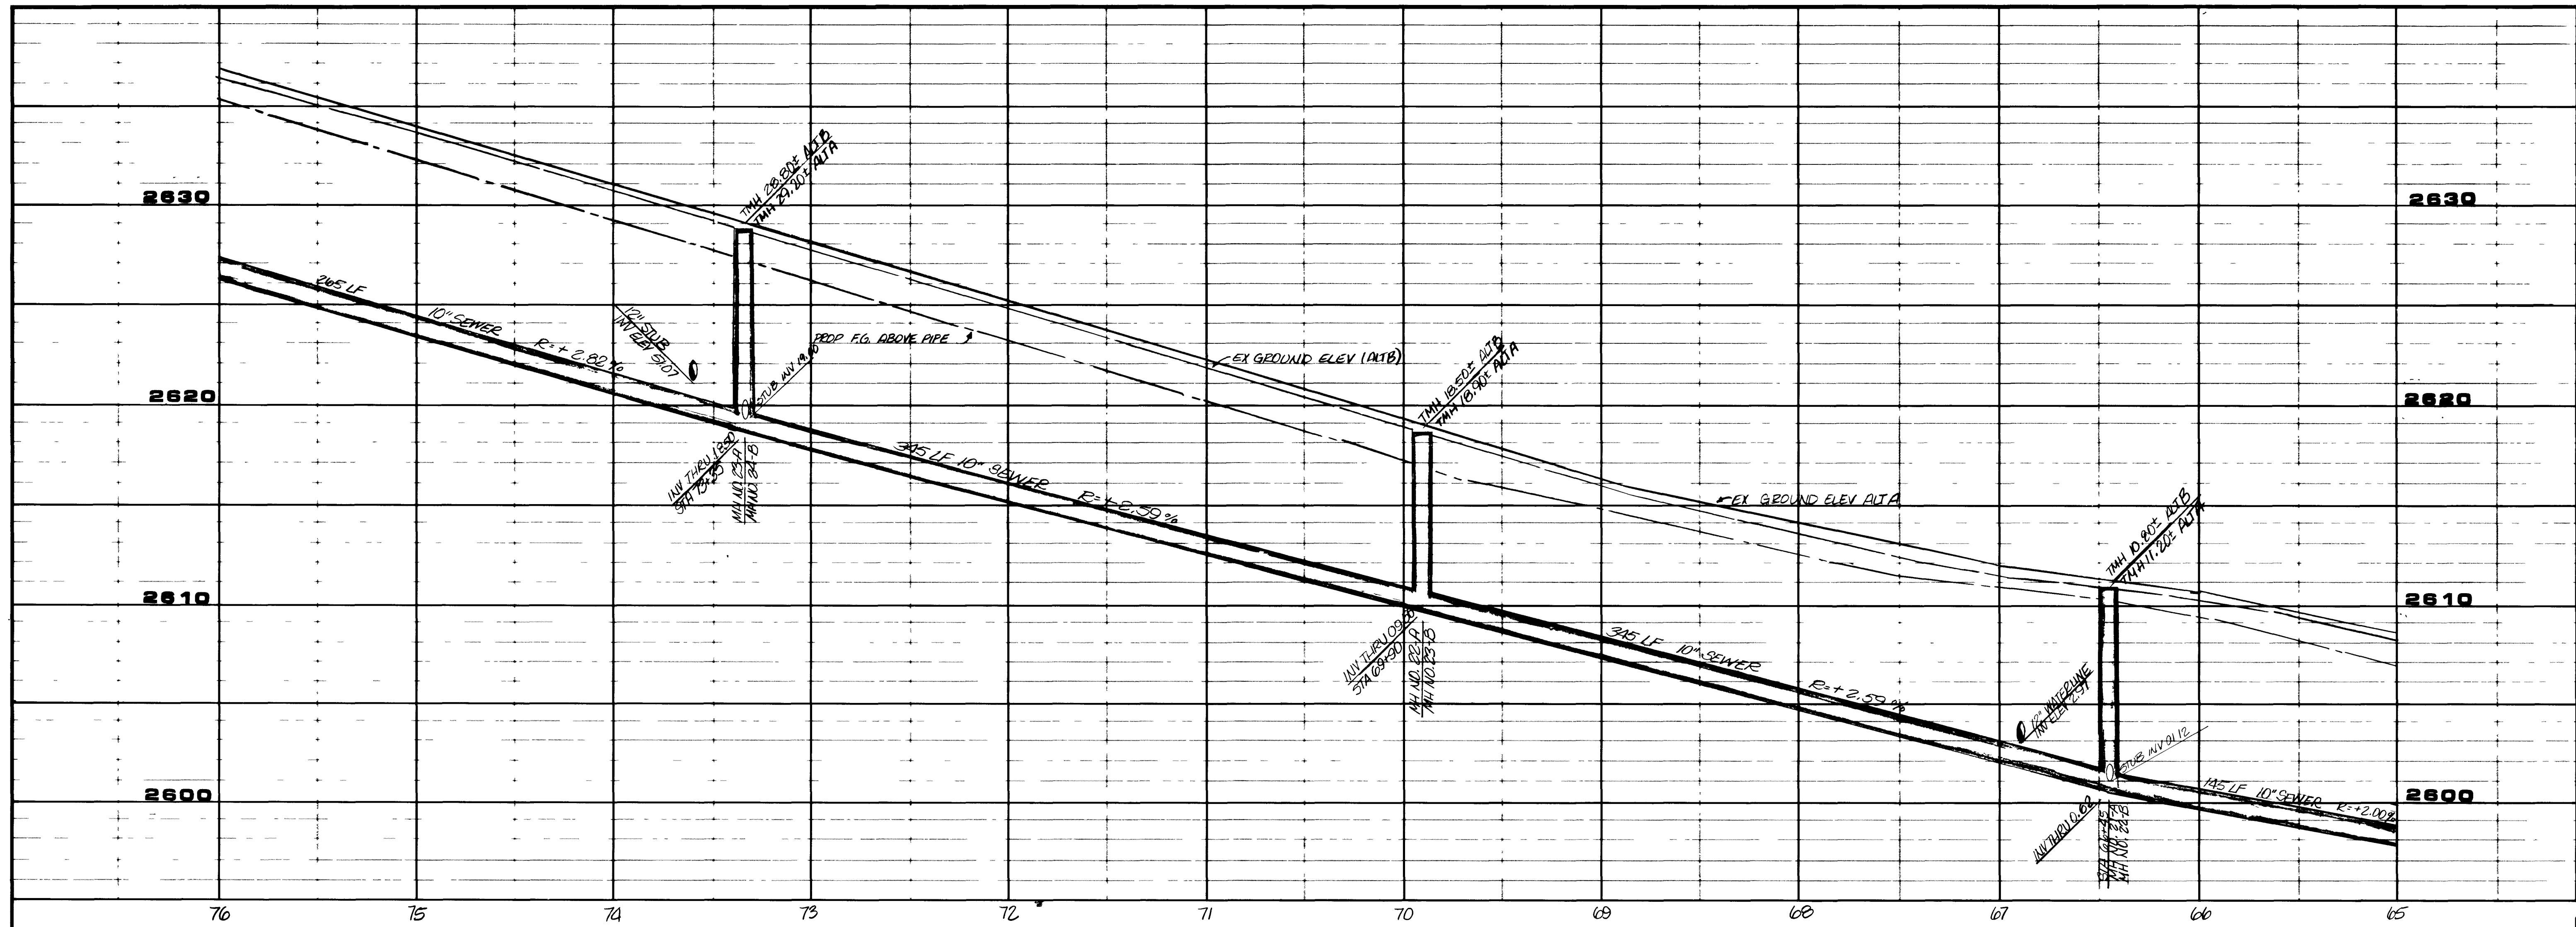

REV	DATE	BY	REVISION
1	4-22-82	AJB	AS BUILT

SUBMITTED BY	DATE
CHARLEY R. JOHNSON PE	

PLANNERS
2800 WEST SAHARA AVENUE
BUILDING 4 SUITE B
LAS VEGAS, NEVADA 89102
PHONE (702) 873-7550

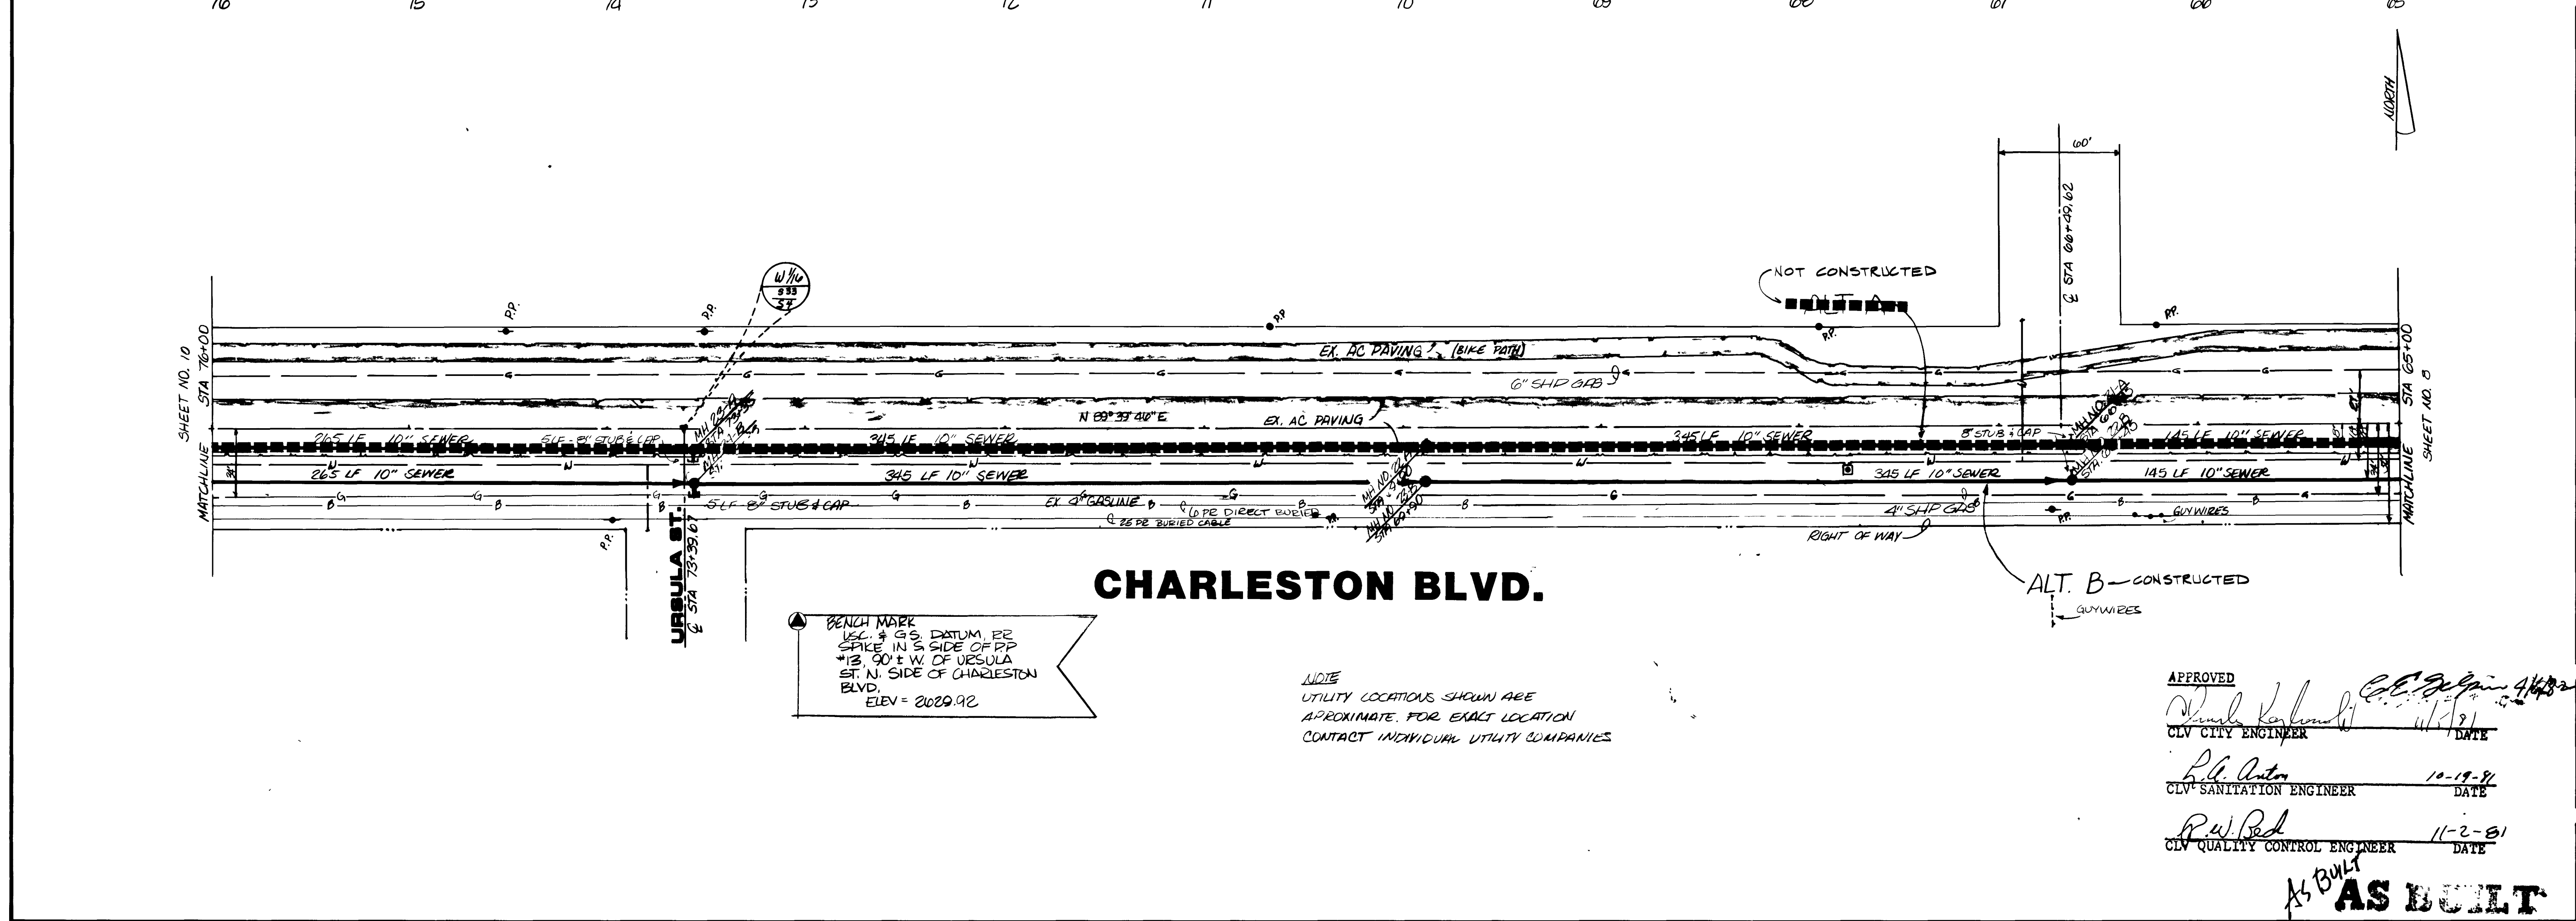

TITLE	PLAN & PROFILE
PROJECT	VALLEY WEST VIII OFF-SITE SEWER

WO NO	2580-3
BY	VE PAX
DATE	10-19-81
SCALE	1"=40'


SHEET	9
OF 12 SHEETS	

AS BUILT

5552

24-8-101

3078-3170-VIII

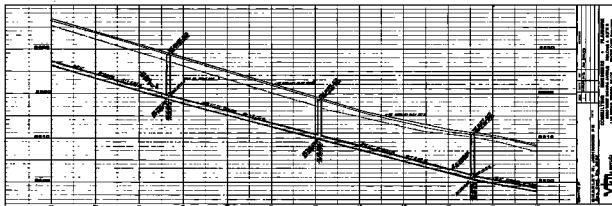

PROJECT NO. 10-1000
 DRAWING NO. 10-1000
 SHEET NO. 10-1000
 DATE 10-10-10
 BY 10-10-10
 CHECKED 10-10-10
 APPROVED 10-10-10



CHARLESTON BLVD.

10-10-10
 10-10-10
AS BUILT

PLAN & ELEVATION
 STA. 10+00 TO STA. 10+50
 VALLEY MEET VIA
 CONCRETE BRIDGE

10-10-10
 10-10-10
 10-10-10