
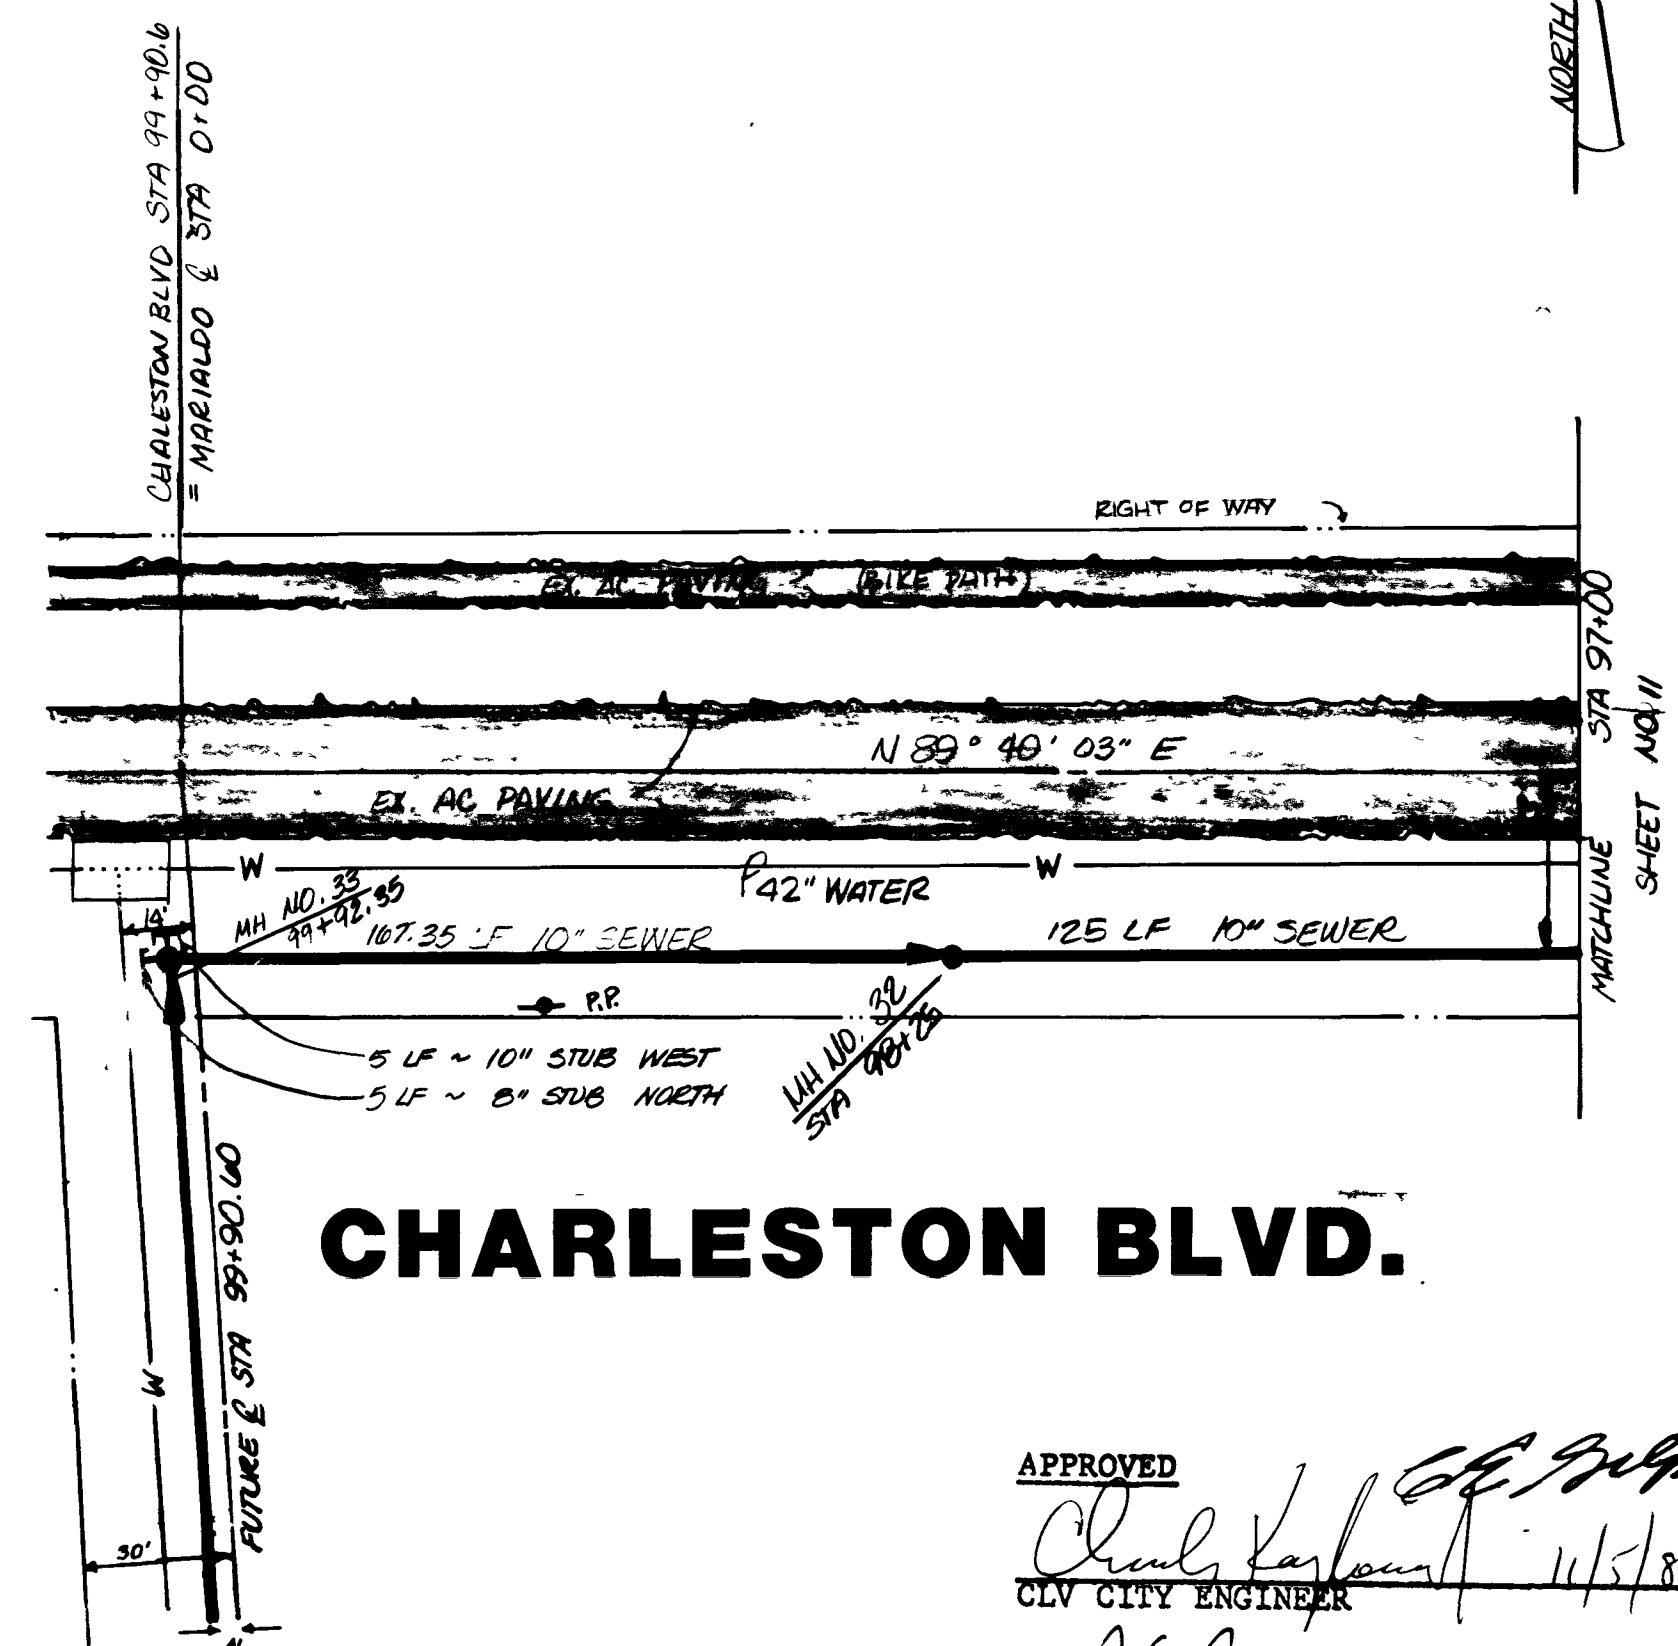


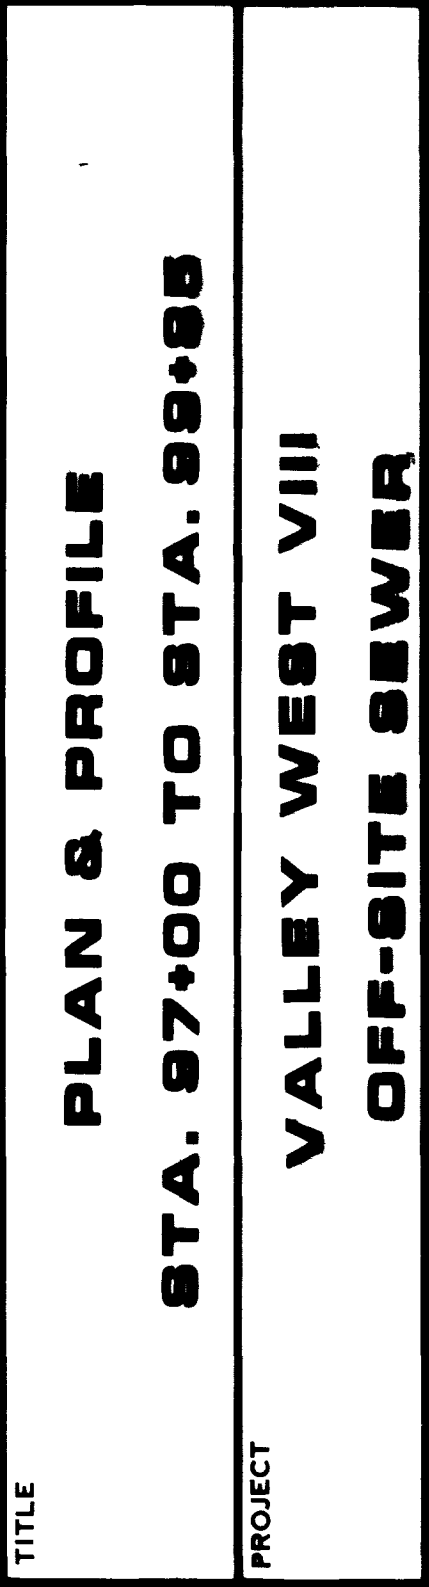

# CHARLESTON BLVD.

AS BUILT AS BUILT

SHEET

12

OF 12 SHEETS

**PLAN & PROFILE**  
**STA. 97+00 TO STA. 99+85**

**VALLEY WEST VIII**  
**OFF-SITE SEWER**

