


GENERAL NOTES


- CONTRACTOR TO NOTIFY SOUTHWEST GAS CORPORATION AT LEAST 48 HOURS PRIOR TO COMMENCEMENT OF WORK.
- CONTRACTOR SHALL, AT HIS OWN EXPENSE, LOCATE ALL OVERHEAD INTERFERENCES AND ELEVATION OF ALL UTILITIES (POTHOLING) AND SHALL TAKE NECESSARY PRECAUTIONS TO AVOID DAMAGE TO SAME.
- CONTRACTOR SHALL TAKE ALL NECESSARY PRECAUTIONS TO PREVENT ANY DAMAGE TO HIGH PRESSURE GAS MAINS, TELEPHONE OR ELECTRICAL CONDUIT, SENER, ETC.
- PROPOSED FINISH GRADE ABOVE PIPE IS FOR DESIGN PURPOSES ONLY. ALL CONSTRUCTION SHALL BE BROUGHT TO EXISTING FINISH GRADE UNLESS OTHERWISE SPECIFIED.
- ALL WORK SHALL CONFORM TO THE CITY OF LAS VEGAS STANDARD SPECIFICATIONS.

INDEX OF DRAWINGS


- COVER SHEET
- LOCATION PLAN & GENERAL INFORMATION
- PLAN & PROFILE - STA. 0+00 TO 10+00
- PLAN & PROFILE - STA. 10+00 TO 21+00
- PLAN & PROFILE - STA. 21+00 TO 32+00
- PLAN & PROFILE - STA. 32+00 TO 43+00
- PLAN & PROFILE - STA. 43+00 TO 54+00
- PLAN & PROFILE - STA. 54+00 TO 65+00
- PLAN & PROFILE - STA. 65+00 TO 76+00
- PLAN & PROFILE - STA. 76+00 TO 87+00
- PLAN & PROFILE - STA. 87+00 TO 97+00
- PLAN & PROFILE - STA. 97+00 TO 99+85

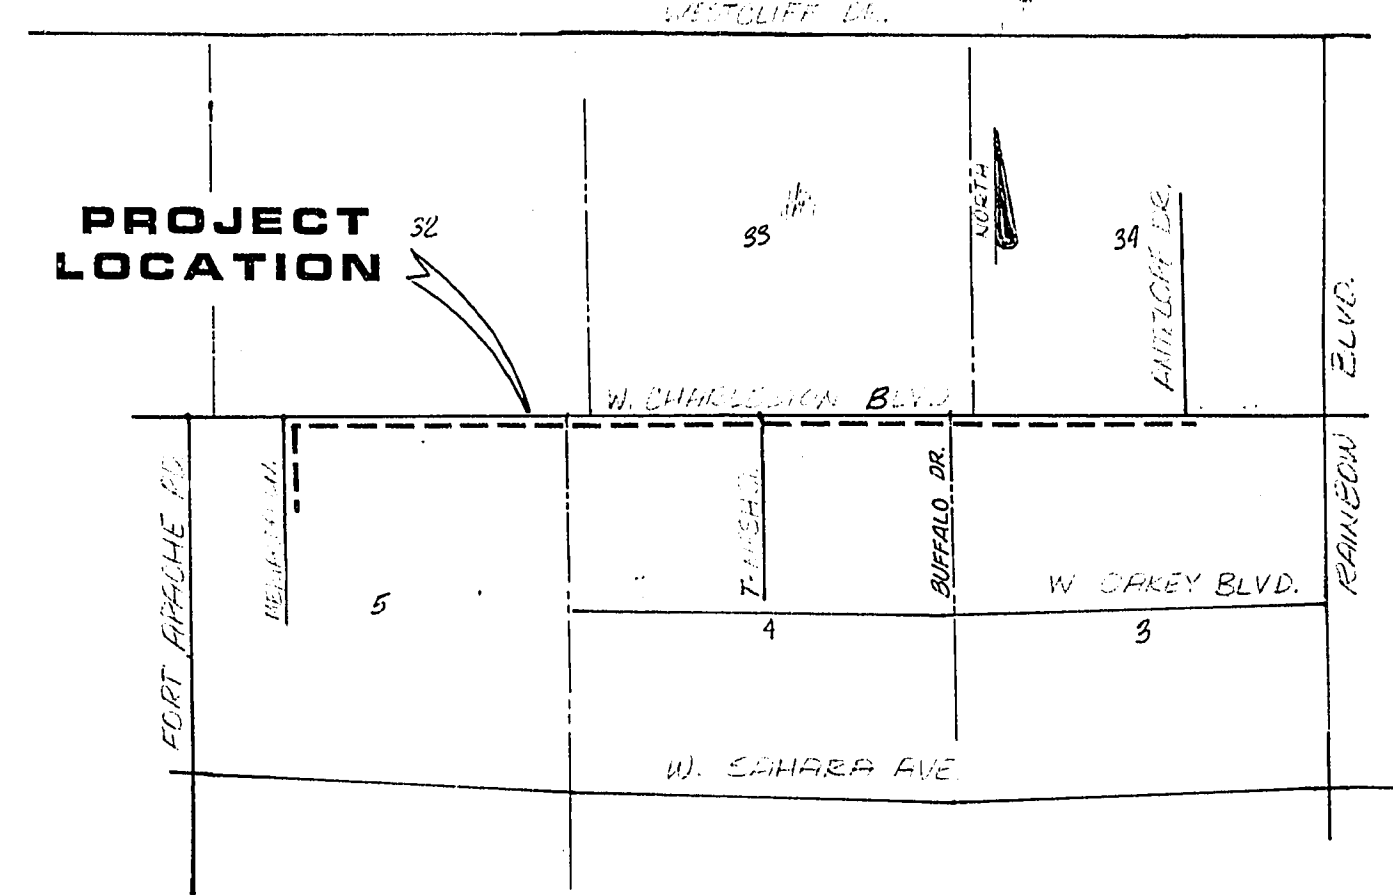


VICINITY MAP
(N.T.S.)

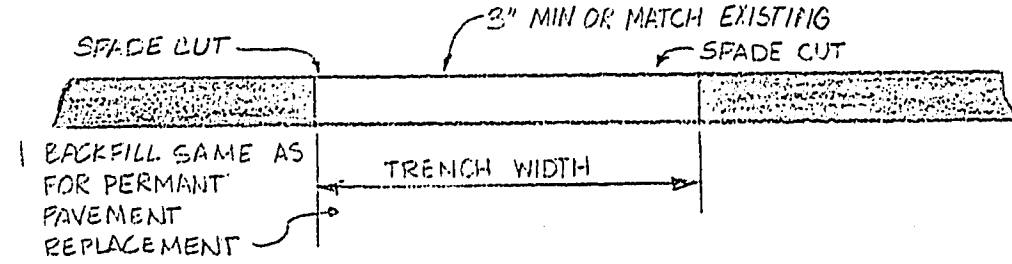

TEMPORARY PAVEMENT

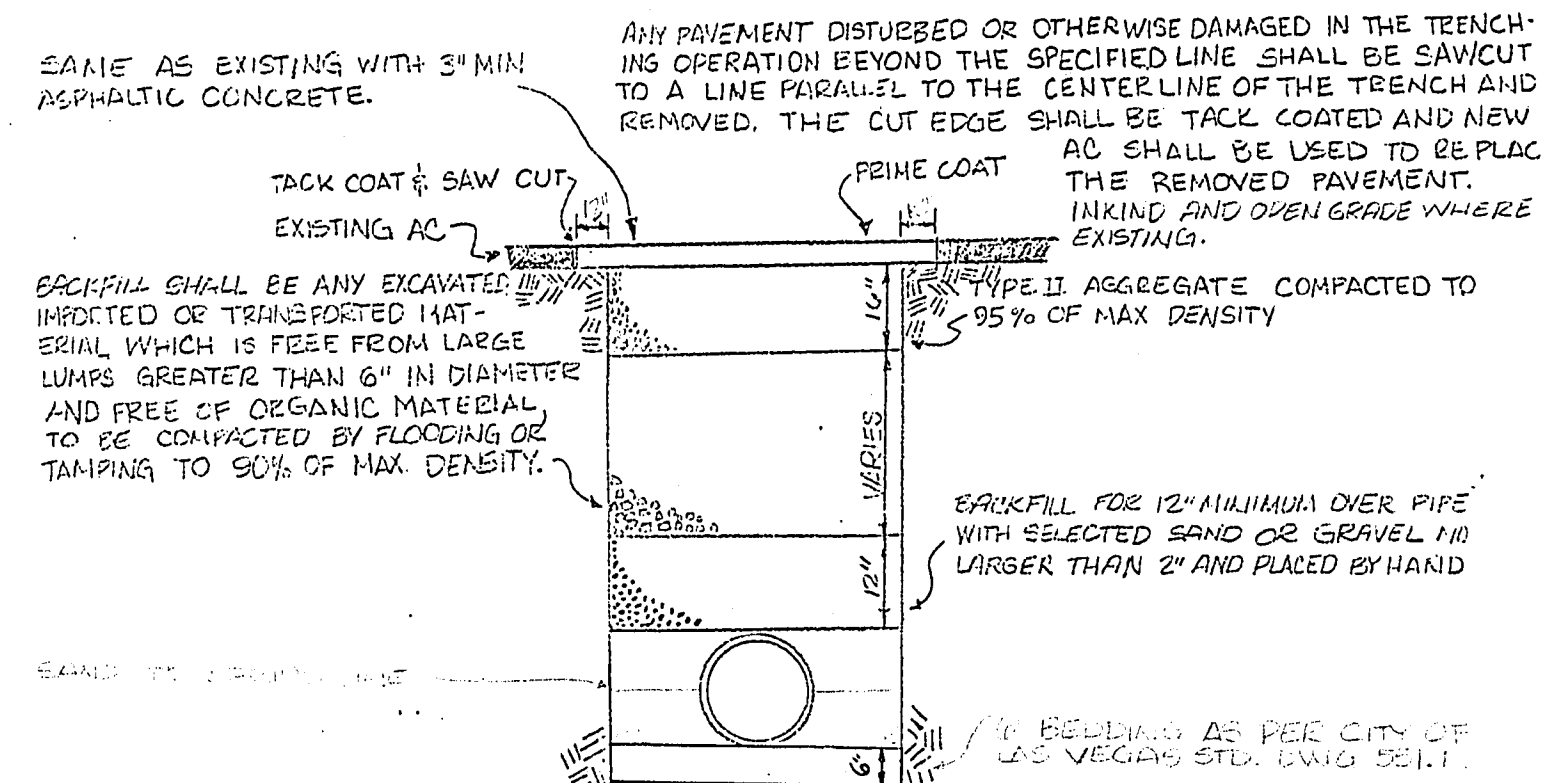

PERMANENT PAVEMENT

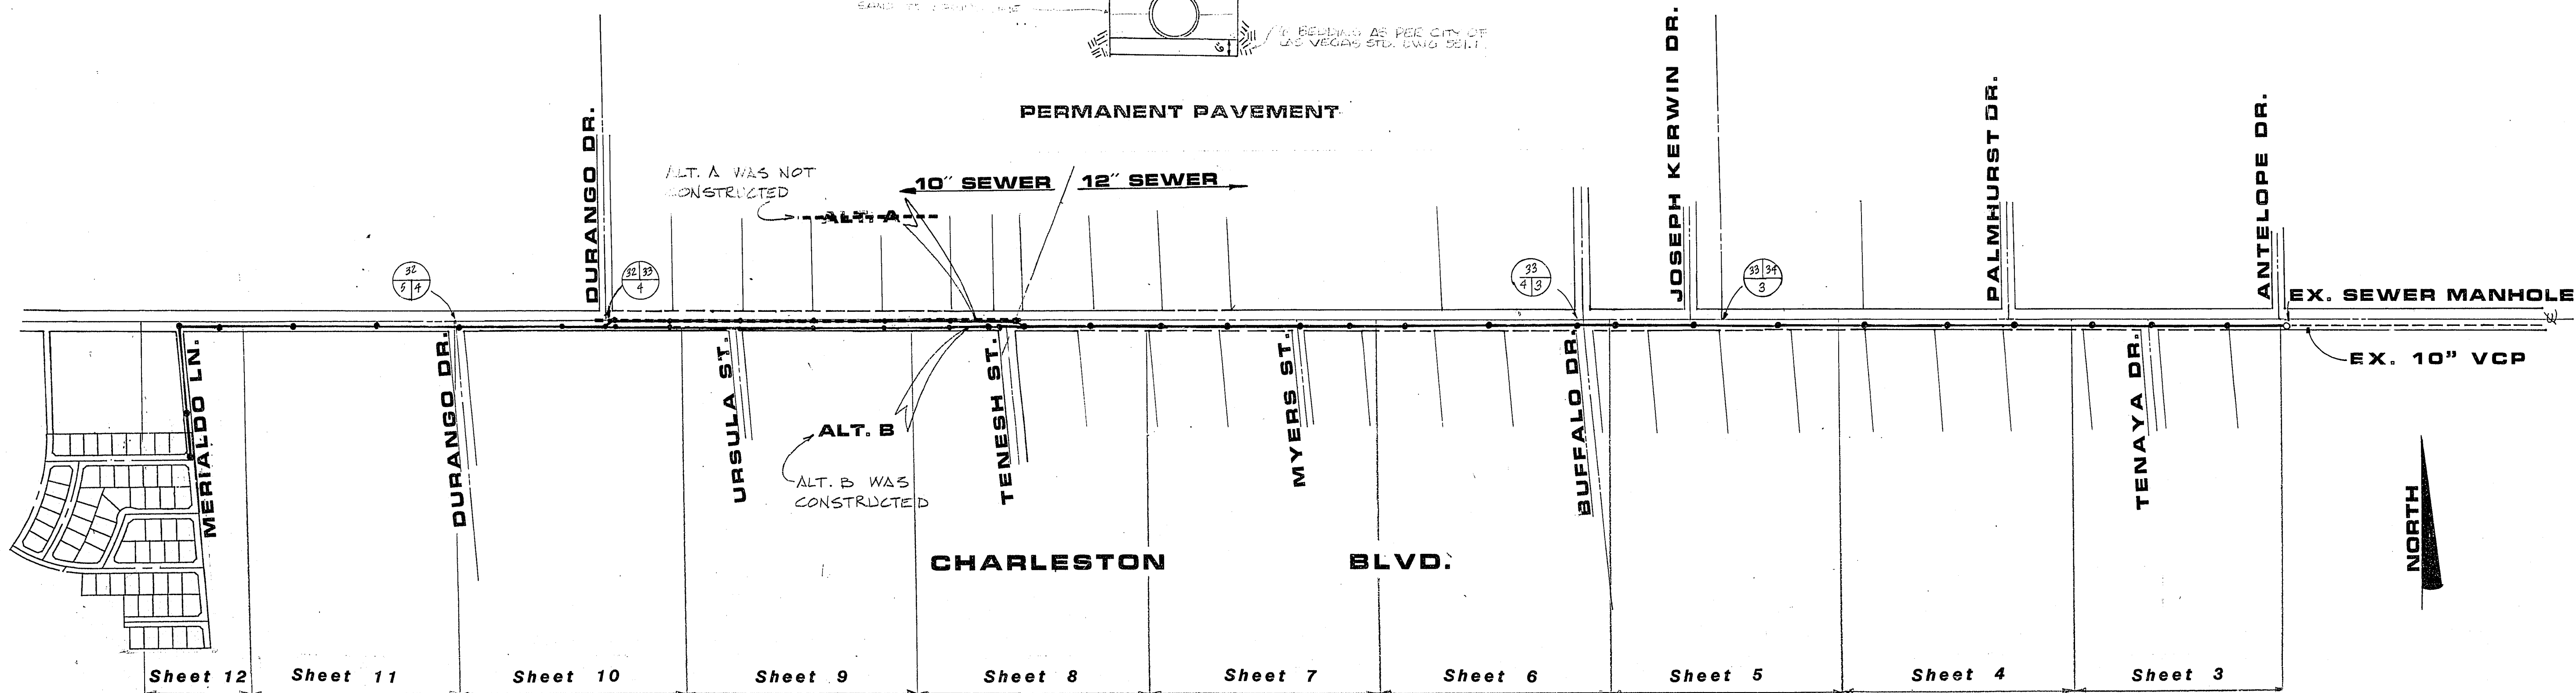

- Before any work is started in the right of way, the Contractor shall install all advance warning signs for the construction zone. The Contractor shall install temporary stop signs at all new street encroachments into existing County streets immediately after first grading work is accomplished, and shall maintain said signs until permanent signs are installed.
- All construction signing, barricading and traffic delineation shall conform to the "Nevada Traffic Control Manual."

DEVELOPER

BAILEY & McGAH
P.O. BOX 19102
LAS VEGAS, NEVADA
89119

BASIS OF BEARING

N. 89°41'33" E., BEING THE SOUTH LINE OF THE SOUTHEAST QUARTER (SE₄) OF SECTION 33, T. 20 S., R. 60 E., AS SHOWN BY CHARLESTON RAINBOW UNIT 15 ON FILE IN THE OFFICE OF THE COUNTY RECORDER, CLARK COUNTY, NEVADA, IN BOOK 20 OF PLATS, PAGE 20.

BENCH MARK

CLARK COUNTY BENCHMARK NO. CLONE04, BLM BRASS CAP, INTERSECTION OF CHARLESTON BOULEVARD & BUFFALO DRIVE.

ELEVATION = 2527.65

THE BENCHMARK USED FOR VALLEY WEST 8 OFF-SITE SEWER IS CLARK COUNTY B.M. NO. CLONE04 AT THE NORTHEAST CORNER OF SECTION 4, T. 21 S., R. 60 E.; THE EQUATION BETWEEN CLARK COUNTY DATUM AND CITY OF LAS VEGAS DATUM IS 2.04'. CLARK COUNTY DATUM + 2.04 = CITY DATUM.

LEGEND

- OR SECTION LINE
- RIGHT OF WAY LINE
- PROPOSED PIPE LINE & ALT. A
- ALT. B PIPE LINE
- INVERT OF PIPE
- MANHOLE
- EXISTING GRADE
- PROPOSED FINISH GRADE
- POWER POLE
- MONUMENT
- TTMH TEMPORARY TOP OF MANHOLE
- FTMH FINISHED GRADE TOP OF MANHOLE (PROPOSED)
- ▲ FIRE HYDRANT

QUANTITIES

ALT A
6834 LF 12" SEWER PIPE (PVC)
4729 LF 10" SEWER PIPE (PVC)
25 LF 8" SEWER PIPE (PVC)
34 SEWER MANHOLES

ALT B
6087 LF 12" SEWER PIPE (PVC)
4673 LF 10" SEWER PIPE (PVC)
25 LF 8" SEWER PIPE (PVC)
35 SEWER MANHOLES

APPROVAL

CLV CITY ENGINEER
CLV SANITATION ENGINEER
CLV QUALITY CONTROL ENGINEER

DATE 11/5/81
DATE 10-29-81
DATE 11-2-81

LOCATION PLAN

VALLEY WEST VIII
OFF-SITE SEWER

TITLE

WO NO. 2580-3

BY VE BAX

DATE

SCALE 1" = 400'

SHEET

2

OF 12 SHEETS

SUBMITTED BY

CHARLEY R. JOHNSON PE

DATE

REV

BY

DATE

REVISION

AS BUILT

REVISION

nevada

CONSULTING ENGINEERS

PLANNERS

BUILDING 4 SUITE B

PHONE (702) 873-7550

2800 WEST SAHARA AVENUE

LAS VEGAS, NEVADA 89102

PLANERS

26-8-14 3074-3170 VII