
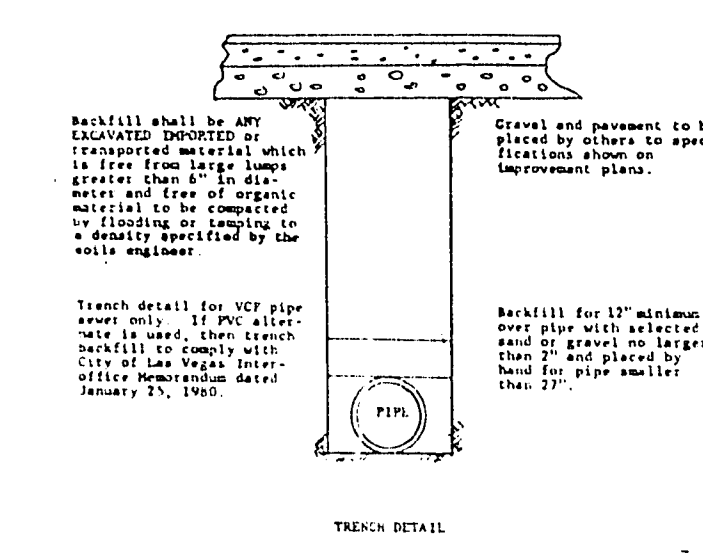
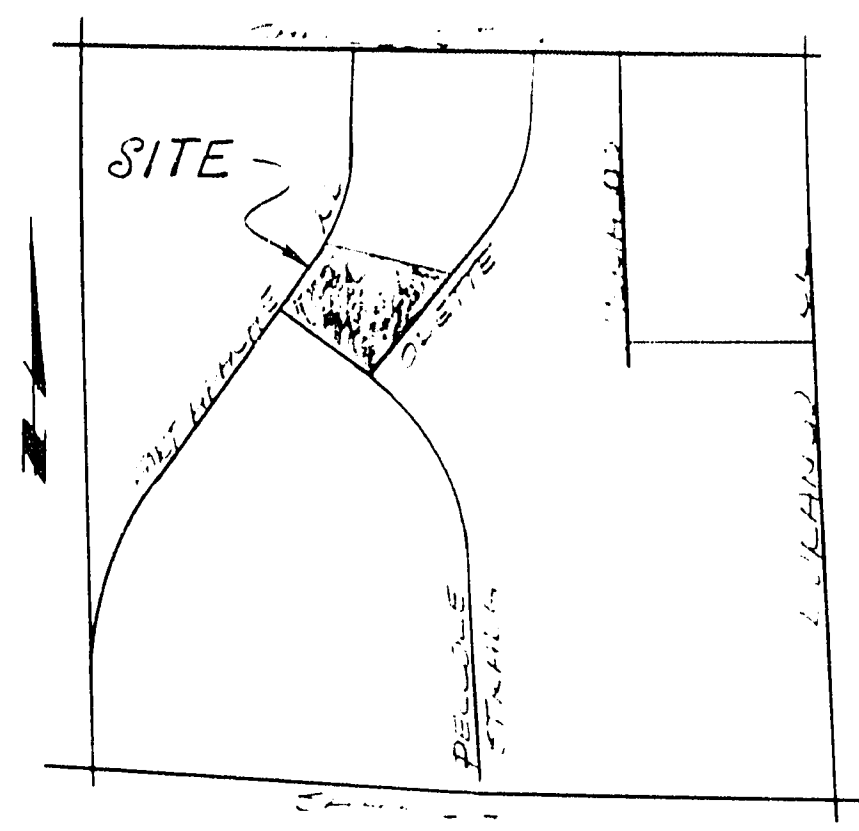


SEWER LATERAL "AS-BUILT"
CERTIFICATION

Gene D. Krammetbauer 1/28/87
GENE D. KRAMMETBAUER, P.L.S.
NEVADA CERT. NO. 6201 DATE

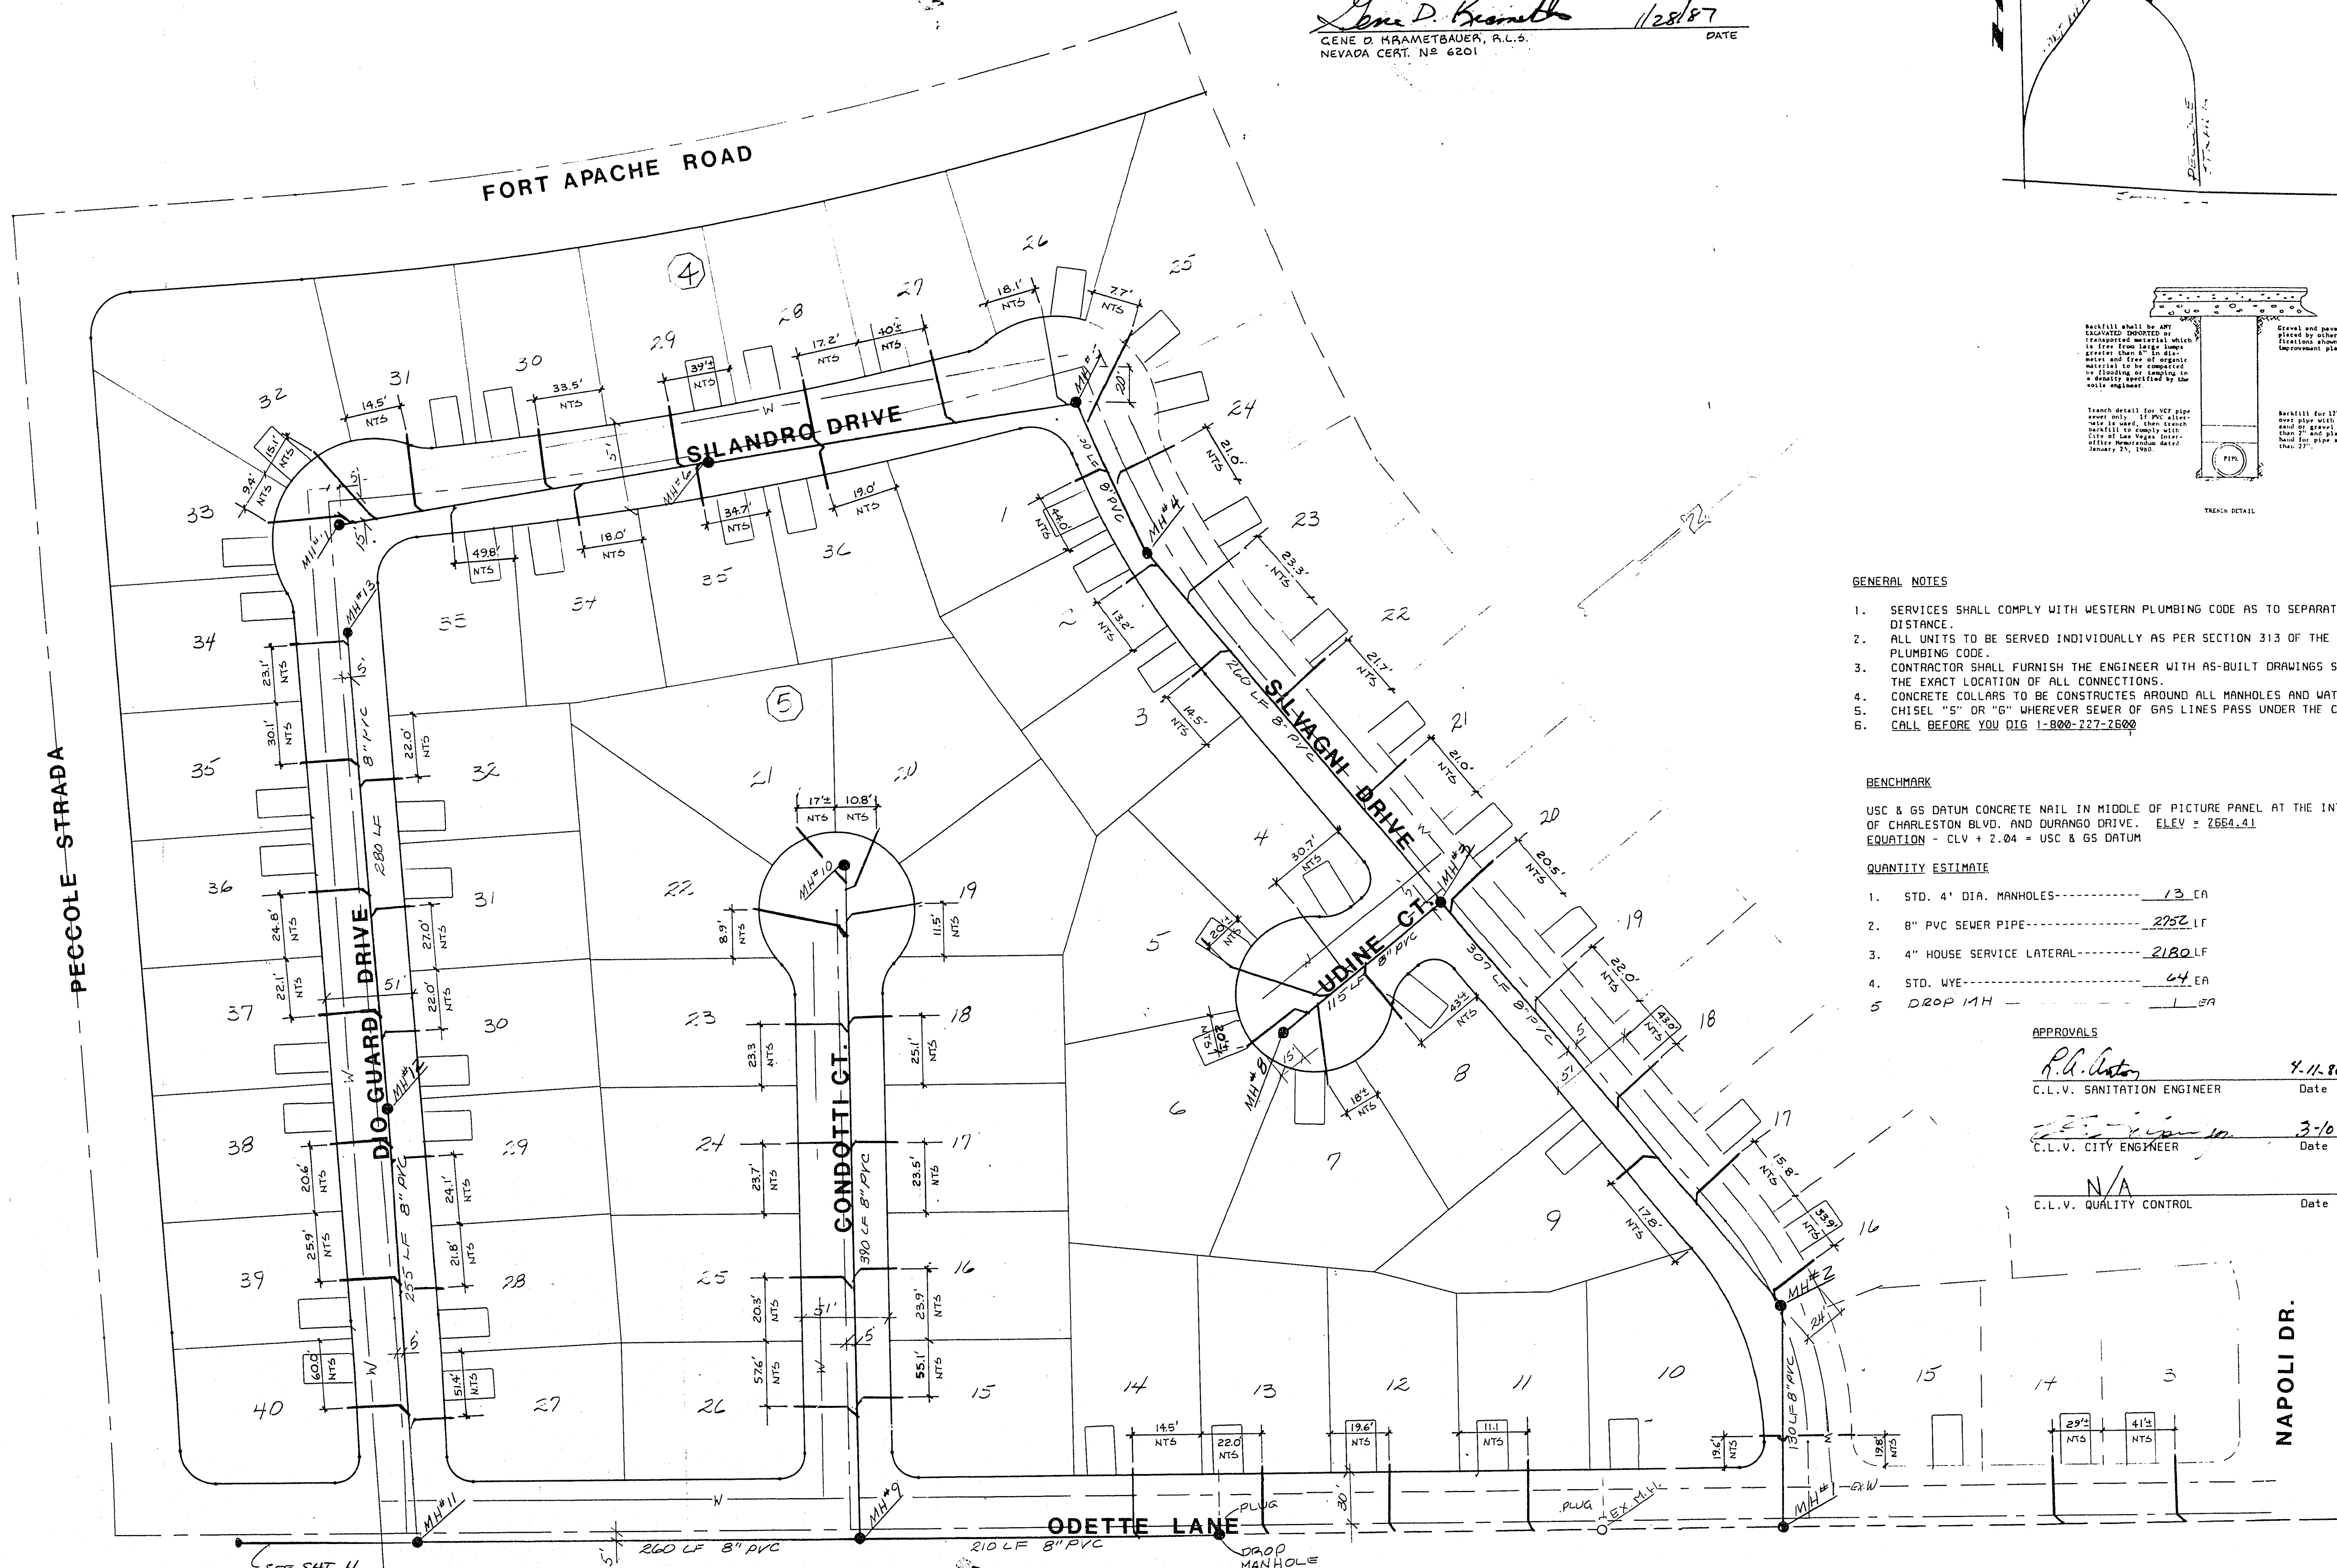

GENERAL NOTES

1. SERVICES SHALL COMPLY WITH WESTERN PLUMBING CODE AS TO SEPARATION DISTANCE.
2. ALL UNITS TO BE SERVED INDIVIDUALLY AS PER SECTION 313 OF THE UNIFORM PLUMBING CODE.
3. CONTRACTOR SHALL FURNISH THE ENGINEER WITH AS-BUILT DRAWINGS SHOWING THE EXACT LOCATION OF ALL CONNECTIONS.
4. CONCRETE COLLARS TO BE CONSTRUCTED AROUND ALL MANHOLES AND WATER VALVES.
5. CHISEL "S" OR "D" WHEREVER SEWER OR GAS LINES PASS UNDER THE CURB.
6. CALL BEFORE YOU DIG 1-800-227-2600

BENCHMARK

USC & GS DATUM CONCRETE NAIL IN MIDDLE OF PICTURE PANEL AT THE INTERSECTION OF CHARLESTON BLVD. AND DURANGO DRIVE. ELEV = 2664.41
EQUATION - CLV + 2.04 = USC & GS DATUM

QUANTITY ESTIMATE

- | | |
|----------------------------------|---------|
| 1. STD. 4" DIA. MANHOLES----- | 13 EA |
| 2. 8" PVC SEWER PIPE----- | 2752 LF |
| 3. 4" HOUSE SERVICE LATERAL----- | 2180 LF |
| 4. STD. WYE----- | 64 EA |
| 5. DROP MH----- | 1 EA |

APPROVALS

R.D. Carter 4/11/86
C.L.V. SANITATION ENGINEER Date
[Signature] 3/10/86
C.L.V. CITY ENGINEER Date
N/A
C.L.V. QUALITY CONTROL Date

MASTER SEWER PLAN

VALLEY WEST IX UNIT NO. 2

WO NO 3072-2
BY COS
DATE 4/7/86
SCALE 1" = 50'

SHEET
10R
OF SHEETS

CONSULTING ENGINEERS • PLANNERS
2300 PASEO DEL PRADO BUILDING A SUITE 100
LAS VEGAS, NEVADA 89102 PHONE (702) 873-7550

Gene D. Krammetbauer 1/28/87
vtm nevada

29-4.173 As Built 3074-3/70-IX-2