


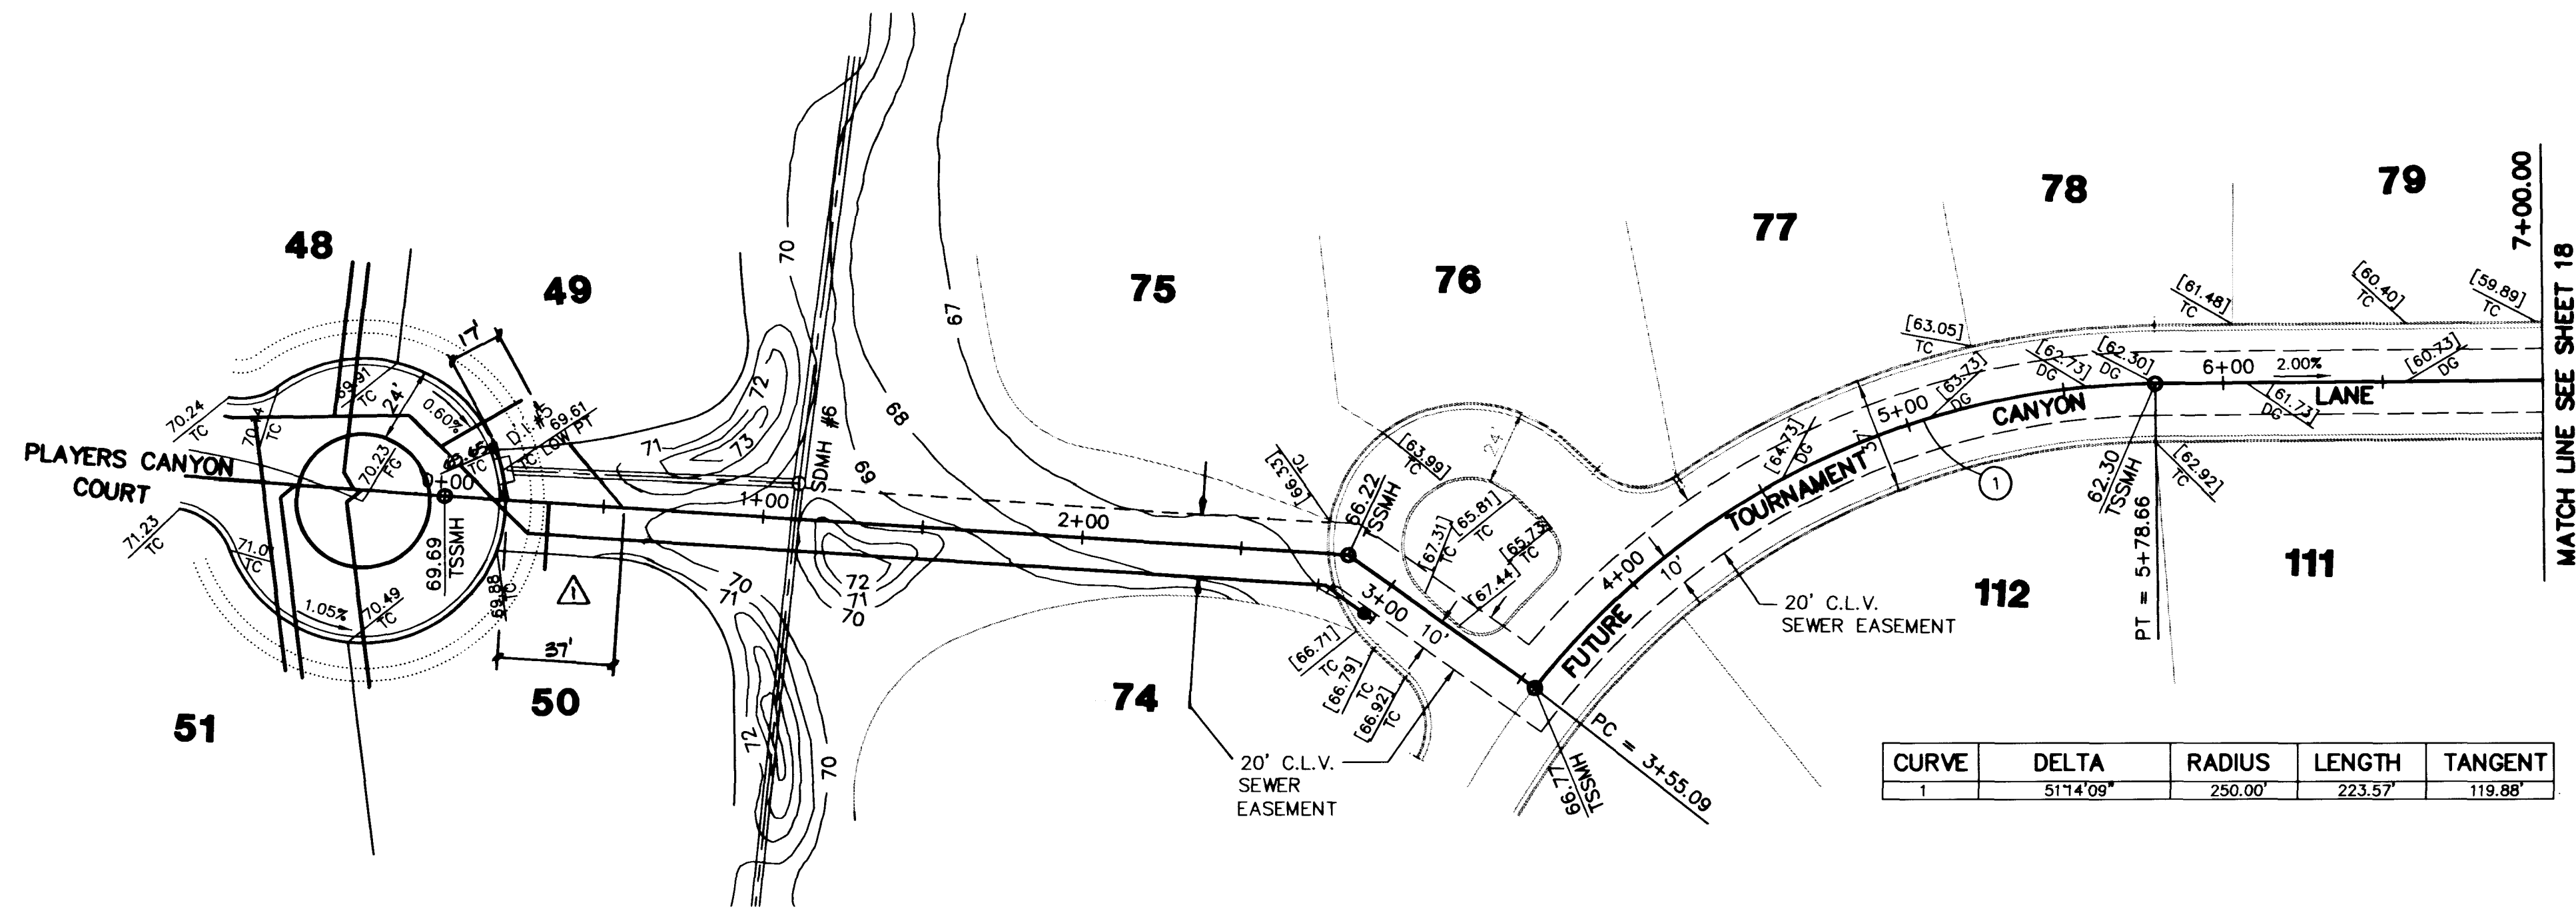


CURVE	DELTA	RADIUS	LENGTH	TANGENT
1	51°14'08"	250.00'	223.57'	119.88'

SEWER EXTENSION

SCALE: HORIZ. 1" = 40'
VERT. 1" = 4'

RECORD DRAWINGS
THESE PLANS SHOW RECORD INFORMATION RECEIVED FROM:
CONTRACTOR: BULLDOG EQUIPMENT COMPANY
DATE: 05/23/97
THIS DATA MAY OR MAY NOT REFLECT THE ACTUAL
FIELD LOCATIONS. ALL DATA SHOULD BE CONFIRMED
PRIOR TO USE ON DEVELOPMENT OR ENGINEERING
PLANS.

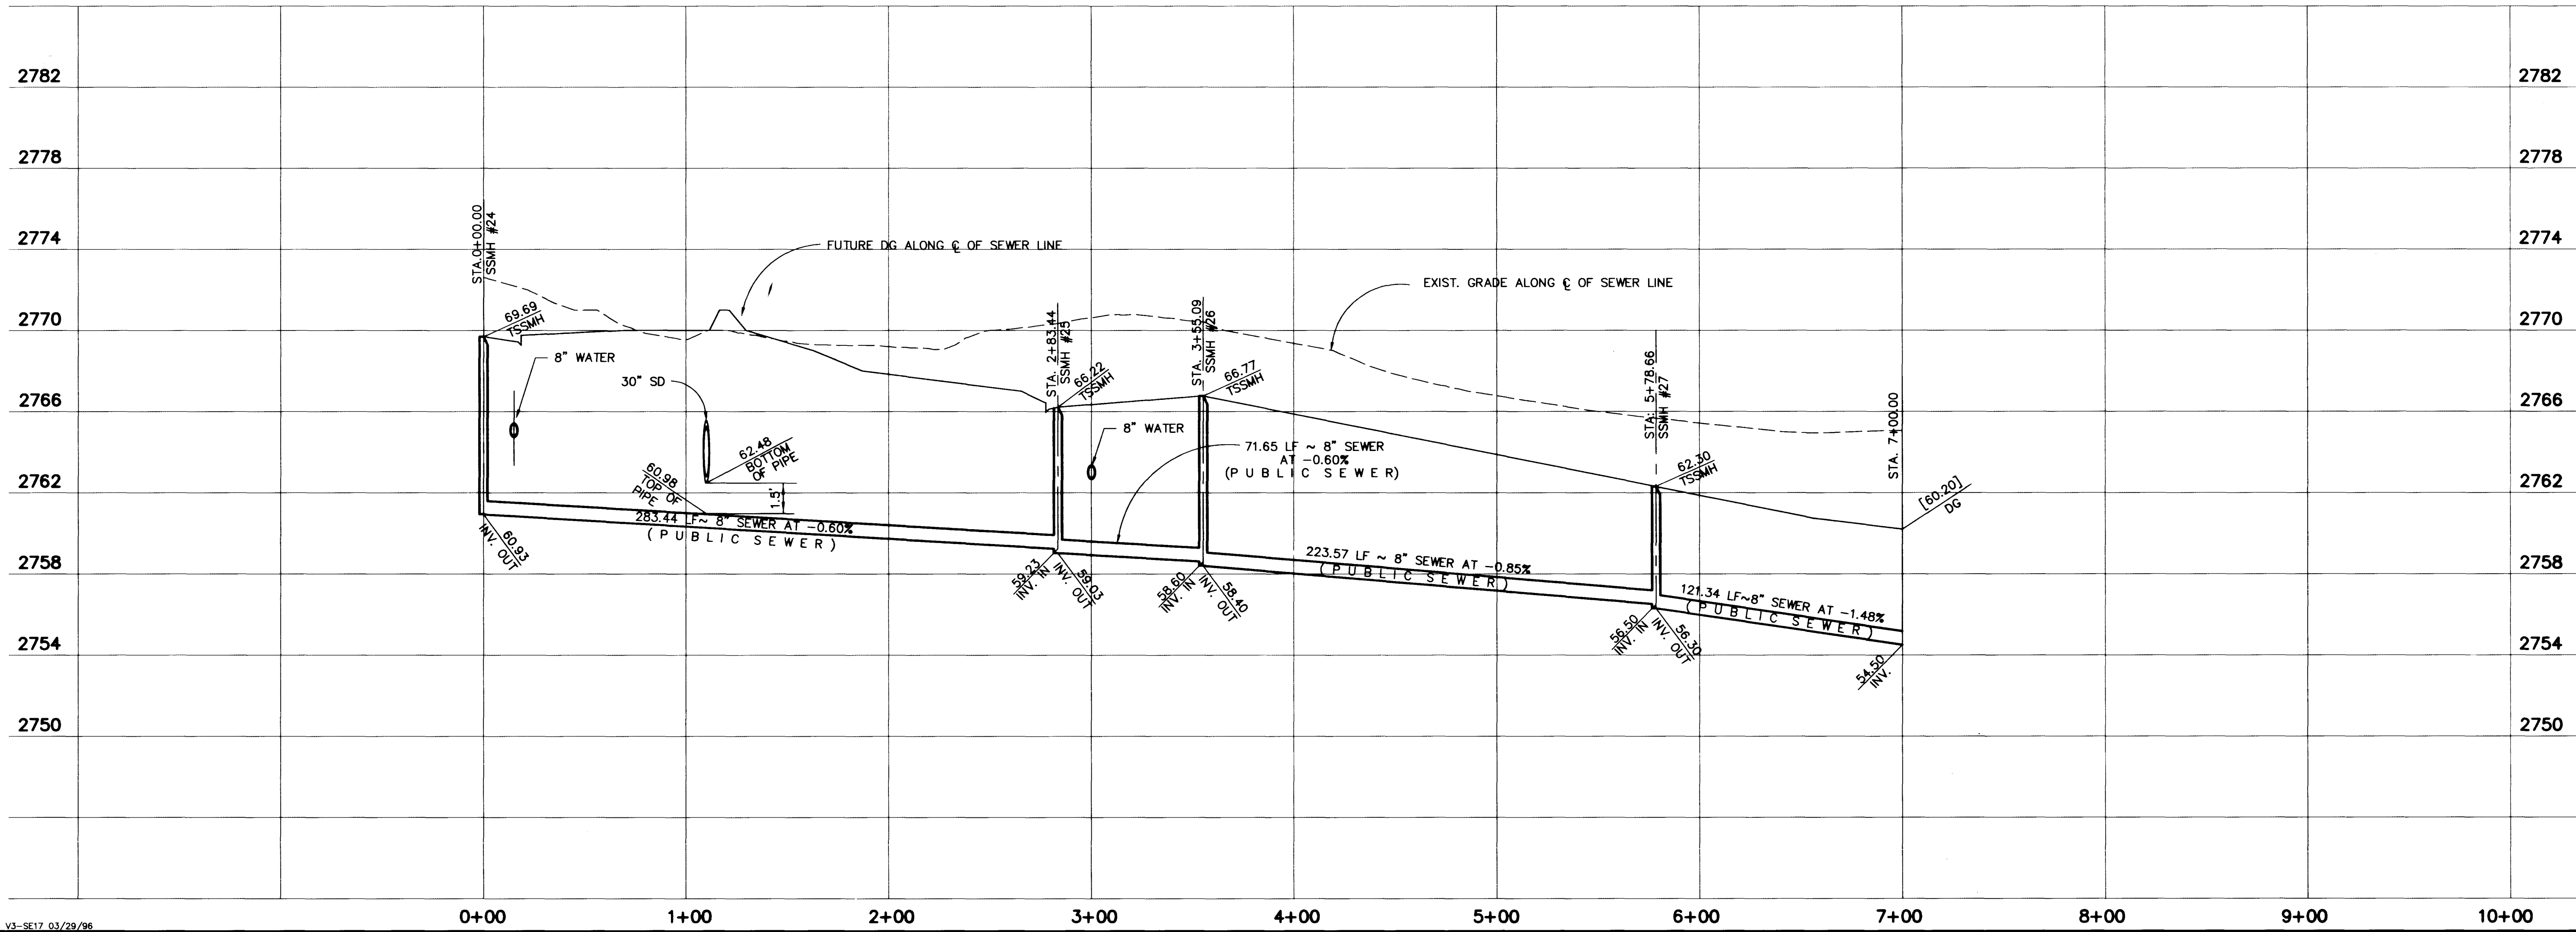

RECOMMENDED BY
ENGINEER
DATE
APPROVAL
DATE

RECORD DRAWINGS
DATE
REVISION
DATE
DESCRIPTION

RECOMMENDED BY
ENGINEER
DATE
APPROVAL
DATE

RECORD DRAWINGS
DATE
REVISION
DATE
DESCRIPTION

RECOMMENDED BY
ENGINEER
DATE
APPROVAL
DATE

RECORD DRAWINGS
DATE
REVISION
DATE
DESCRIPTION

RECOMMENDED BY
ENGINEER
DATE
APPROVAL
DATE


RECORD DRAWINGS
DATE
REVISION
DATE
DESCRIPTION

SUMMERLIN
VILLAGE 3 CUSTOM LOTS - PHASE 1
TOURNAMENT CANYON LANE
PLAN & PROFILE-SEWER EXTENSION
STA. 0+00.00 TO STA. 7+00.00

SHEET
17

SHT 17 OF 23

G. C. WALLACE, INC.
Engineering/Architecture
1555 SOUTH RAINBOW BLVD./LAS VEGAS, NEVADA 89108

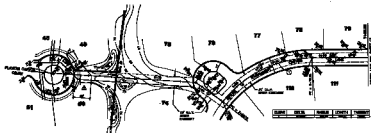

SEWER EXTENSION

SCALE: HORIZ. 1" = 40'
VERT. 1" = 5'

NOTED: OWNER
 THIS PLAN IS FOR RECORD INFORMATION ONLY AND
 DOES NOT CONSTITUTE A CONTRACT.
 THE OWNER AND THE ENGINEER SHALL BE RESPONSIBLE FOR THE
 FINAL DESIGN, ALL DETAILS AND THE CONSTRUCTION OF THE
 PROJECT AND THE CONTRACTOR SHALL BE RESPONSIBLE FOR THE
 CONSTRUCTION OF THE PROJECT.

