

Call before you Dig
1-800-227-2600

PHASE 1 - FUTURE SERVICE(S) (3/4" THROUGH 2")

IF ANY OF THE SERVICE(S) INSTALLED FOR FUTURE LOTS 64 & 65, BK.1 ARE INCORRECTLY LOCATED OR ARE NOT USED FOR ANY REASON, WHEN THE LOTS ARE DEVELOPED, THE DEVELOPER SHALL ABANDON THE LATERALS AT THE CONNECTION TO THE ACTIVE MAIN IN ACCORDANCE WITH THE DISTRICT'S STANDARDS AND AT THE DEVELOPER'S EXPENSE.




PHASE 3 - FUTURE SERVICE(S) (3/4" THROUGH 2")

IF ANY OF THE SERVICE(S) INSTALLED FOR FUTURE LOTS 84, BK.4 ARE INCORRECTLY LOCATED OR ARE NOT USED FOR ANY REASON, WHEN THE LOTS ARE DEVELOPED, THE DEVELOPER SHALL ABANDON THE LATERALS AT THE CONNECTION TO THE ACTIVE MAIN IN ACCORDANCE WITH THE DISTRICT'S STANDARDS AND AT THE DEVELOPER'S EXPENSE.

PHASE 4 - EXISTING SERVICES LOTS 64 & 65, BK.1 AND LOT 84, BK.4


IF ANY OF THE EXISTING SERVICES ARE INCORRECTLY LOCATED OR ARE NOT USED FOR ANY REASON, THE DEVELOPER SHALL ABANDON THE LATERALS AT THE CONNECTION TO THE ACTIVE MAIN IN ACCORDANCE WITH THE DISTRICT'S STANDARDS AND AT THE DEVELOPER'S EXPENSE.

BENCHMARK
CITY OF LAS VEGAS BENCH MARK NO. 01000 21E4
R.I. & DRIVE PLATE IN TOP OF CURB, NW RETURN
OF BUFFALO DR. AND LAKE MEAD BLVD.
ELEVATION ~ 2425.487

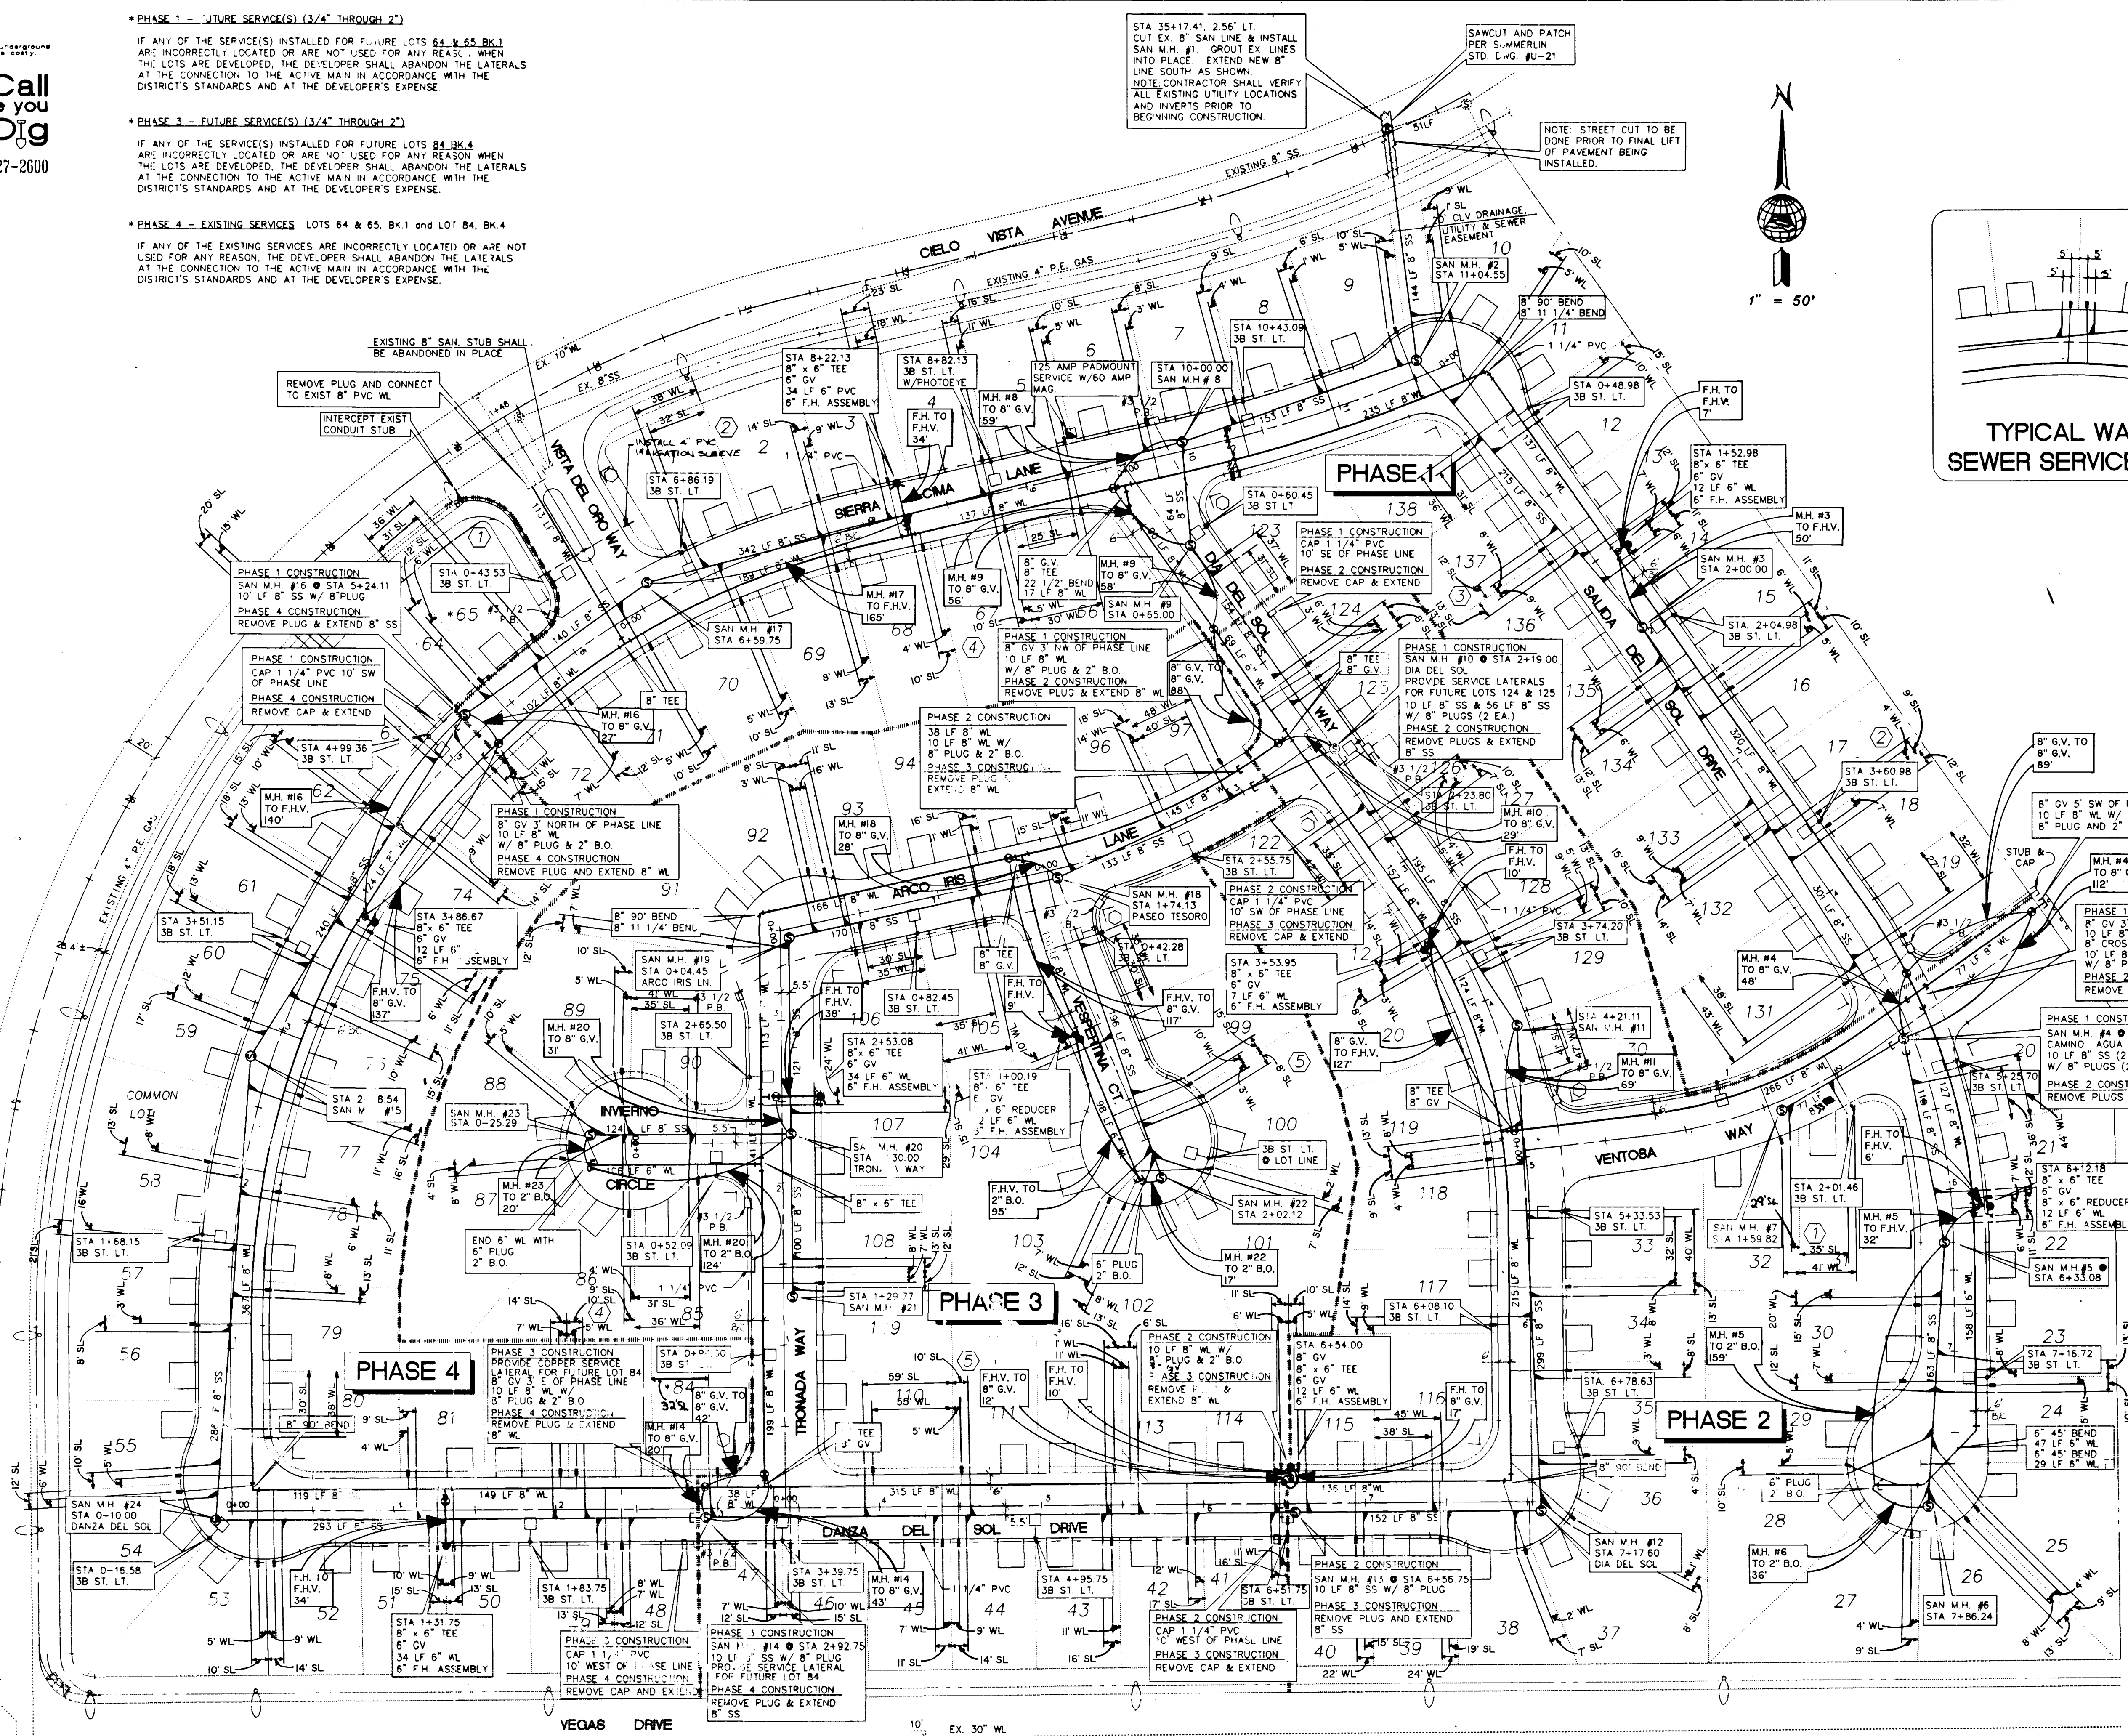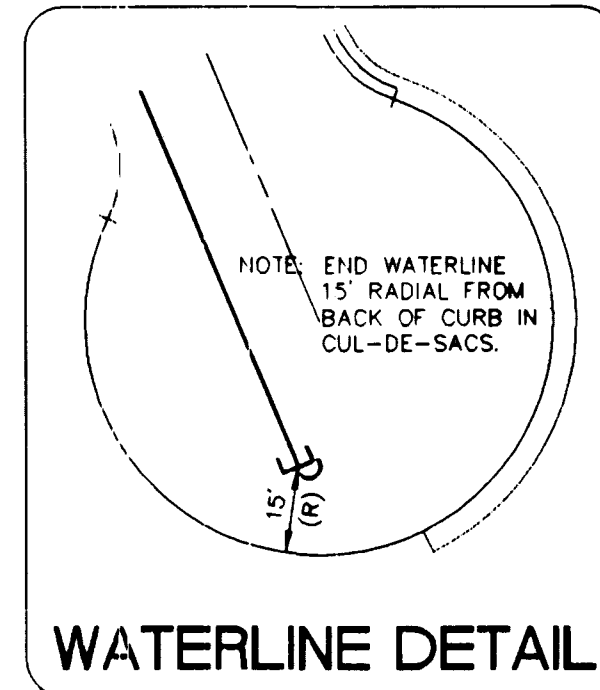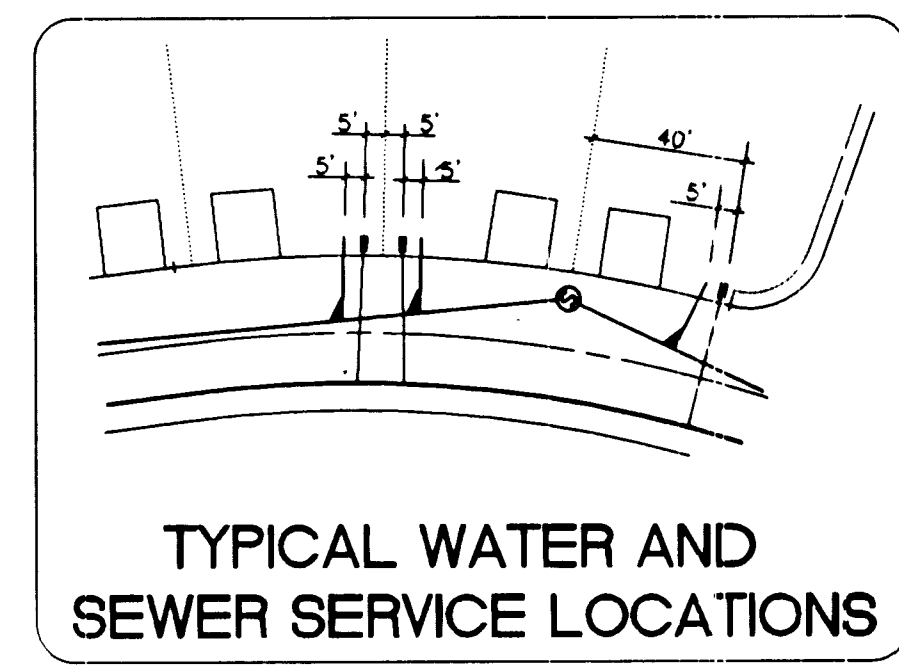

FIRE FLOW INFORMATION - C.L.V. FIRE DEPARTMENT
THE FIRE FLOW REQUIREMENT IS 1500 GPM AT 20 PSI RESIDUAL PRESSURE. THIS REQUIREMENT IS BASED UPON SQUARE FOOTAGE FOR TYPE V NR CONSTRUCTION. THE FLOW INDICATED IS THE MINIMUM ALLOWED BY CLVD FOR SINGLE FAMILY RESIDENTIAL CONSTRUCTION.
City of Las Vegas Fire Department
3/17/93
DATE
VISTA DEL ORO, PHASE 1
3/18/93
DATE
VISTA DEL ORO, PHASE 2
8/13/93
DATE
VISTA DEL ORO, PHASE 3
12-14-93
DATE
VISTA DEL ORO, PHASE 4
12-14-93
DATE

NOTE: REFERENCE SHEET 14 FOR UTILITY NOTES

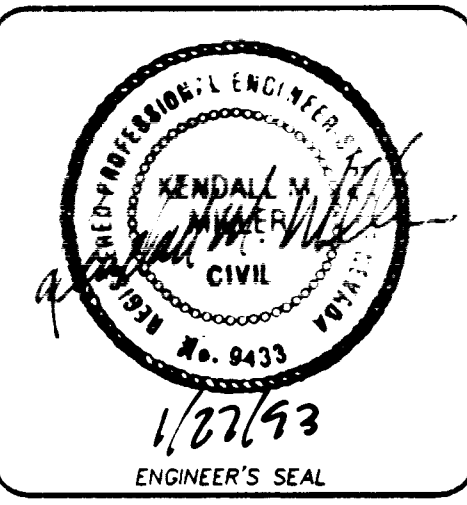

Job Number	Scale	Drawn by	Checked by	Date	Plot Date
7118.471	1" = 50'	MM	MM	JAN 26, 1993	1/26/93
Sheet Number	File No.	Drawn by	Checked by	Date	Plot Date
5 OF 14	471IMP	MM	MM	JAN 26, 1993	1/26/93


AS-BUILTS PROVIDED BY
KBECH ENTERPRISE 8/27/99
UTILITY AND SIGNAGE PLAN
VISTA DEL ORO
THE PUEBLO AT SUMMERLIN
Phases 1,2,3 & 4

Church Engineering of Nevada, Inc.
6600 W. Charleston Blvd.
Suite 140
Las Vegas, NV 89102
(702) 879-6244

1. THIS PLAN IS A PRELIMINARY DESIGN AND IS NOT TO BE USED FOR CONSTRUCTION. IT IS THE RESPONSIBILITY OF THE USER TO OBTAIN ALL NECESSARY PERMITS AND TO VERIFY THE ACCURACY OF THE INFORMATION SHOWN HEREON.
 2. THE USER SHALL BE RESPONSIBLE FOR OBTAINING ALL NECESSARY PERMITS AND FOR VERIFYING THE ACCURACY OF THE INFORMATION SHOWN HEREON.
 3. THE USER SHALL BE RESPONSIBLE FOR OBTAINING ALL NECESSARY PERMITS AND FOR VERIFYING THE ACCURACY OF THE INFORMATION SHOWN HEREON.

1. THIS PLAN IS A PRELIMINARY DESIGN AND IS NOT TO BE USED FOR CONSTRUCTION. IT IS THE RESPONSIBILITY OF THE USER TO OBTAIN ALL NECESSARY PERMITS AND TO VERIFY THE ACCURACY OF THE INFORMATION SHOWN HEREON.
 2. THE USER SHALL BE RESPONSIBLE FOR OBTAINING ALL NECESSARY PERMITS AND FOR VERIFYING THE ACCURACY OF THE INFORMATION SHOWN HEREON.
 3. THE USER SHALL BE RESPONSIBLE FOR OBTAINING ALL NECESSARY PERMITS AND FOR VERIFYING THE ACCURACY OF THE INFORMATION SHOWN HEREON.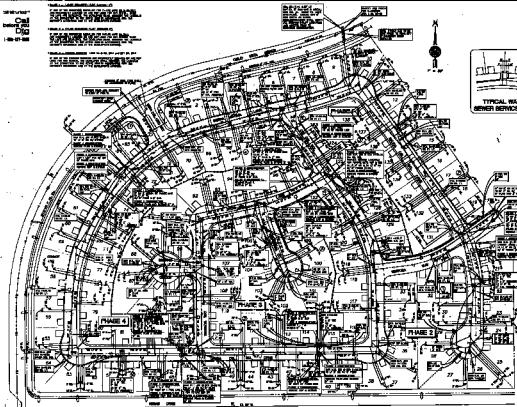

Project No.	3077-100-1
Sheet No.	1 of 1
Scale	1" = 10'
Author	City of Vista
Check	City of Vista
Approved	City of Vista
Date	11/11/11
Project Name	Vista del Oro
Project Location	1/2 Mile S. of Vista, Del Norte County, California
Project Description	Water and Sewer Service Locations
Project Status	Pre-Design
Project Budget	\$100,000
Project Owner	City of Vista
Project Manager	City of Vista
Project Engineer	City of Vista
Project Designer	City of Vista
Project Checker	City of Vista
Project Approver	City of Vista
Project Date	11/11/11
Project Version	1.0
Project Revision	1.0
Project Change	1.0
Project Update	1.0
Project Status	Pre-Design
Project Budget	\$100,000
Project Owner	City of Vista
Project Manager	City of Vista
Project Engineer	City of Vista
Project Designer	City of Vista
Project Checker	City of Vista
Project Approver	City of Vista
Project Date	11/11/11
Project Version	1.0
Project Revision	1.0
Project Change	1.0
Project Update	1.0