


# ROOF FRAMING NOTES:

1. SEE FRAMING NOTES SHEET S-0 FOR ROOF SHEATHING.
2. SEE ARCHITECTURAL DRAWINGS FOR WALL PARTITION LOCATIONS (BELOW) AND DIMENSIONS NOT SHOWN OR NOTED.
3. TRUSS MANUFACTURER SHALL VERIFY ALL DIMENSIONS WITH ARCHITECTURAL DRAWINGS AND COORDINATE WITH MECHANICAL SUBCONTRACTOR FOR THE SIZE, LOCATION AND DIMENSIONS OF ALL MECHANICAL UNITS & OPENINGS.
4. SEE (1) FOR HEADER SCHEDULE UNLESS NOTED ON PLAN.
5. TRUSS MANUFACTURER TO SUBMIT CALCULATIONS TO BUILDING OFFICIAL FOR APPROVAL.
6. SEE (2) FOR NON-BEARING PARTITION ATTACHMENT TO ROOF TRUSS.

| DATE     | REVISION        |
|----------|-----------------|
| 04/19/95 | RECORD DRAWINGS |


POGGEMEYER DESIGN GROUP  
ENGINEERS PLANNERS SURVEYORS  
1140 ALMOND TREE LANE, SUITE 306 LAS VEGAS, NEVADA 89104 (702) 735-5108

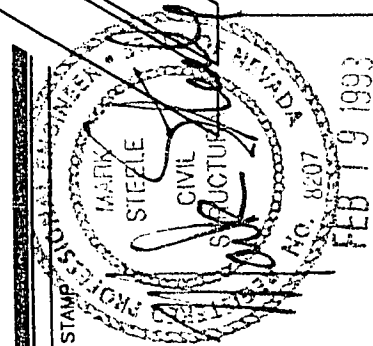

FRAMING PLAN - BLDG. & SAFETY  
WEST SERVICE CENTER  
PHASE I  
B. & S., Q.C., & SANT. SITES

|              |          |
|--------------|----------|
| JOB NUMBER   | 91012    |
| DESIGNED BY  | MS       |
| DRAWN BY     | JDS      |
| CHECKED BY   | MS       |
| DATE         | 1/15/92  |
| SHEET NUMBER | 41 of 78 |


S1-2  
OF 11

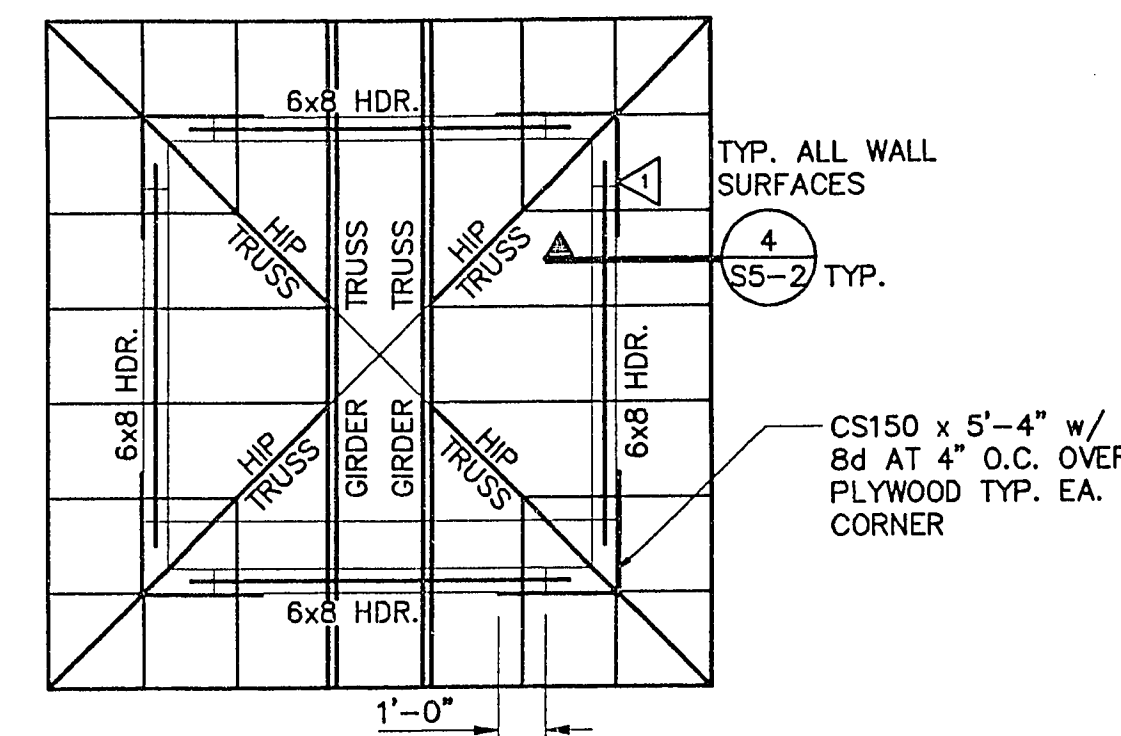

HIGH ROOF FRAMING PLAN  
SCALE: 1/4"=1'-0"

AS-BUILT

DRAWING NO. 522-V52

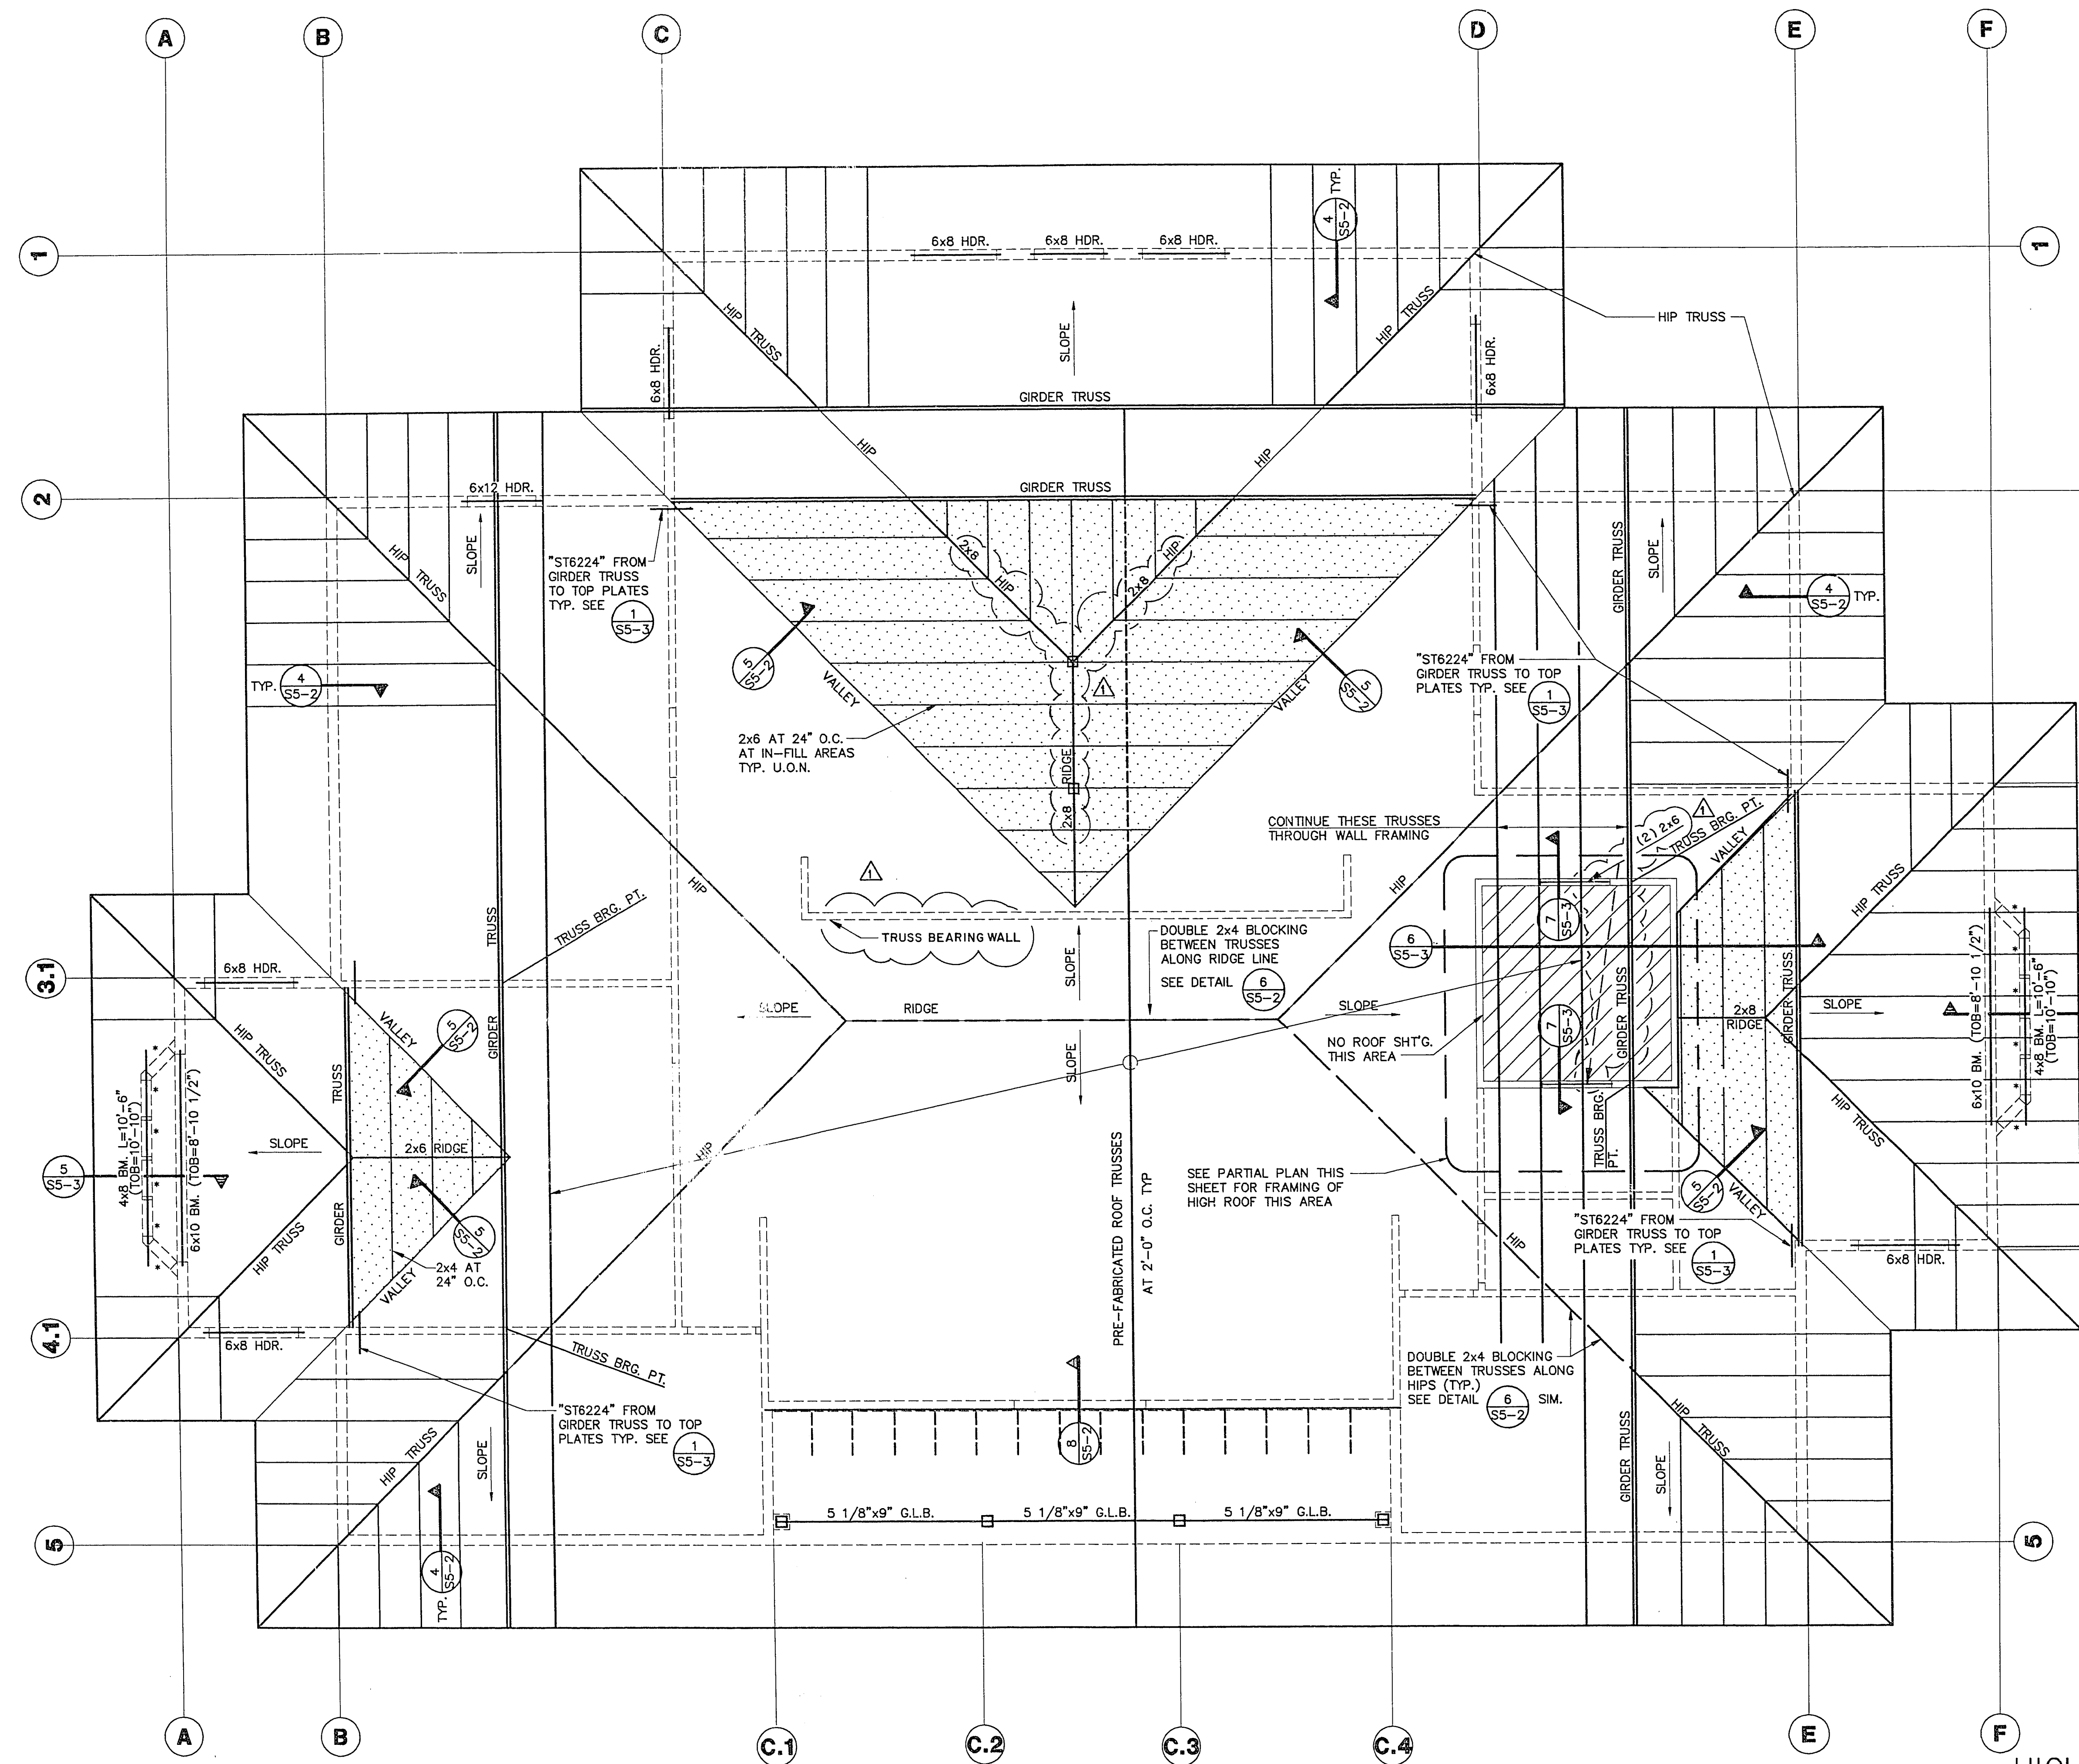

ROOF FRAMING PLAN  
SCALE: 1/4"=1'-0"