




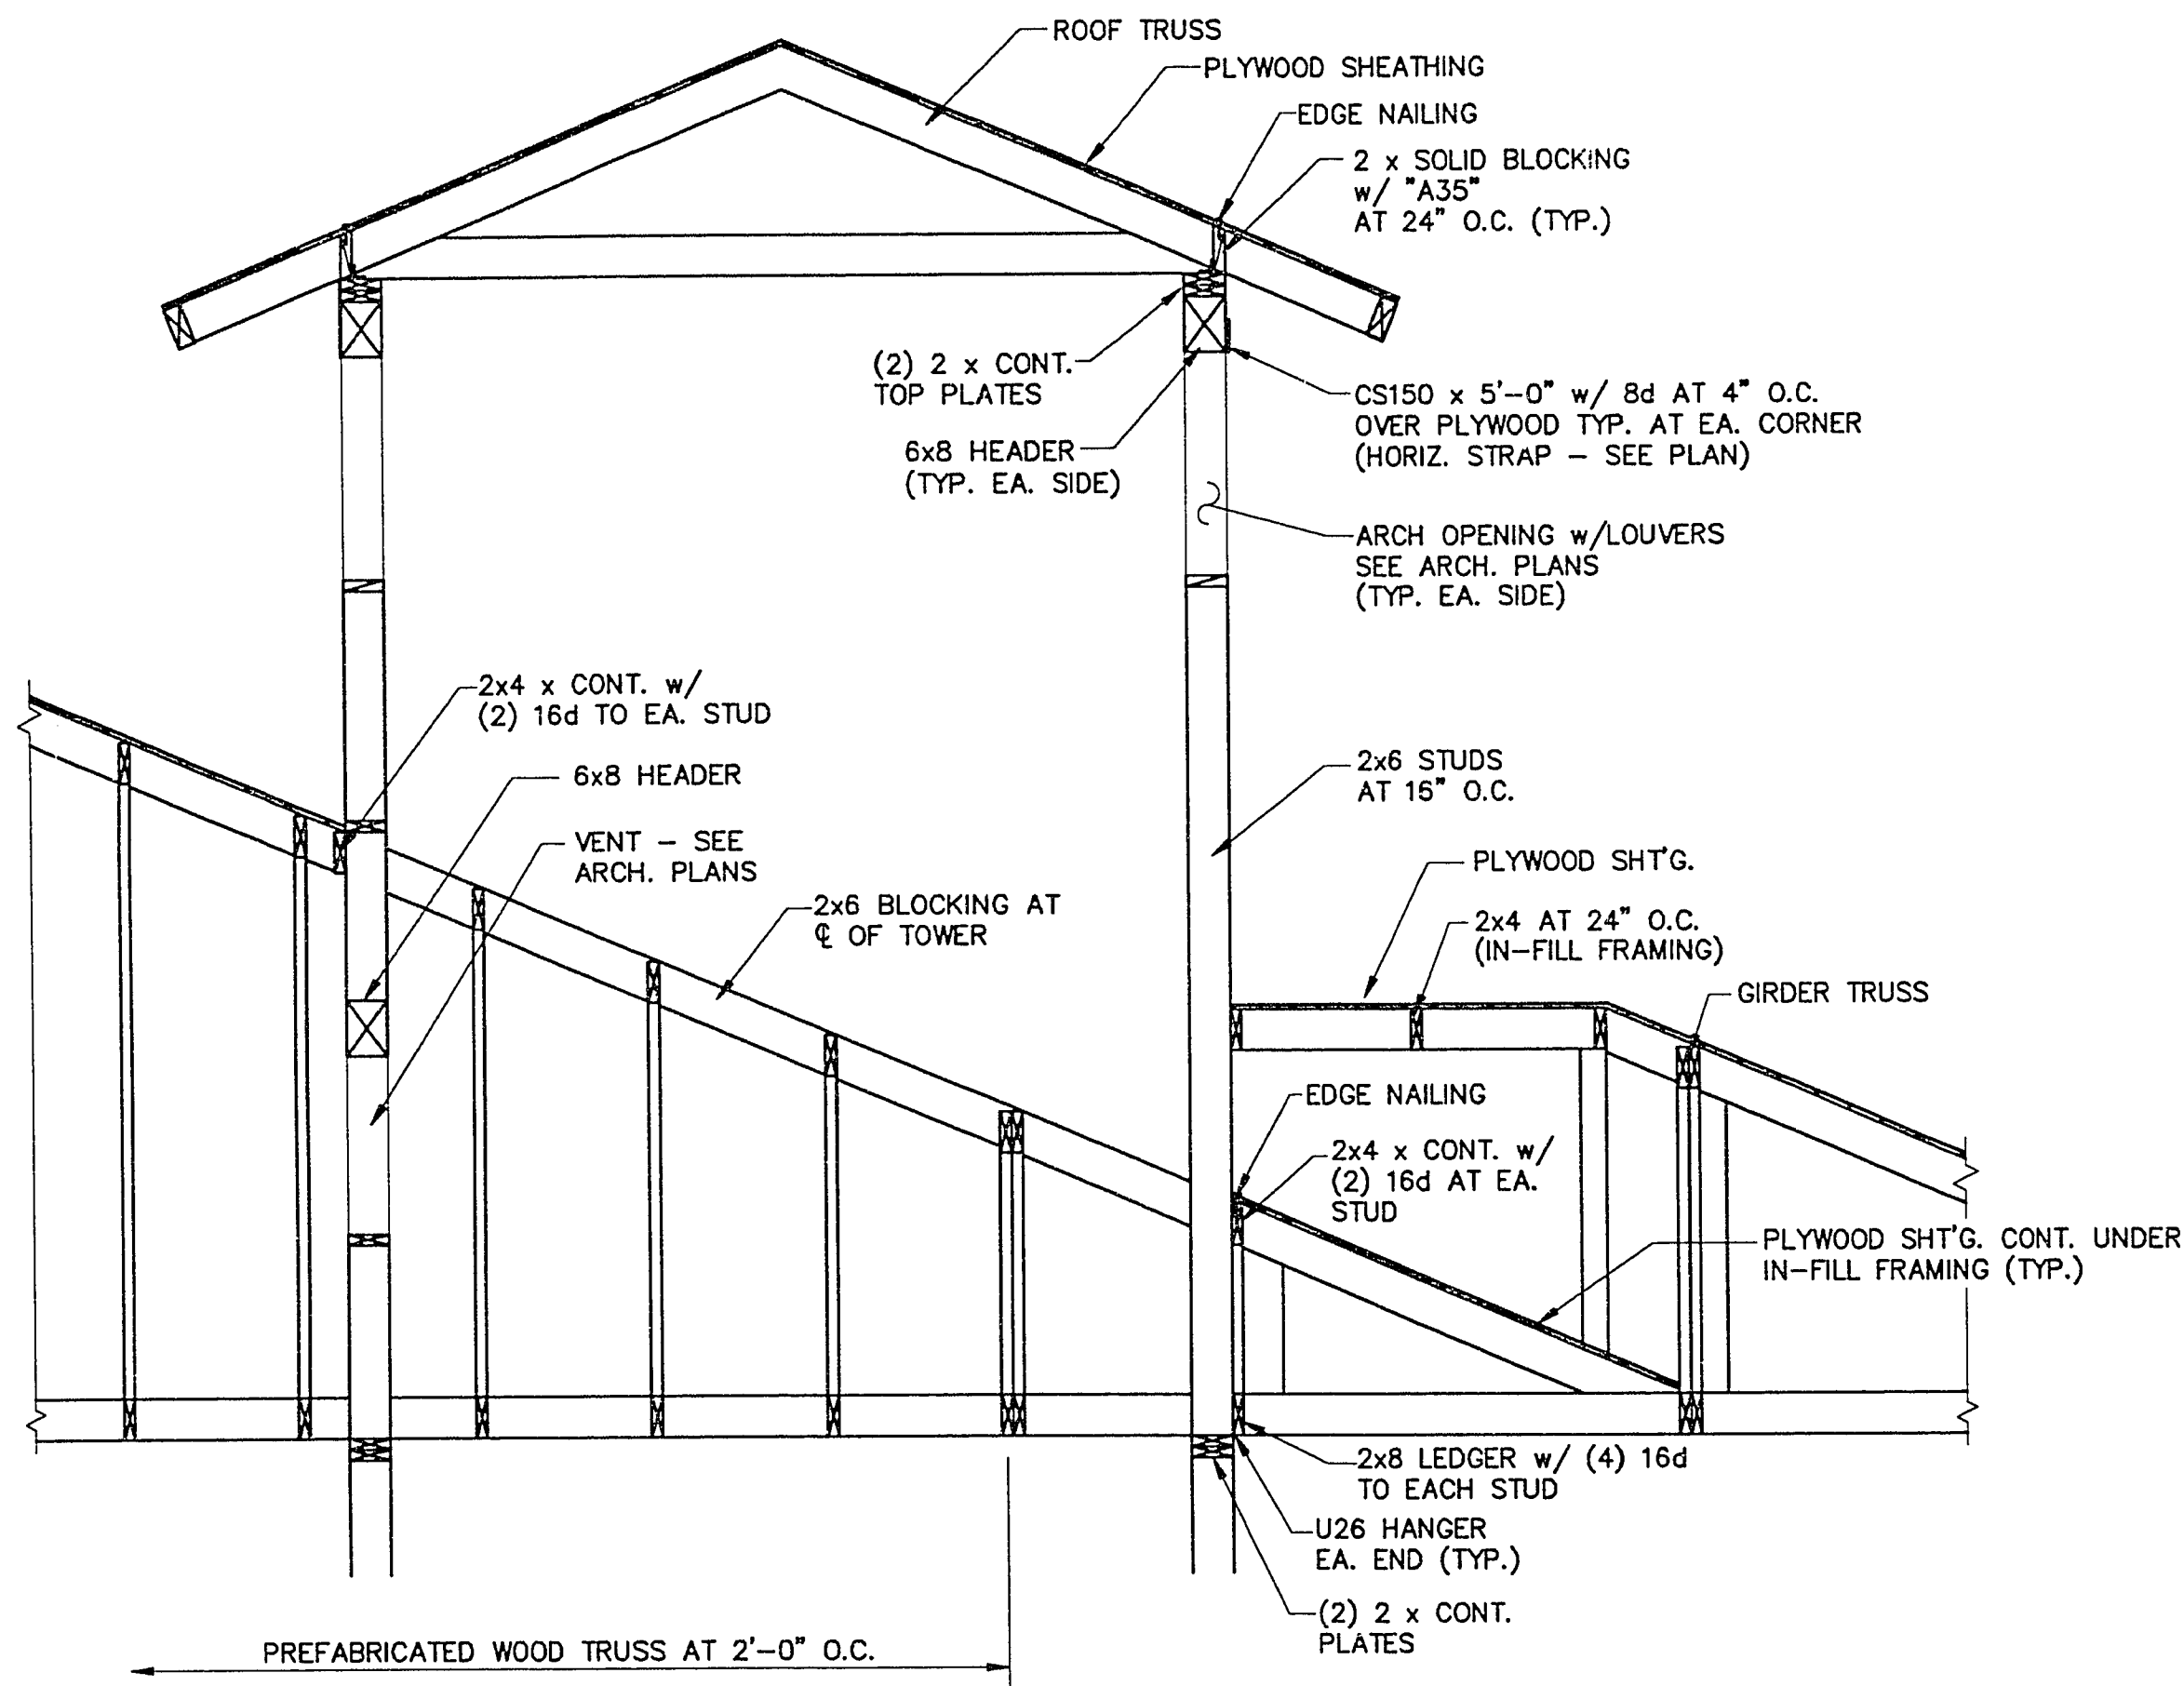


SECTION THRU TOWER
SCALE: 1/2" = 1'-0"

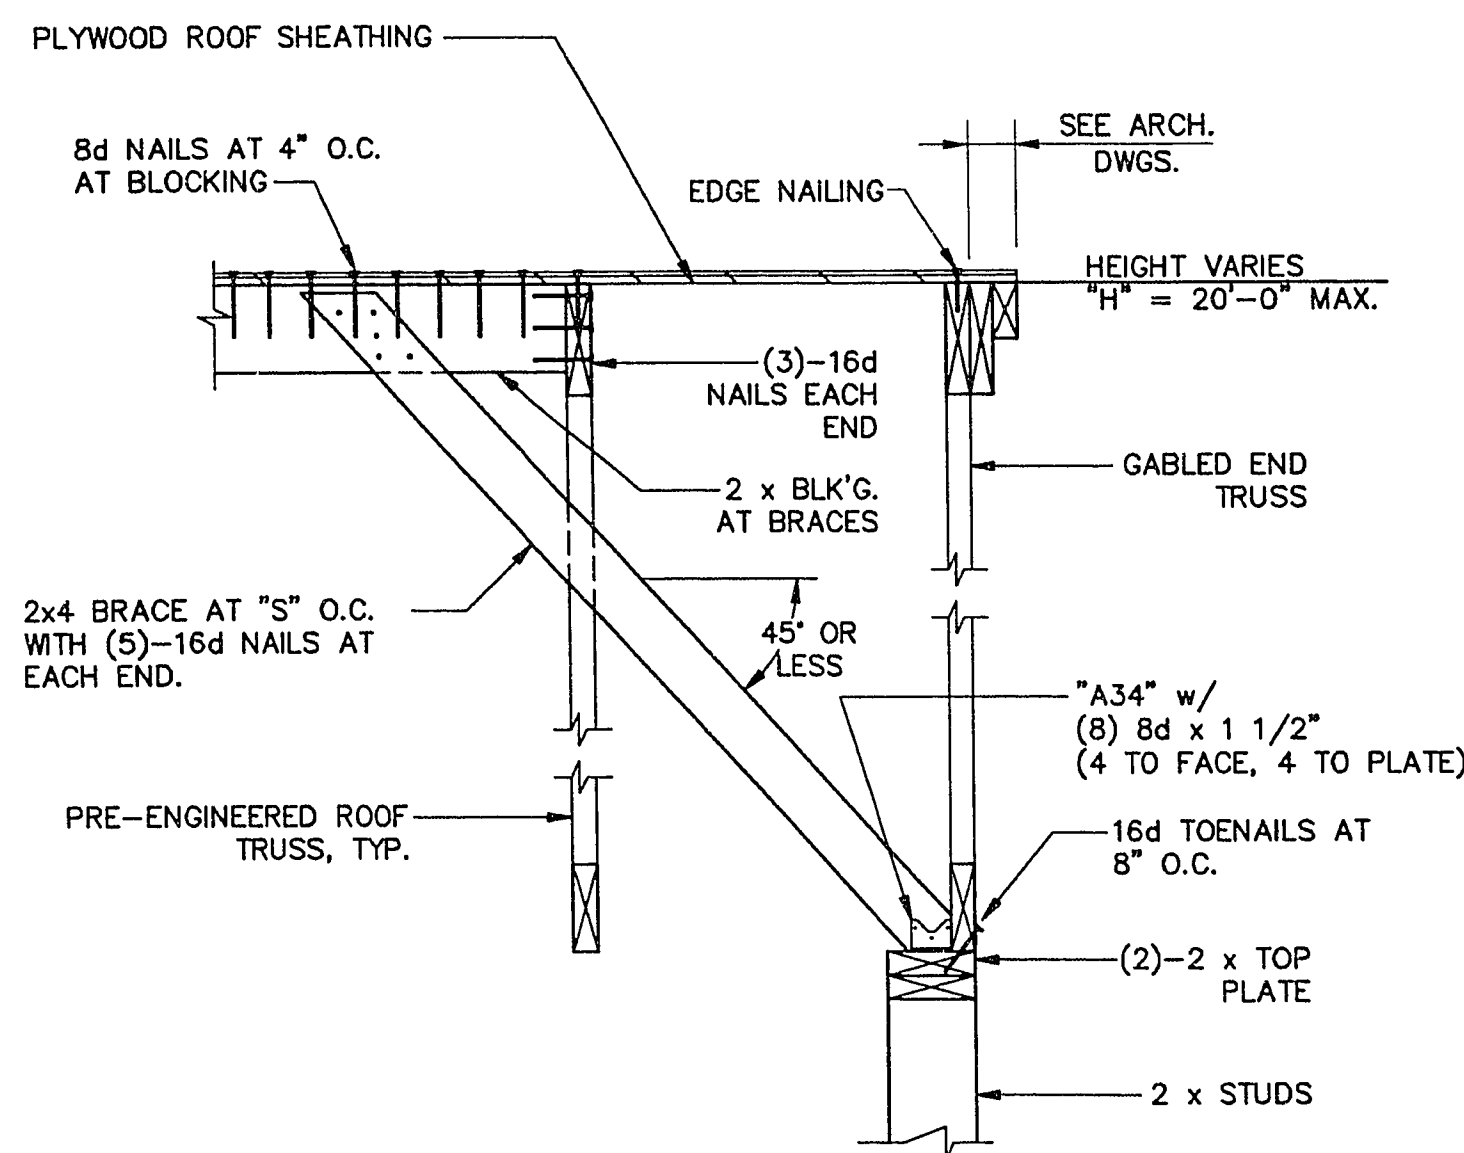

DETAIL
1" = 1'-0"

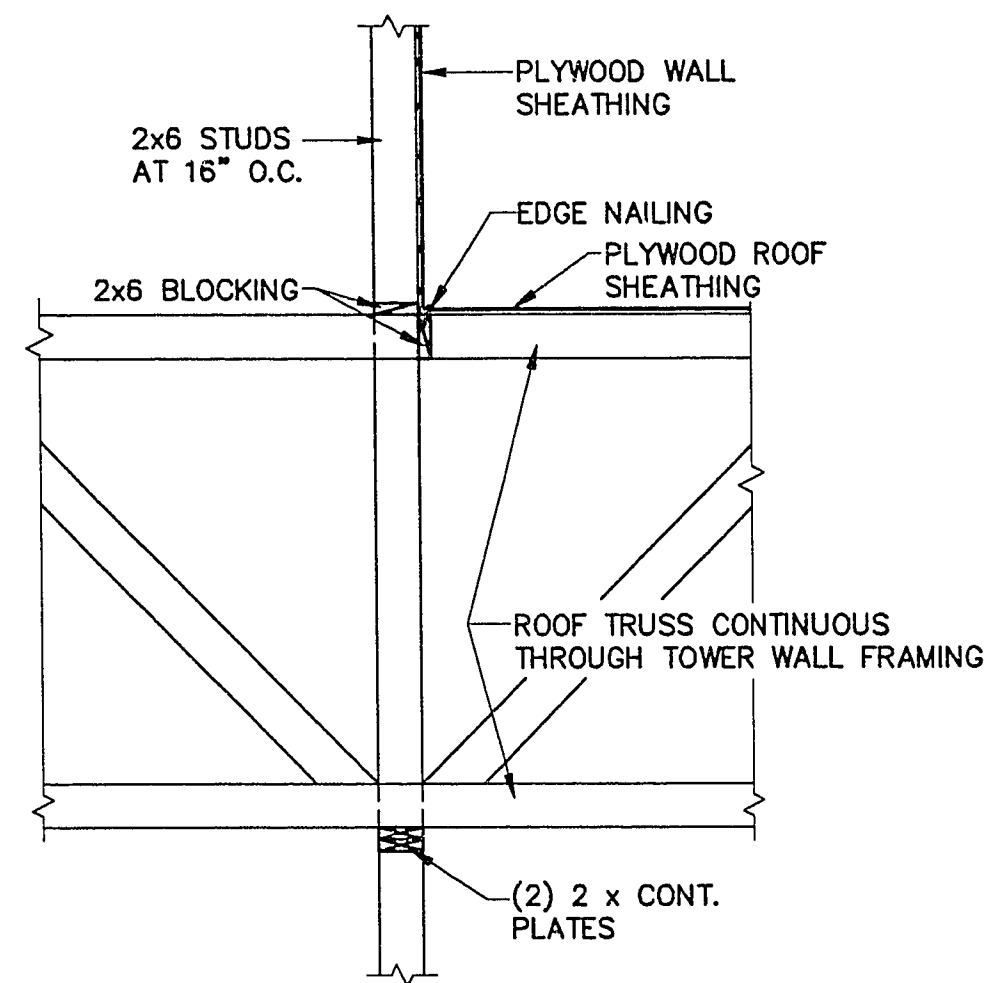


TRUSS BLK'G. DET. AT TOWER
SCALE: 1/2" = 1'-0"

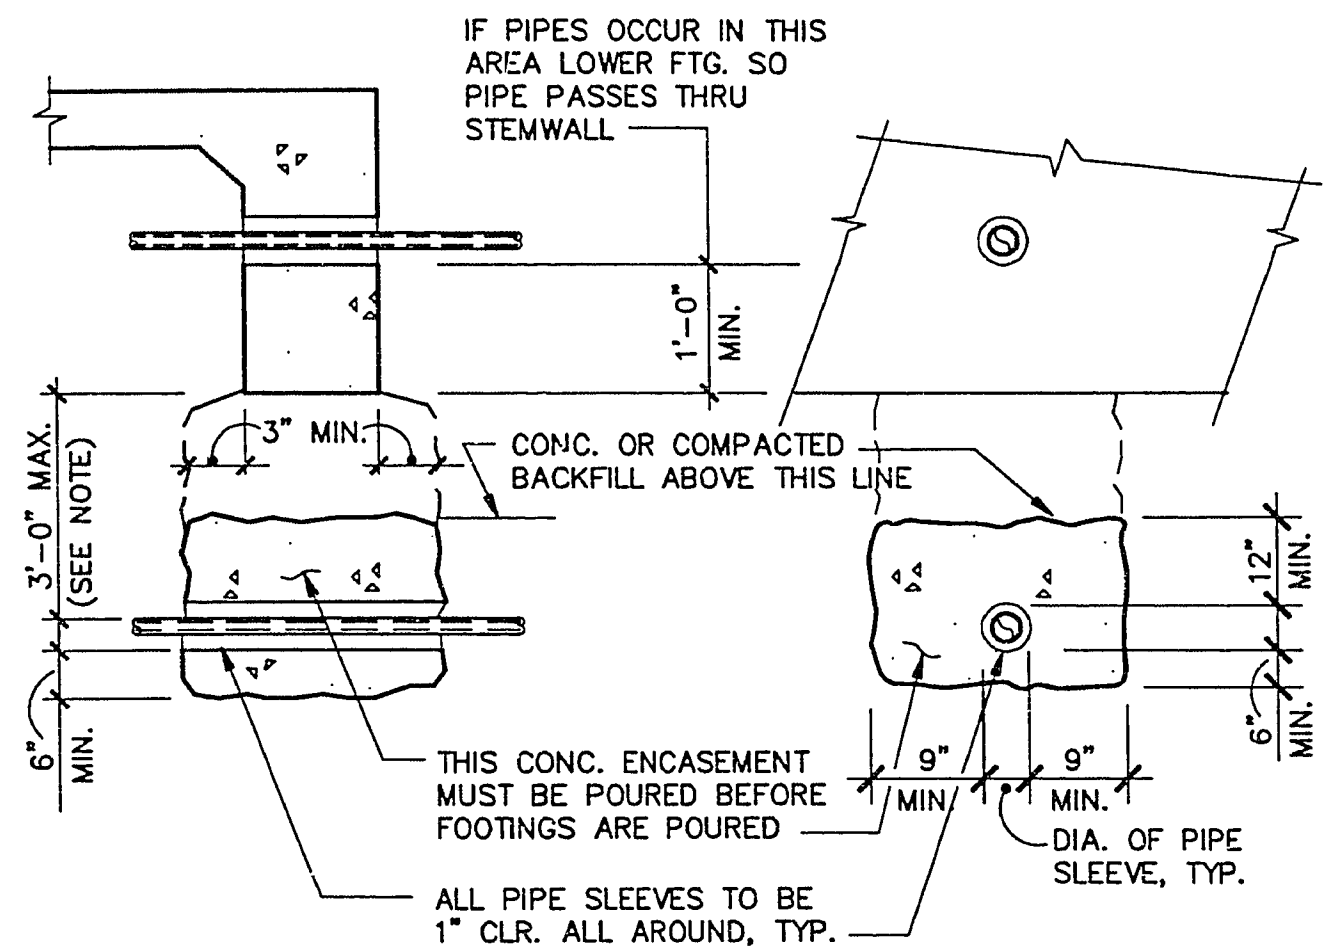


NOTES:

1. FOR PIPES MORE THAN 3'-0" BELOW BOTT. OF FTG., CONC. ENCASEMENT IS NOT REQUIRED, COMPACT SOIL TO 95%
2. SEE MECH. SPECS FOR CAULKING.
3. BUILDING FOOTING CONTRACTOR MAY FORM ENDS OF CONCRETE ENCASEMENT OR AT HIS OPTION LET CONCRETE SLOUGH TO NATURAL SLOPE.

DETAIL
NO SCALE

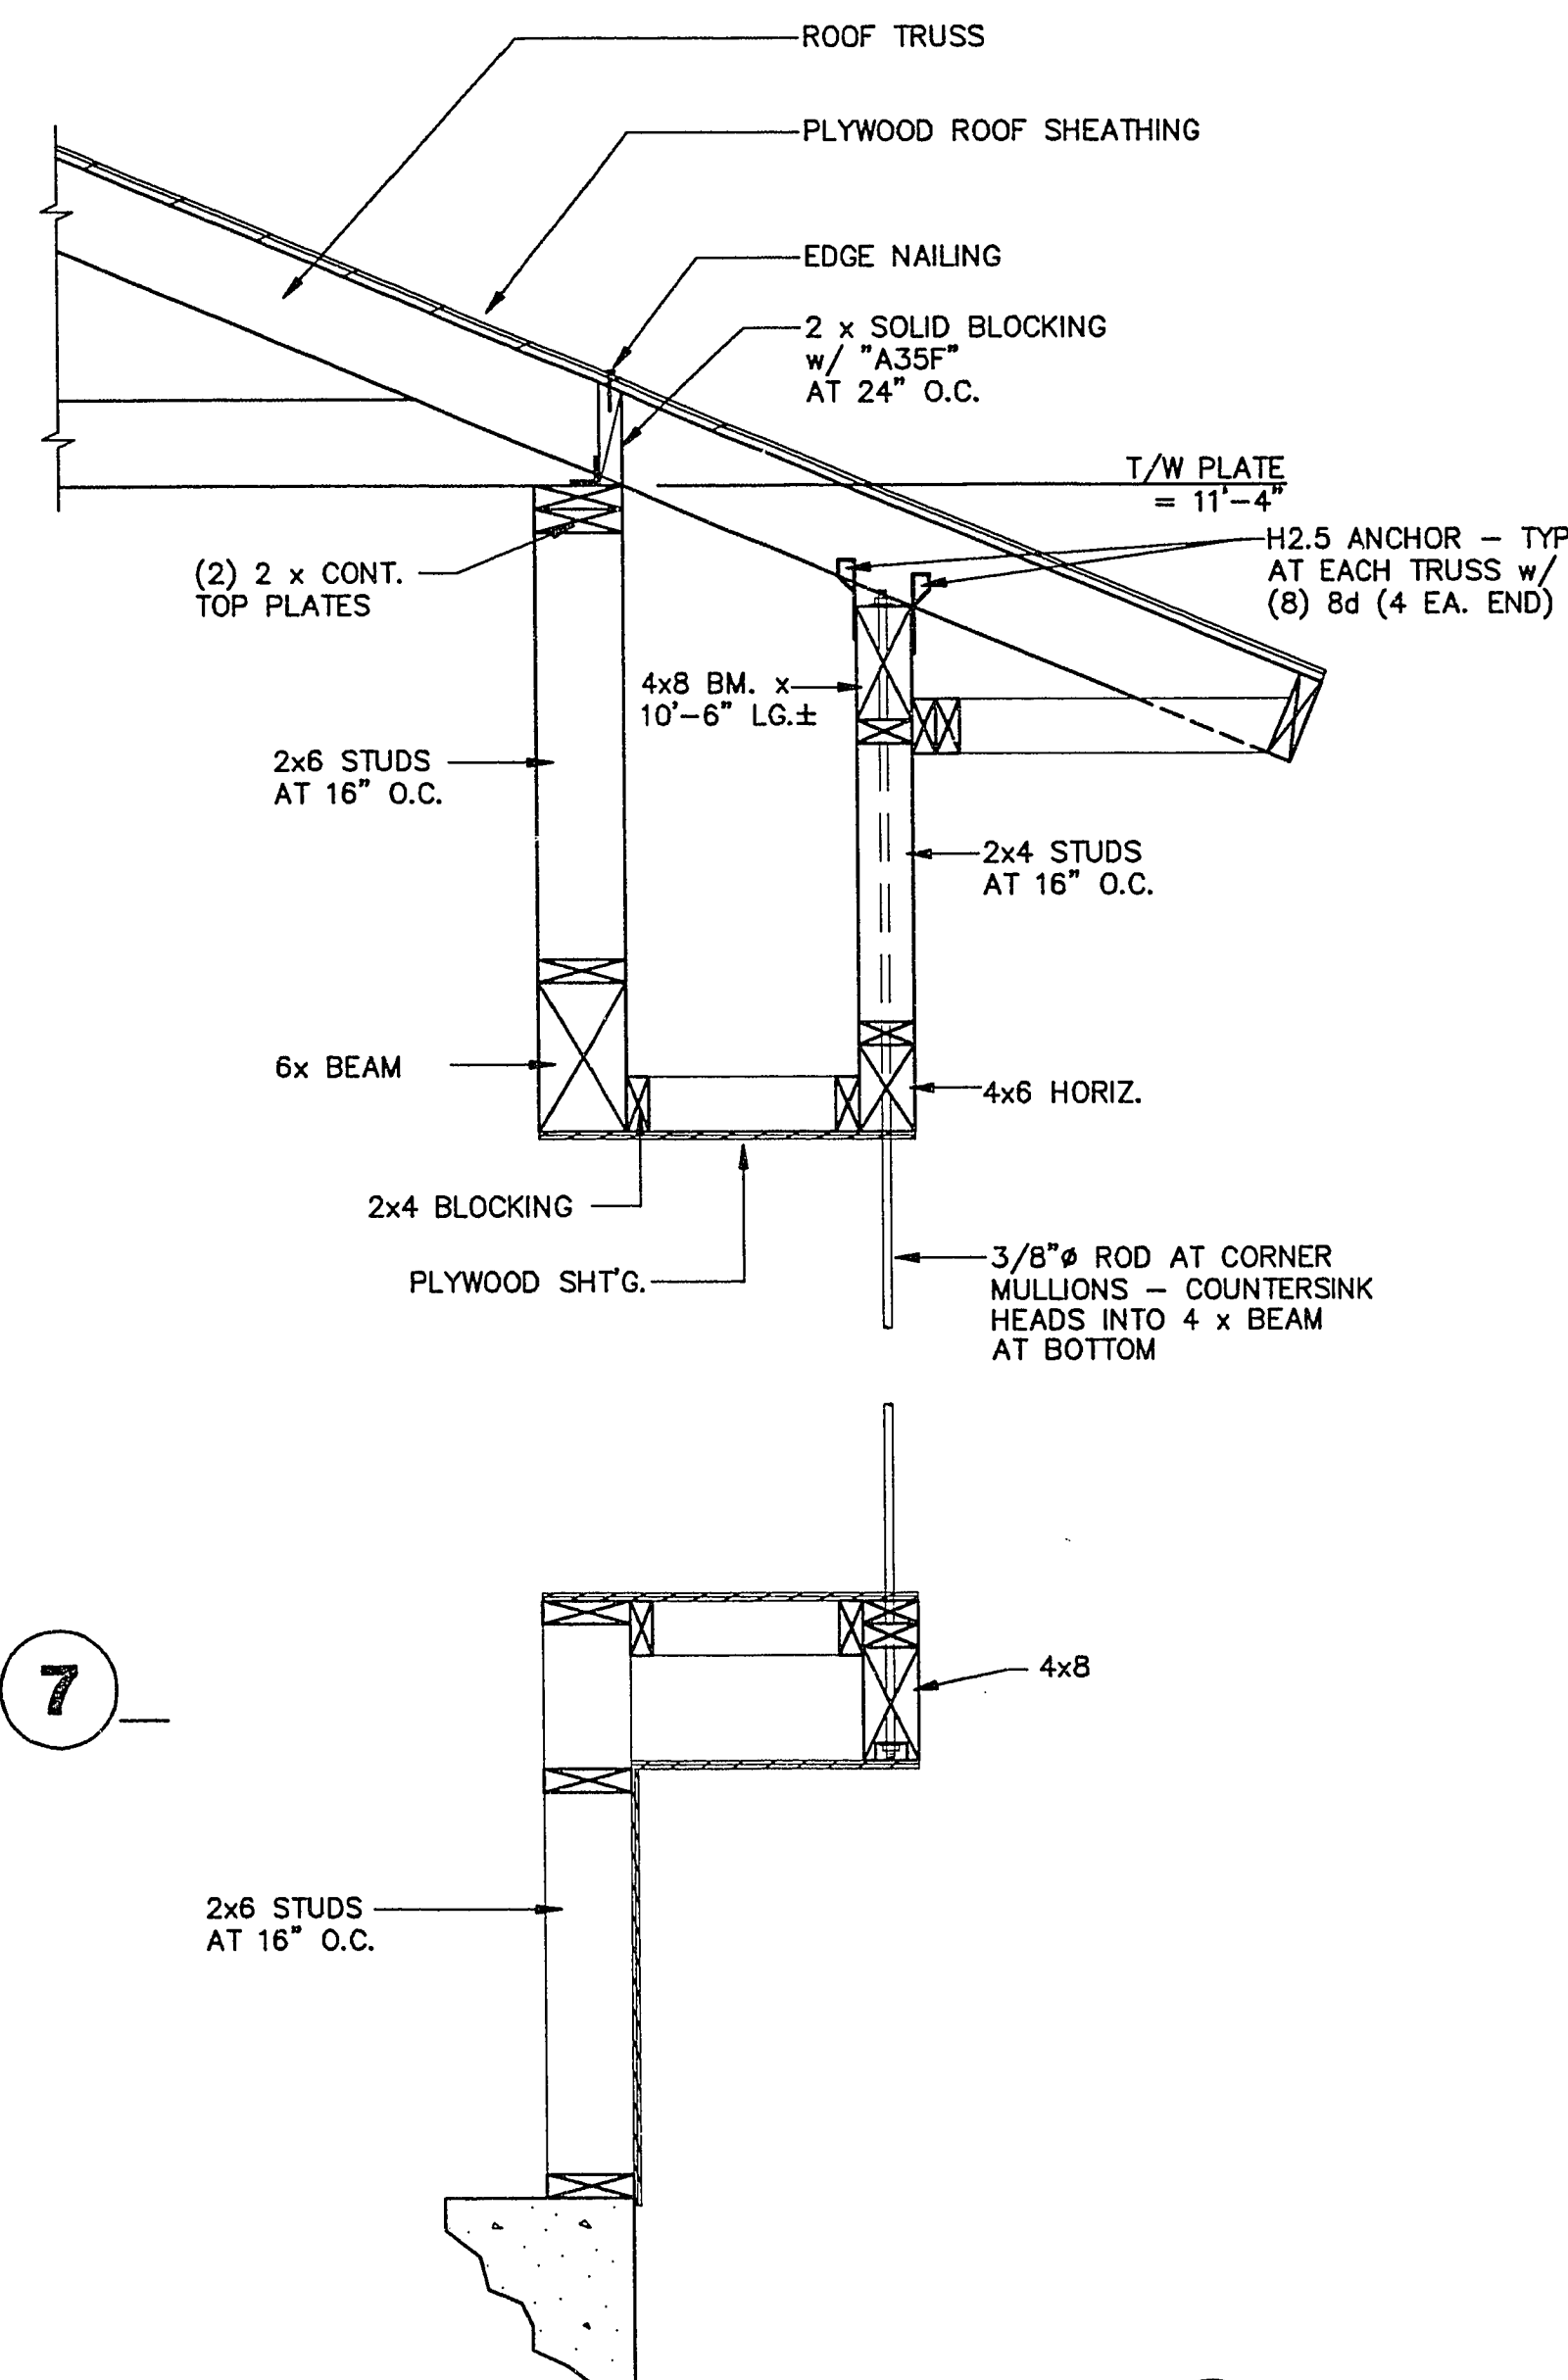


TYP. DETAIL AT BAY WINDOW
SCALE: 1" = 1'-0"

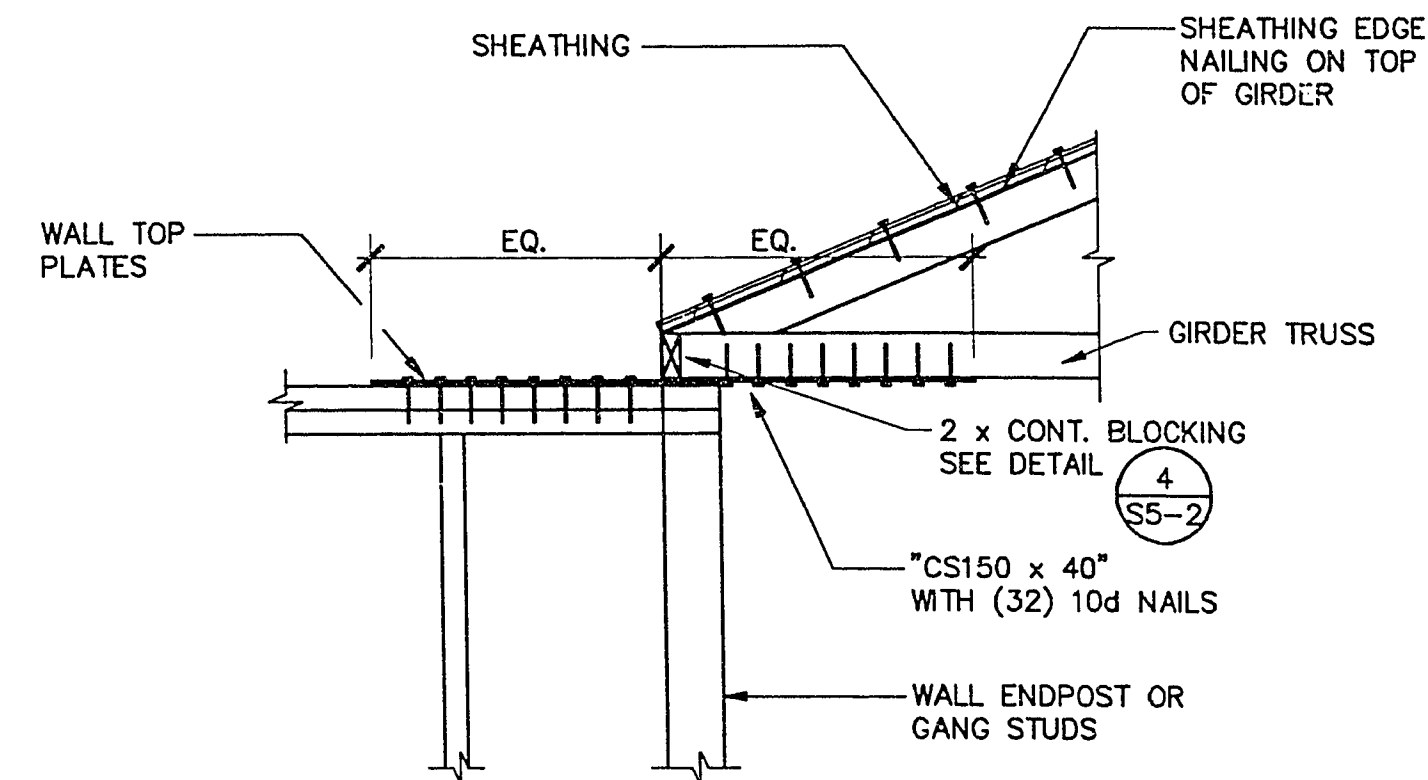


TYP. GIRDER TRUSS TO TOP PLATE

DETAIL
1" = 1'-0"

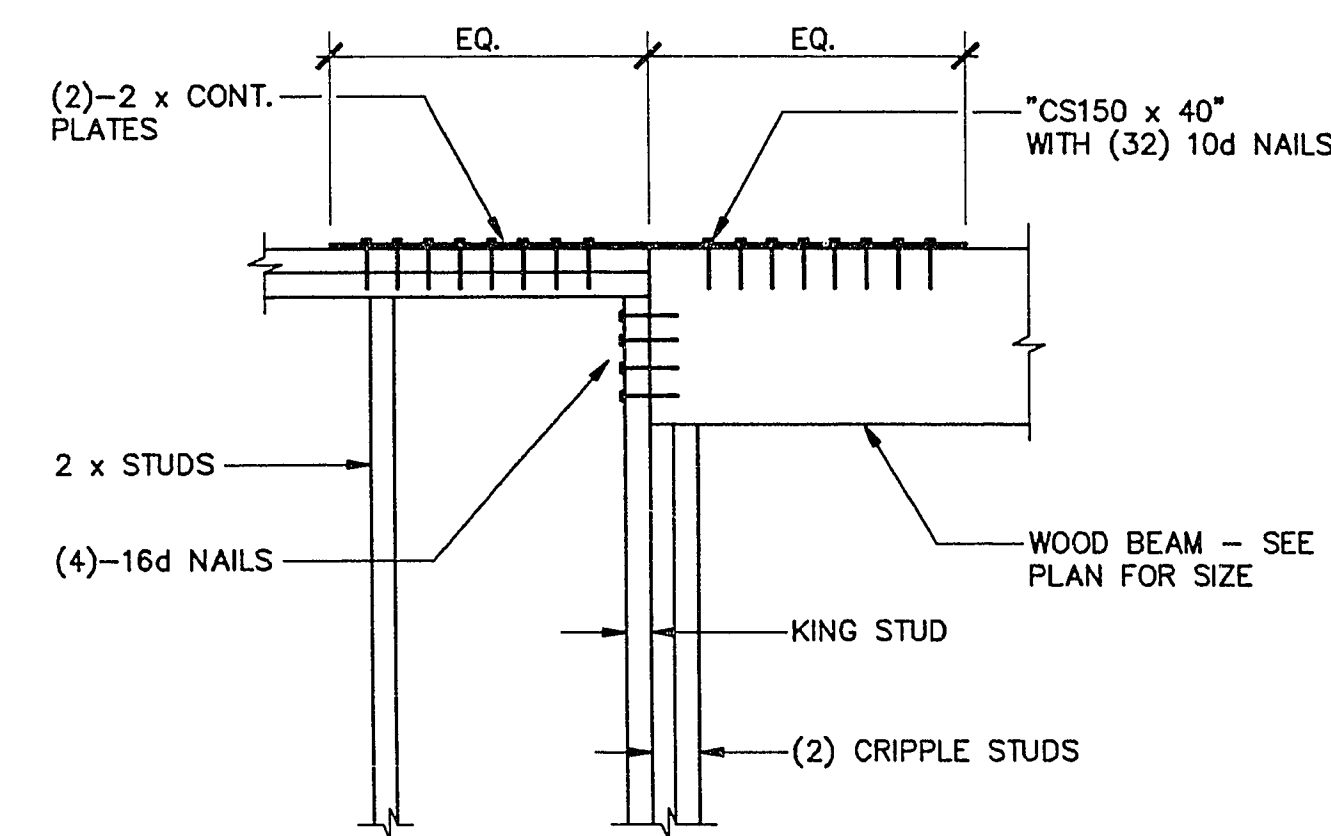

TYP. DRAG STRUT BEAM TO TOP PLATE

DETAIL
NO SCALE

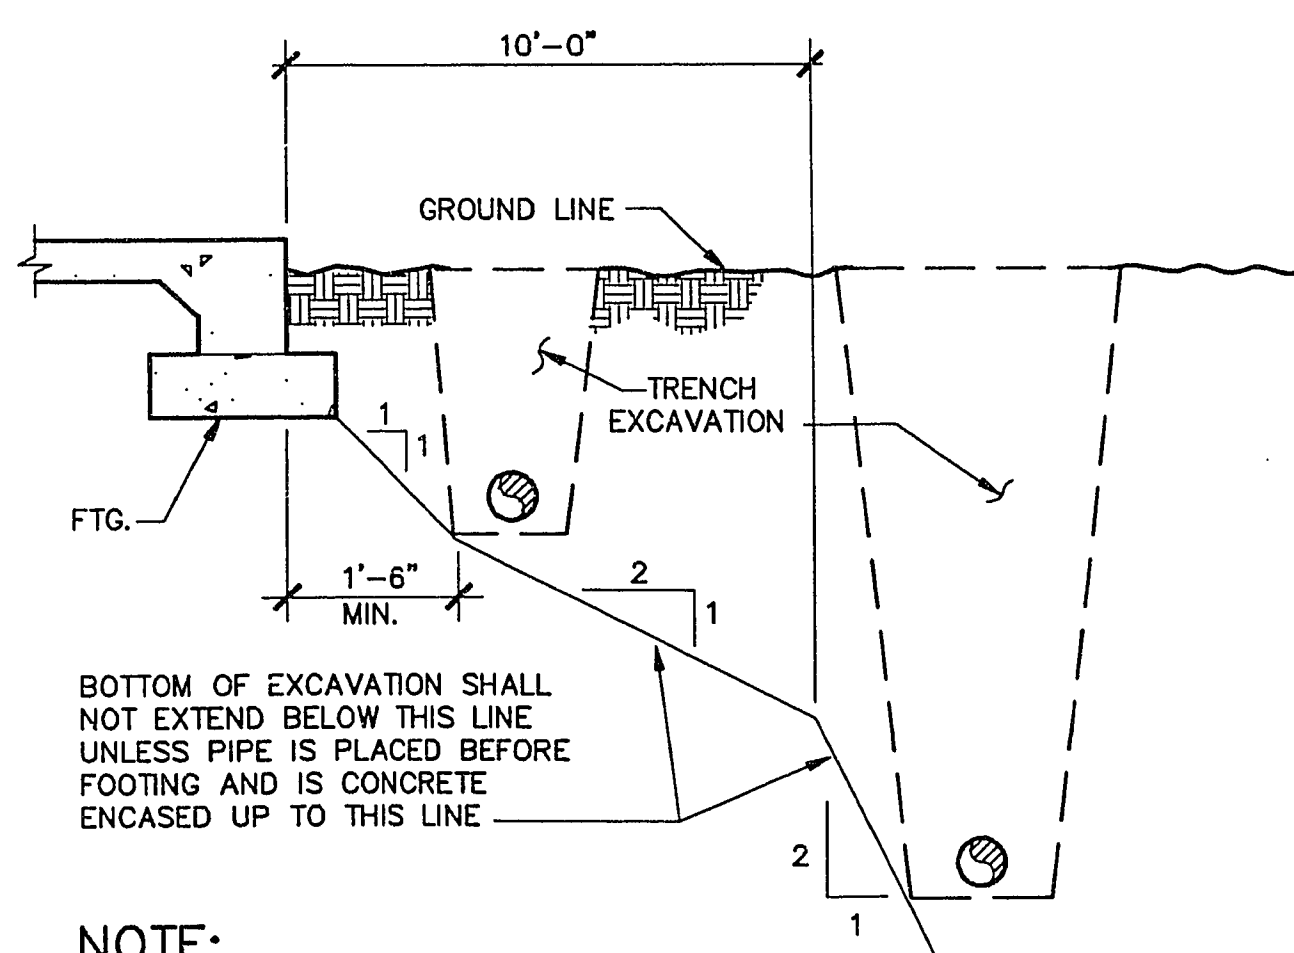

NOTE:

CONTRACTOR SHALL BE RESPONSIBLE FOR SHORING OR OTHERWISE MAINTAINING THE SIDES OF THE EXCAVATION FROM CAVE-IN UNTIL ALL BACKFILL IS COMPLETED. BACKFILL IN ACCORDANCE WITH GENERAL NOTES AND SPECIFICATIONS.


TYP. TRENCH PARALLEL TO FTG.

DETAIL
NO SCALE

AS-BUILT

REVISION	DATE	RECORD DRAWINGS
	04/19/95	

POGEMEYER DESIGN GROUP
SURVEYORS
PLANNERS
ENGINEERS
1140 ALMOND TREE LANE, SUITE 306 LAS VEGAS, NEVADA 89104 (702) 735-5108

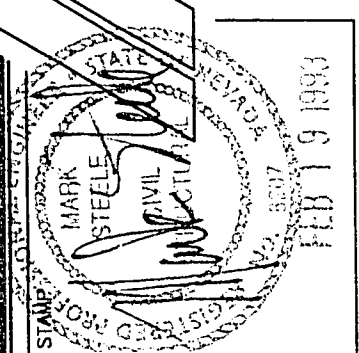

DETAILS
WEST SERVICE CENTER
PHASE I
B. & S., Q.C. & SANT. SITES

JOB NUMBER	91012
DESIGNED BY	MS
DRAWN BY	JDS
CHECKED BY	MS
DATE	1/15/92
SHEET NUMBER	49 of 78
S5-3	or 11