


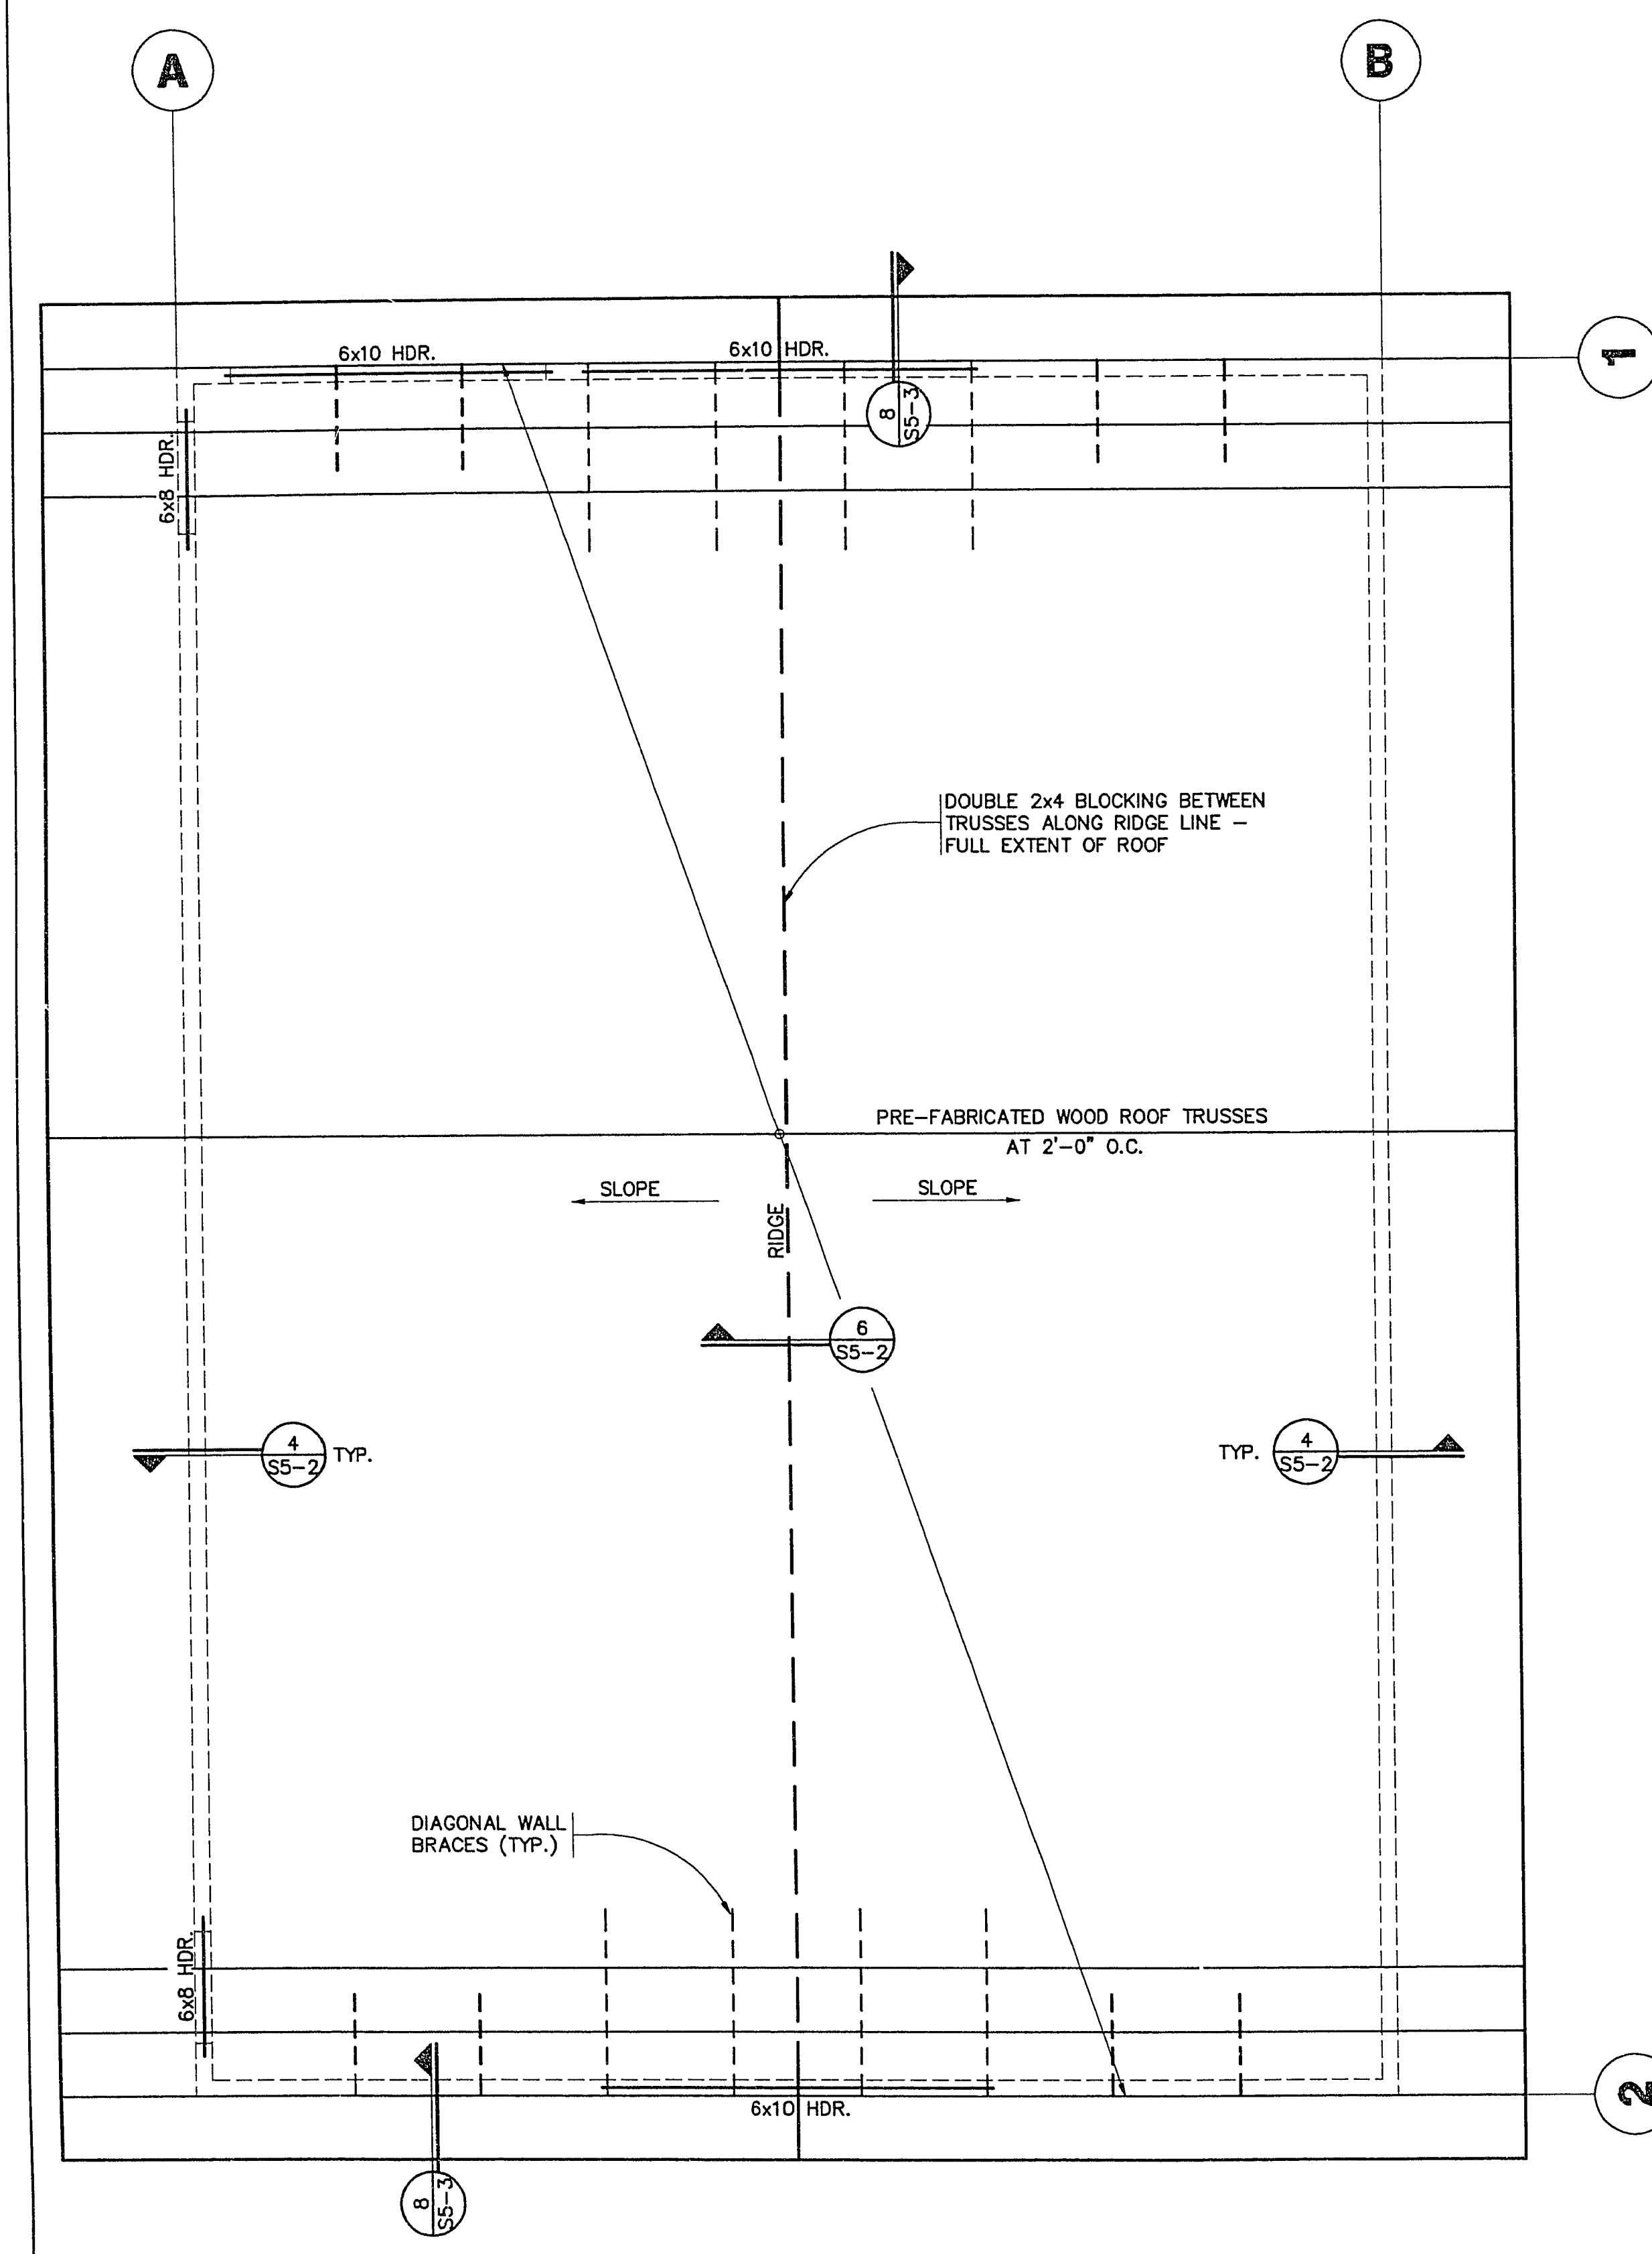


ROOF FRAMING PLAN
SCALE: 1/4"=1'-0"

ROOF FRAMING NOTES:

1. SEE FRAMING NOTES SHEET S-0 FOR ROOF SHEATHING.
2. SEE ARCHITECTURAL DRAWINGS FOR WALL PARTITION LOCATIONS (BELOW) AND DIMENSIONS NOT SHOWN OR NOTED.
3. TRUSS MANUFACTURER SHALL VERIFY ALL DIMENSIONS WITH ARCHITECTURAL DRAWINGS AND COORDINATE WITH MECHANICAL SUBCONTRACTOR FOR THE SIZE, LOCATION AND DIMENSIONS OF ALL UNITS AND OPENINGS.
4. SEE (1) S5-2 FOR HEADER SCHEDULE UNLESS NOTED ON PLAN.
5. TRUSS MANUFACTURER TO SUBMIT CALCULATIONS TO BUILDING OFFICIAL FOR APPROVAL.

FOUNDATIONS NOTES:

1. CONCRETE FLOOR SLAB SHALL BE 4" THICK WITH 6" x 6", W2.9 x W2.9 W.W.F. AT MID-HEIGHT OVER 2" SAND OVER 12" SELECT MATERIAL. SEE SOIL REPORT FOR SUBGRADE PREPARATION.
2. TOP OF CONCRETE SLAB (T.O.C.) ELEVATION = 100'-0" TYPICAL UNLESS NOTED OTHERWISE. (ASSUMED - SEE CIVIL DRAWINGS FOR ACTUAL TOP OF CONCRETE & GRADE ELEVATIONS.
3. [Dashed line symbol] INDICATES SHEARWALL LOCATIONS
[X in triangle symbol] SHEARWALL MARKER, SEE SHEARWALL SCHEDULE SHEET S-0.
4. ALL EXTERIOR STUD WALLS AT THIS LEVEL SHALL BE FRAMED WITH 2 x 6 STUDS AT 16" O.C., TYPICAL UNLESS NOTED OTHERWISE.
5. FOR TYPICAL DETAILS OF PIPE THRU FOOTING AND TRENCHES ADJACENT TO FOOTINGS, SEE DETAILS (4) S5-3 AND (5) S5-3 SEE CIVIL AND PLUMBING DRAWINGS FOR LOCATIONS.
6. SEE ARCHITECTURAL DRAWINGS FOR DIMENSIONS, PARTITIONS AND NOTES NOT SHOWN OR COVERED ON THIS PLAN.
7. [Triangle symbol] INDICATES HOLDOWN LOCATIONS.
8. PROVIDE A MINIMUM OF (2) 2x6 KING STUDS AT EACH "PA" HOLD DOWN TYPICAL, UNLESS OTHERWISE NOTED.
9. VERIFY GIRDER TRUSS LOCATIONS.

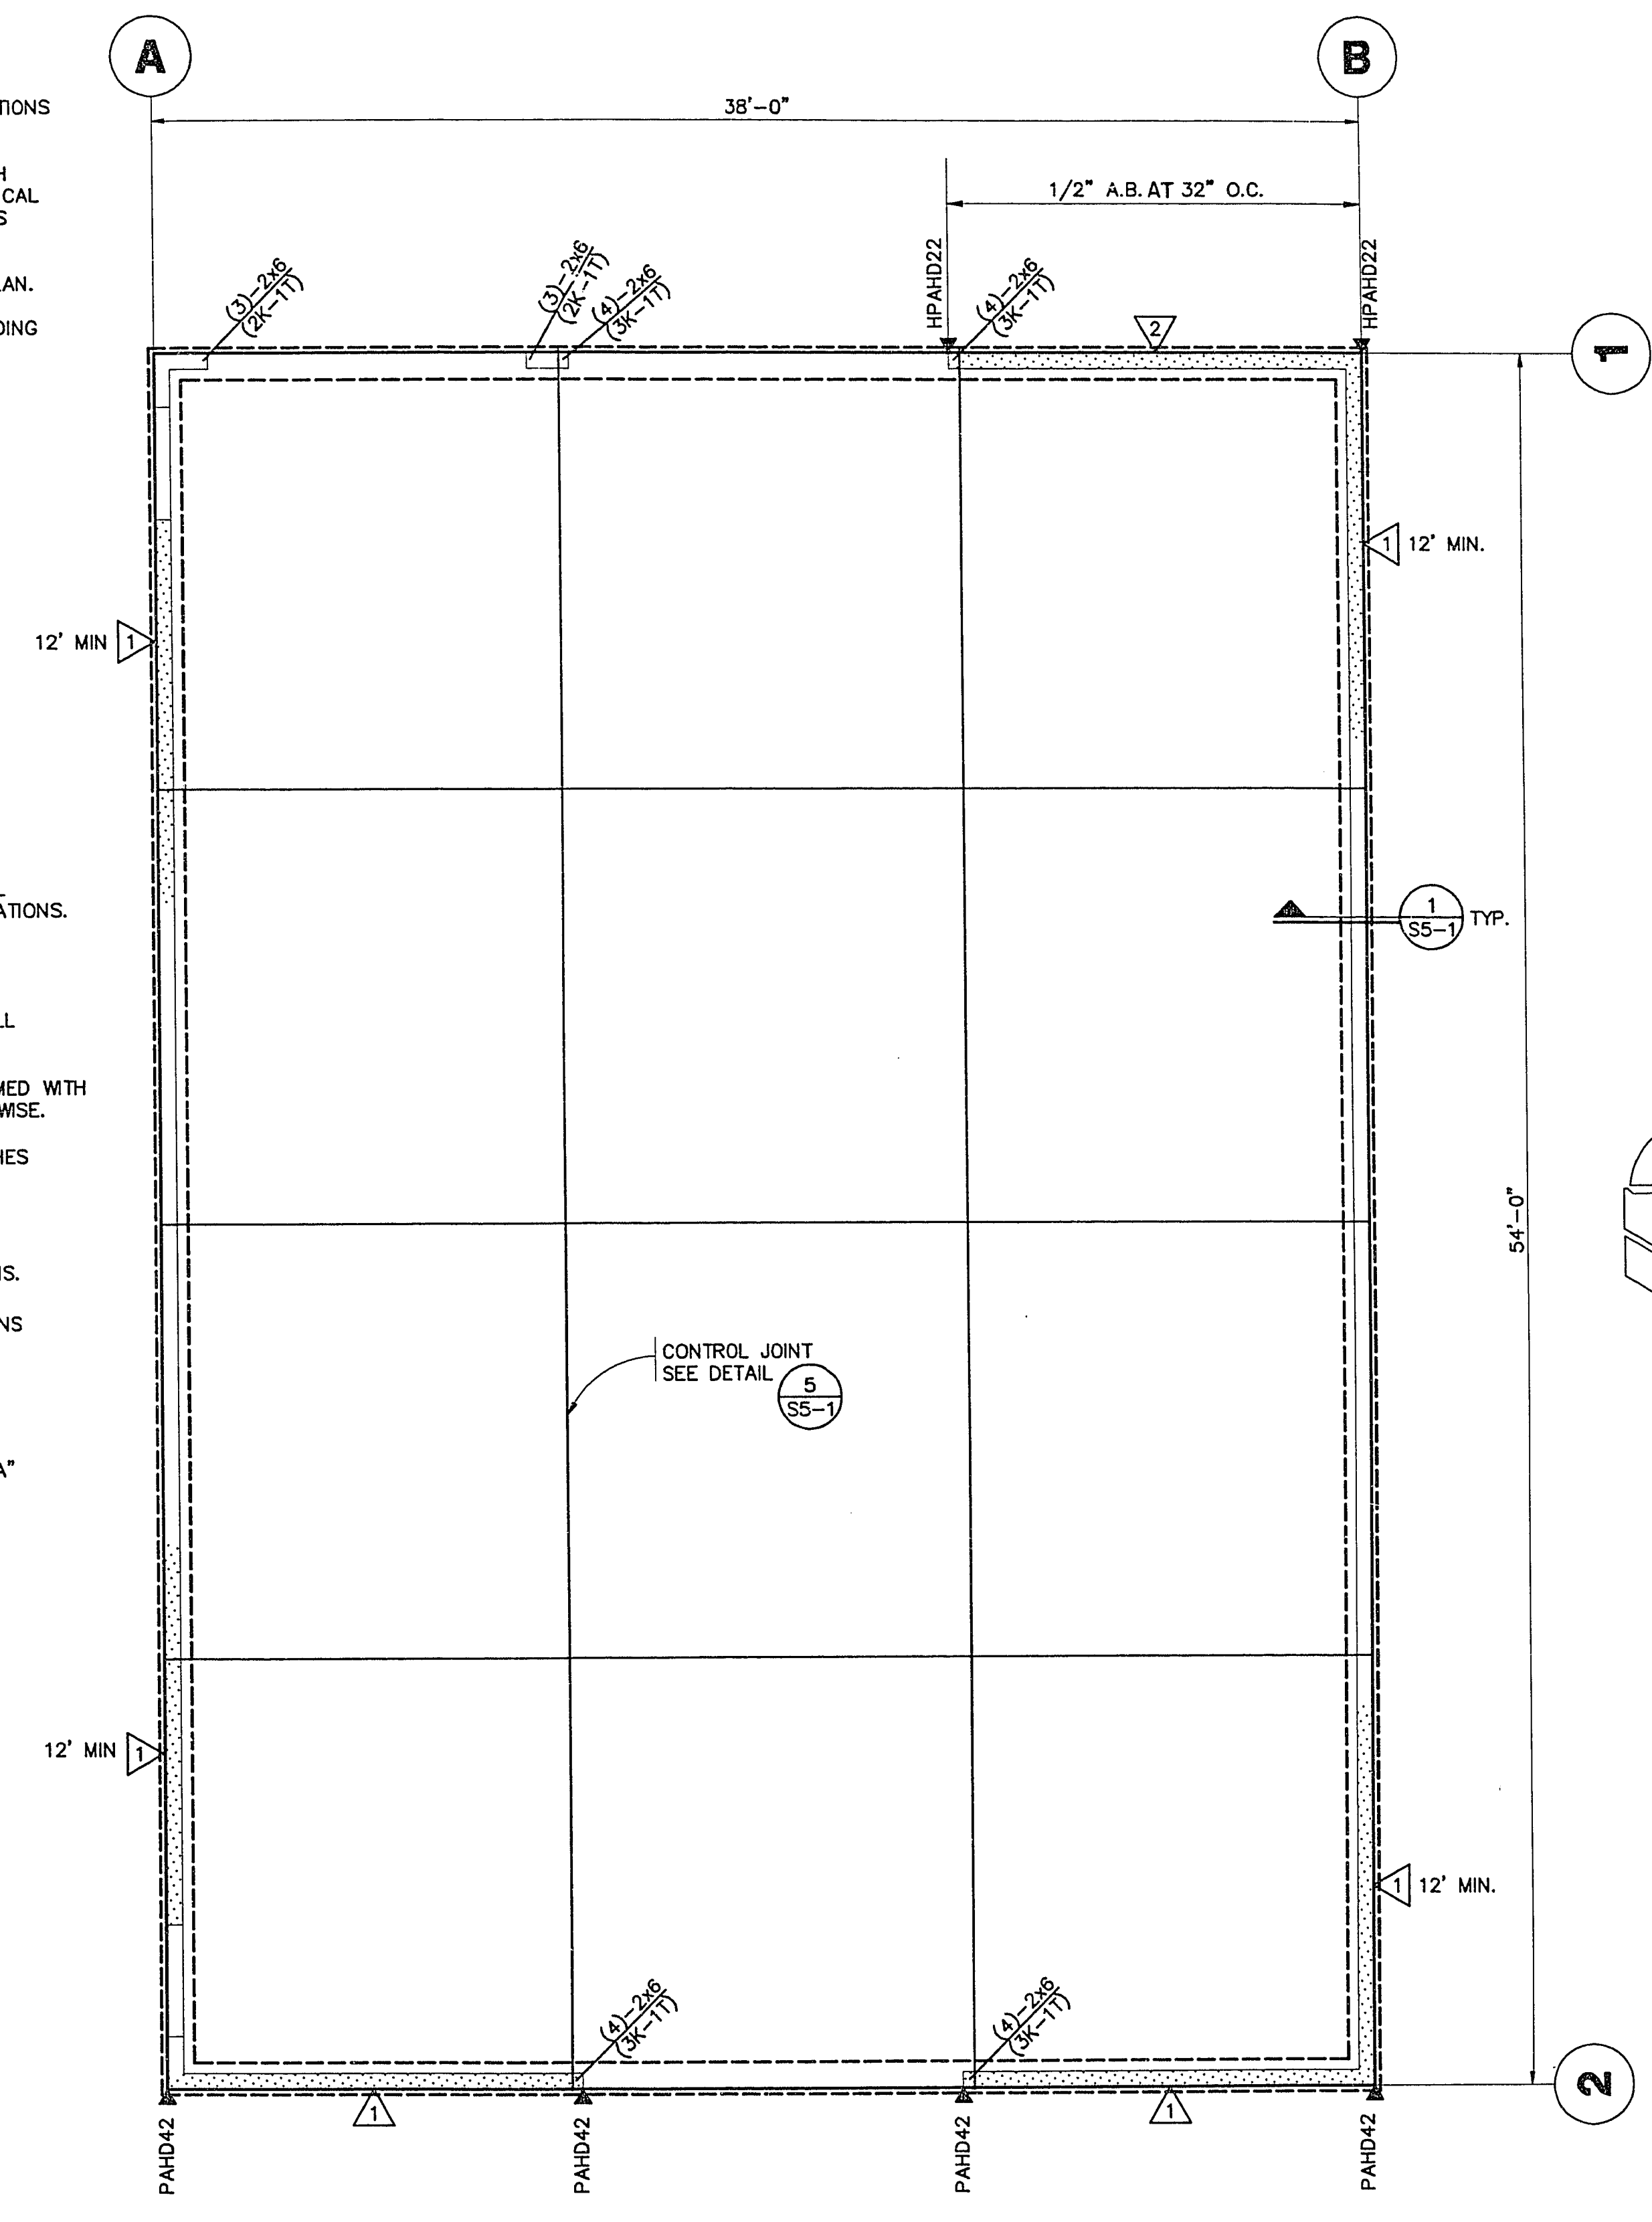

FOUNDATION PLAN
SCALE: 1/4"=1'-0"

DATE 04/19/95		REVISION A RECORD DRAWINGS
POGGEMEYER DESIGN GROUP ENGINEERS PLANNERS SURVEYORS 1140 ALMOND TREE LANE, SUITE 306 LAS VEGAS, NEVADA 89104 (702) 735-5108		
FND. & FRM'G. PLAN - SAN. STOR. BLDG. WEST SERVICE CENTER PHASE I B. & S., Q.C. & SANT. SITES		
JOB NUMBER 91012	DESIGNED BY MS	SHEET NUMBER 46 of 78 S4-1 OF 11
DRAWN BY JDS/RAP	CHECKED BY MS	
DATE 1/15/92		
AS-BUILT		