


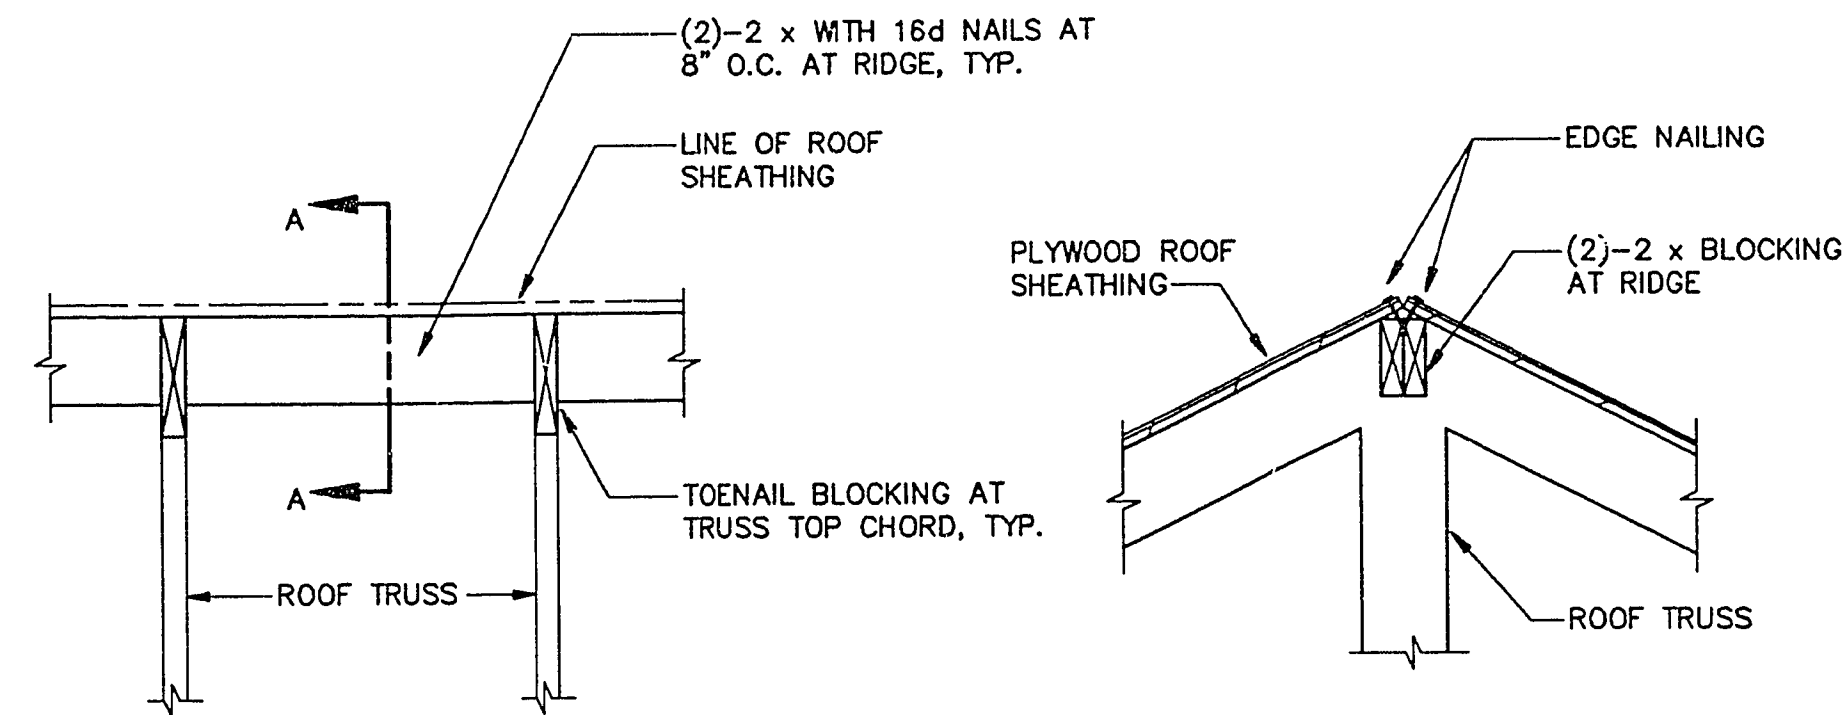


ELEVATION

SECTION A-A

DETAIL

1" = 1'-0"


6

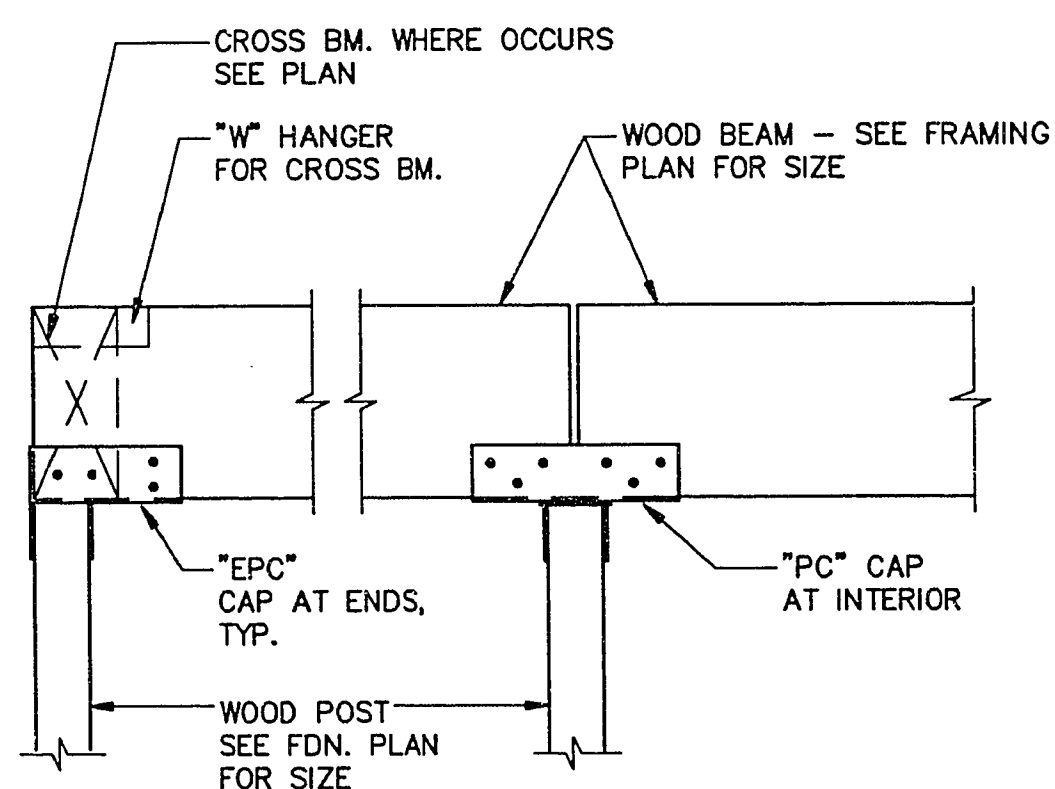

TYP. BEAM TO COL. CONN.

SCALE: 1"=1'-0"


7

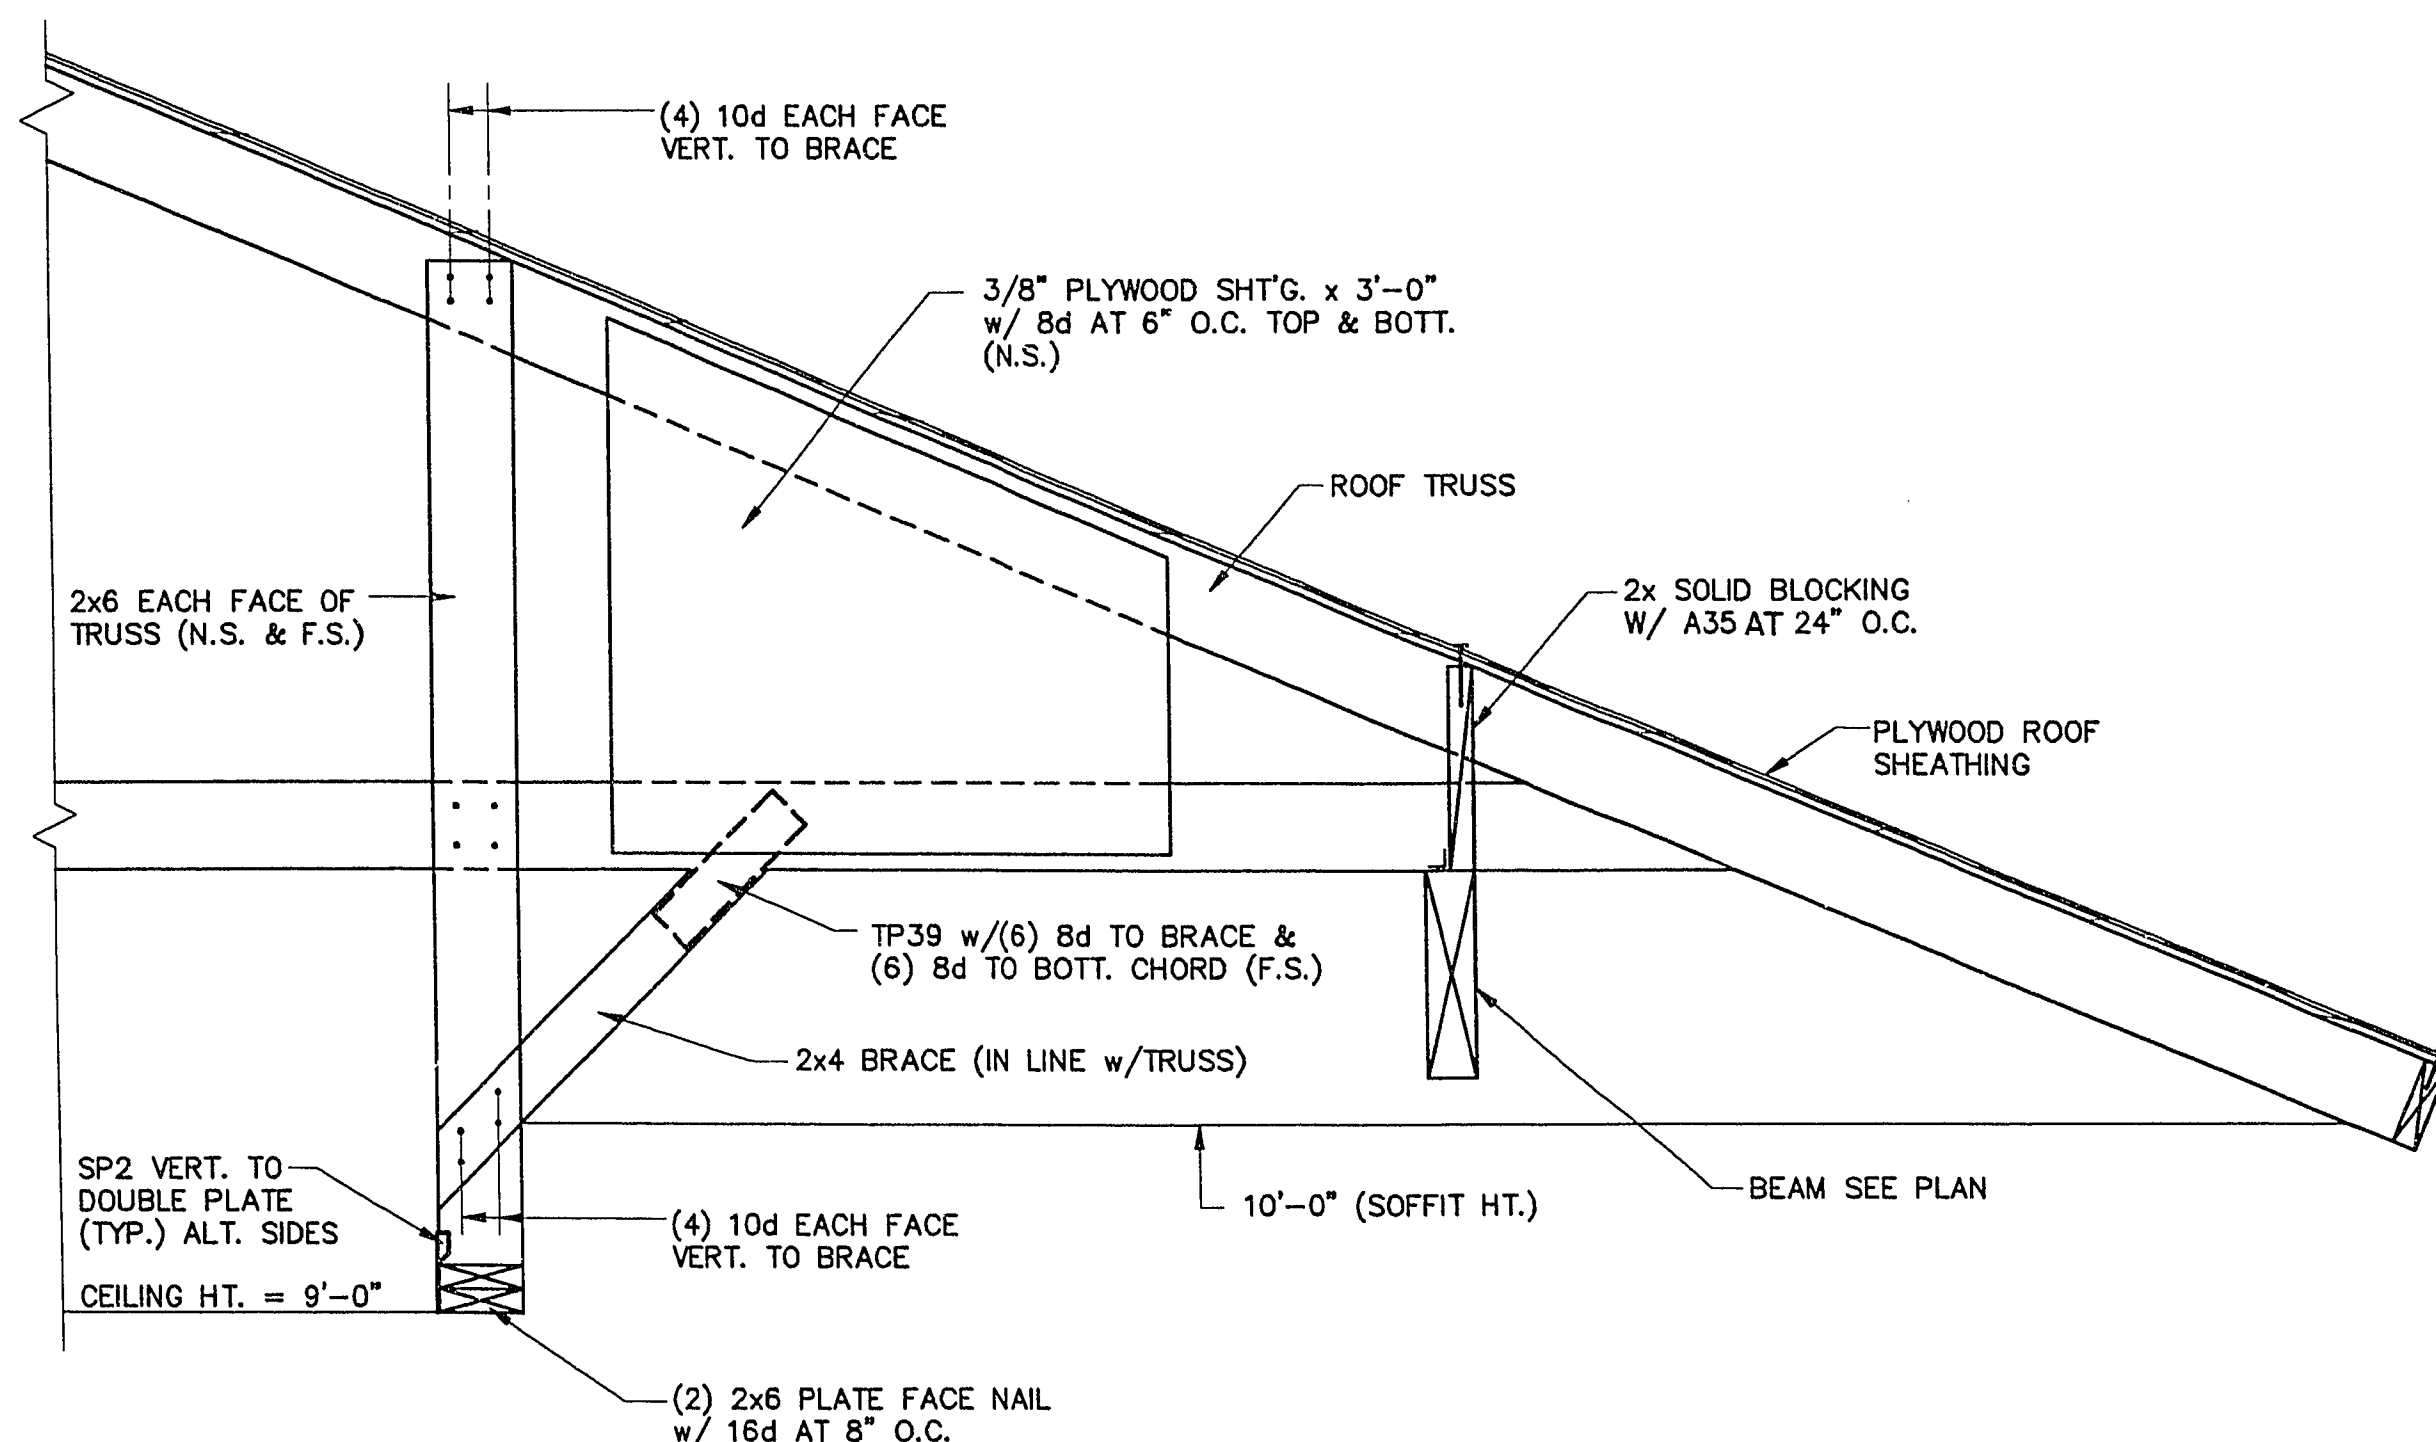

DETAIL

1" = 1'-0"

8

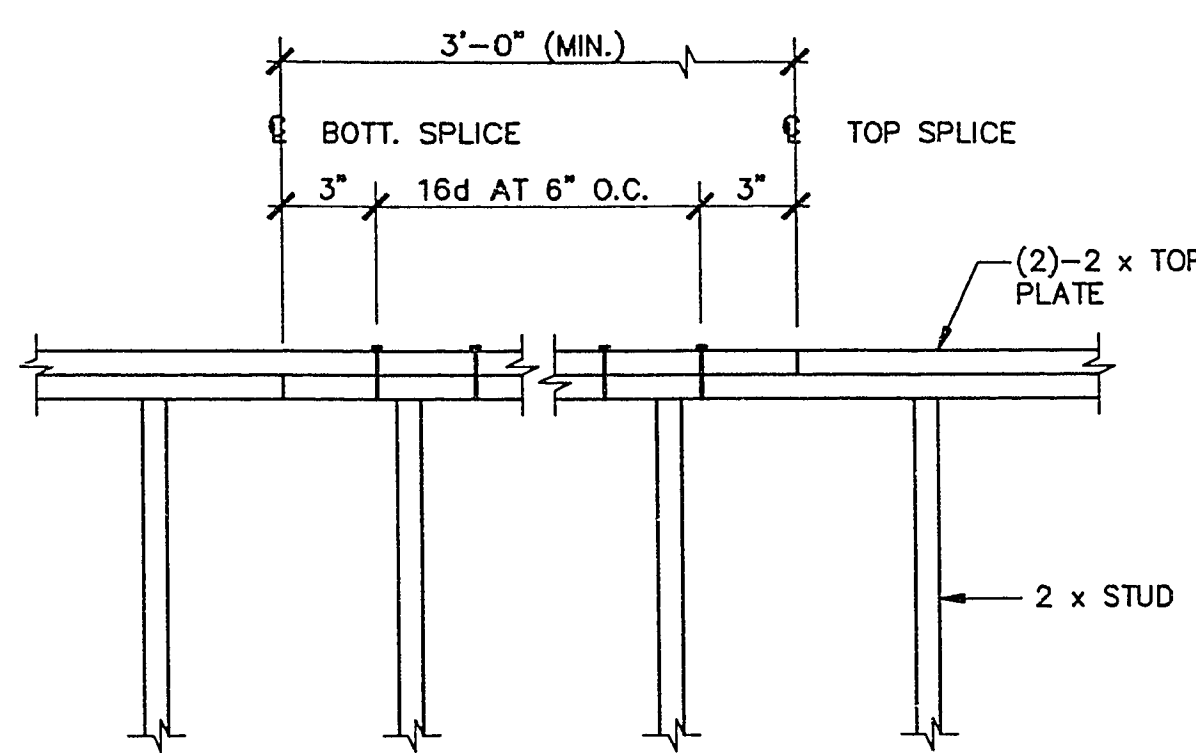


TYP. DBL. TOP CHORD SPLICE

DETAIL

NO SCALE


3

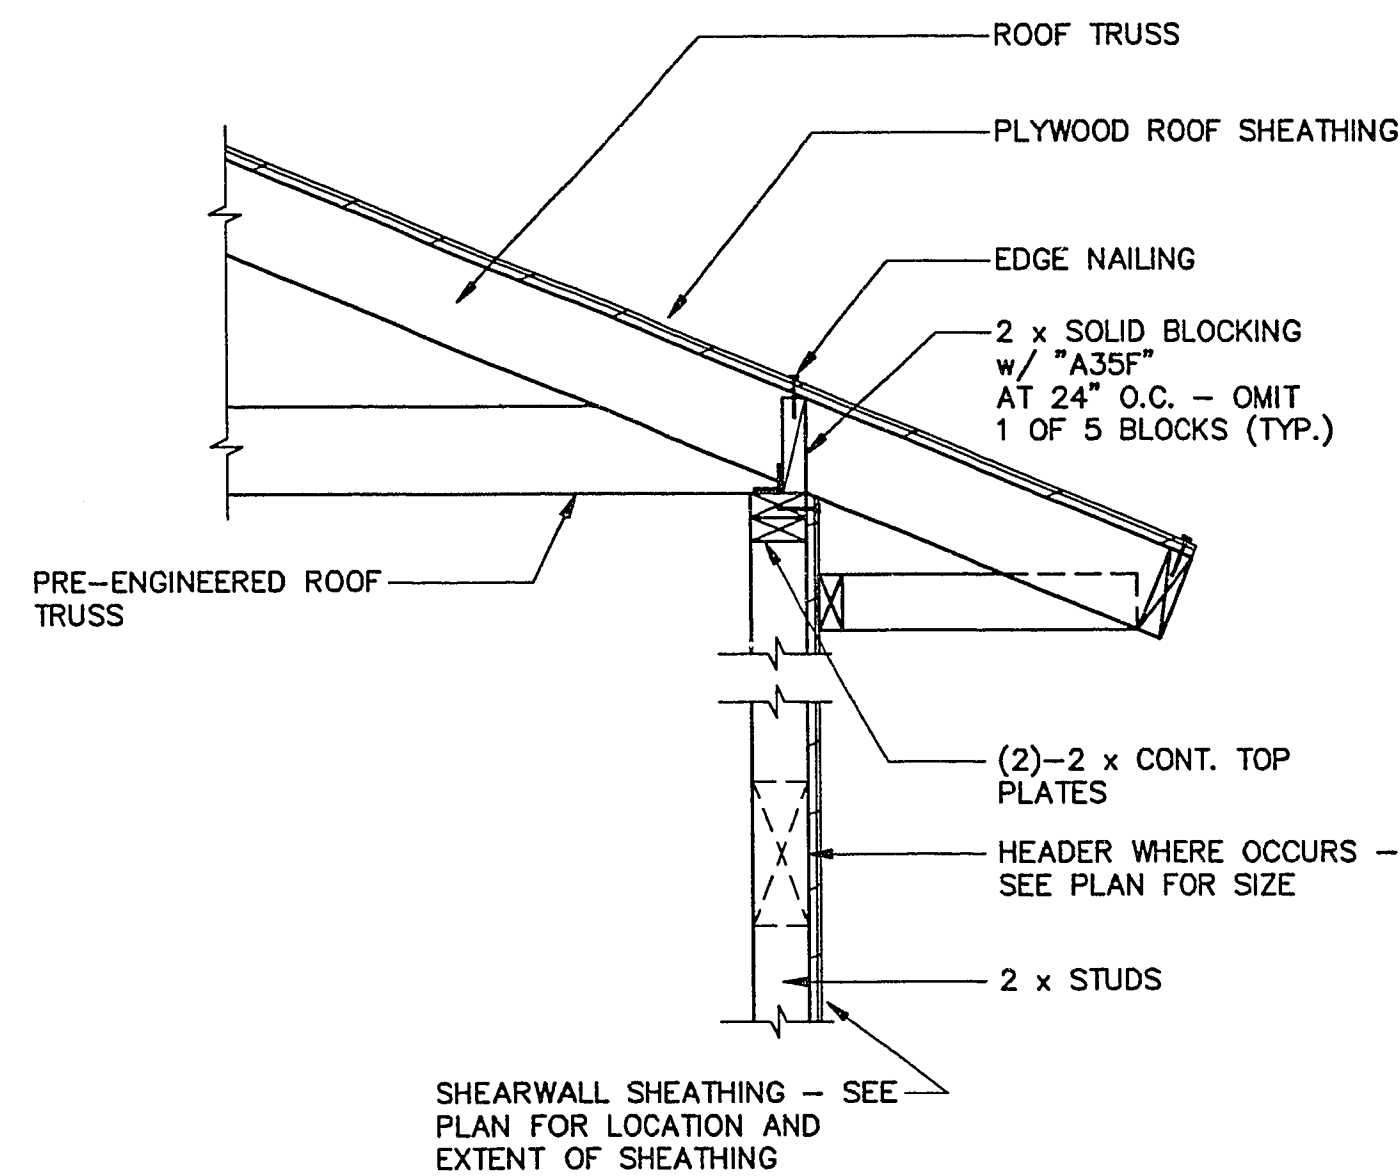

DETAIL

1" = 1'-0"


4

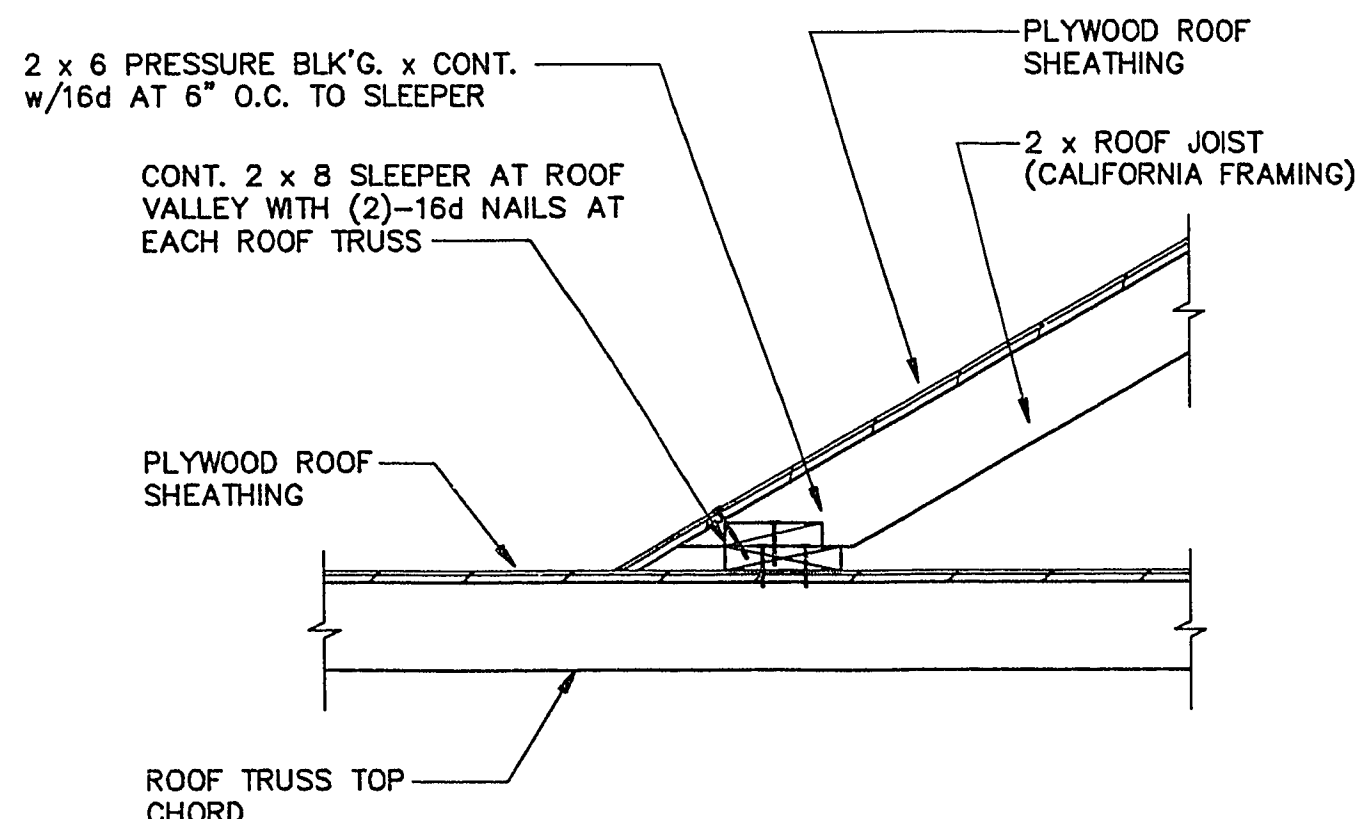

DETAIL

1" = 1'-0"

5

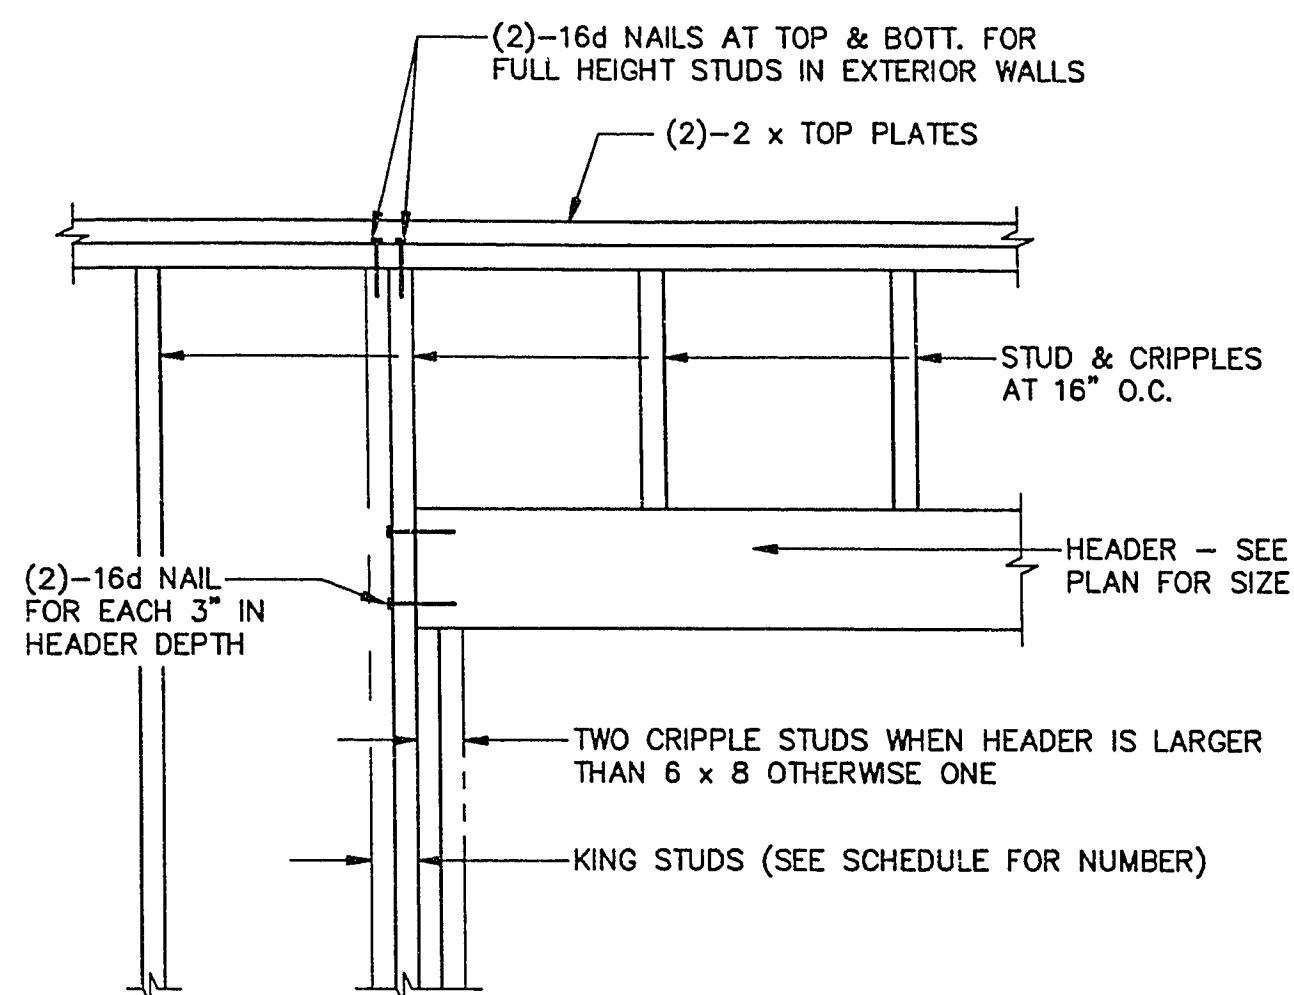


TYPICAL HEADER


DETAIL

NO SCALE

1

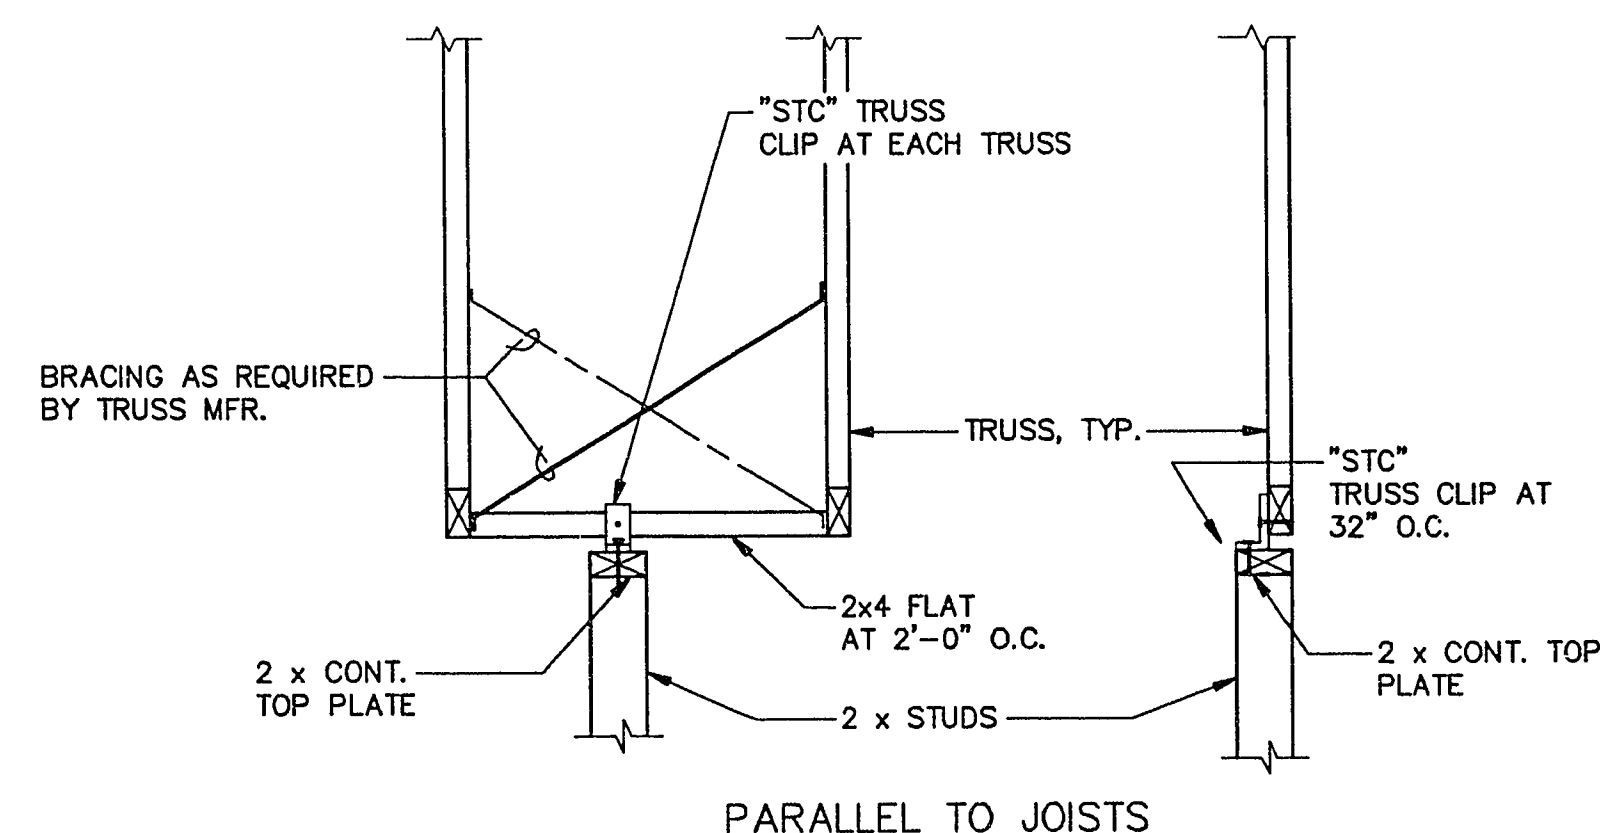

PARALLEL TO JOISTS

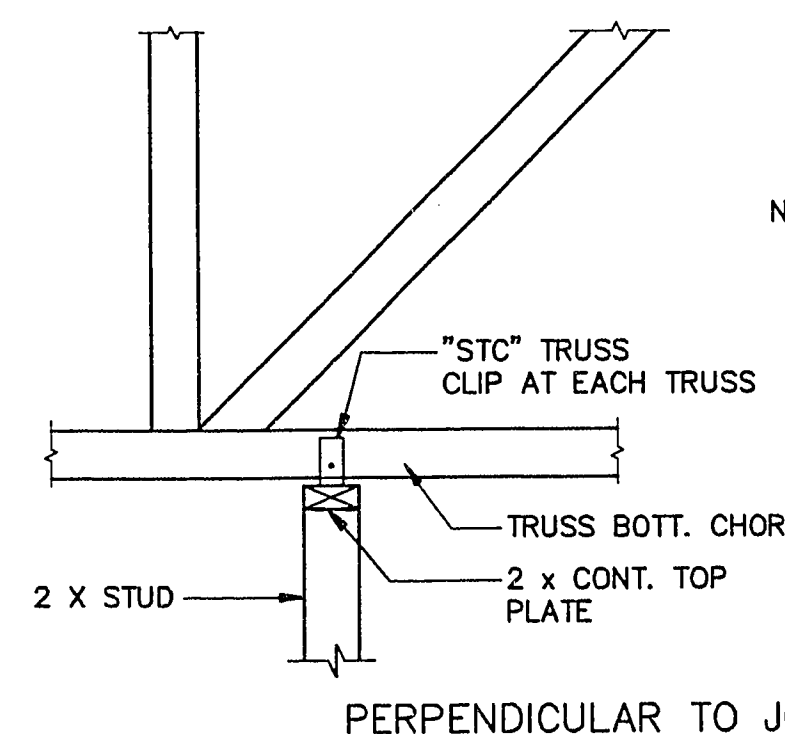

TYP. NON-BEARING PARTITION CONNECTION DETAIL

DETAIL

NO SCALE


2

KING STUD SCHEDULE		HEADER SCHEDULE	
EXTERIOR WALLS LESS THAN 11'-4"		NON-BEARING WALLS	
OPENING WIDTH	HEADER SIZE	OPENING WIDTH	HEADER SIZE
5'-0" OR LESS	(1)DF	3'-0" OR LESS	(1)-2 x 4 FLAT
3'-0" TO 4'-0"	(1)DF	3'-0" TO 4'-0"	(2)-2 x 4 FLAT
	(2)DF	4'-0" TO 8'-0"	4 x 6
	(2)DF		

DATE	04/19/95	REVISION	

ANY INFORMATION OR DATA ON THIS DRAWING IS NOT INTENDED TO BE SUITABLE FOR REUSE IN ANY OTHER PROJECT. ANY REUSE WITHOUT WRITTEN PERMISSION AND ADAPTATION BY THE ENGINEER FOR THE SPECIFIC PURPOSE INTENDED AND THE USER'S SOLE RISK AND RESPONSIBILITY.

POGGEMEYER DESIGN GROUP
SURVEYORS
PLANNERS
ENGINEERS
1140 ALMOND TREE LANE, SUITE 306 LAS VEGAS, NEVADA 89104 (702) 735-5108

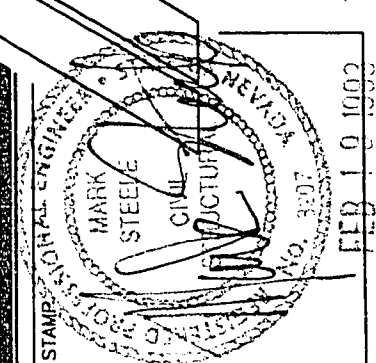

DETAILS
WEST SERVICE CENTER
PHASE I
B. & S., Q.C. & SANT. SITES

JOB NUMBER	91012
DESIGNED BY	MS
DRAWN BY	JDS
CHECKED BY	MS
DATE	1/15/92
SHEET NUMBER	48 of 78
S5-2	OF 11

AS-BUILT