
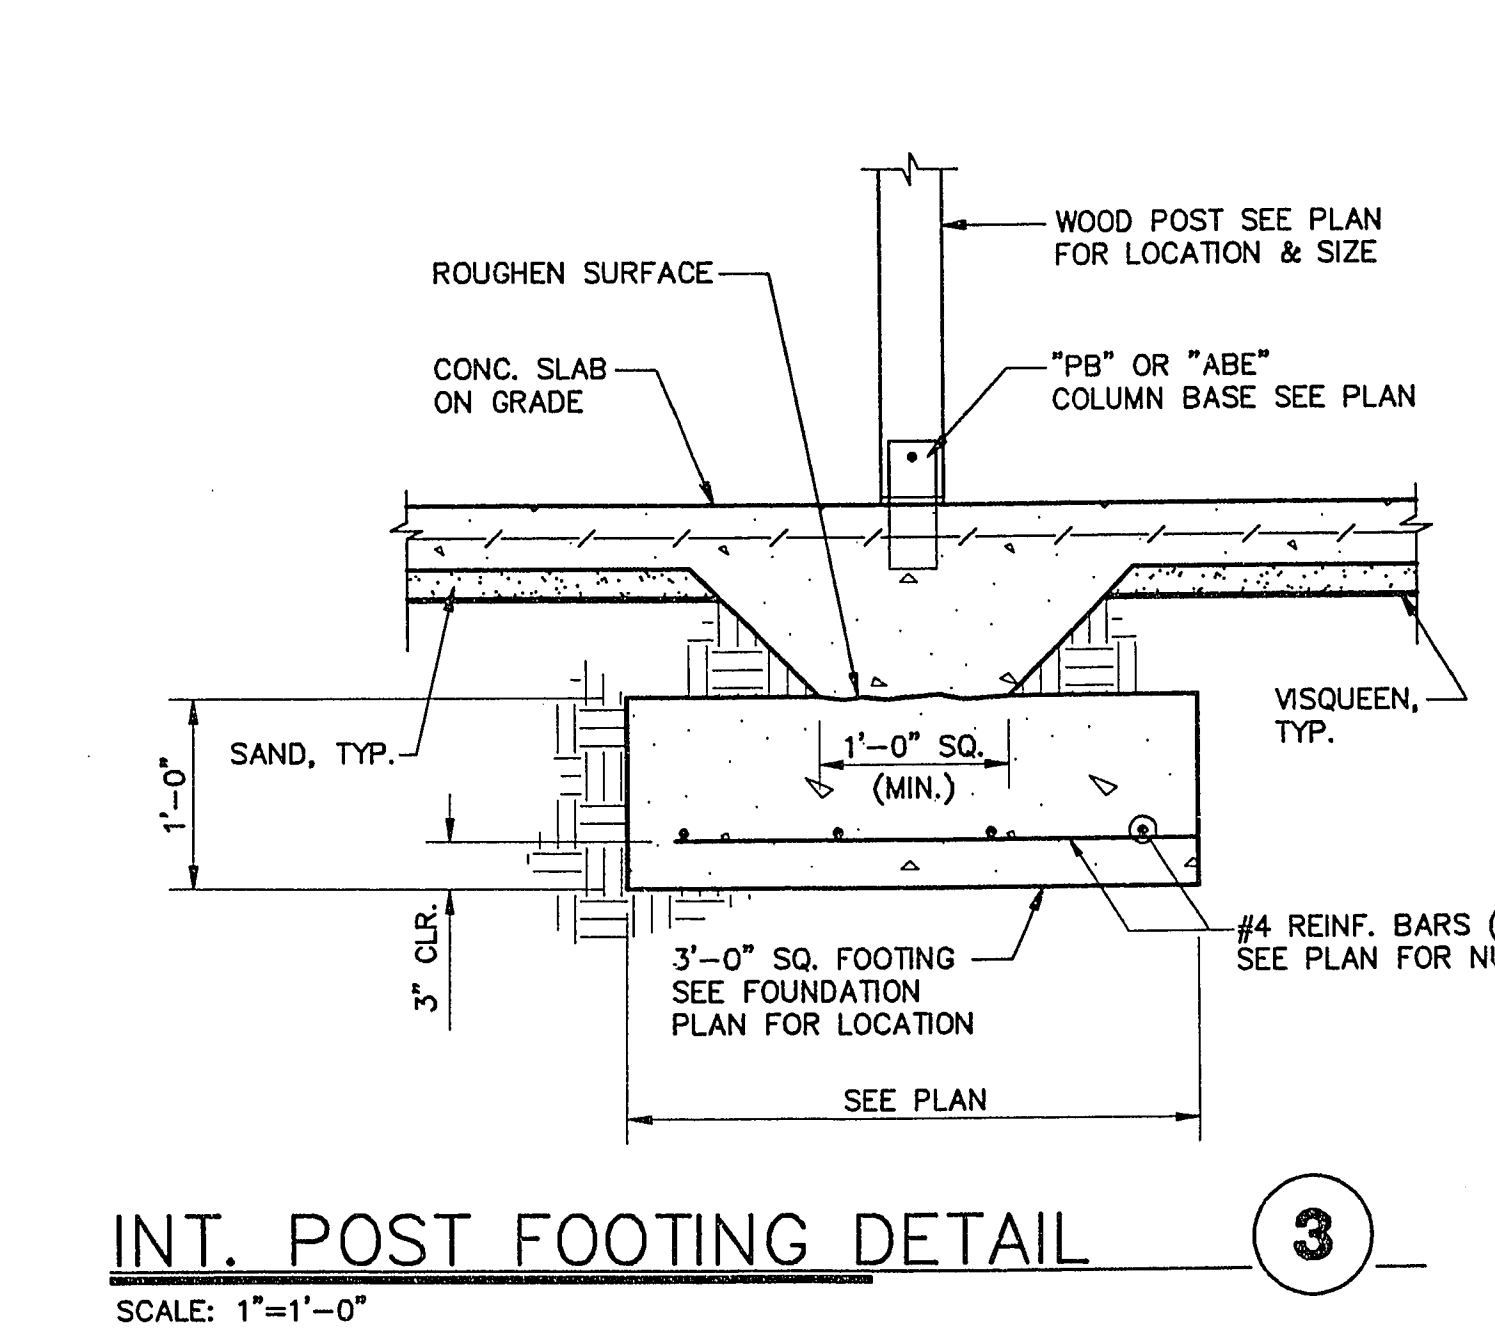
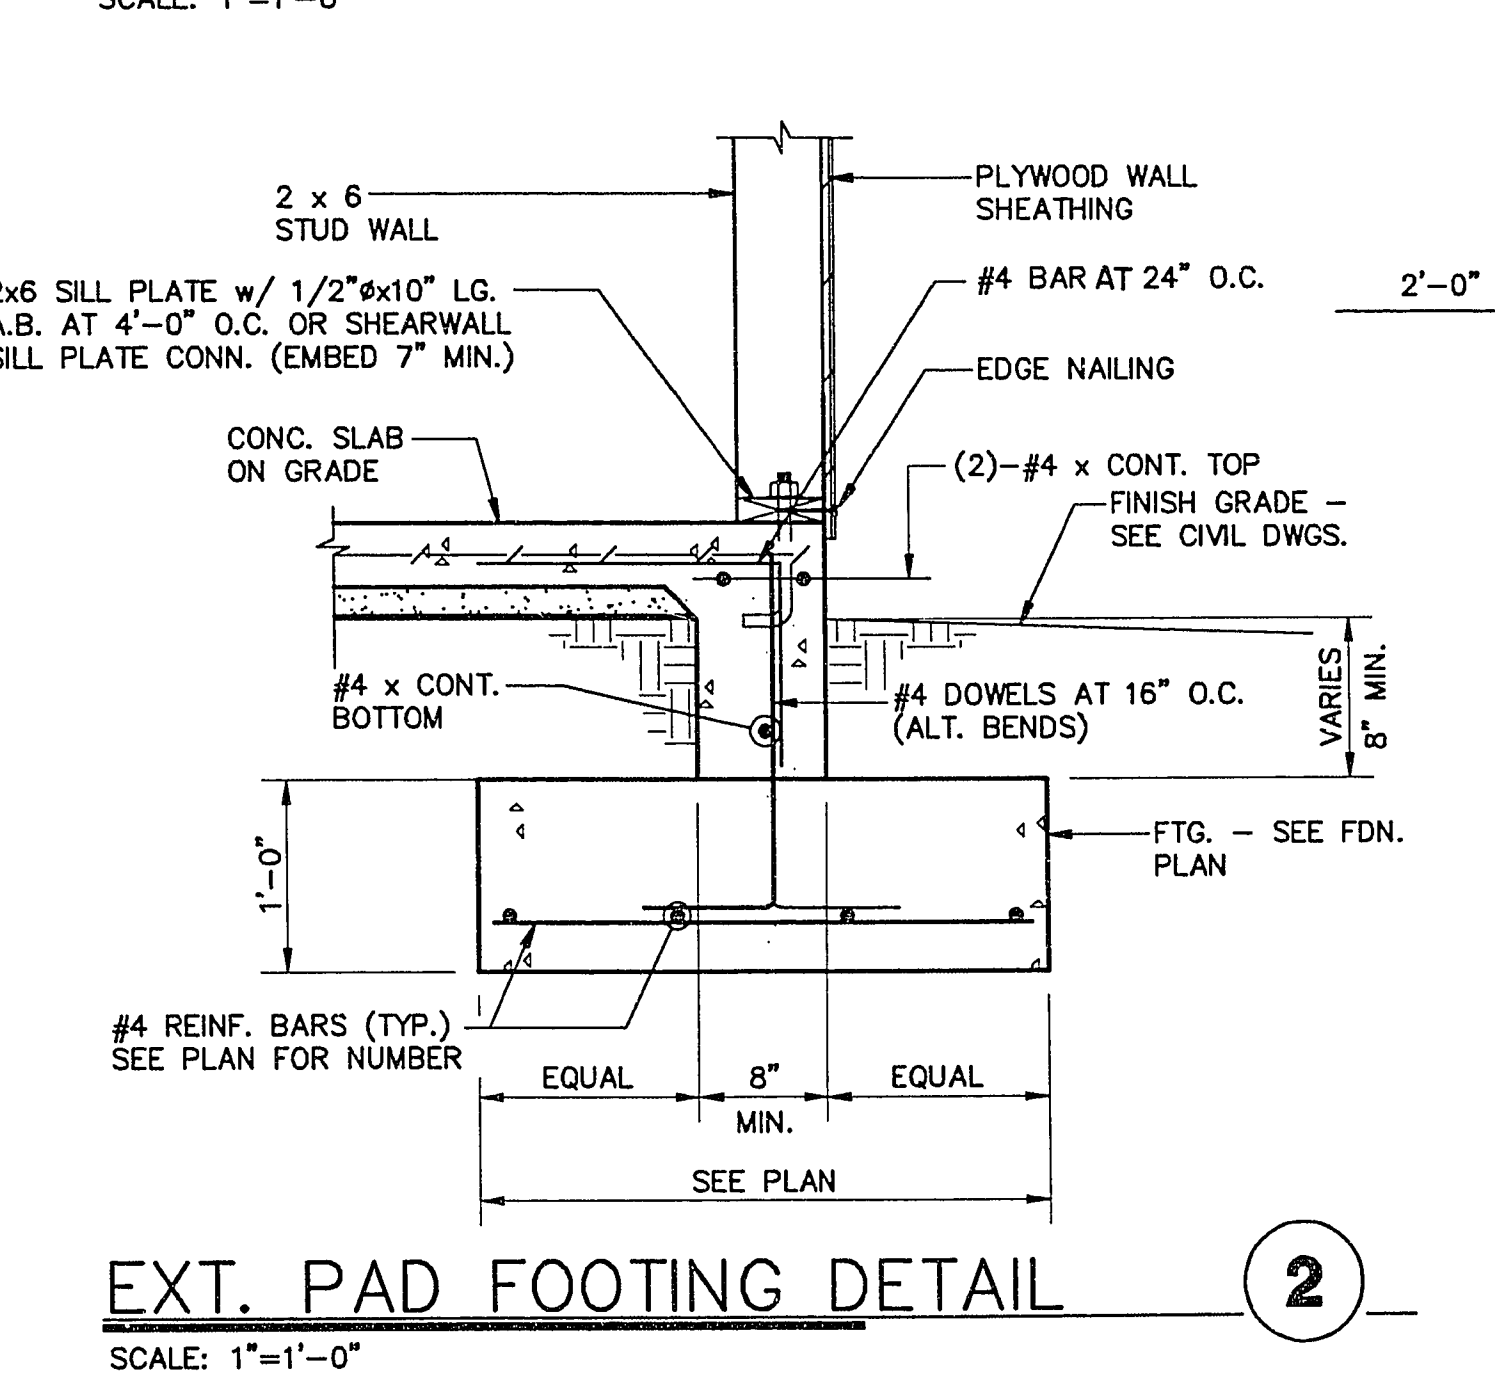
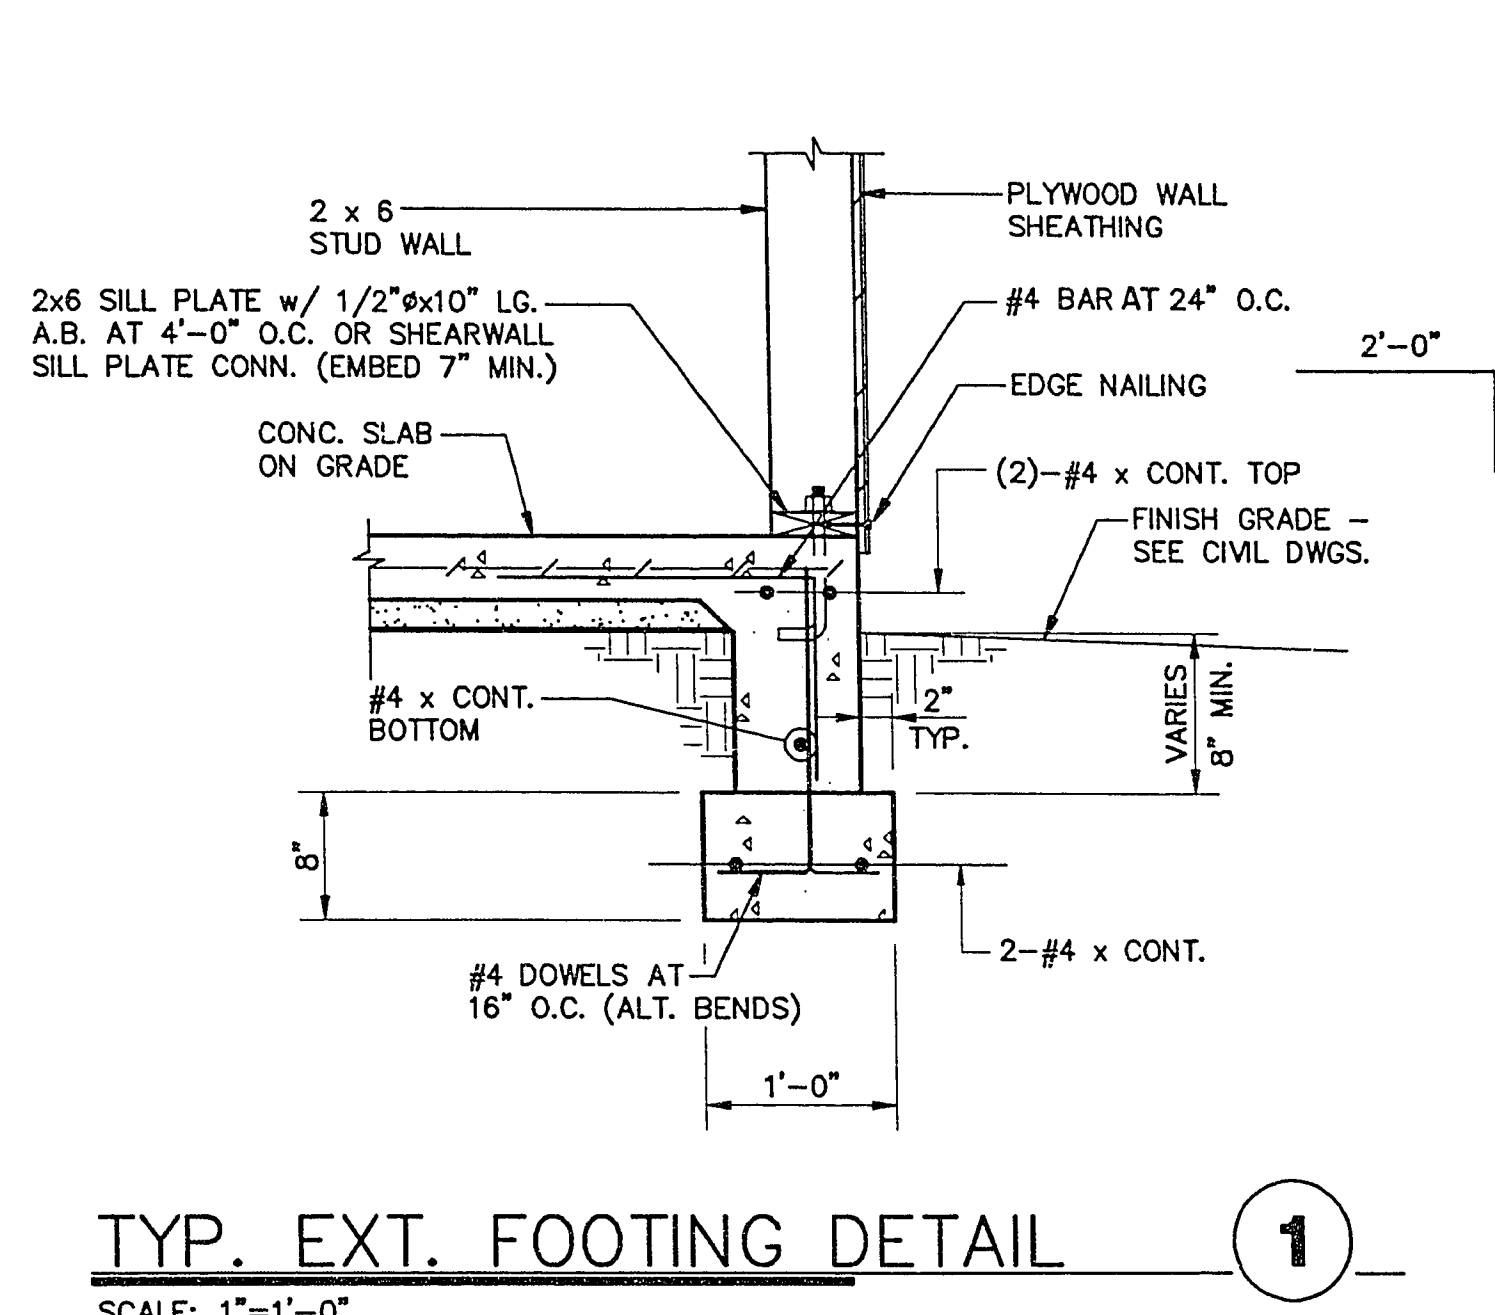
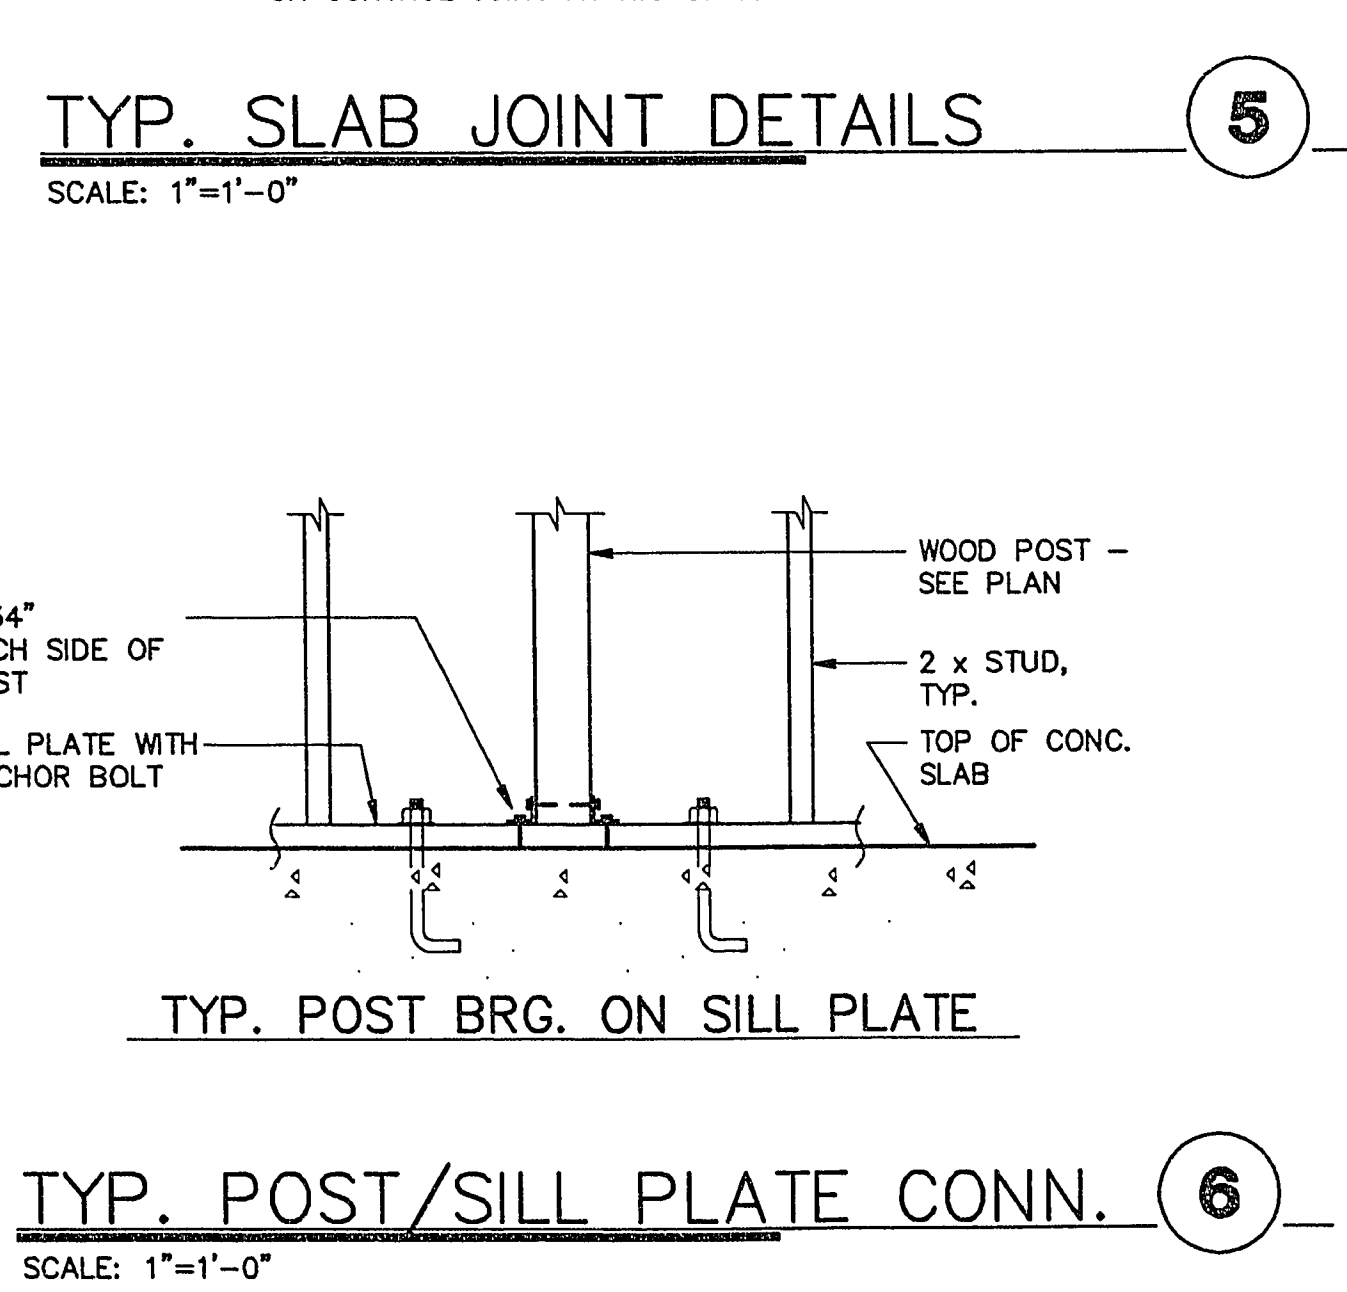
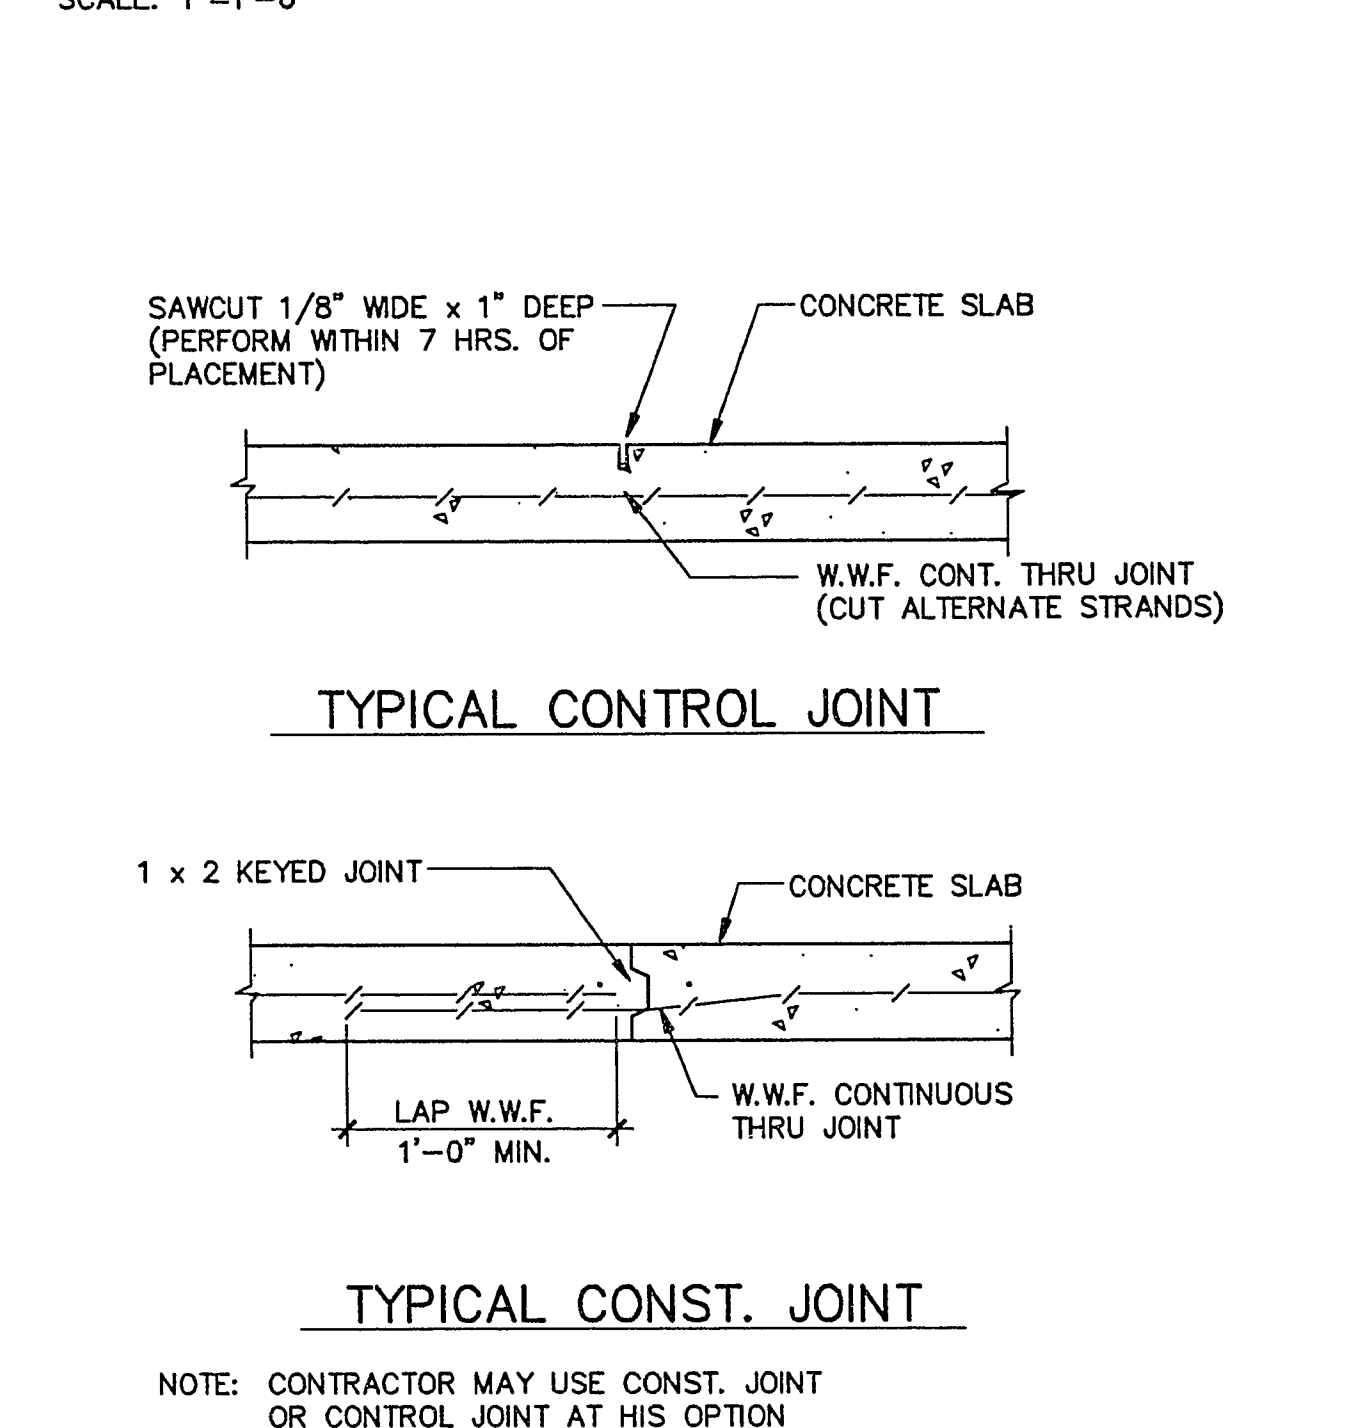
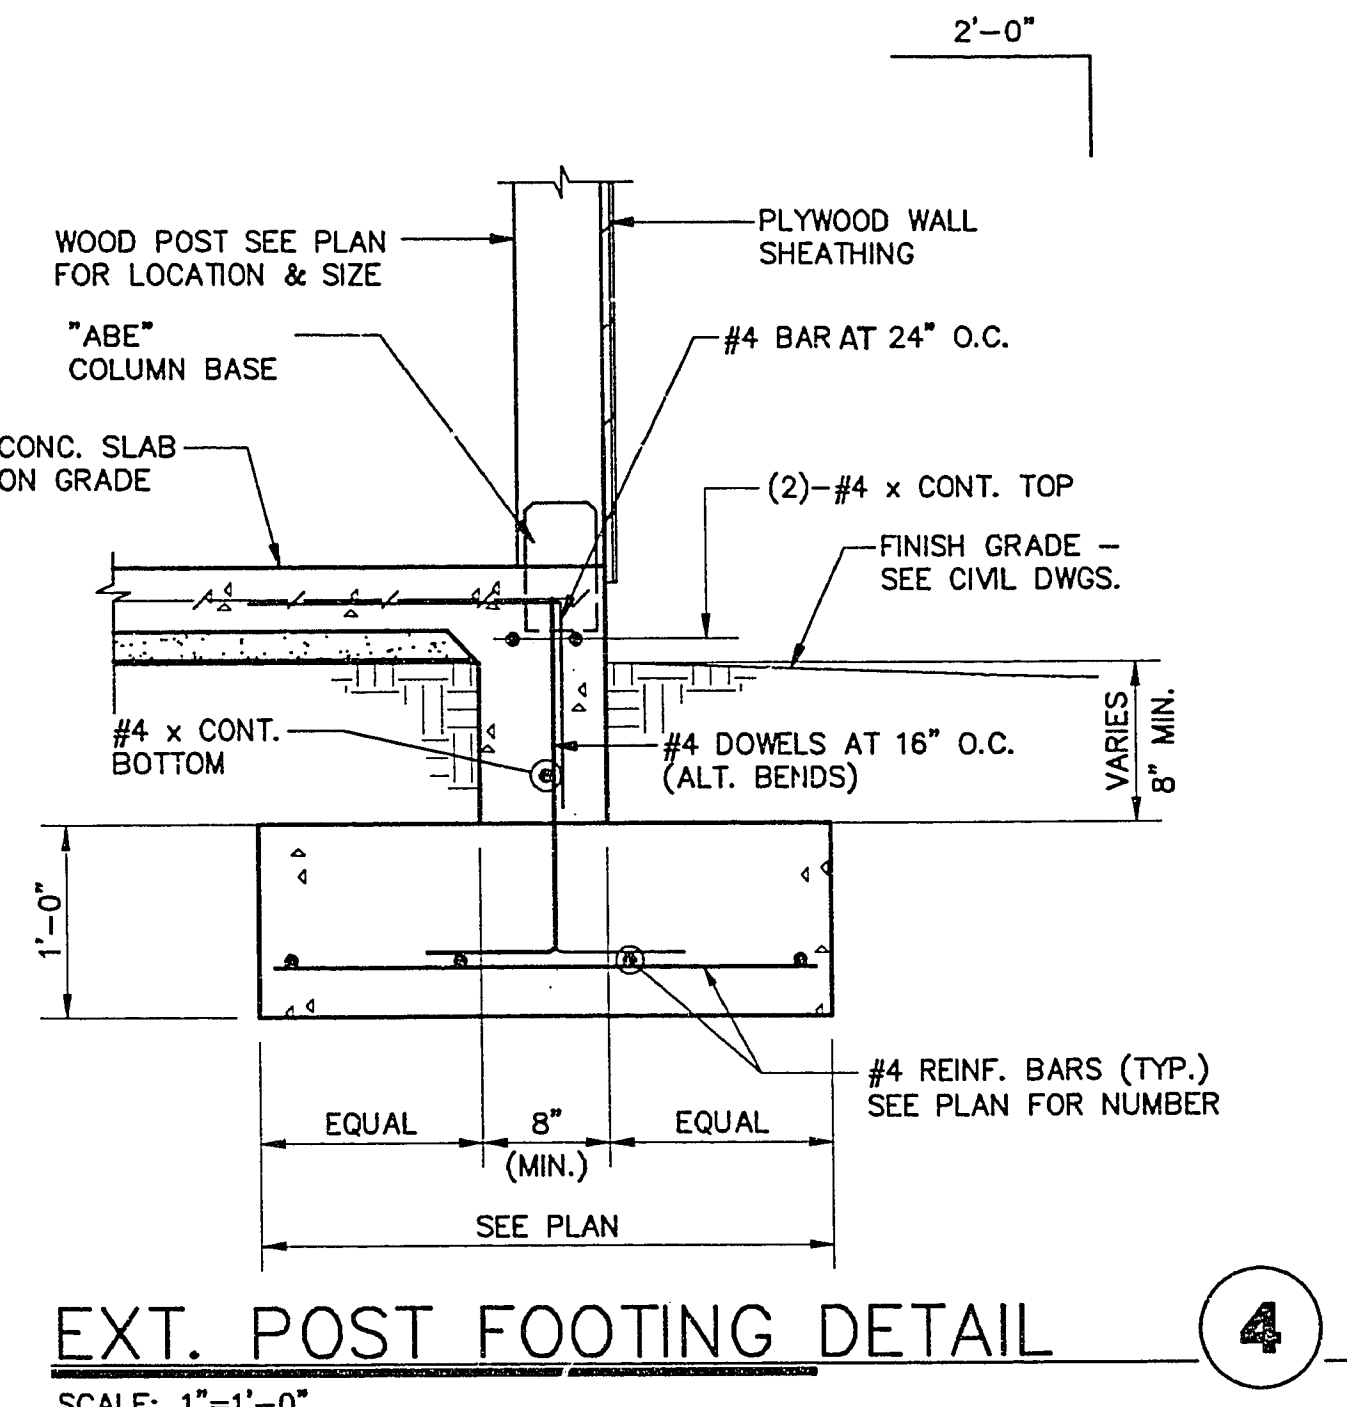
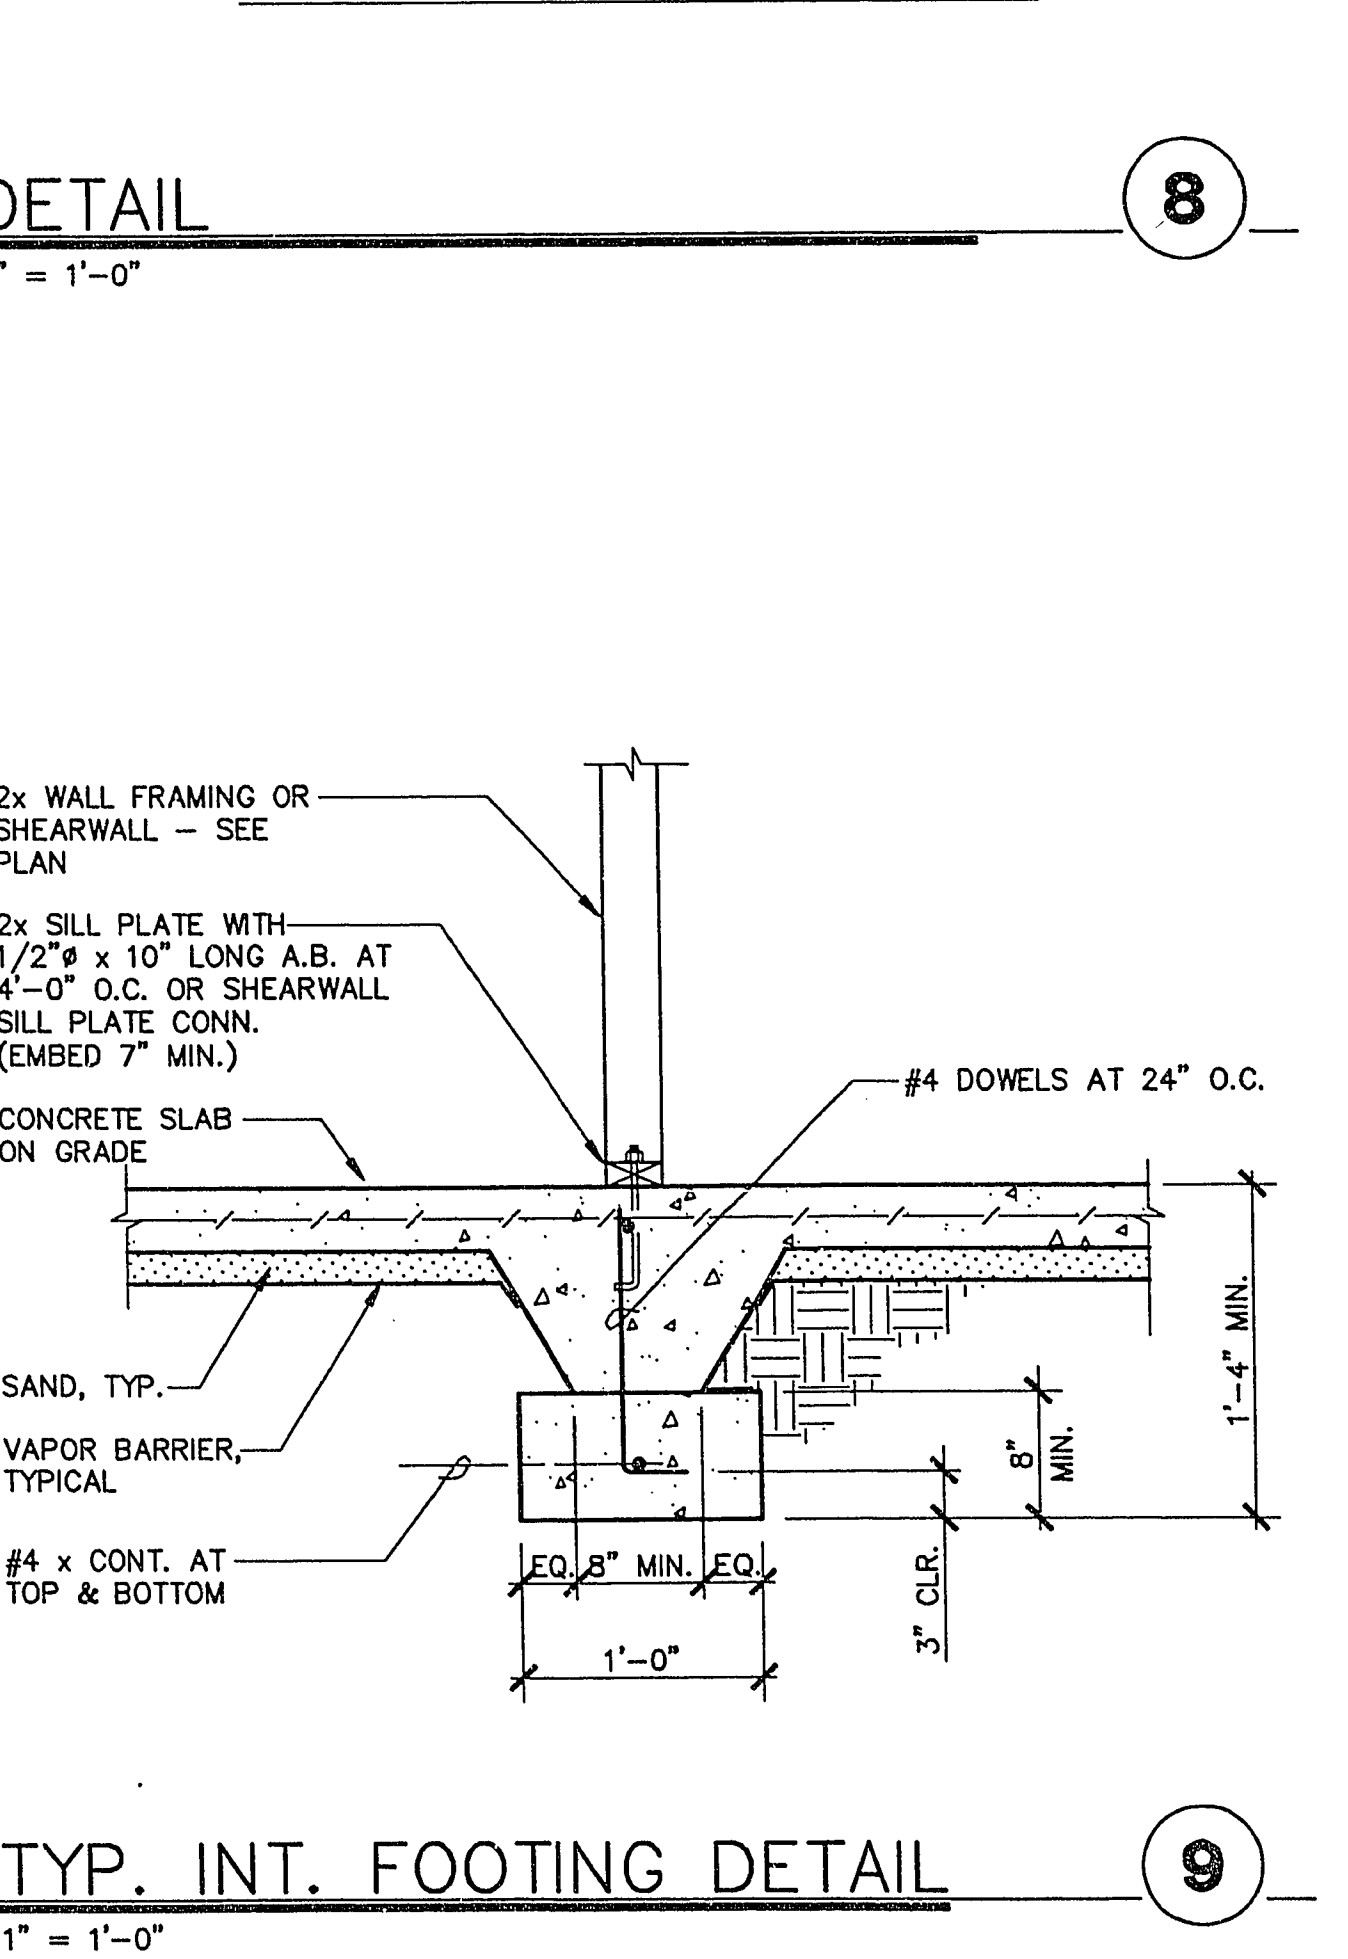
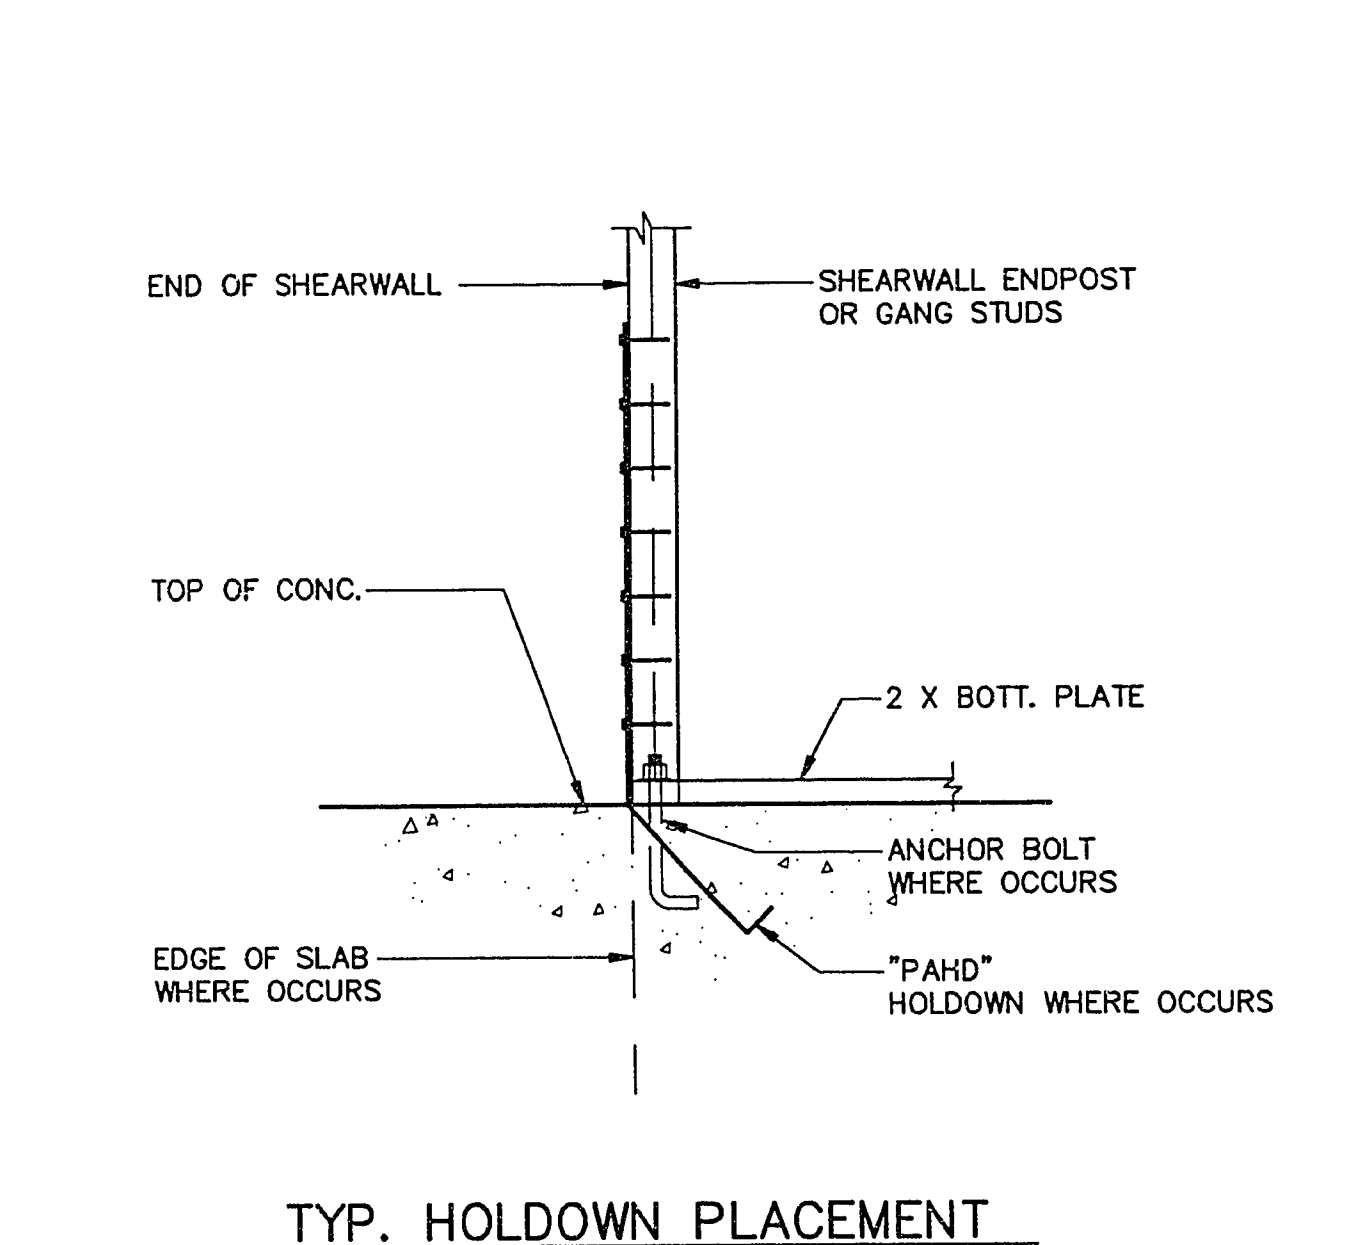


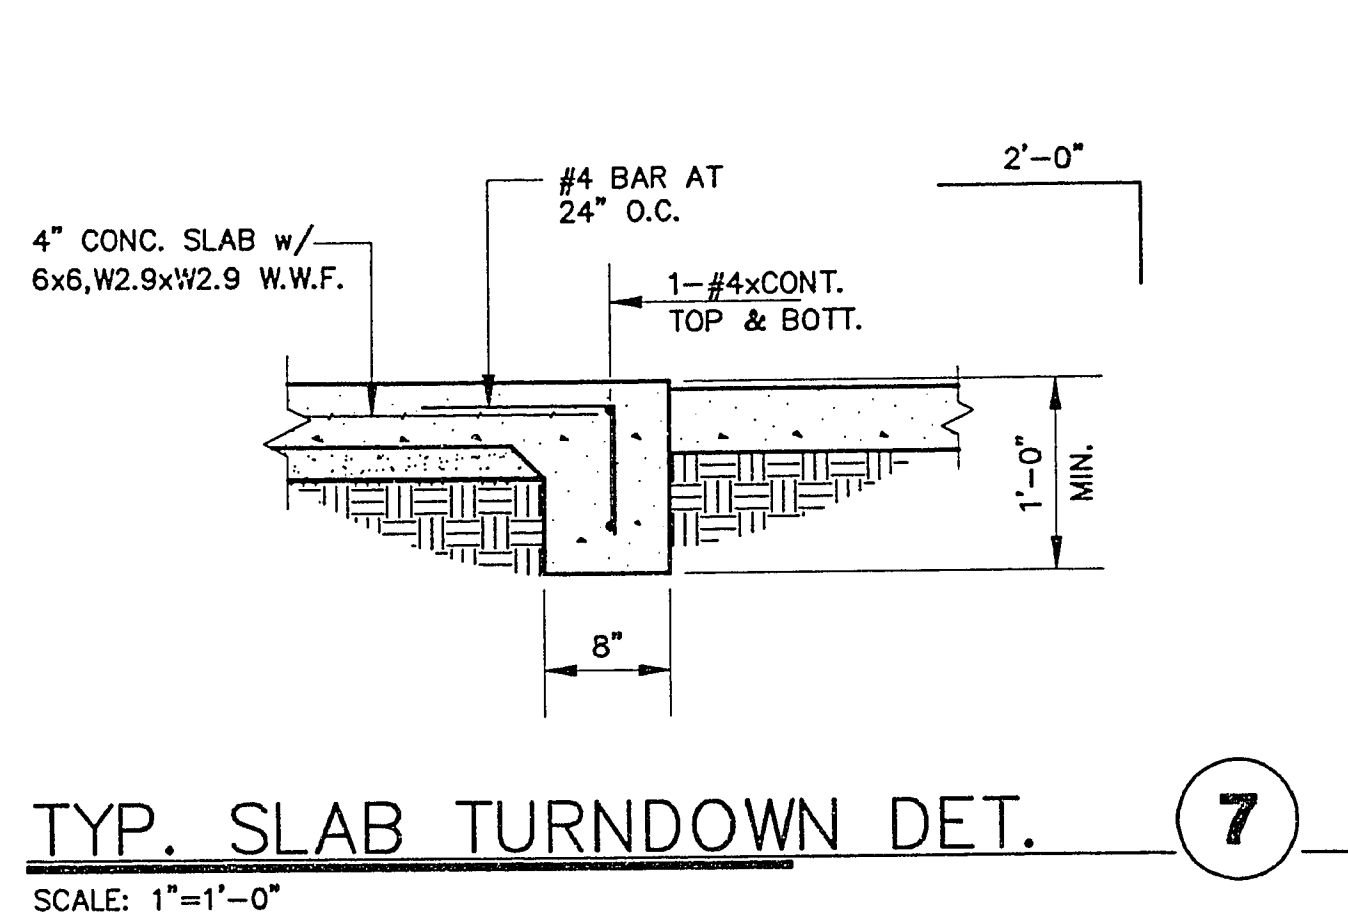

DATE	04/19/95	REVISION	
DESIGNED BY	MS	DRAWN BY	JDS
CHECKED BY	MS	DATE	1/15/92
JOB NUMBER	91012	SHEET NUMBER	47 of 78
S5-1 OF 11			

POGEMEYER DESIGN GROUP
 ENGINEERS
 PLANNERS
 SURVEYORS
 1140 ALMOND TREE LANE, SUITE 306 LAS VEGAS, NEVADA 89104 (702) 735-5108

WEST SERVICE CENTER
PHASE I
B. & S., Q.C. & SANT. SITES

DETAILS

AS BUILT