



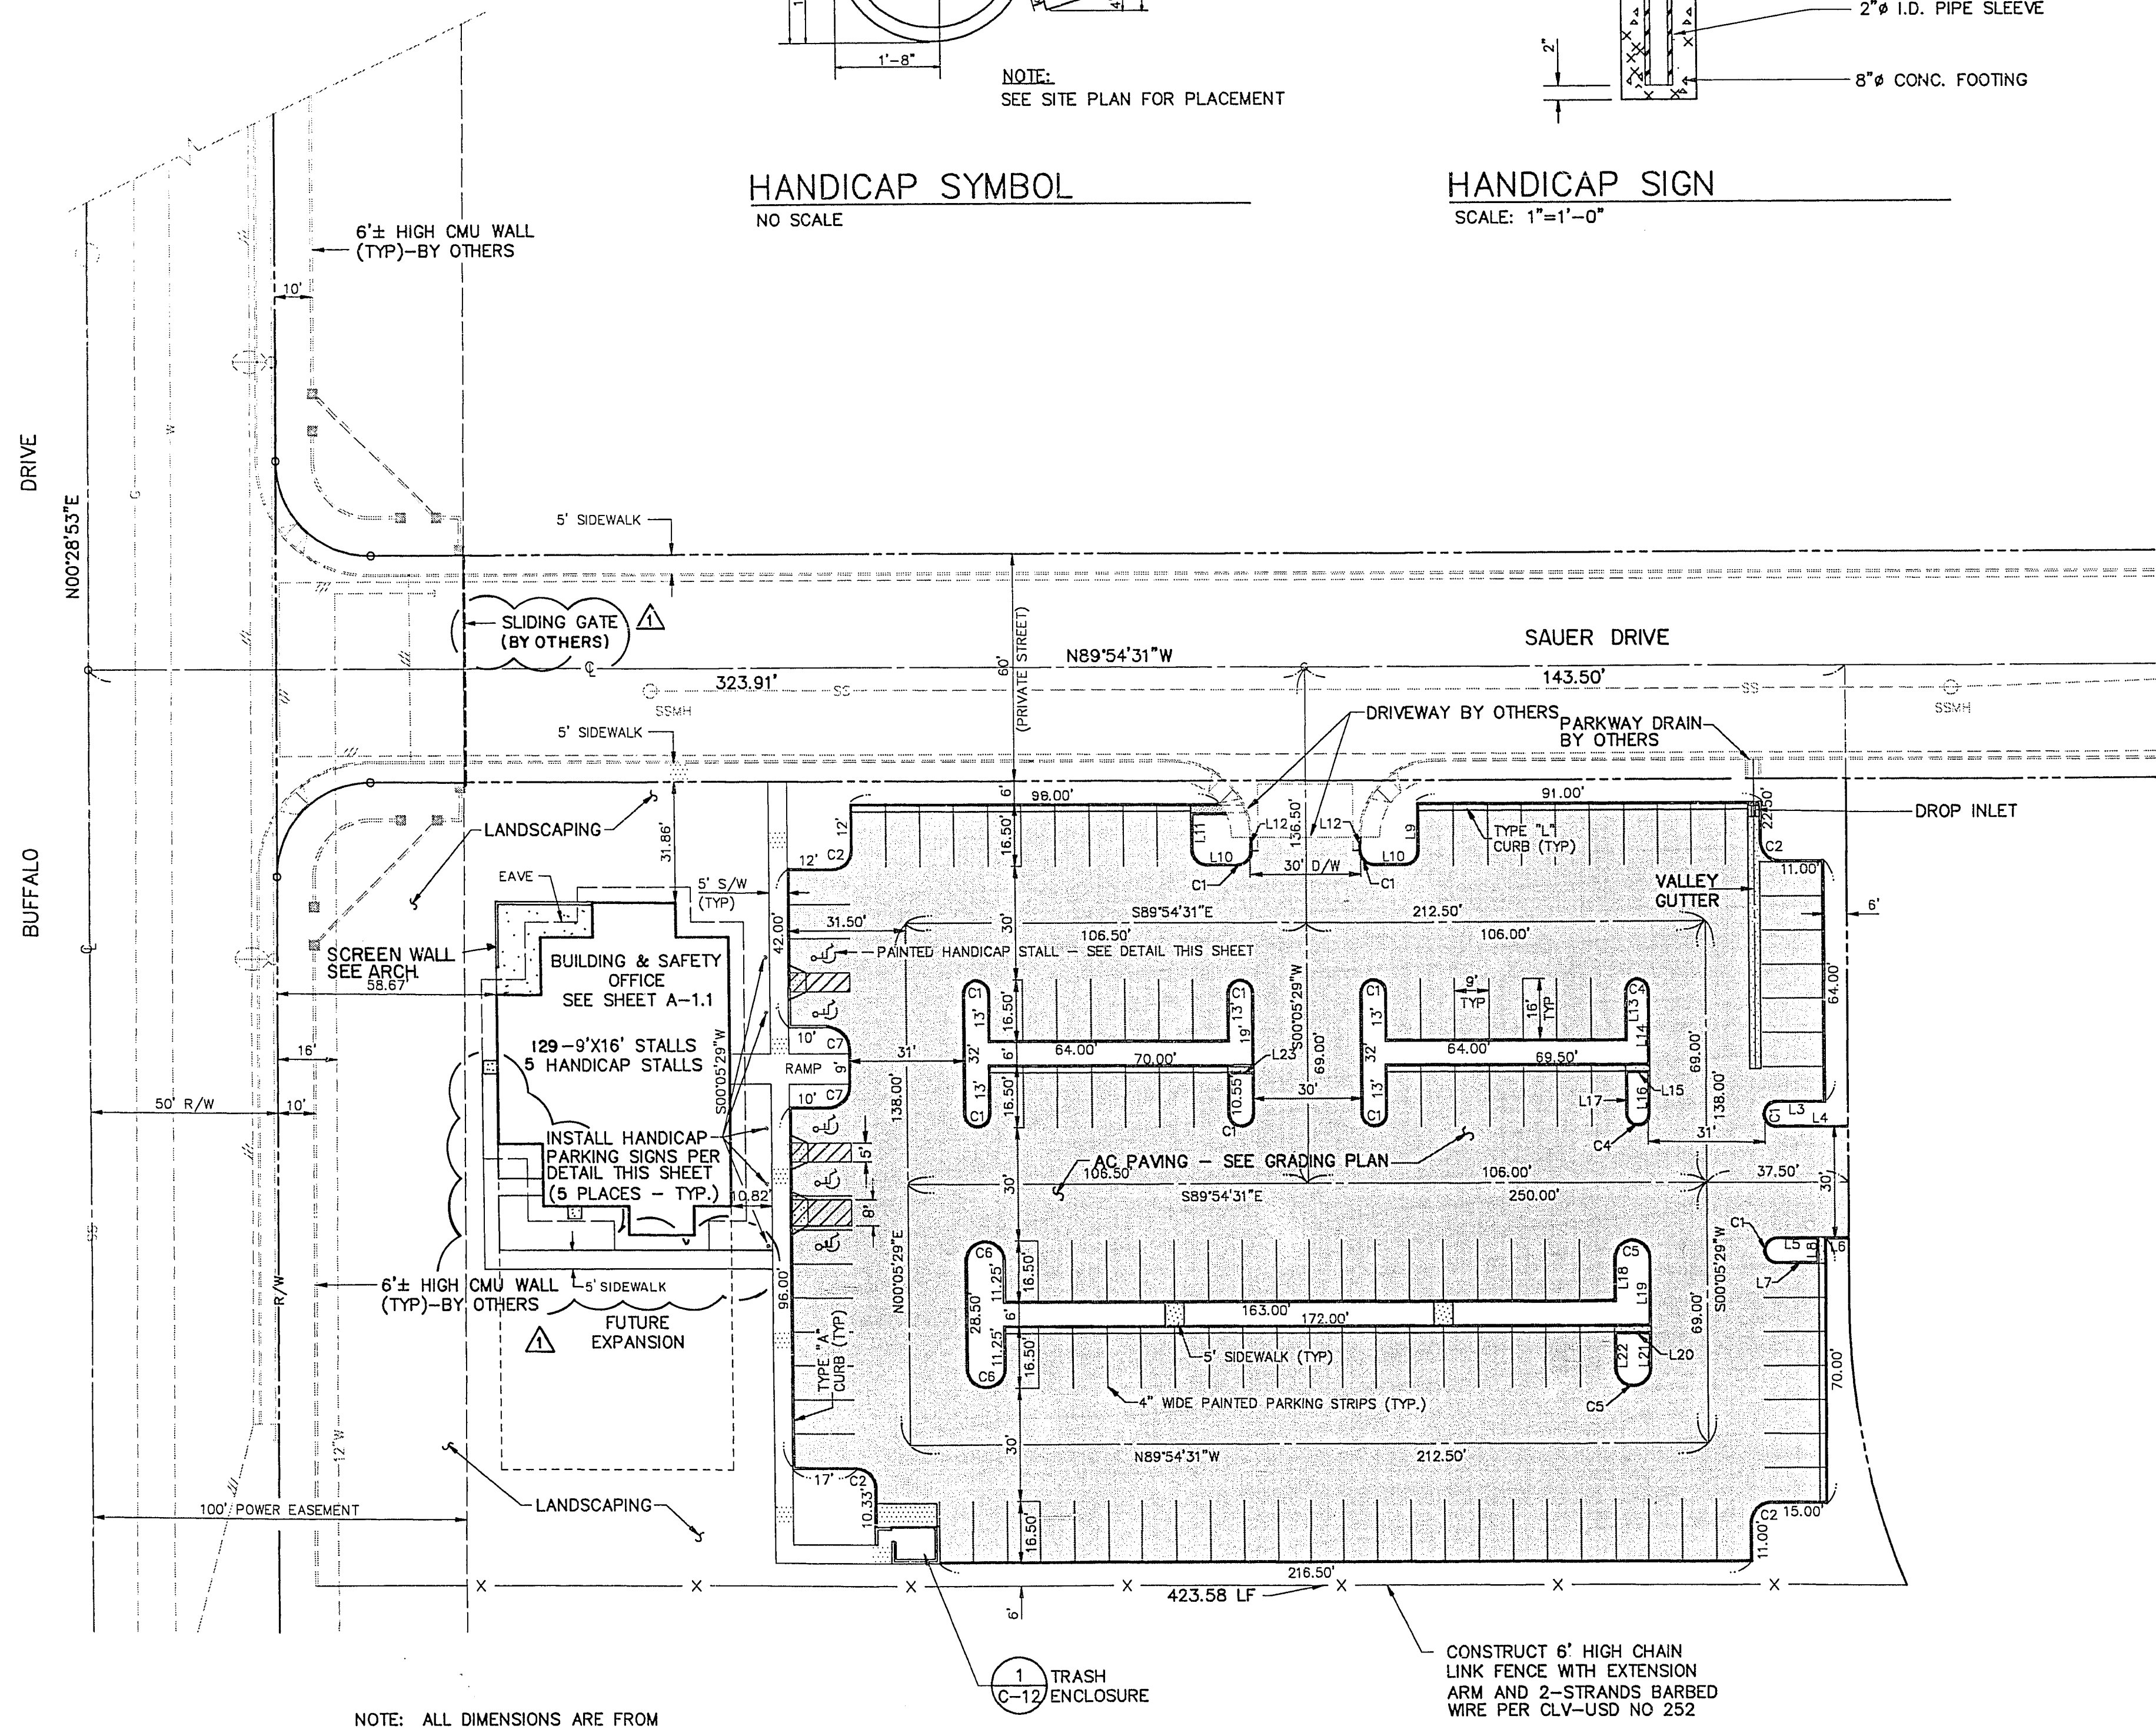

HANDICAP SYMBOL
NO SCALE

HANDICAP SIGN
SCALE: 1"=1'-0"

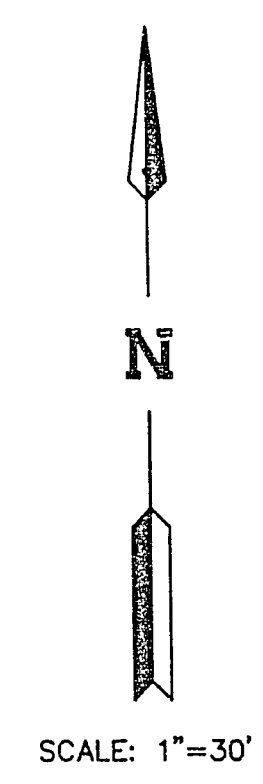

BASIS OF BEARINGS:
S89°56'51"E - BEING THE SOUTH LINE OF THE S.E. 1/4
OF THE S.W. 1/4 OF SECTION 10, T.26S., R.60E., M.D.B. & M.

NOTE:
ALL WORK WITHIN SAUER DRIVE
AND ALL ENTRY WALLS BY OTHERS.

CURVE TABLE			
CURVE	RADIUS	LENGTH	DELTA
C1	3.00'	9.42'	180°00'00"
C2	5.00'	7.85'	90°00'00"
C3	2.75'	8.64'	180°00'00"
C4	4.50'	14.14'	180°00'00"
C5	4.75'	14.92'	180°00'00"
C6	6.00'	9.42'	90°00'00"

LINE TABLE		
LINE	DIRECTION	DISTANCE
L1	S00°05'29"W	13.00'
L2	N00°05'29"E	13.00'
L3	S89°54'31"E	13.00'
L4	S89°54'31"E	19.00'
L5	N89°54'31"W	10.50'
L6	N89°54'31"W	6.00'
L7	S89°54'31"E	10.50'
L8	N00°05'29"E	6.00'
L9	N00°05'29"E	12.50'
L10	S89°54'31"E	8.00'
L11	S00°05'29"W	9.50'
L12	N00°05'29"E	13.50'
L13	N00°05'29"E	13.25'
L14	S00°05'29"W	19.25'
L15	N89°54'31"W	5.50'
L16	N00°05'29"E	10.75'
L17	S00°05'29"W	10.75'
L18	S00°05'29"W	11.50'
L19	S00°05'29"W	12.50'
L20	S89°54'31"E	9.00'
L21	N00°05'29"E	9.00'
L22	N00°05'29"E	9.00'
L23	N89°54'31"W	6.00'

AS-BUILT

DATE
04/19/95

REVISION
RECORD DRAWINGS

ENGINEERS
PLANNERS
SURVEYORS

POGGEMEYER DESIGN GROUP

1140 ALMOND TREE LANE, SUITE 306
LAS VEGAS, NEVADA 89104
(702) 735-5108

WEST SERVICE CENTER
PHASE I
BUILDING AND SAFETY

SITE PLAN

JOB NUMBER
91012

DESIGNED BY
GP

DRAWN BY
EC

CHECKED BY
TP

DATE
8-7-92

SHEET NUMBER
4 of 78

C-4

4 of 12

ANY INFORMATION OR DATA ON THIS DRAWING IS NOT INTENDED TO BE SUITABLE FOR REUSE BY ANY PERSON, FIRM, CORPORATION, OR ANY OTHERS ON EXTENSIONS OF THIS DRAWING OR FOR ANY OTHER PURPOSES. THE USER'S SOLE RISK AND WITHOUT LIABILITY OR LEGAL EXPOSURE TO THE ENGINEER.