
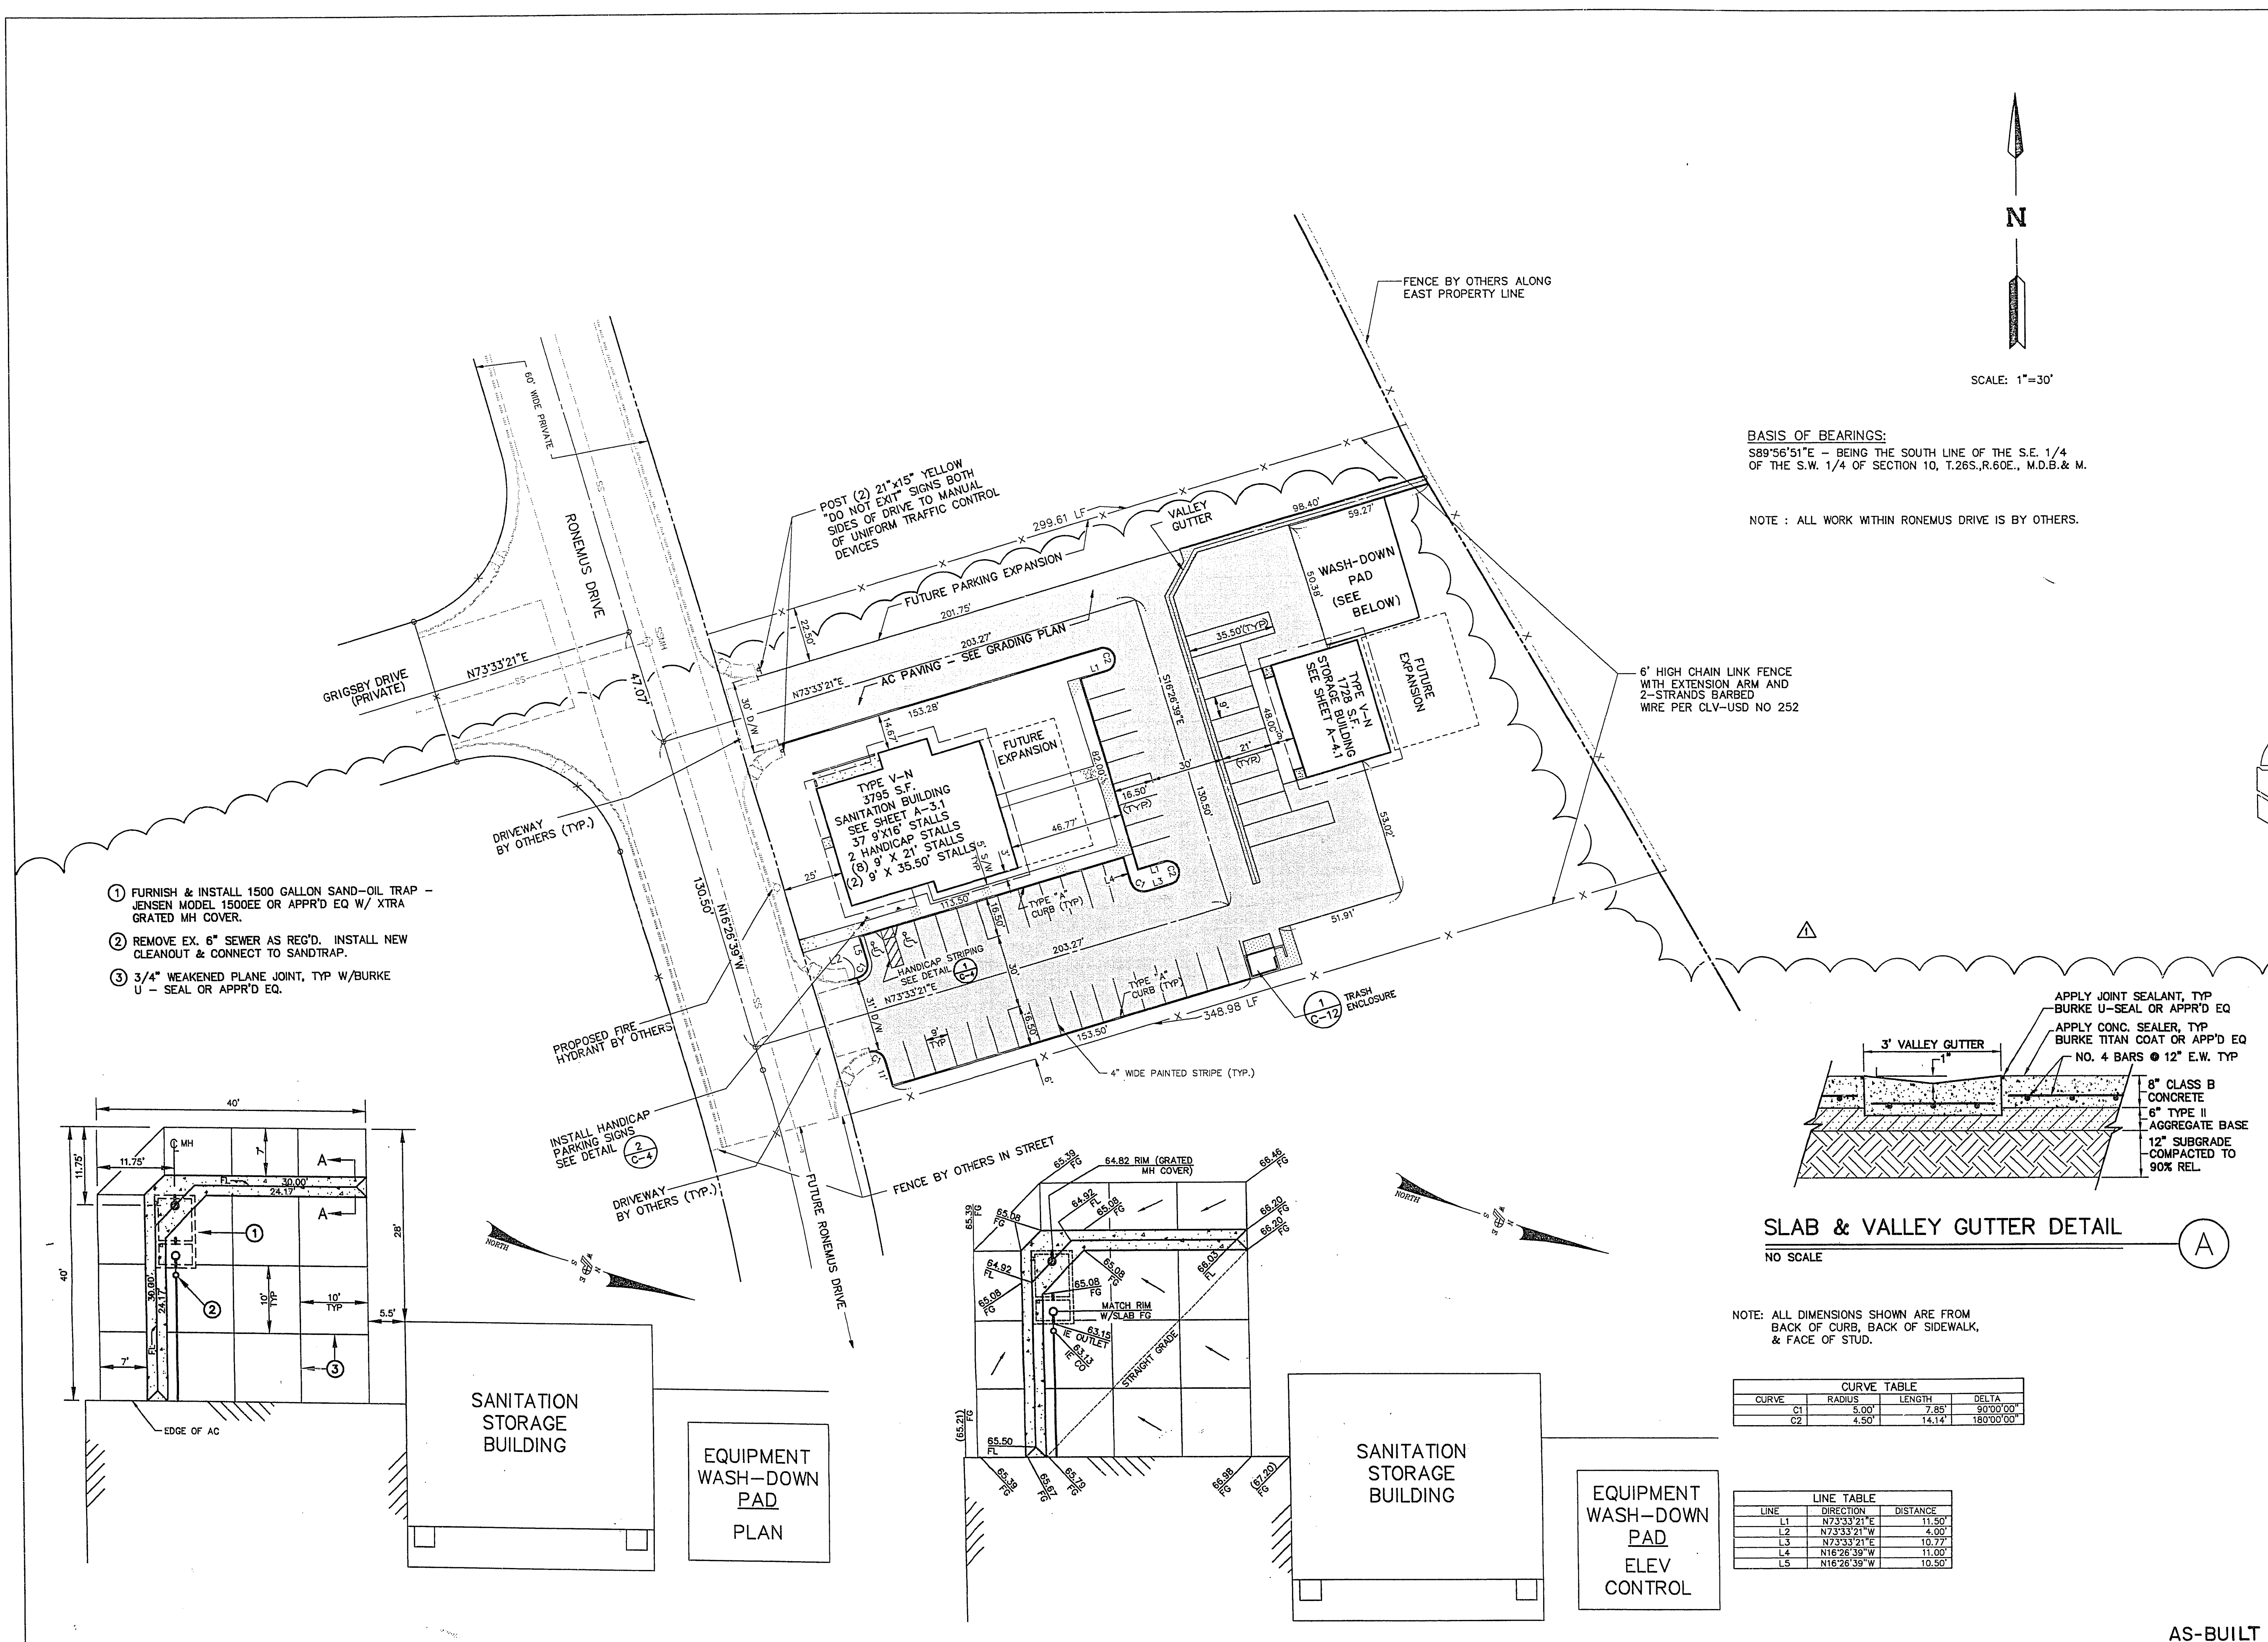


BASIS OF BEARINGS:
S89°56'51"E - BEING THE SOUTH LINE OF THE S.E. 1/4
OF THE S.W. 1/4 OF SECTION 10, T.26S, R.60E., M.D.B. & M.


NOTE : ALL WORK WITHIN RONEMUS DRIVE IS BY OTHERS.

- 1 FURNISH & INSTALL 1500 GALLON SAND-OIL TRAP - JENSEN MODEL 1500EE OR APPR'D EQ W/ XTRA GRATED MH COVER.
- 2 REMOVE EX. 6" SEWER AS REG'D. INSTALL NEW CLEANOUT & CONNECT TO SANDTRAP.
- 3 3/4" WEAKENED PLANE JOINT, TYP W/BURKE U - SEAL OR APPR'D EQ.

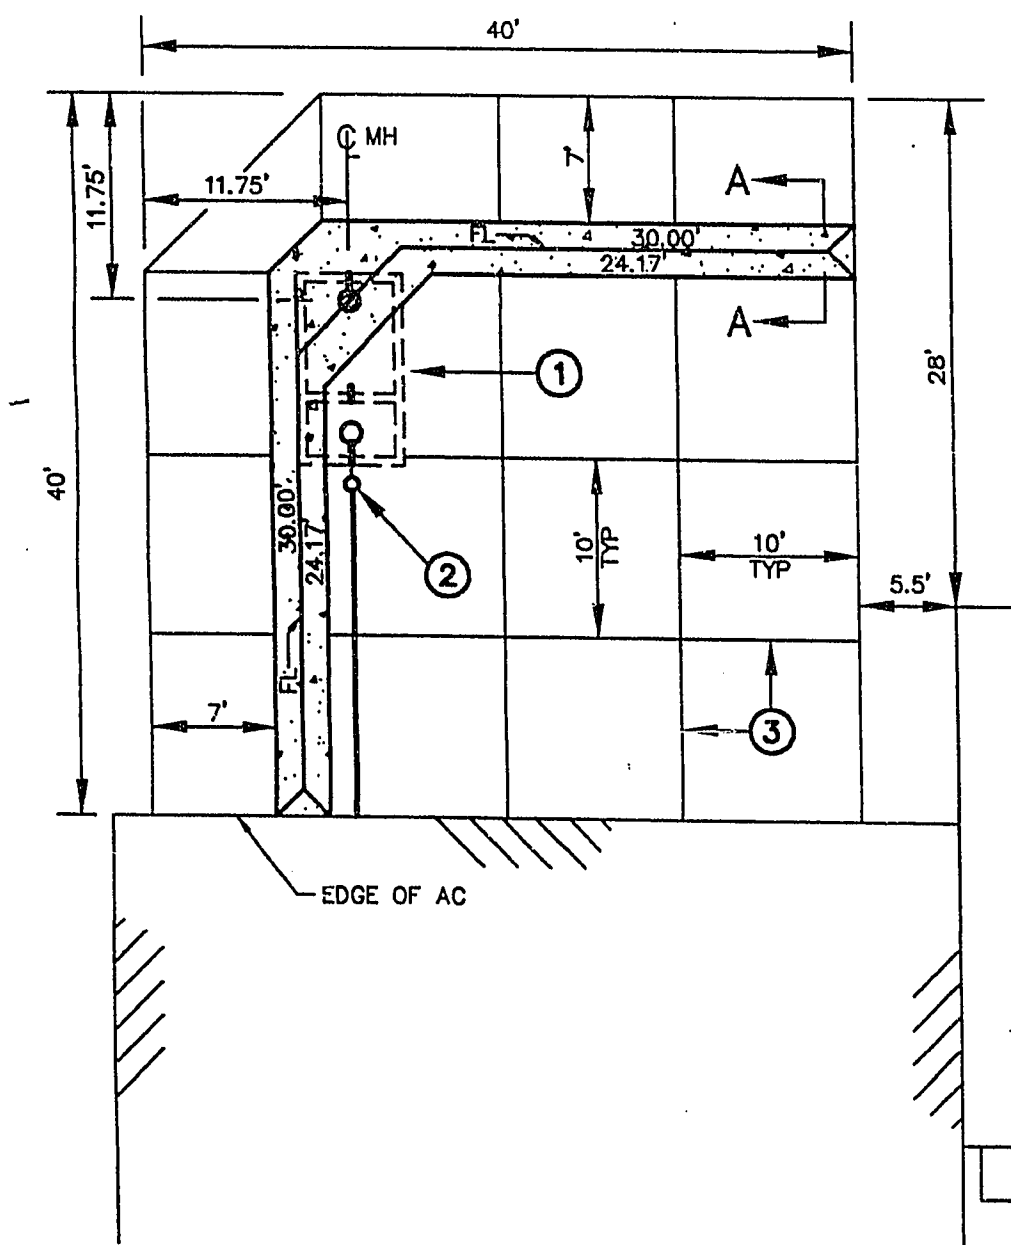

SANITATION STORAGE BUILDING

EQUIPMENT WASH-DOWN PAD PLAN

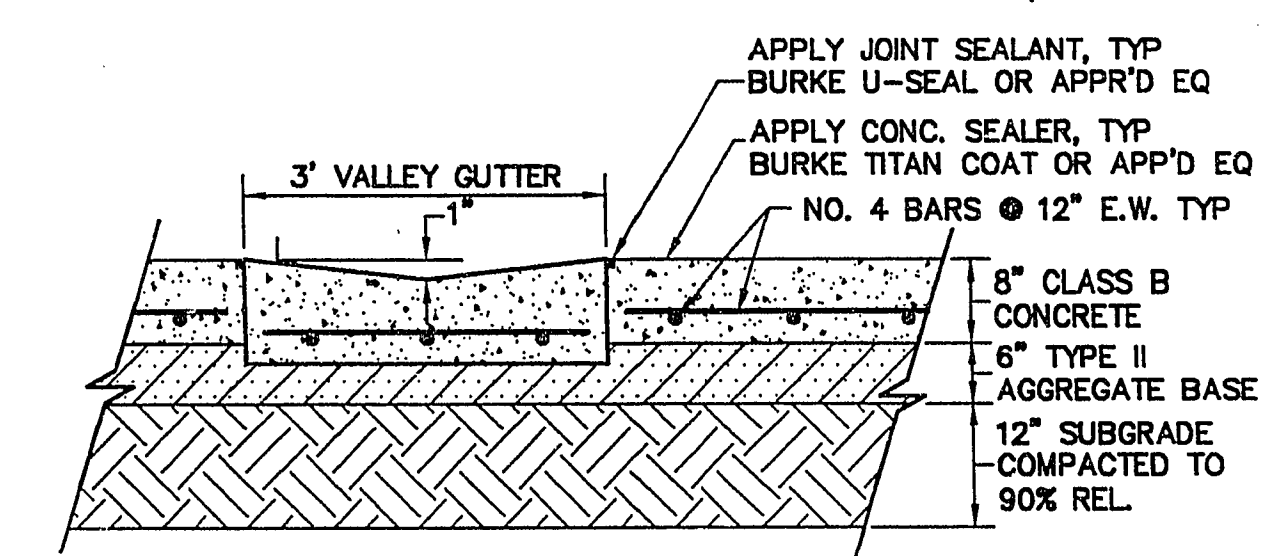

SLAB & VALLEY GUTTER DETAIL
NO SCALE

NOTE: ALL DIMENSIONS SHOWN ARE FROM BACK OF CURB, BACK OF SIDEWALK, & FACE OF STUD.

CURVE TABLE			
CURVE	RADIUS	LENGTH	DELTA
C1	5.00'	7.85'	90°00'00"
C2	4.50'	14.14'	180°00'00"

LINE TABLE		
LINE	DIRECTION	DISTANCE
L1	N73°33'21"E	11.50'
L2	N73°33'21"W	4.00'
L3	N73°33'21"E	10.77'
L4	N16°26'39"W	11.00'
L5	N16°26'39"W	10.50'

DATE: 04/19/95
REVISION: RECORD DRAWINGS

POGGEMEYER DESIGN GROUP
PLANNERS
ENGINEERS
SURVEYORS

1140 ALMOND TREE LANE, SUITE 306 LAS VEGAS, NEVADA 89104 (702) 735-5108

SITE PLAN
WEST SERVICE CENTER
PHASE I
SANITATION

JOB NUMBER: 91012
DESIGNED BY: GP
DRAWN BY: EC
CHECKED BY: TP
DATE: 8-7-92
SHEET NUMBER: 6 of 78

C-6
6 of 12