



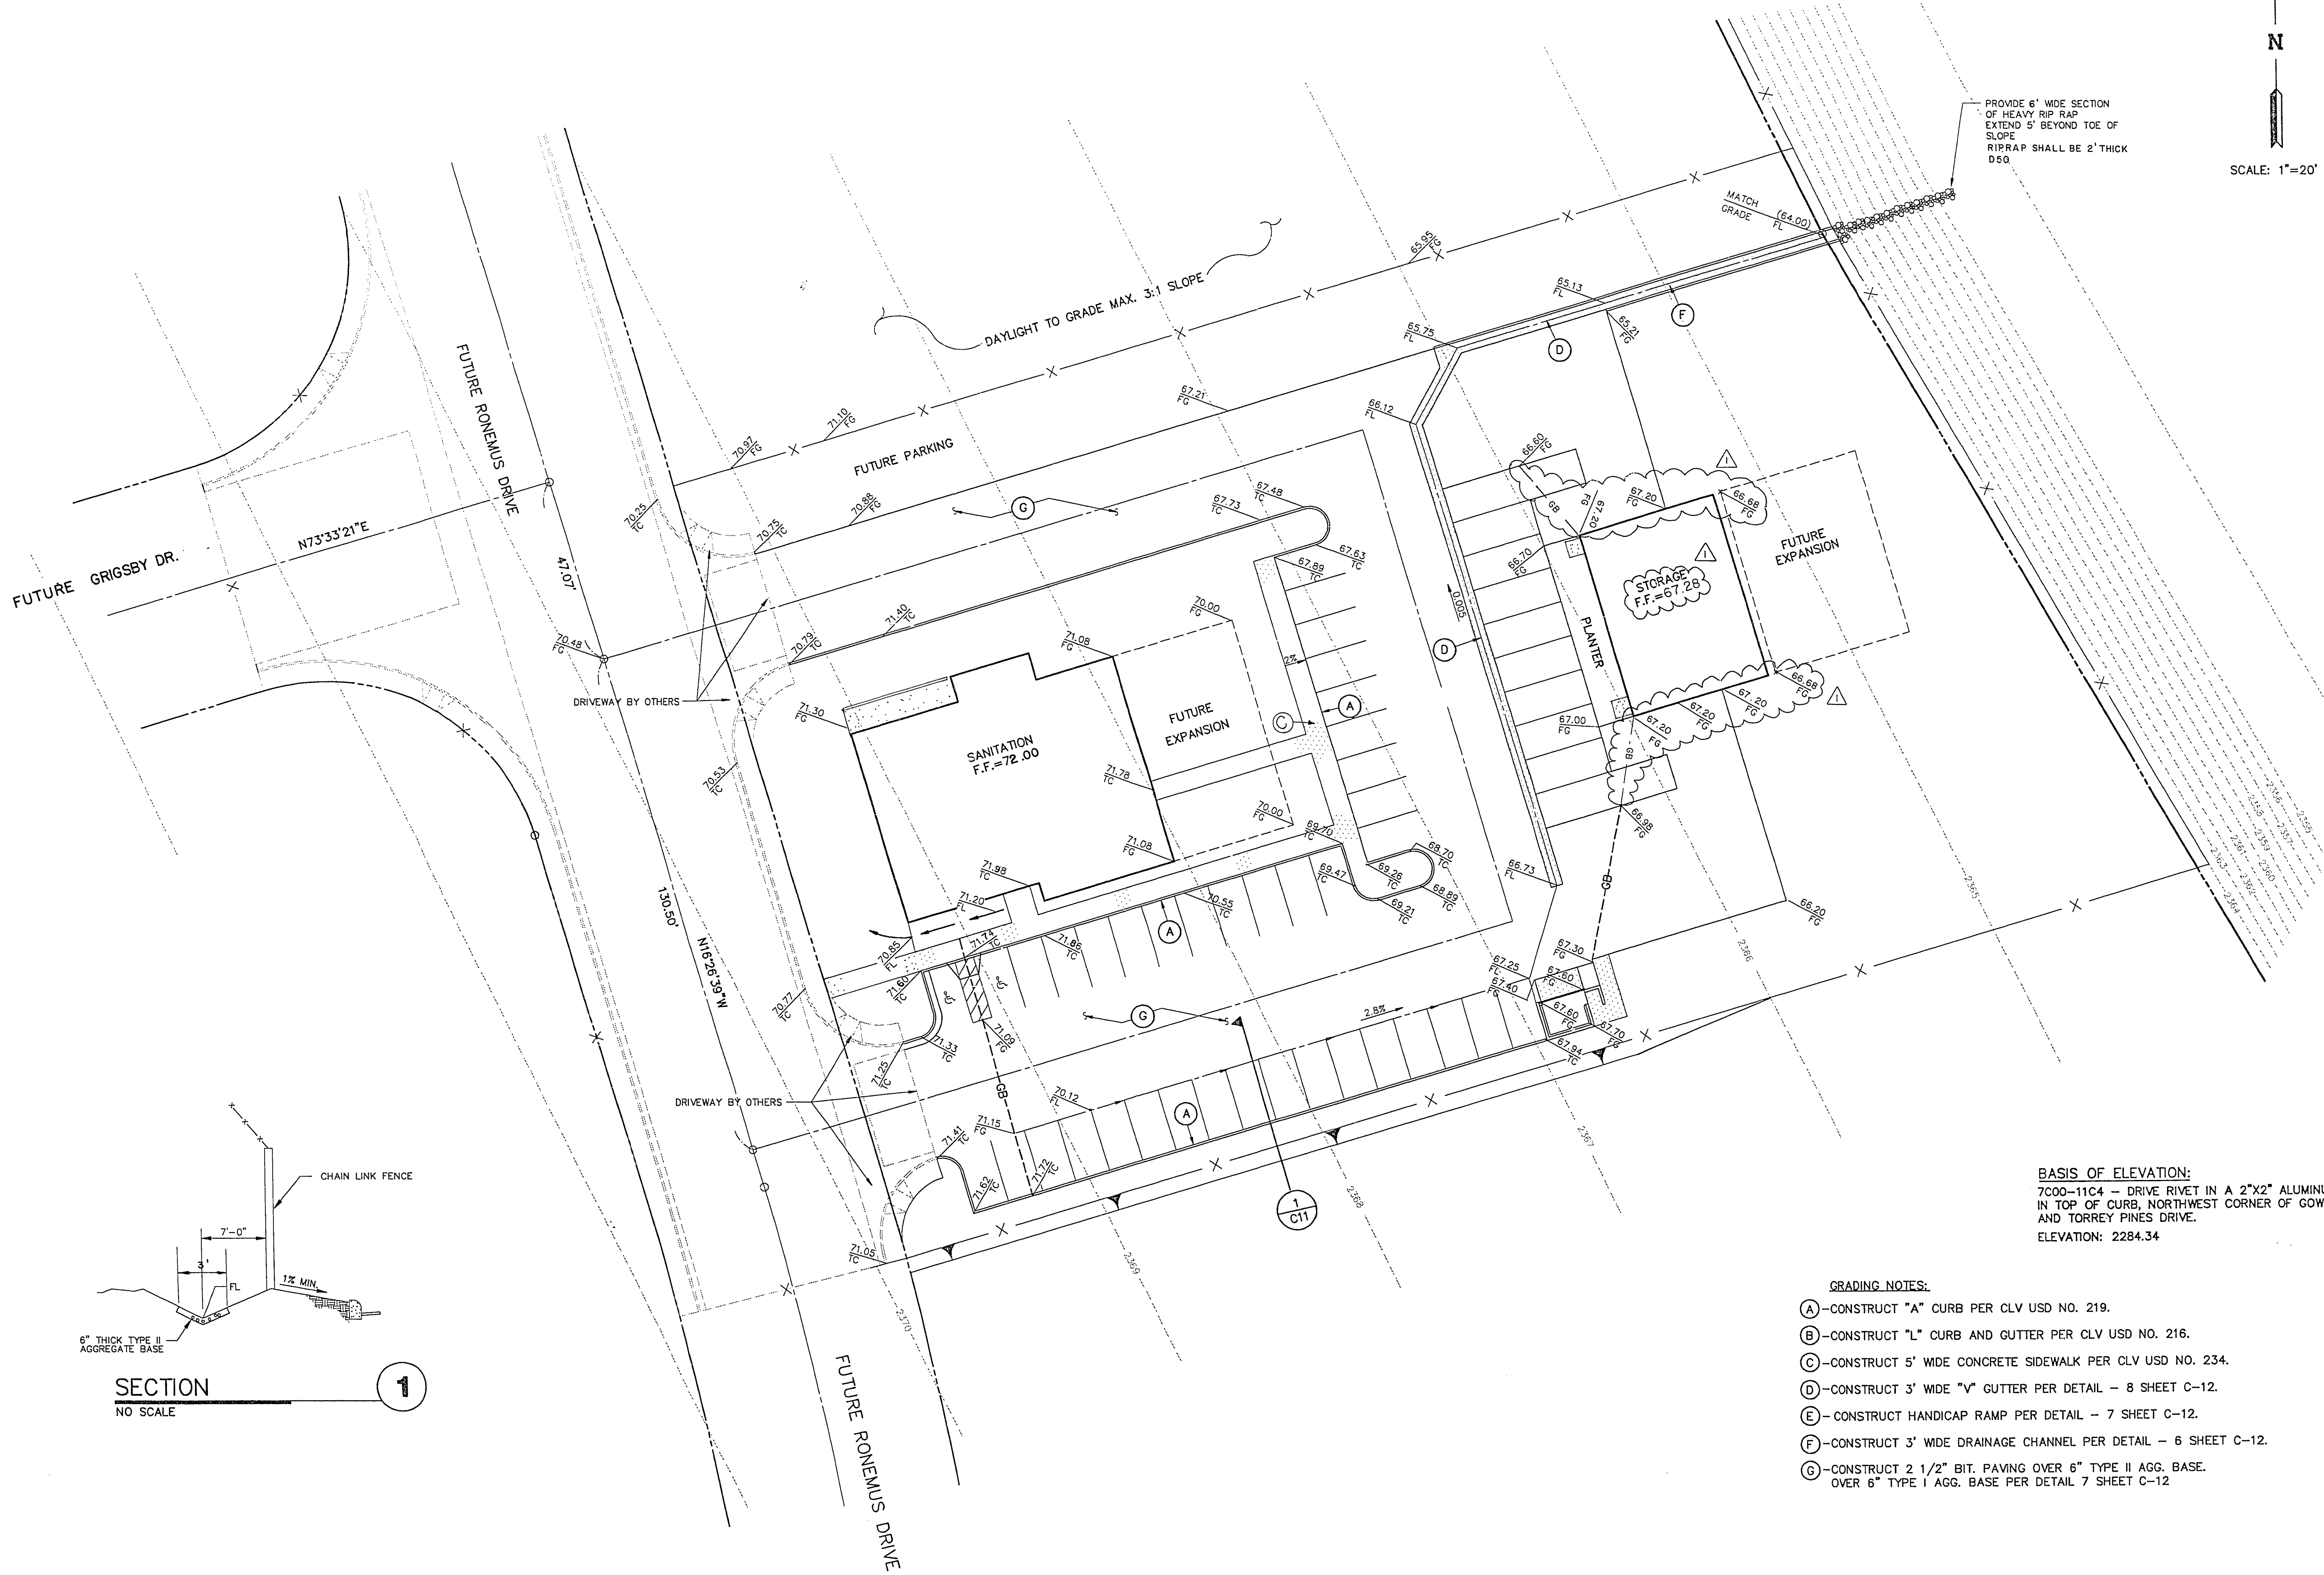


N
SCALE: 1"=20'

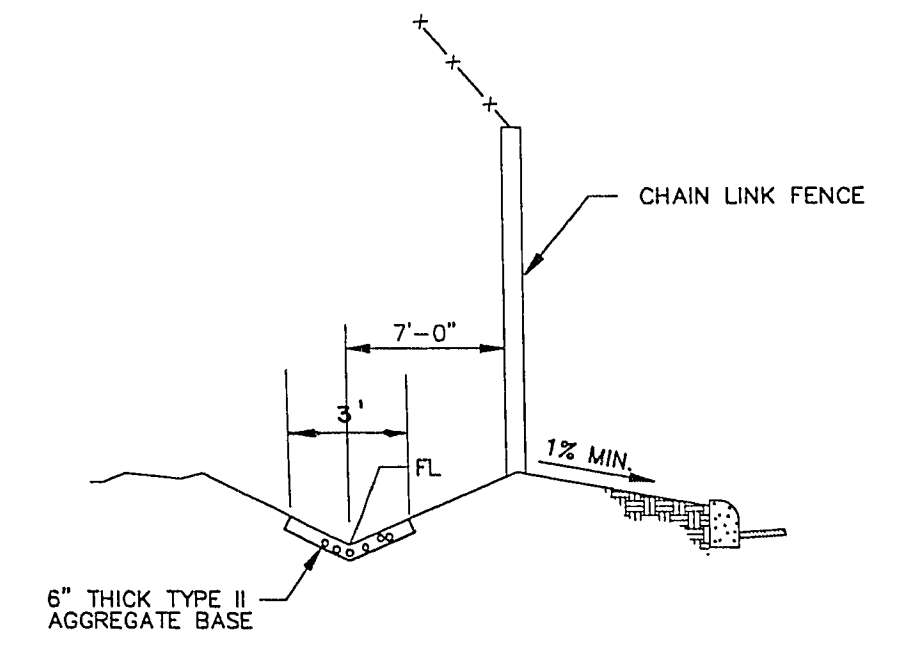

BASIS OF ELEVATION:
7000-11C4 - DRIVE RIVET IN A 2"x2" ALUMINUM PLATE,
IN TOP OF CURB, NORTHWEST CORNER OF GOWAN ROAD
AND TORREY PINES DRIVE.
ELEVATION: 2284.34

- GRADING NOTES:
- (A) -CONSTRUCT "A" CURB PER CLV USD NO. 219.
 - (B) -CONSTRUCT "L" CURB AND GUTTER PER CLV USD NO. 216.
 - (C) -CONSTRUCT 5' WIDE CONCRETE SIDEWALK PER CLV USD NO. 234.
 - (D) -CONSTRUCT 3' WIDE "V" GUTTER PER DETAIL - 8 SHEET C-12.
 - (E) -CONSTRUCT HANDICAP RAMP PER DETAIL - 7 SHEET C-12.
 - (F) -CONSTRUCT 3' WIDE DRAINAGE CHANNEL PER DETAIL - 6 SHEET C-12.
 - (G) -CONSTRUCT 2 1/2" BIT. PAVING OVER 6" TYPE II AGG. BASE.
OVER 6" TYPE I AGG. BASE PER DETAIL 7 SHEET C-12.

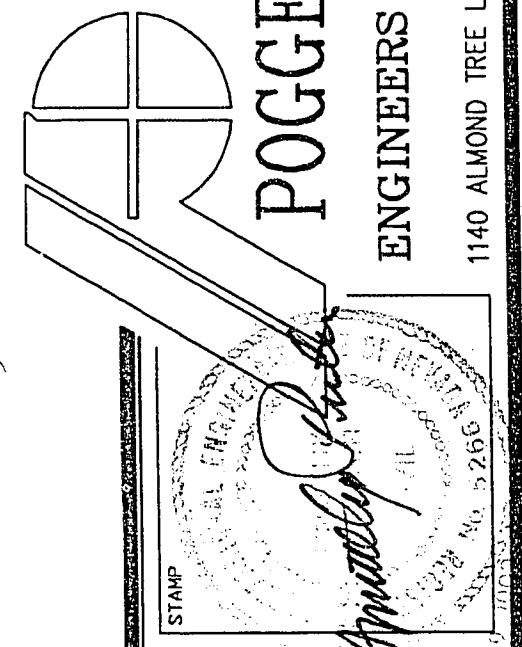

POGEMEYER DESIGN GROUP
ENGINEERS PLANNERS SURVEYORS
1140 ALMOND TREE LANE, SUITE 306 LAS VEGAS, NEVADA 89104 (702) 735-5108

**WEST SERVICE CENTER
PHASE I
SANITATION**

DATE	REVISION	CLV REVIEW COMMENTS
06-11-93		

JOB NUMBER	91012
DESIGNED BY	GP
DRAWN BY	EC
CHECKED BY	TP
DATE	8-7-92
SHEET NUMBER	11 OF 78
C-11	
	11 OF 12