



- (A) CONSTRUCT "A" CURB PER CLV USD NO. 219.
- (B) CONSTRUCT "L" CURB AND GUTTER PER CLV USD NO. 216.
- (C) CONSTRUCT 5' WIDE CONCRETE SIDEWALK PER CLV USD NO. 234.
- (D) CONSTRUCT 3' WIDE "V" GUTTER PER DETAIL - 8 SHEET C-12.
- (E) CONSTRUCT HANDICAP RAMP PER DETAIL - 5 SHEET C-12.
- (F) CONSTRUCT 2' WIDE DRAINAGE CHANNEL PER DETAIL - 6 SHEET C-12.
- (G) CONSTRUCT 2 1/2" BIT. PAVING OVER 4" TYPE II AGG. BASE, OVER 7" TYPE I AGG. BASE PER DETAIL 7 SHEET C-12
- (H) PROVIDE 6" WIDE OPENING IN CURB FOR SLIDING GATE
- (I) INSTALL 14 CONCRETE PARKING BUMPERS W/2(1) #5 DOWELS EA.

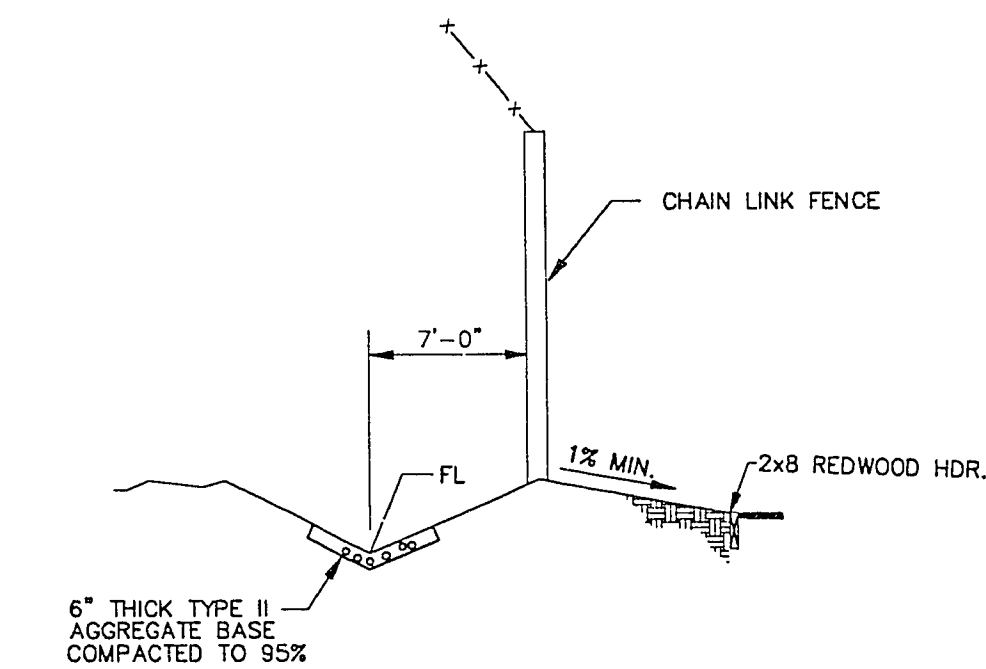

SECTION
NO SCALE

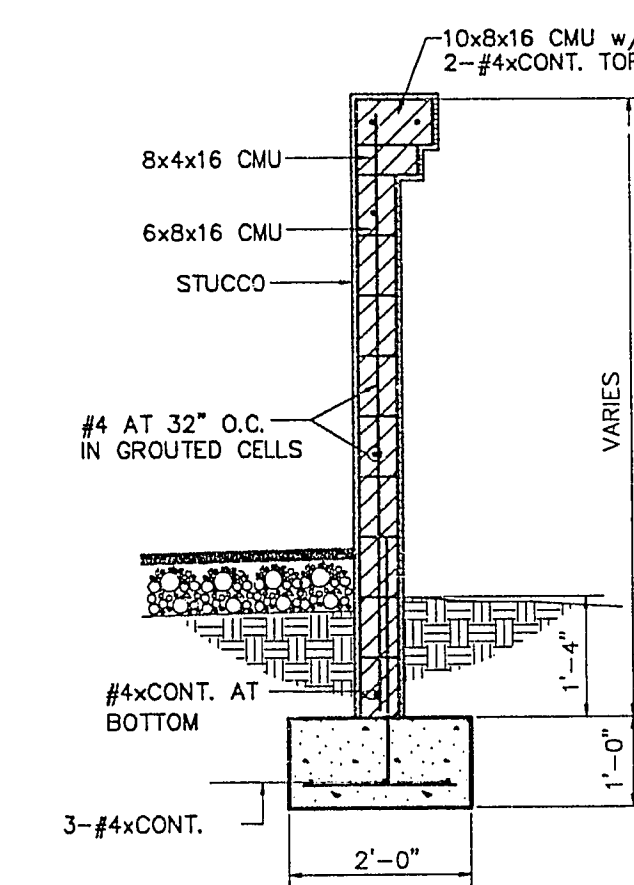


TYP. WALL SECTION (2)
NO SCALE

BASIS OF ELEVATION:
7C00-11C4 - DRIVE RIVET IN A 2"x2" ALUMINUM PLATE,
IN TOP OF CURB, NORTHWEST CORNER OF GOWAN ROAD
AND TORREY PINES DRIVE.
ELEVATION: 2284.34

[illegible]

POGEMEYER DESIGN GROUP

ENGINEERS	PLANNERS	SURVEYORS
11440 AL MONTO TRFF 1 AVE. SUITE 306 LAS VEGAS, NEVADA 89104		(702) 735-5100

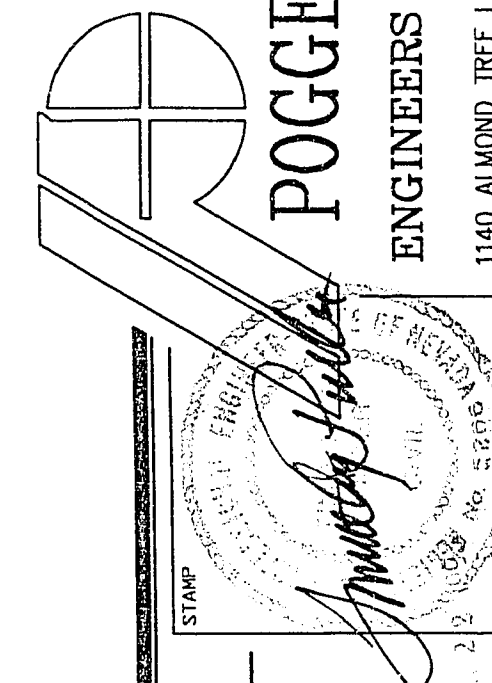

GRADING PLAN

**WEST SERVICE CENTER
PHASE I
QUALITY CONTROL**

JOB NUMBER	91012
DESIGNED BY	GP
DRAWN BY	EC
CHECKED BY	TP
DATE	8-7-92
SHEET NUMBER	10 of 74

C-10
10 of 12

AS-BUILT

DRAWING NO. 522-V52