



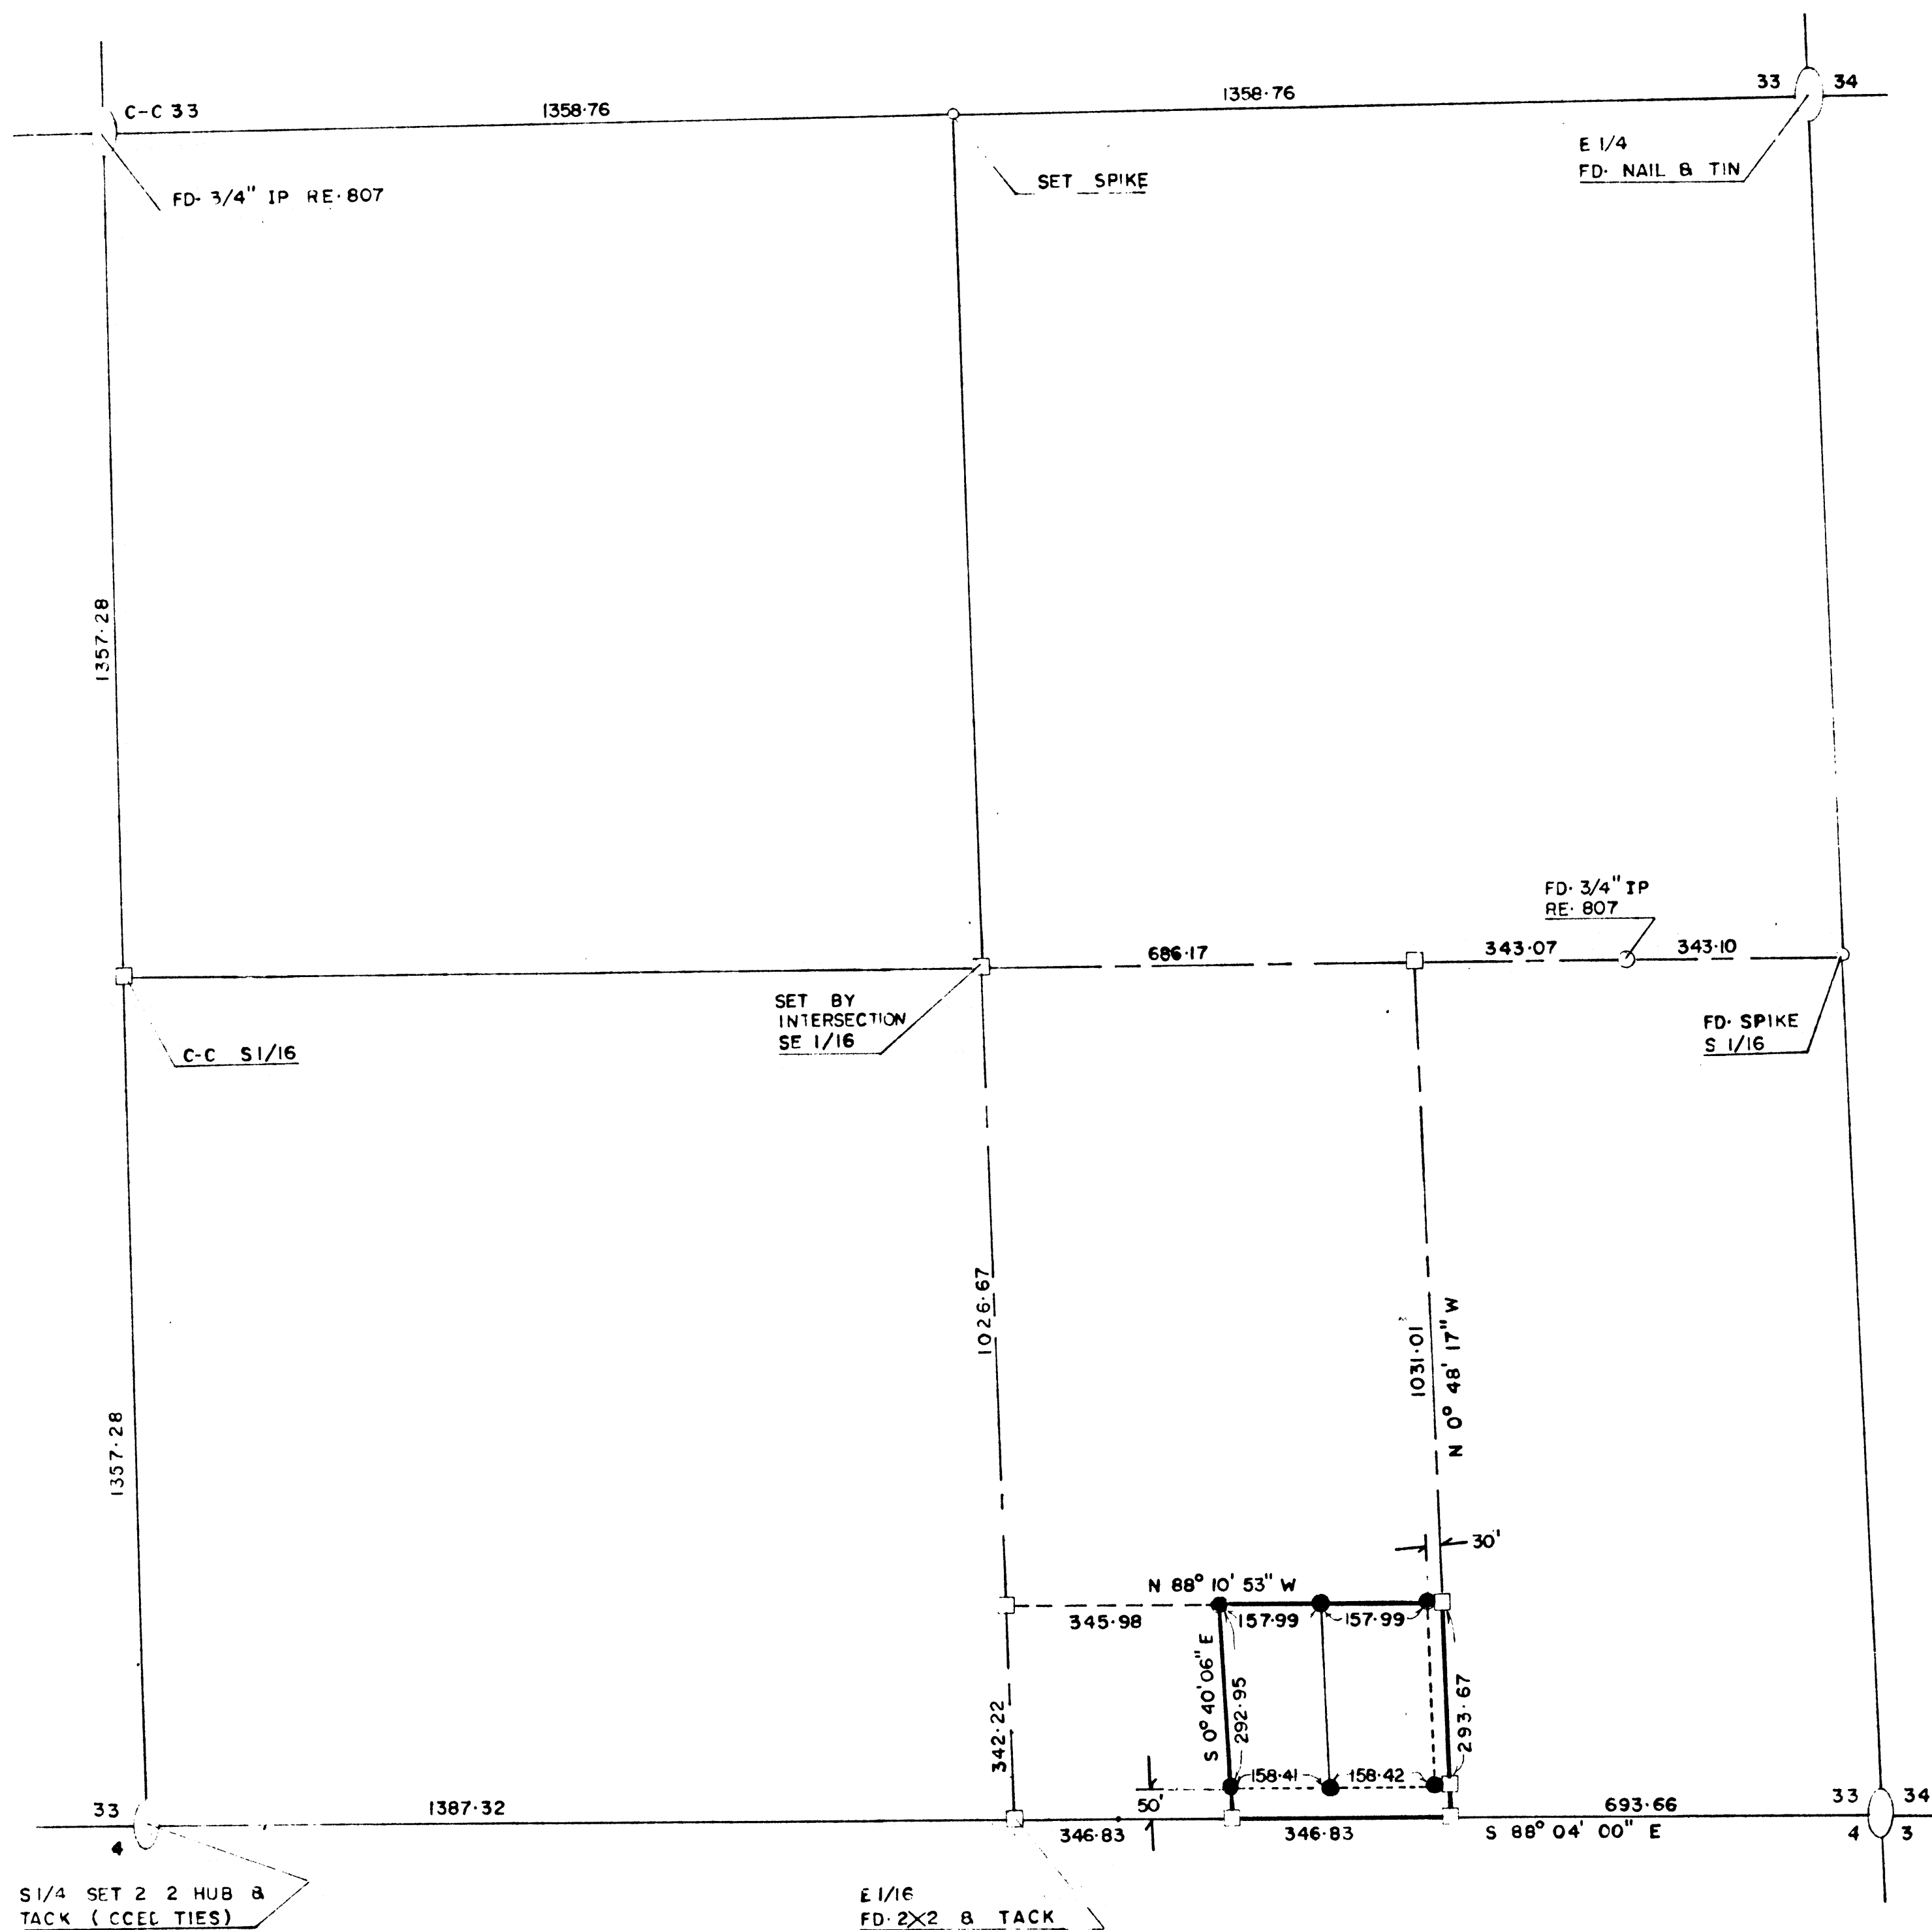

SURVEYOR'S CERTIFICATE

THIS IS TO CERTIFY THAT THIS MAP ACCURATELY DELINEATES A SURVEY MADE UNDER MY SUPERVISION AND DIRECTION AND COMPLETED ON NOV. 15, 1969, AND THAT THE POINTS SET AND THE POINTS FOUND ARE CORRECTLY SHOWN HEREON, THIS SURVEY WAS COMPLETED AT THE INSTANCE OF W.S. & EVELYN MILLIKEN

Kay L. Adams
KAY L. ADAMS
REGISTERED LAND SURVEYOR
NEVADA CERT. NO. 2050

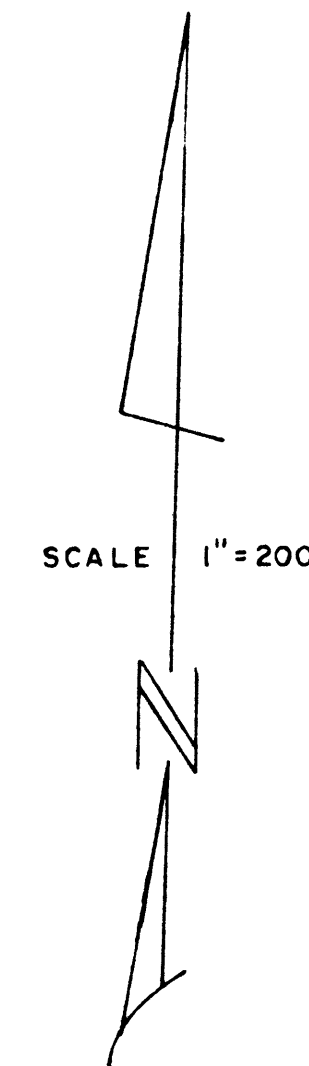

BASIS OF BEARING

(N 88° 04' 00" W) SOUTH LINE OF SE 1/4 SECTION 33, T.19S., R.60E., M.D.B. & M.

LEGEND

- --- SET 2" < 2" HUB & TACK
- --- SET 3/4" REBAR L.S. TAG 2050

RECORD OF SURVEY MAP	NO. 797800
FOR	RECORDED AT THE REQUEST OF KAY L. ADAMS
W.S. & EVELYN MILLIKEN	DATE 11-25-69 AT 9:00
	FILE 19 PAGE 6
	OF SURVEYS
	OFFICIAL RECORDS BOOK NO. CLARK COUNTY NEVADA R
	RECORDER, PAUL E. H.
SE 1/4, SW 1/4, SE 1/4, SE 1/4, SEC. 33, T19S, R60E	FEE \$2.52 <i>gh</i> DEPT