




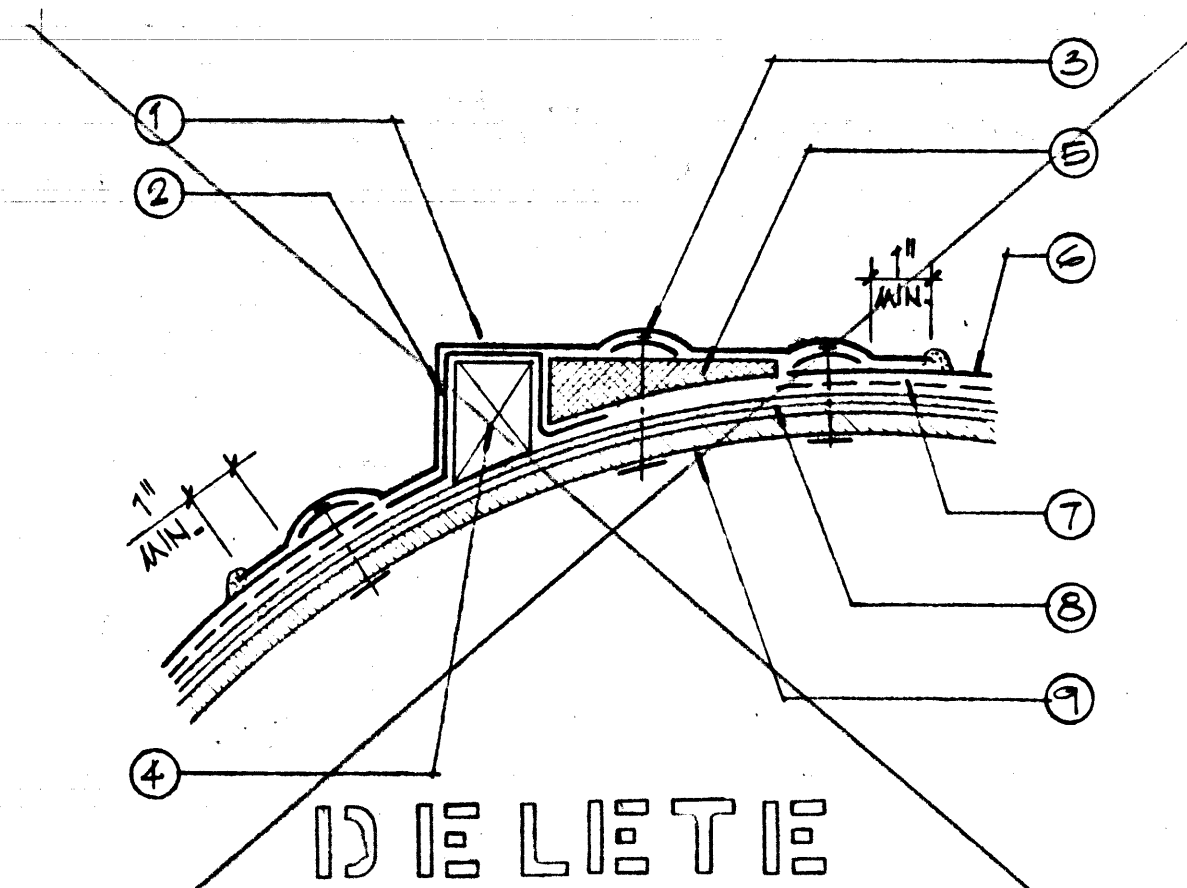


RAIL UNDER COOLER DET. NO SCALE 1

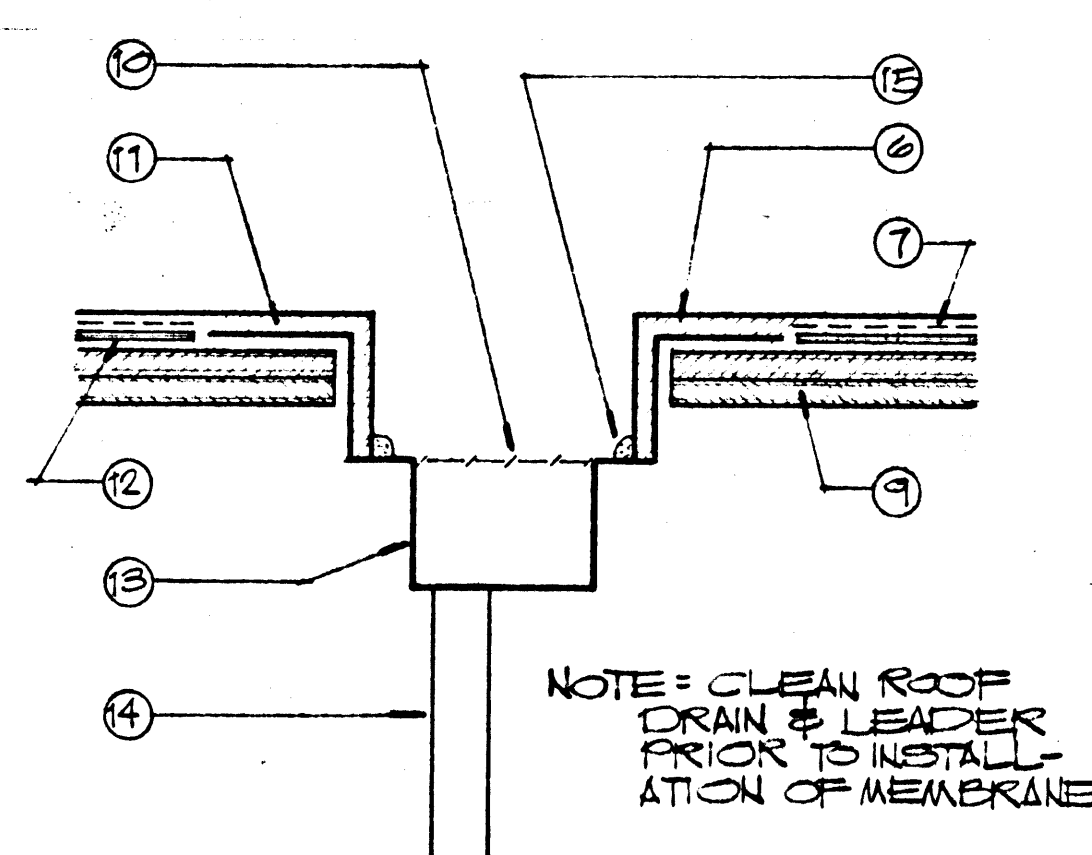


ROOF DRAIN DET. NO SCALE 2

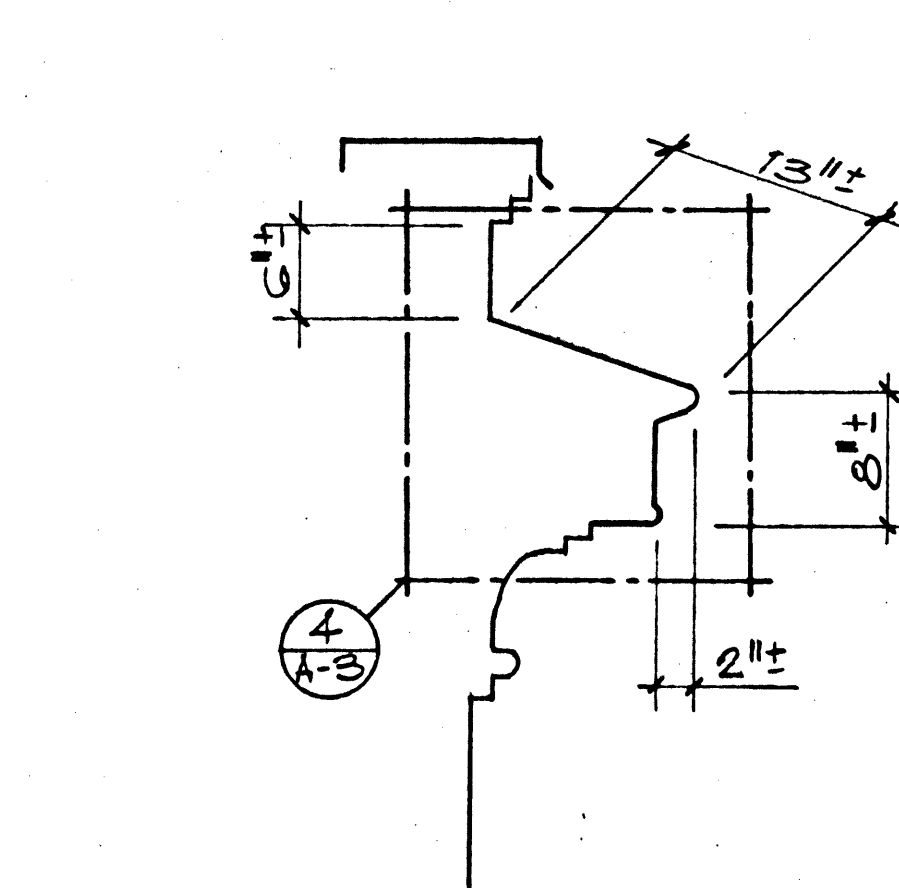


CORNICHE PROFILE 1/4\"/>

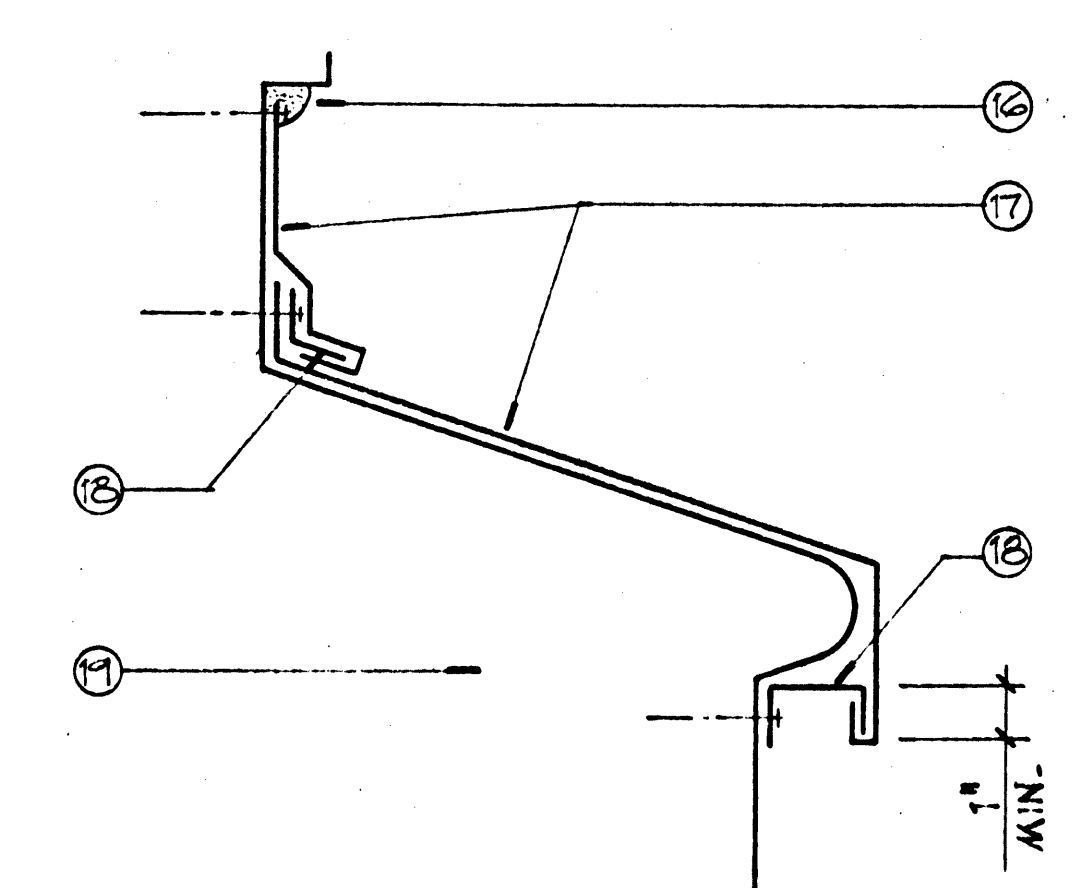


CORNICHE FLASHING DET. 3/4\"/>

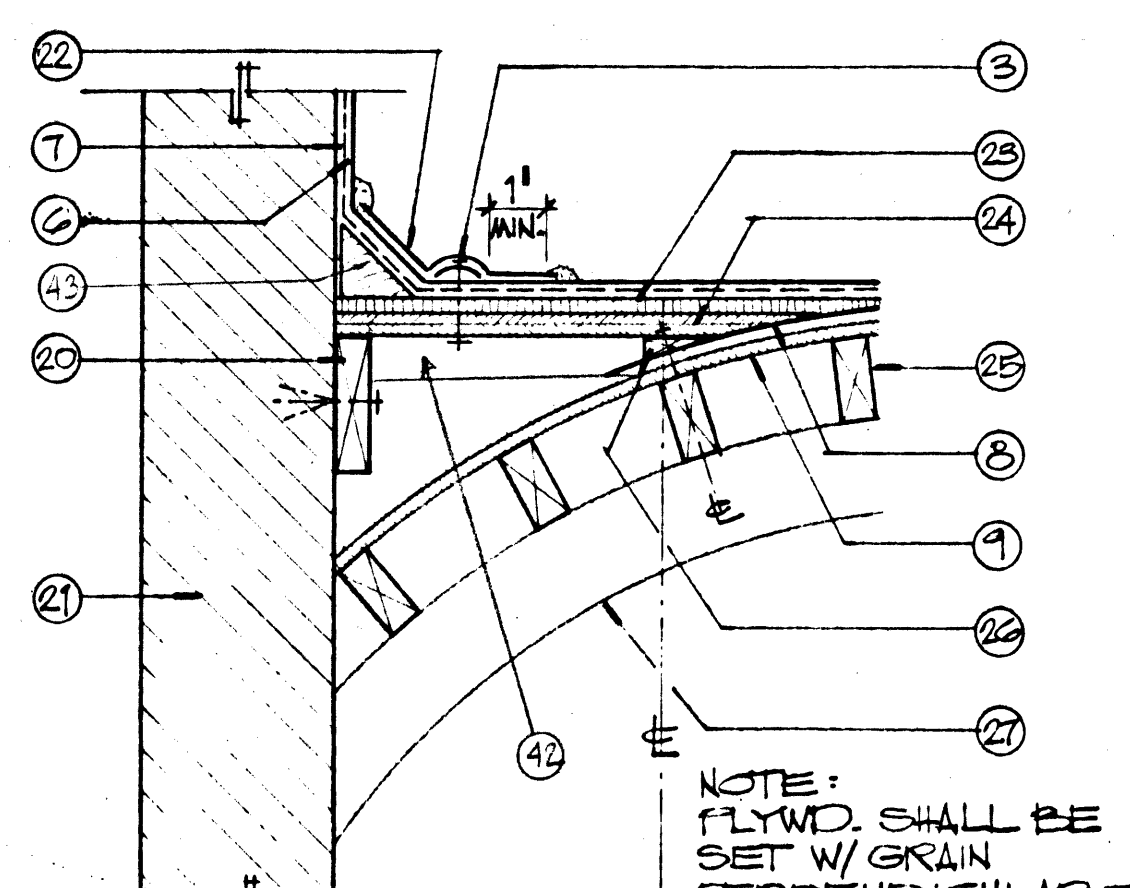


NEW CRICKET/RAIN DET. NO SCALE 5

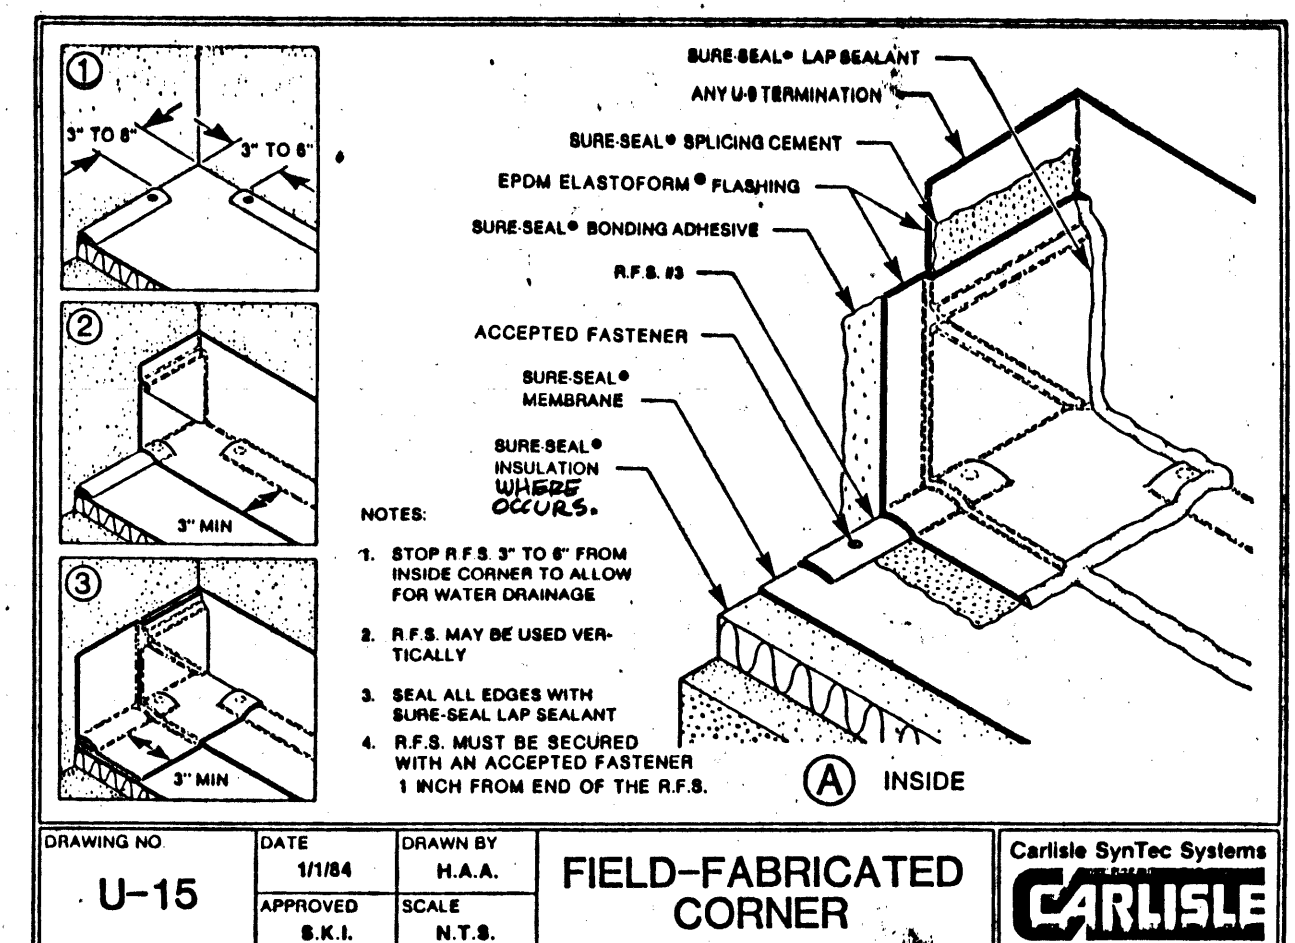


TYP. CORNER DETAIL NO SCALE 6

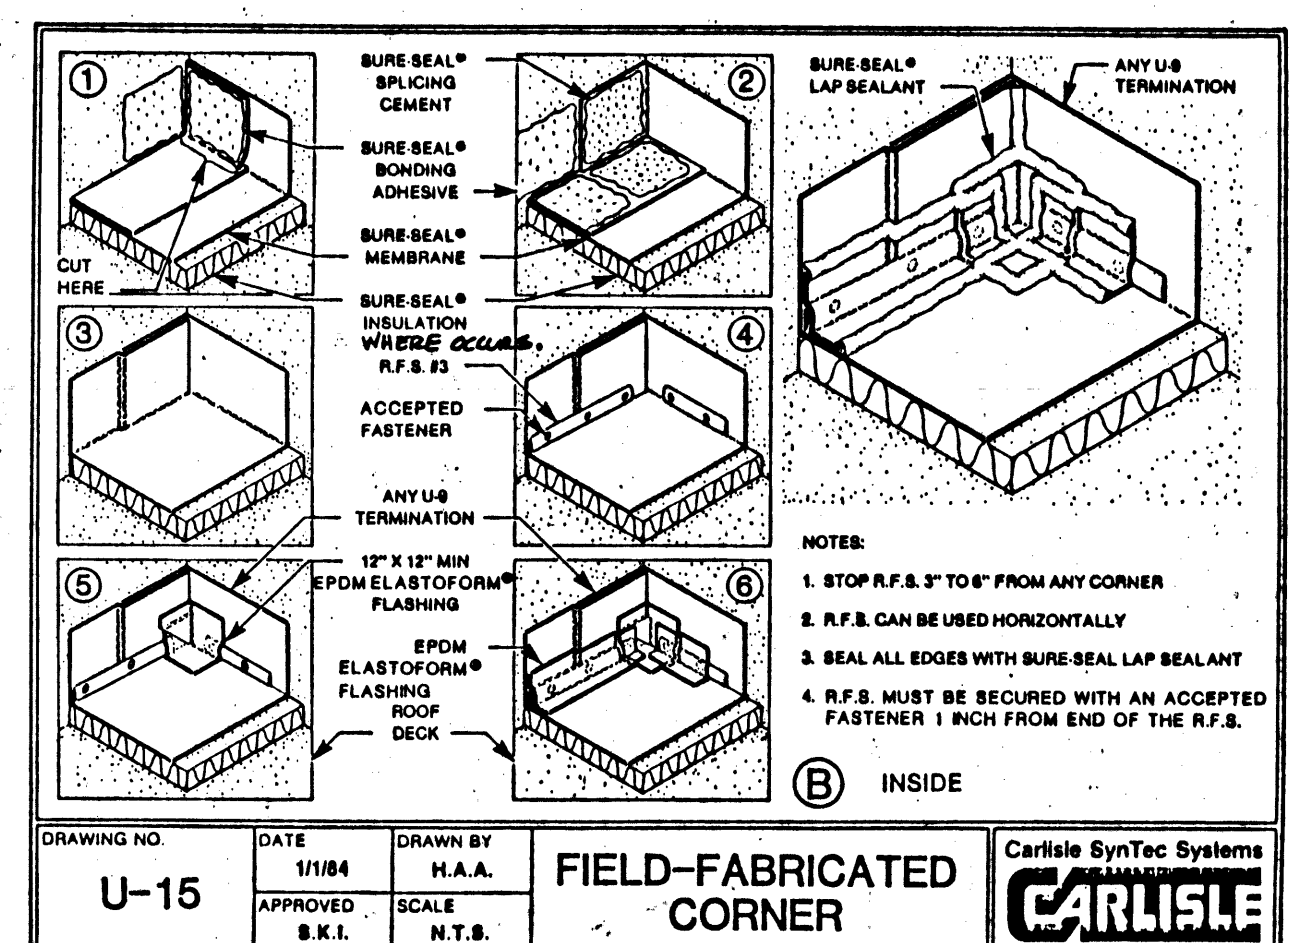


TYP. CORNER DETAIL NO SCALE 7

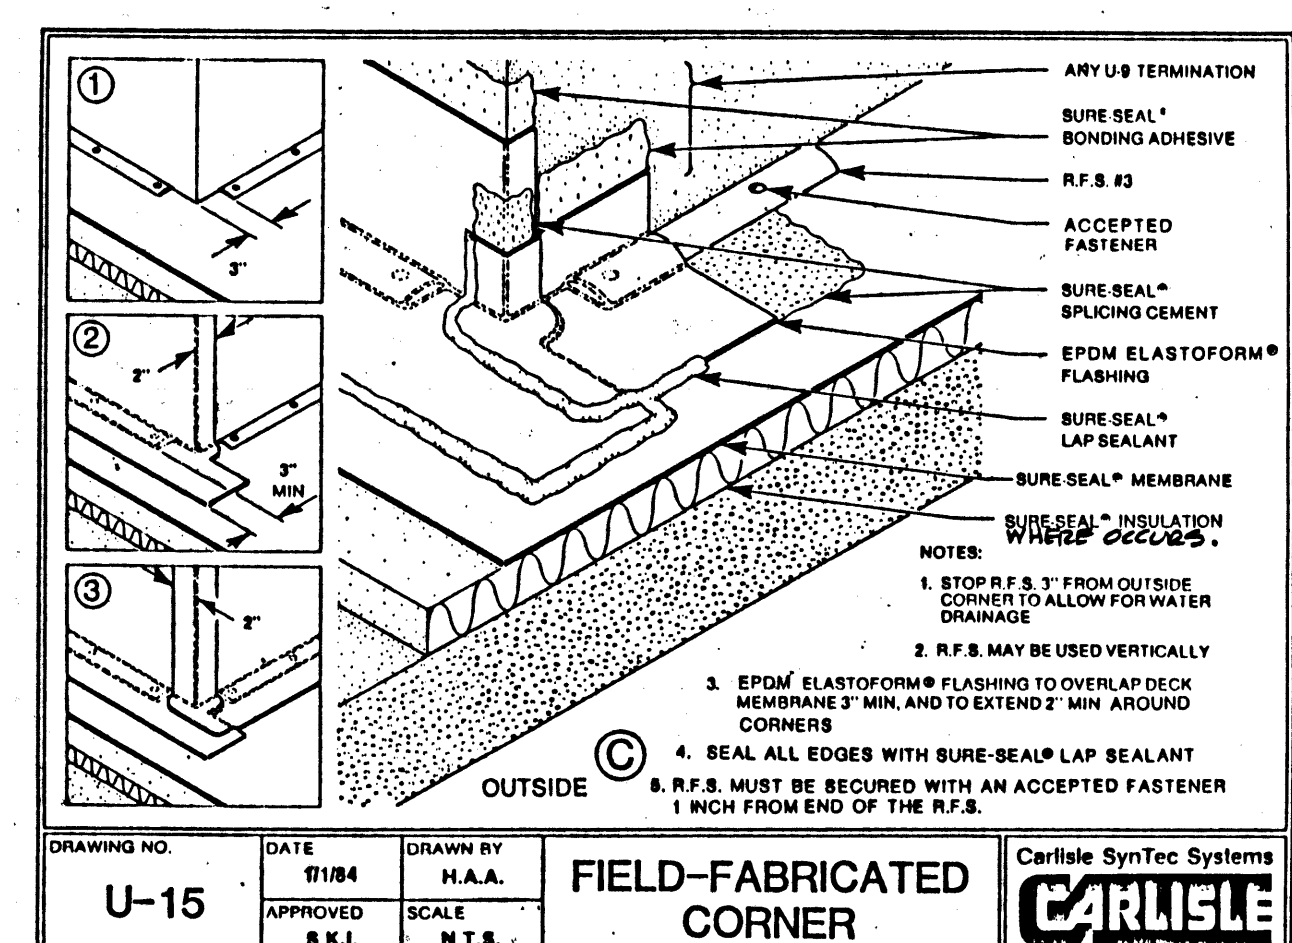


TYP. CORNER DETAIL NO SCALE 8

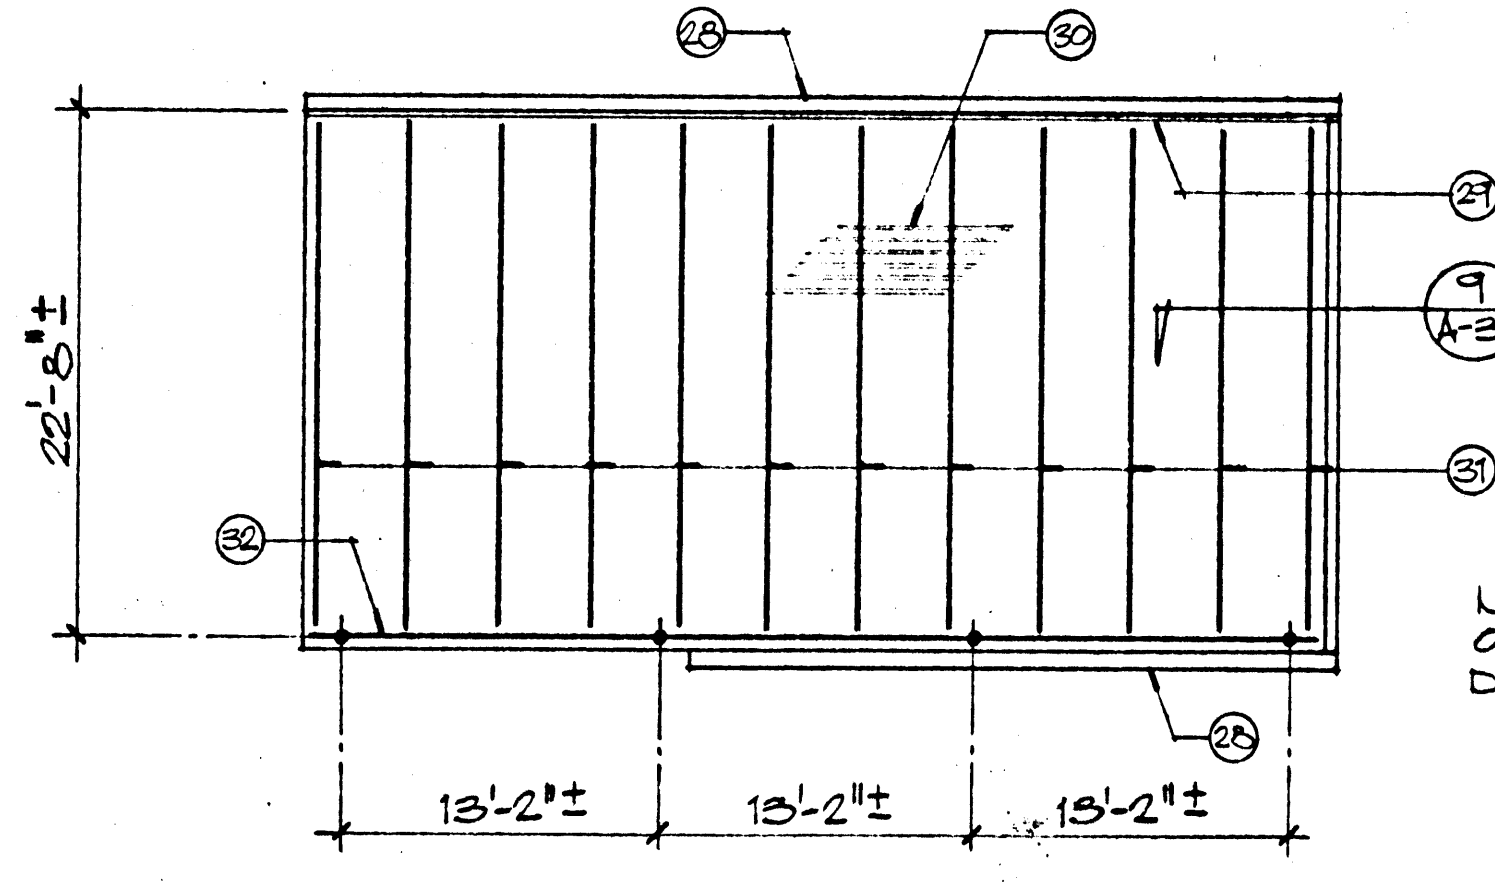


EXIST. ROOF FRAMING - ROOF AREA 'D' 1/8\"/>

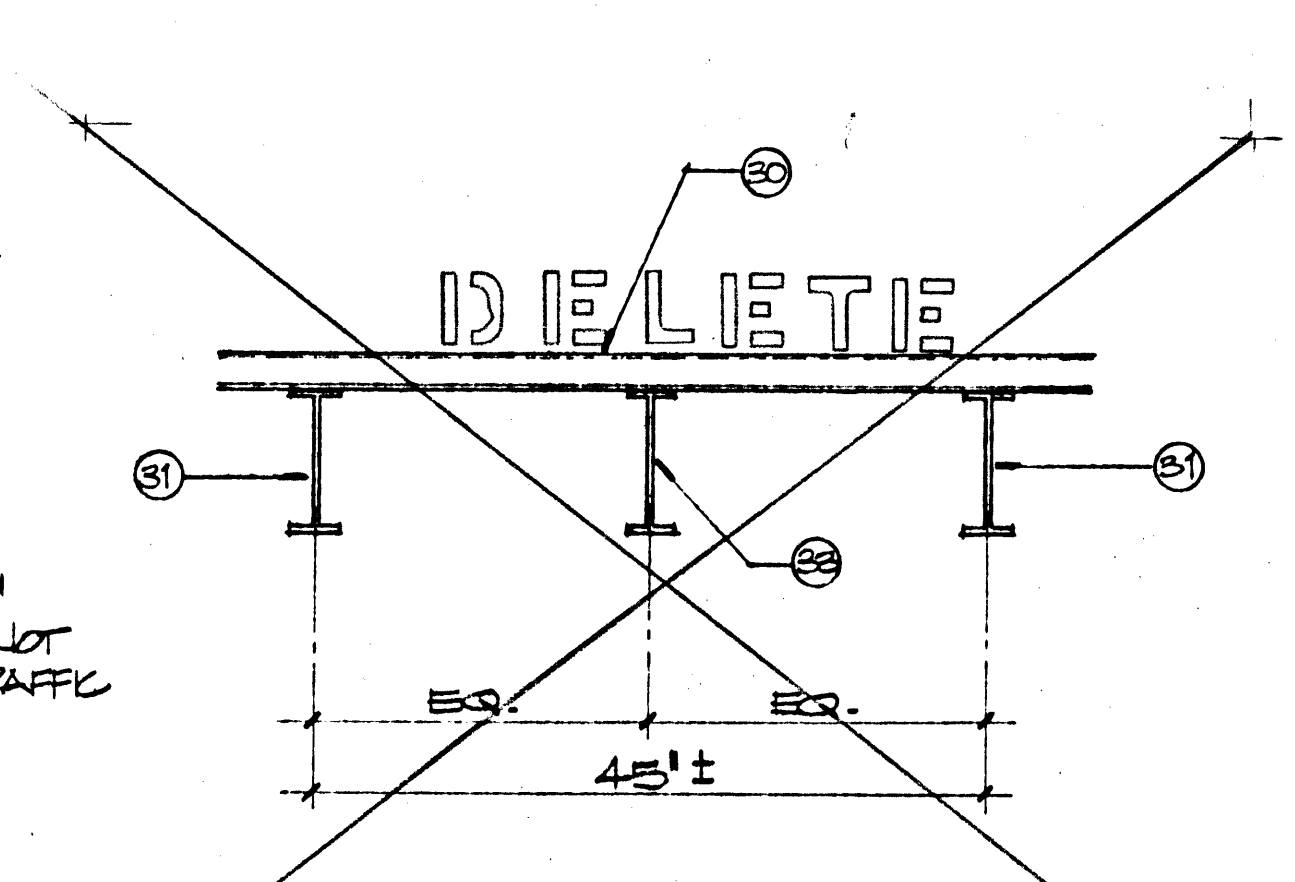


ROOF REINFORCING DET. NO SCALE 9

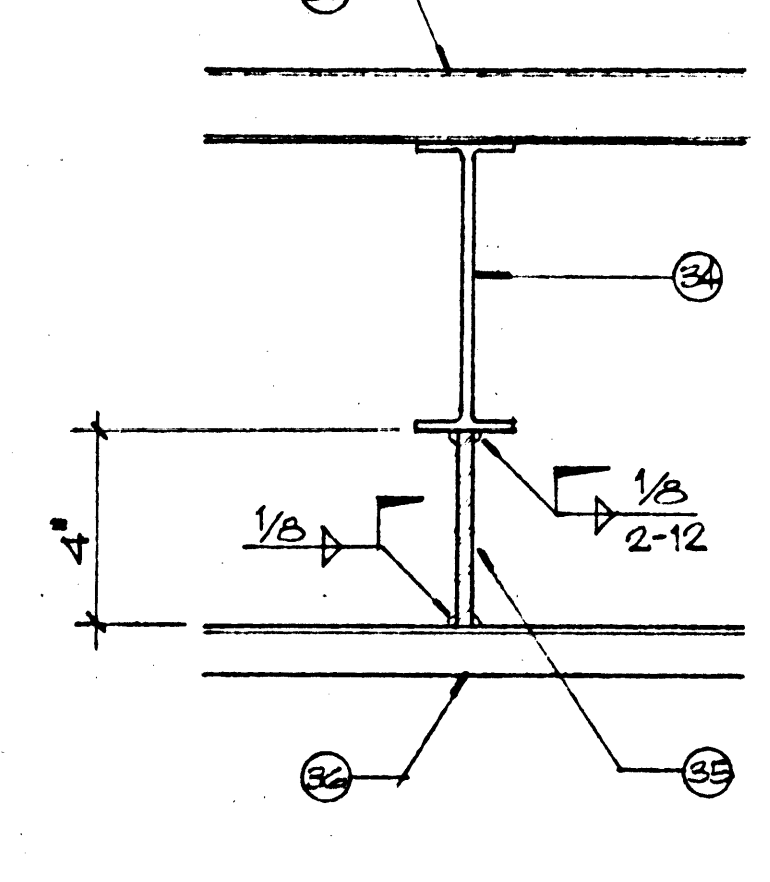


ALTERNATE ROOF REINFORCING DET. 3/4\"/>

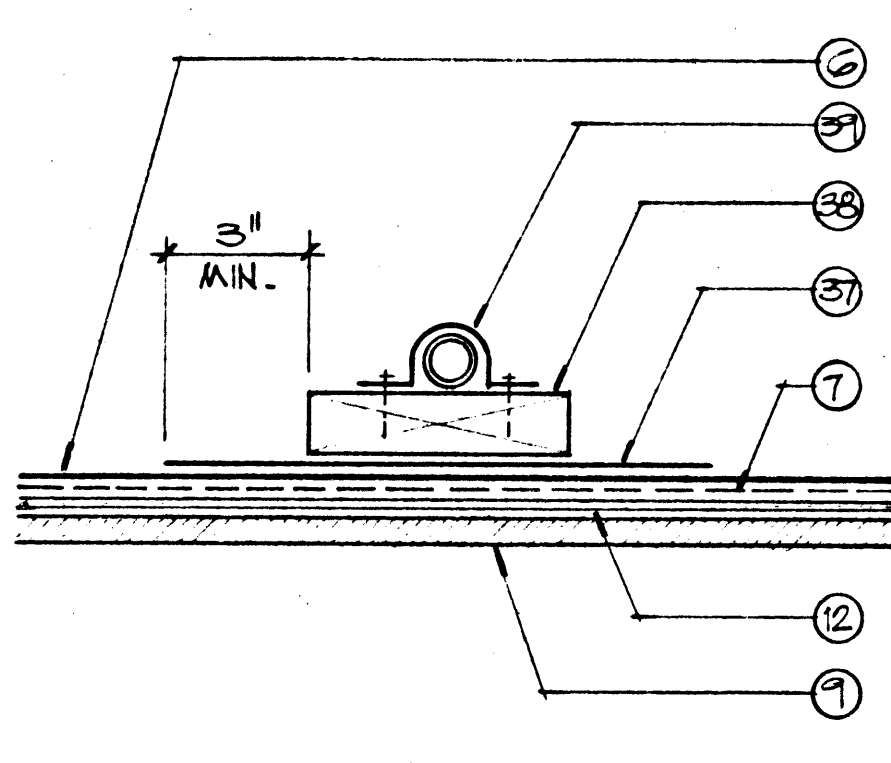


SLEEPER DETAIL NO SCALE 11

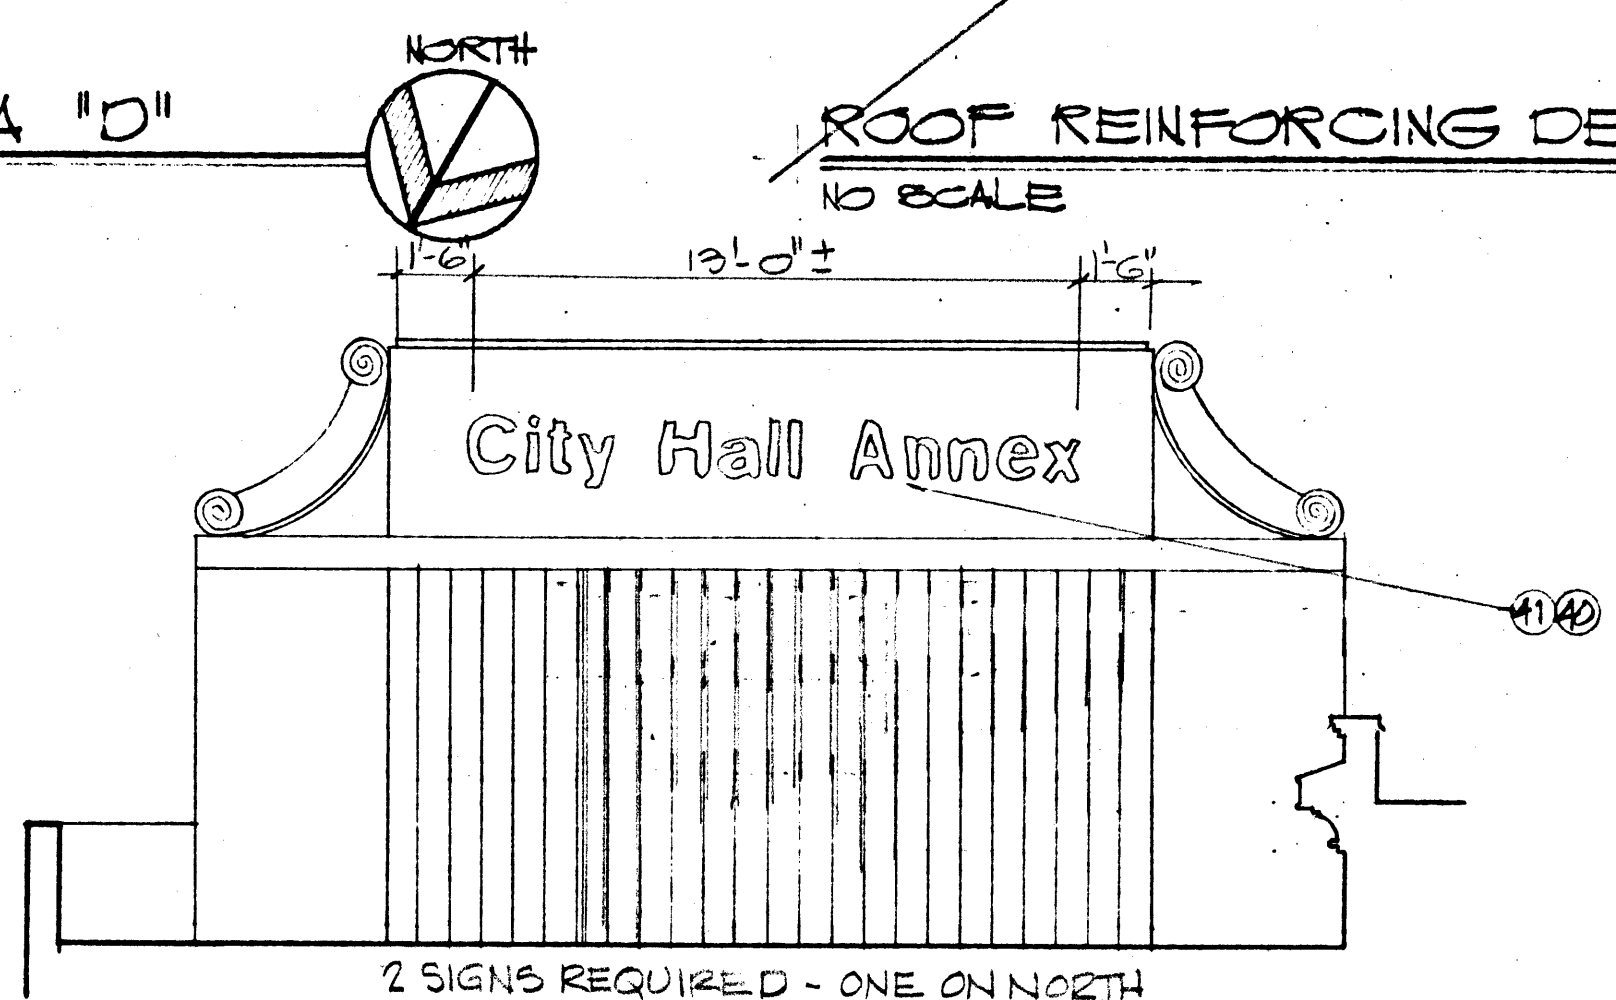

MARQUEE DETAIL 1/4\"/>

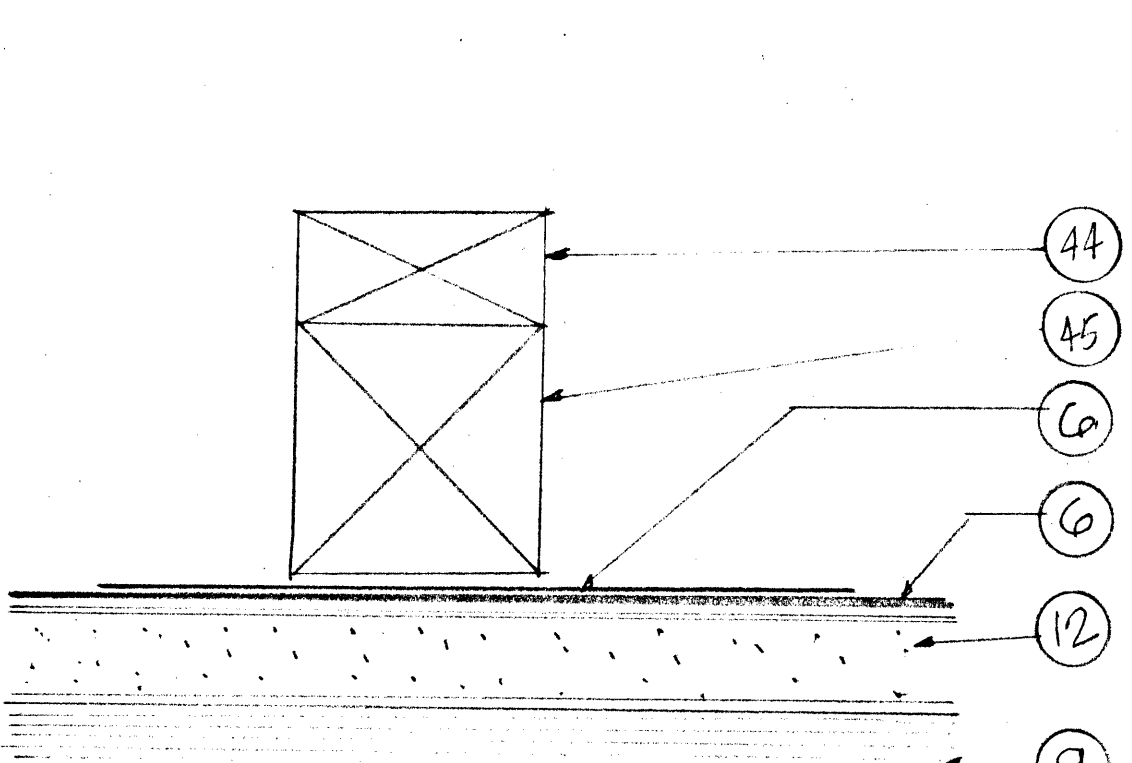

RAIL DETAIL NO SCALE 13

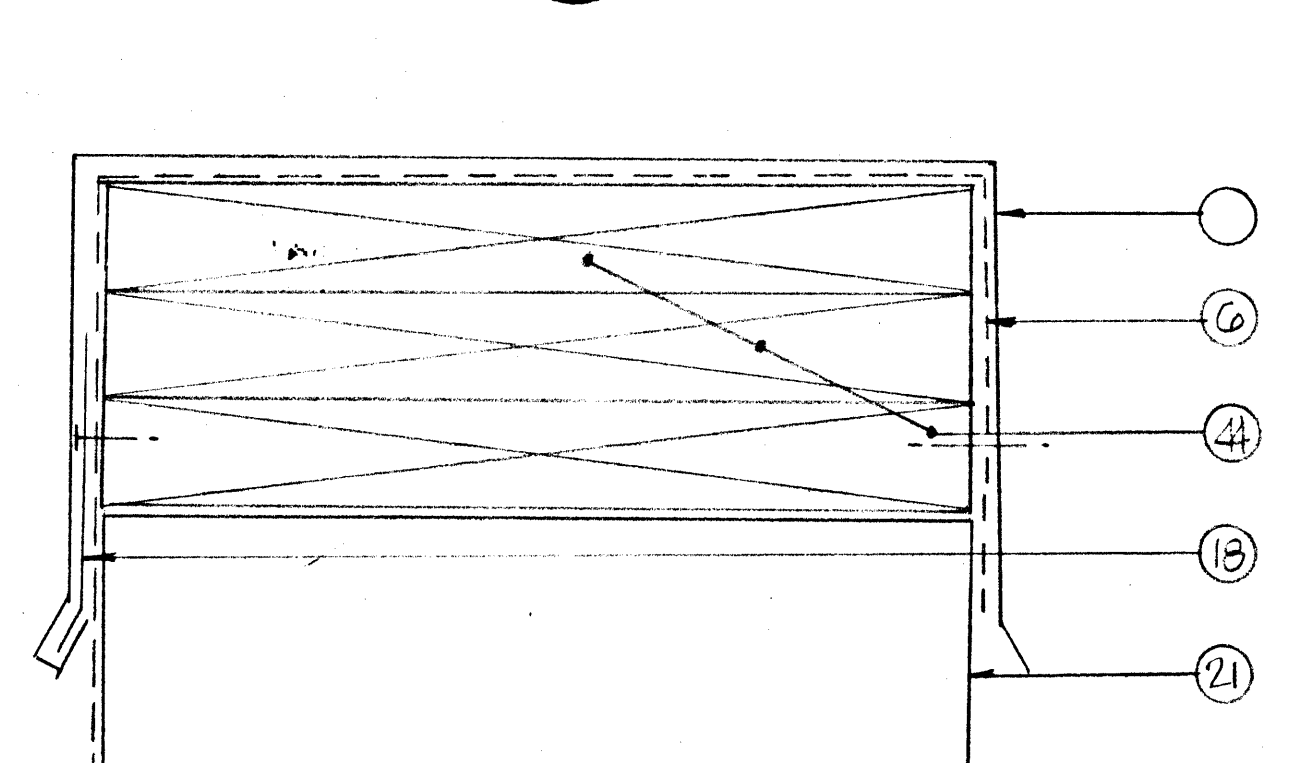

DETAIL NO SCALE 14

- NOTES: (THIS SHEET ONLY)**
1. SURE SEAL MEMBRANE OR FLASHING
 2. EXIST. MINERAL ROOFING OVER RAIL
 3. R.F.S. #3 W/ ACCEPTED FASTENER
 4. EXIST. RAIL AT COOLER FRAMES
 5. CRICKET AT RAIL - FORM FROM ACCEPTED INSULATION MATERIAL
 6. SURE SEAL MEMBRANE 60 MIL.
 7. SURE SEAL BONDING ADHESIVE
 8. EXIST. SMOOTH SURFACED BUILT-UP ROOFING TO BE REMOVED.
 9. EXIST. WOOD DECK
 10. NEW DOME FOR ROOF DRAIN.
 11. SURE SEAL SPLICING CEMENT
 12. 1/2" TYPE 'X' W.R. GYP. BD. (NEW)
 13. ZURN Z-126 ROOF DRAIN W/ DOME (NEW)
 14. EXIST. ROOF LEADER 2" x 5" x 1/2"
 15. SURE SEAL LAP SEALANT
 16. NEW CAULKING
 17. 24 GA. G.I. FLASHING - PAINT TO MATCH EXISTING
 18. CONT. CLEAT
 19. EXIST. CORNICHE
 20. NEW 2x6 LEADER - SLOPED (ANCHOR AT 4'-0" O.C. W/ 1/2" EXPANSION BOLTS)
 21. EXIST. CMU WALL
 22. G1 EPDM ELASTOFORM FLASHING & LAP SPLICE CENTERED O/ R.F.S. #3 WITH ACCEPTED FASTENER
 23. 1/2" TYPE 'X' W.R. GYP. BD. (NEW)
 24. NEW 2 LAYERS 5/8" PLYWD.
 25. EXIST. 2x WOOD JOIST
 26. CENTER BLOCKING O/ ROOF JOIST
 27. EXIST. BOW STRINGS TRUSS
 28. EXIST. 8" CMU WALL
 29. EXIST. L LEADER
 30. EXIST. CORRUGATED STEEL DECK - 29 GA. x 1/2"
 31. EXIST. 6x4x4 @ 45' O.C. I
 32. EXIST. C8 CHANNEL
 33. ADD NEW 6x4x4 @ EA. MID SPAN - APPROX. - 11' REQ'D (FIELD VERIFY PRIOR TO BID) - DELETE
 34. EXIST. 6x4x4 - APPROX. 12' (FIELD VERIFY PRIOR TO BID)
 35. NEW 4" x 1/4" PLATE
 36. 2" x 1/8" CONT. @ 1/5 PTS. - WELD TO BOTTOM OF 4" x 1/4" PLATE
 37. CURED MEMBRANE OR ASPHALTIC IMPRES-NATED WALKWAY BOARD
 38. CURB OR SLEEPER OR BLOCK 2x MIN.
 39. PIPE CLAMP TO FIT EXIST. LINES. SECURE TO 2x
 40. CONTRACTOR TO PROVIDE LAYOUT OF LETTERS FOR APPROVAL PRIOR TO ORDERING LETTERS FROM SUPPLIER
 41. NEW 12" HIGH LETTERS. SEE NOTE 3 ON NEW ROOF PLAN SEE SHT. A-1
 42. WOOD NAILER 4'-0" O.C.
 43. DELETE WOOD CANT
 44. NEW G.I. CAP FLASHING.

Med E. Cole AIA
Patrick J. Kerk AIA
Thomas M. Silva AIA
Harris P. Sharp AIA (Retired)

Harris Sharp Associates Incorporated
Architecture, Planning, Interiors
4800 West Charleston Boulevard Las Vegas, Nevada 89102 (702) 877-0705

15-338

Sheet Title
EXIST. ROOF FRAMING PLAN - ROOF AREA 'D' & MISC. DETAILS

Job
880307.1

Date
MAY 31, 1999

Drawn By
JG2

Check
T.M.B.

Sheet
A-3

3

GENERAL SERVICES ANNEX RE-ROOF LAS VEGAS, NEVADA

Verify all Dimensions and Locations of the S/S

RECORD DRAWING