

CITY OF LAS VEGAS

MAYOR

RON LURIE



CITY COUNCIL

BOB NOLEN

STEVE MILLER

W. WAYNE BUNKER

ARNIE ADAMSEN

RE-ROOF OF GENERAL SERVICES ANNEX

300 LAS VEGAS BOULEVARD NORTH

LAS VEGAS, NEVADA 89101

PROJECT NUMBER : 880307.1

DEPARTMENT OF GENERAL SERVICES

Index to Drawings

T-1	TITLE SHEET
A-1	NEW & EXISTING ROOF PLANS
A-2	MISCELLANEOUS DETAILS
A-3	EXIST. ROOF FRAMING PLAN - ROOF AREA'D & MISC. DETAILS


Basis of Design

Code Use:
1985 UBC

Occupancy:
N/A

Occupancy Load:
N/A

Construction:
N/A

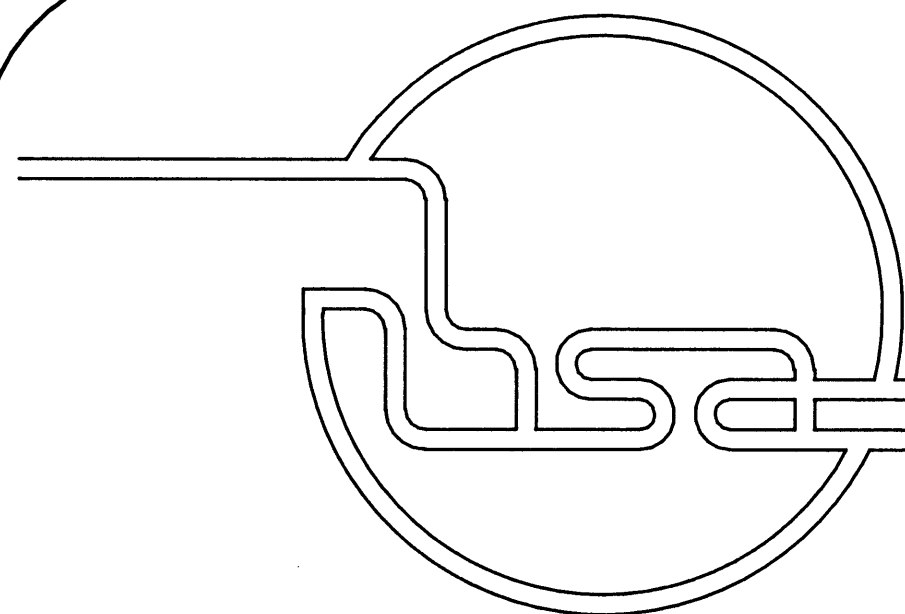


Harris Sharp Associates Incorporated

Architecture, Planning, Interiors

4800 West Charleston Boulevard Las Vegas, Nevada 89102 (702) 877-0125

Vicinity Map

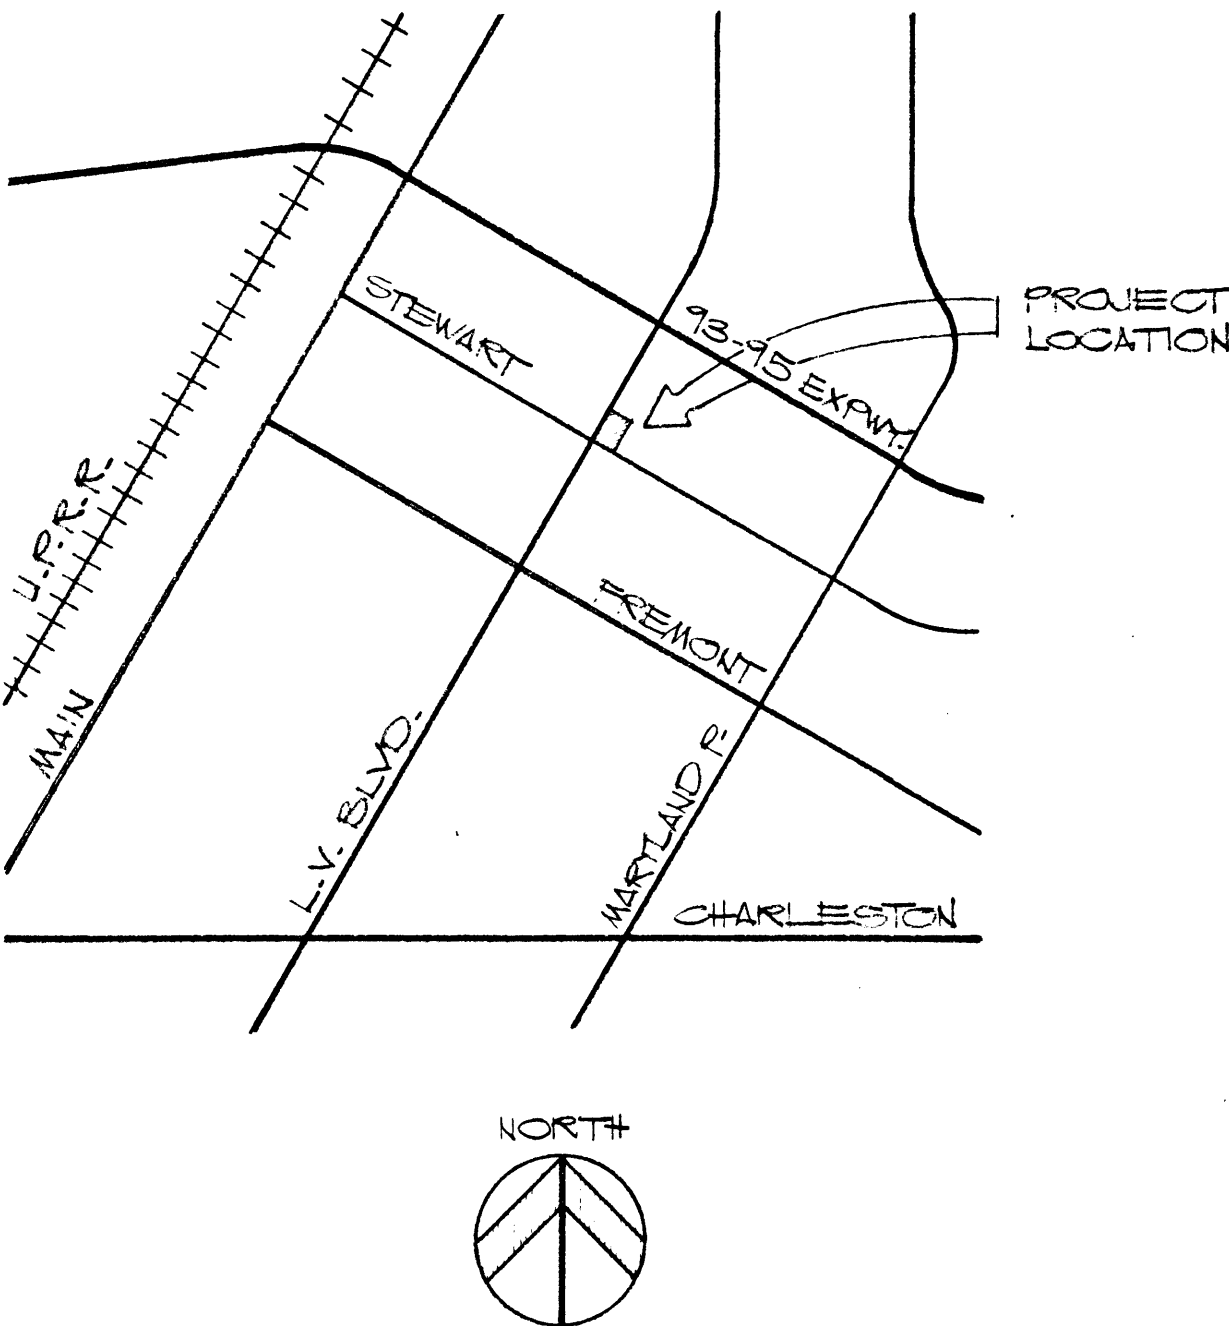

Architect

Set

RECORD DRAWING

CITY OF LAS VEGAS

MAYOR

RON LIPS



CITY COUNCIL

BOB NELSON

STEVE MILLER

W. WAYNE BURGER

ALFRED JOHANNSEN

RE-ROOF OF GENERAL SERVICES ANNEX

300 LAS VEGAS BOULEVARD NORTH

LAS VEGAS, NEVADA 89101

PROJECT NUMBER : 880307.1

DEPARTMENT OF GENERAL SERVICES

Index to Drawings

- 101 TITLE SHEET
- 102 SITE & EXISTING ROOF PLAN
- 103 EXISTING ROOF SECTION
- 104 EXISTING ROOF ELEVATION

Books of Design

See Use

REV. 10/80

Shopping

10/80

Shopping List

10/80

Construction

10/80



Harris Sharp Associates Incorporated

Architecture, Planning, Interiors

4800 West Charleston Boulevard Las Vegas, Nevada 89102 (702) 877-0325

Locality Map



Architect

Set

10/80 10/80