


* / COORDINATE ANY SPECIAL CONDITIONS W/ OWNER IN WRITING

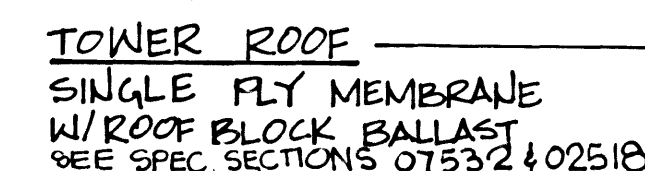

- 18. EXISTING 3" SQ. STRUCTURAL STEEL MTD. TO POSTS BELOW @ 30" +/- ABOVE EXISTING ROOF DO NOT DISTURB ANTENNAS MTD. TO THESE MEMBERS
- 19. EXISTING 2" CONDUIT @ 30" +/- ABOVE EXISTING ROOF
- 20. EXISTING 3" DIA. POST MTD. TO BASE PLATE. SEE DETAIL 3/A2.2 FOR SIMILAR CONDITION OF FLASHING
- 21. FUTURE STEEL BRACING (NIC)
- 22. OUTLINE OF ELEVATOR PENTHOUSE BELOW ROOF. USE NO FASTENERS IN THIS AREA THAT WOULD PENETRATE THE DECK.

THESE DRAWINGS AND DESIGNS ARE THE PROPERTY OF THE ARCHITECT AND MAY NOT BE DUPLICATED OR UTILIZED FOR ANY PURPOSE WITHOUT THE ARCHITECT'S WRITTEN CONSENT. AS INSTRUMENTS OF SERVICE, THESE DOCUMENTS ARE NOT FINAL, AND THEREFORE NOT VALID, UNLESS THEY ARE SIGNED, DATED, AND SEALED BY THE ARCHITECT GARY F. CONGDON.

REVISIONS:
 1.25.90

DRAWING TITLE: New Roof Plan

PROJECT: City of Las Vegas Tower/Penthouse Reroofing



PROJECT: 8805
DATE: JANUARY 8, 1990
Sheet 3 of 7
DRAWING NO.: A1.2

As Built