


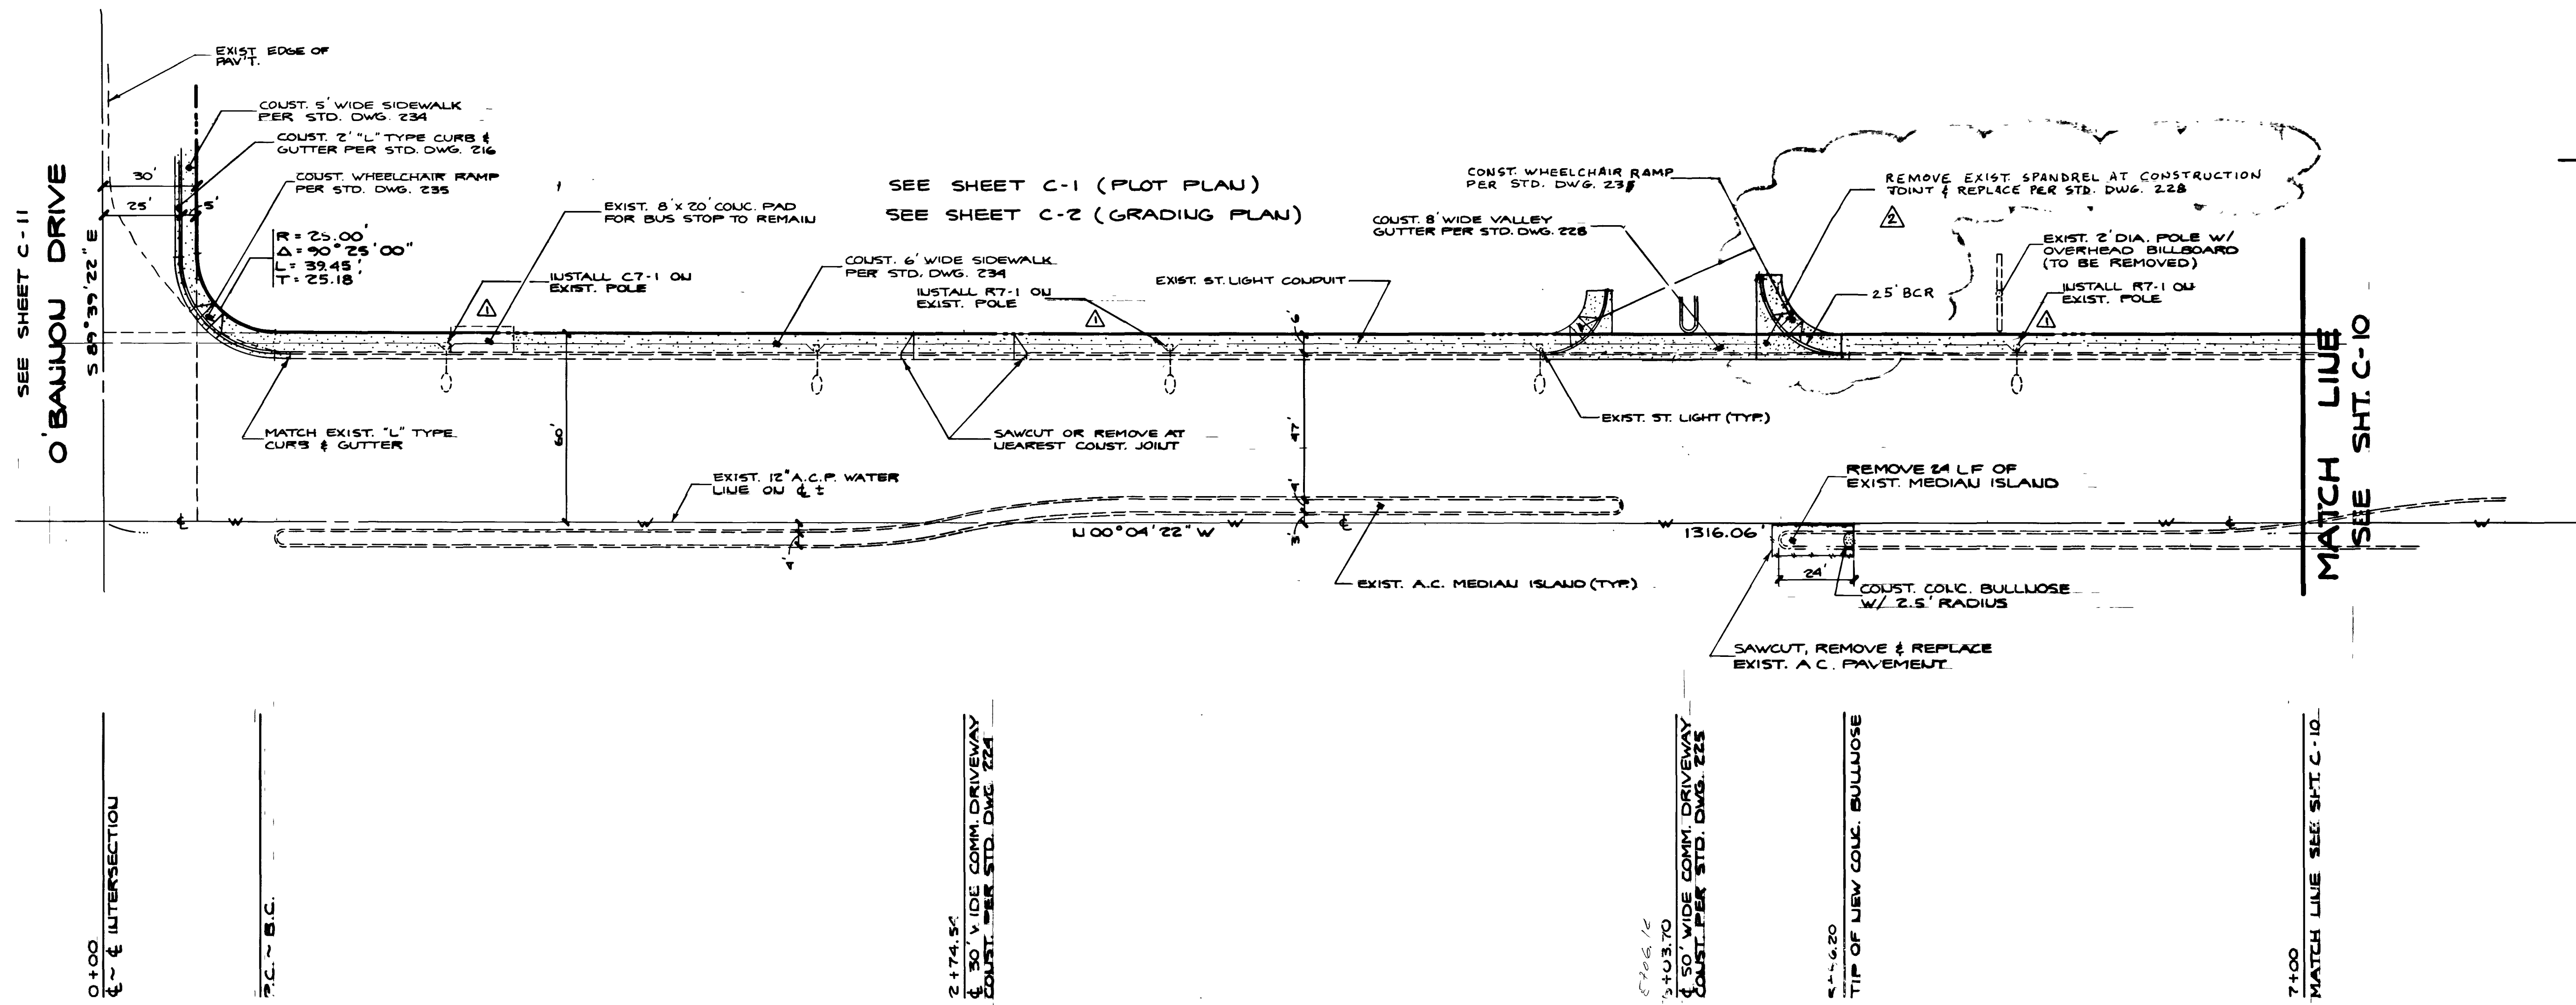

DECATUR

BLVD.

STREET DESIGN SECTION 6, TOWNSHIP 21 SOUTH, RANGE 61 EAST, M.D.B. 14 CITY OF LAS VEGAS CLARK COUNTY NEVADA DECATUR BLVD	DATE DEC. 1988 DESIGN G.A.P. DRAWN D.S.T. CHECK R.J.B. SCALE AS NOTED	BAUGHMAN & TURNER CIVIL ENGINEERS LAND SURVEYORS 2335 WEST CHARLESTON BOULEVARD 702-870-8771 9702	ALLIED DEVELOPMENT CO.	DATE NO. W/APP	REVISIONS ADDED C7-1 & RT-1 REMOVE SPANDREL, INCREASE BCR	APP'D
				DATE NO. W/APP	REVISIONS ADDED C7-1 & RT-1 REMOVE SPANDREL, INCREASE BCR	APP'D

11-3-20

