

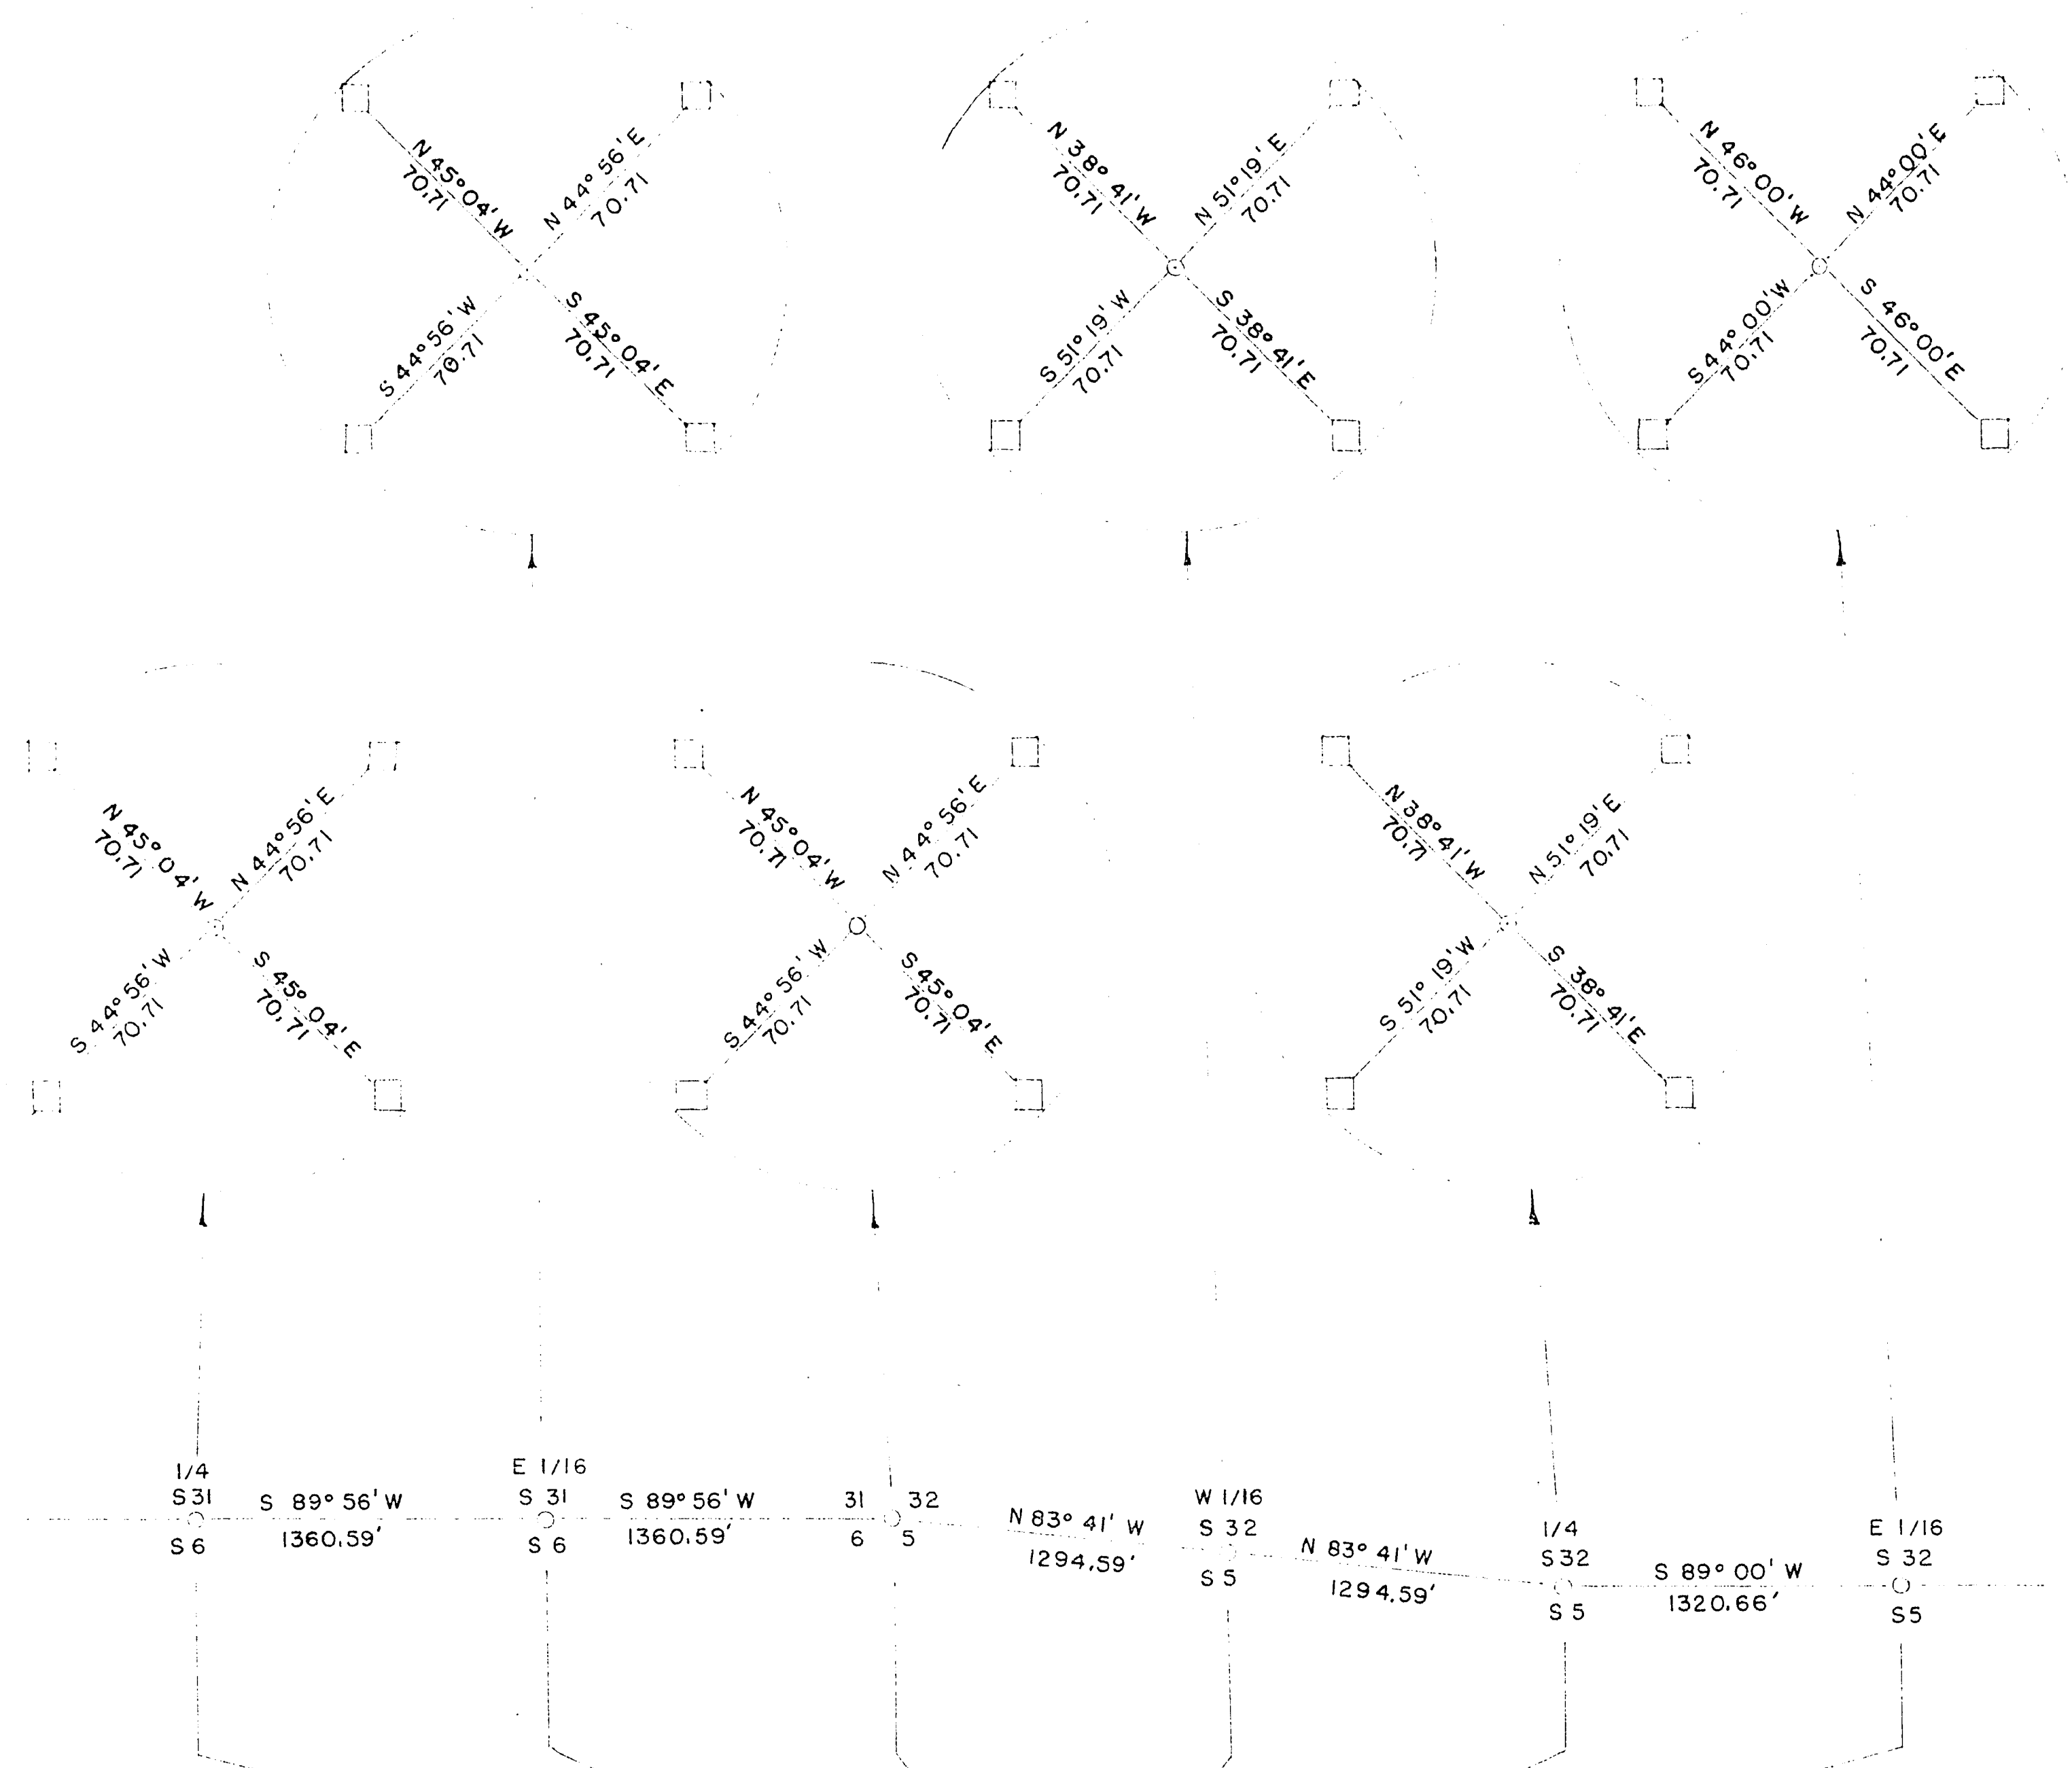


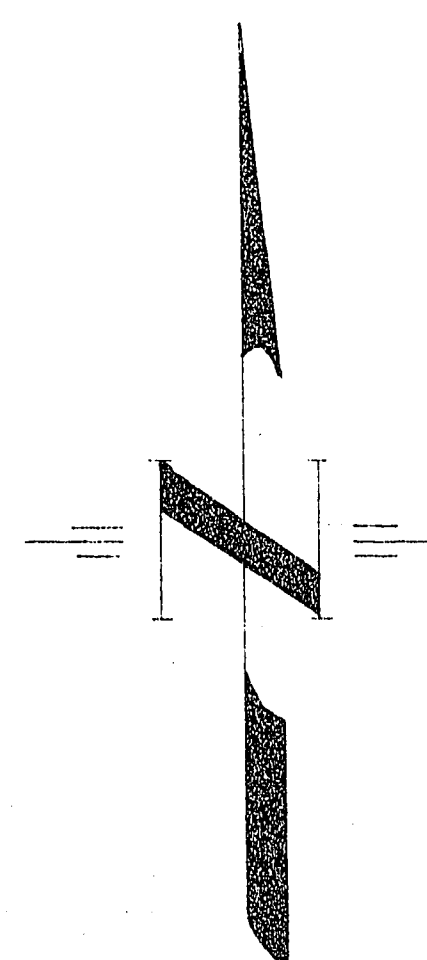

LEGEND

- INDICATES 3/4" IRON PIPE.
- INDICATES STANDARD BRASS DISK.
- BEARINGS ARE BASED ON U.S. CADASTRAL SURVEY DATA.

SECTIONS 31,32 T.21 R.61
5,6 T.22 R.61

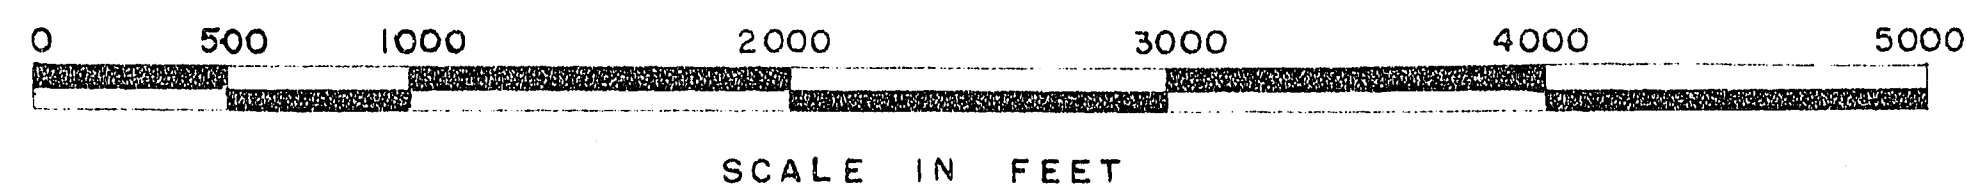

FOUND STANDARD
BRASS DISKS - U.S.
CADASTRAL SURVEY
BURIED 6 INCHES.
(ALL CORNER REFERENCES)

I, GEORGE C. MONAHAN, A DULY REGISTERED PROFESSIONAL ENGINEER AND COUNTY ENGINEER FOR CLARK COUNTY, NEVADA, DO HEREBY CERTIFY THAT THIS SURVEY IS A TRUE AND ACCURATE MAP SHOWING THE REFERENCE STAKES SET BY ME IN MY CAPACITY AS COUNTY ENGINEER FOR CLARK COUNTY, NEVADA AT THE INSTANCE OF CLARK COUNTY, AND IS FILED FOR THE SOLE PURPOSE OF MAKING THESE POINTS A MATTER OF RECORD TO AID IN THE RELOCATING OF THE PERTINANT CORNERS, AND THAT THE SURVEY WAS COMPLETED THIS 14TH DAY OF MARCH 1955.

George C. Monahan
REGISTERED PROFESSIONAL ENGINEER NO. 631

NO. 39677
FILED
Clark County Engineer
Date 3-17-55, 2:11 P.
4
RECORDED AT THE REQUEST OF
Clark County Engineer
MAR 17 2 16 PM '55
OFFICIAL RECORD NO. 46
CLARK COUNTY, NEVADA
PAUL C. CHAPLEY, CLERK
FILED

SECTION CORNER REFERENCES	
CLARK COUNTY ENGINEERING DEPT. LAS VEGAS, NEV.	
DESIGNED <i>J. Basler</i>	CHECKED <i>H. B.</i>
DRAWN <i>J. Basler</i>	APPROVED
SCALE AS NOTED	DATE MARCH 14, 1955

058-8

File 4 49

1-6-101