


PLAN
 SURVEYED
 PLOTTED
 CHECKED
 DATE
 BY
 NO.

PROFILE
 SURVEYED
 PLOTTED
 CHECKED
 DATE
 BY
 NO.

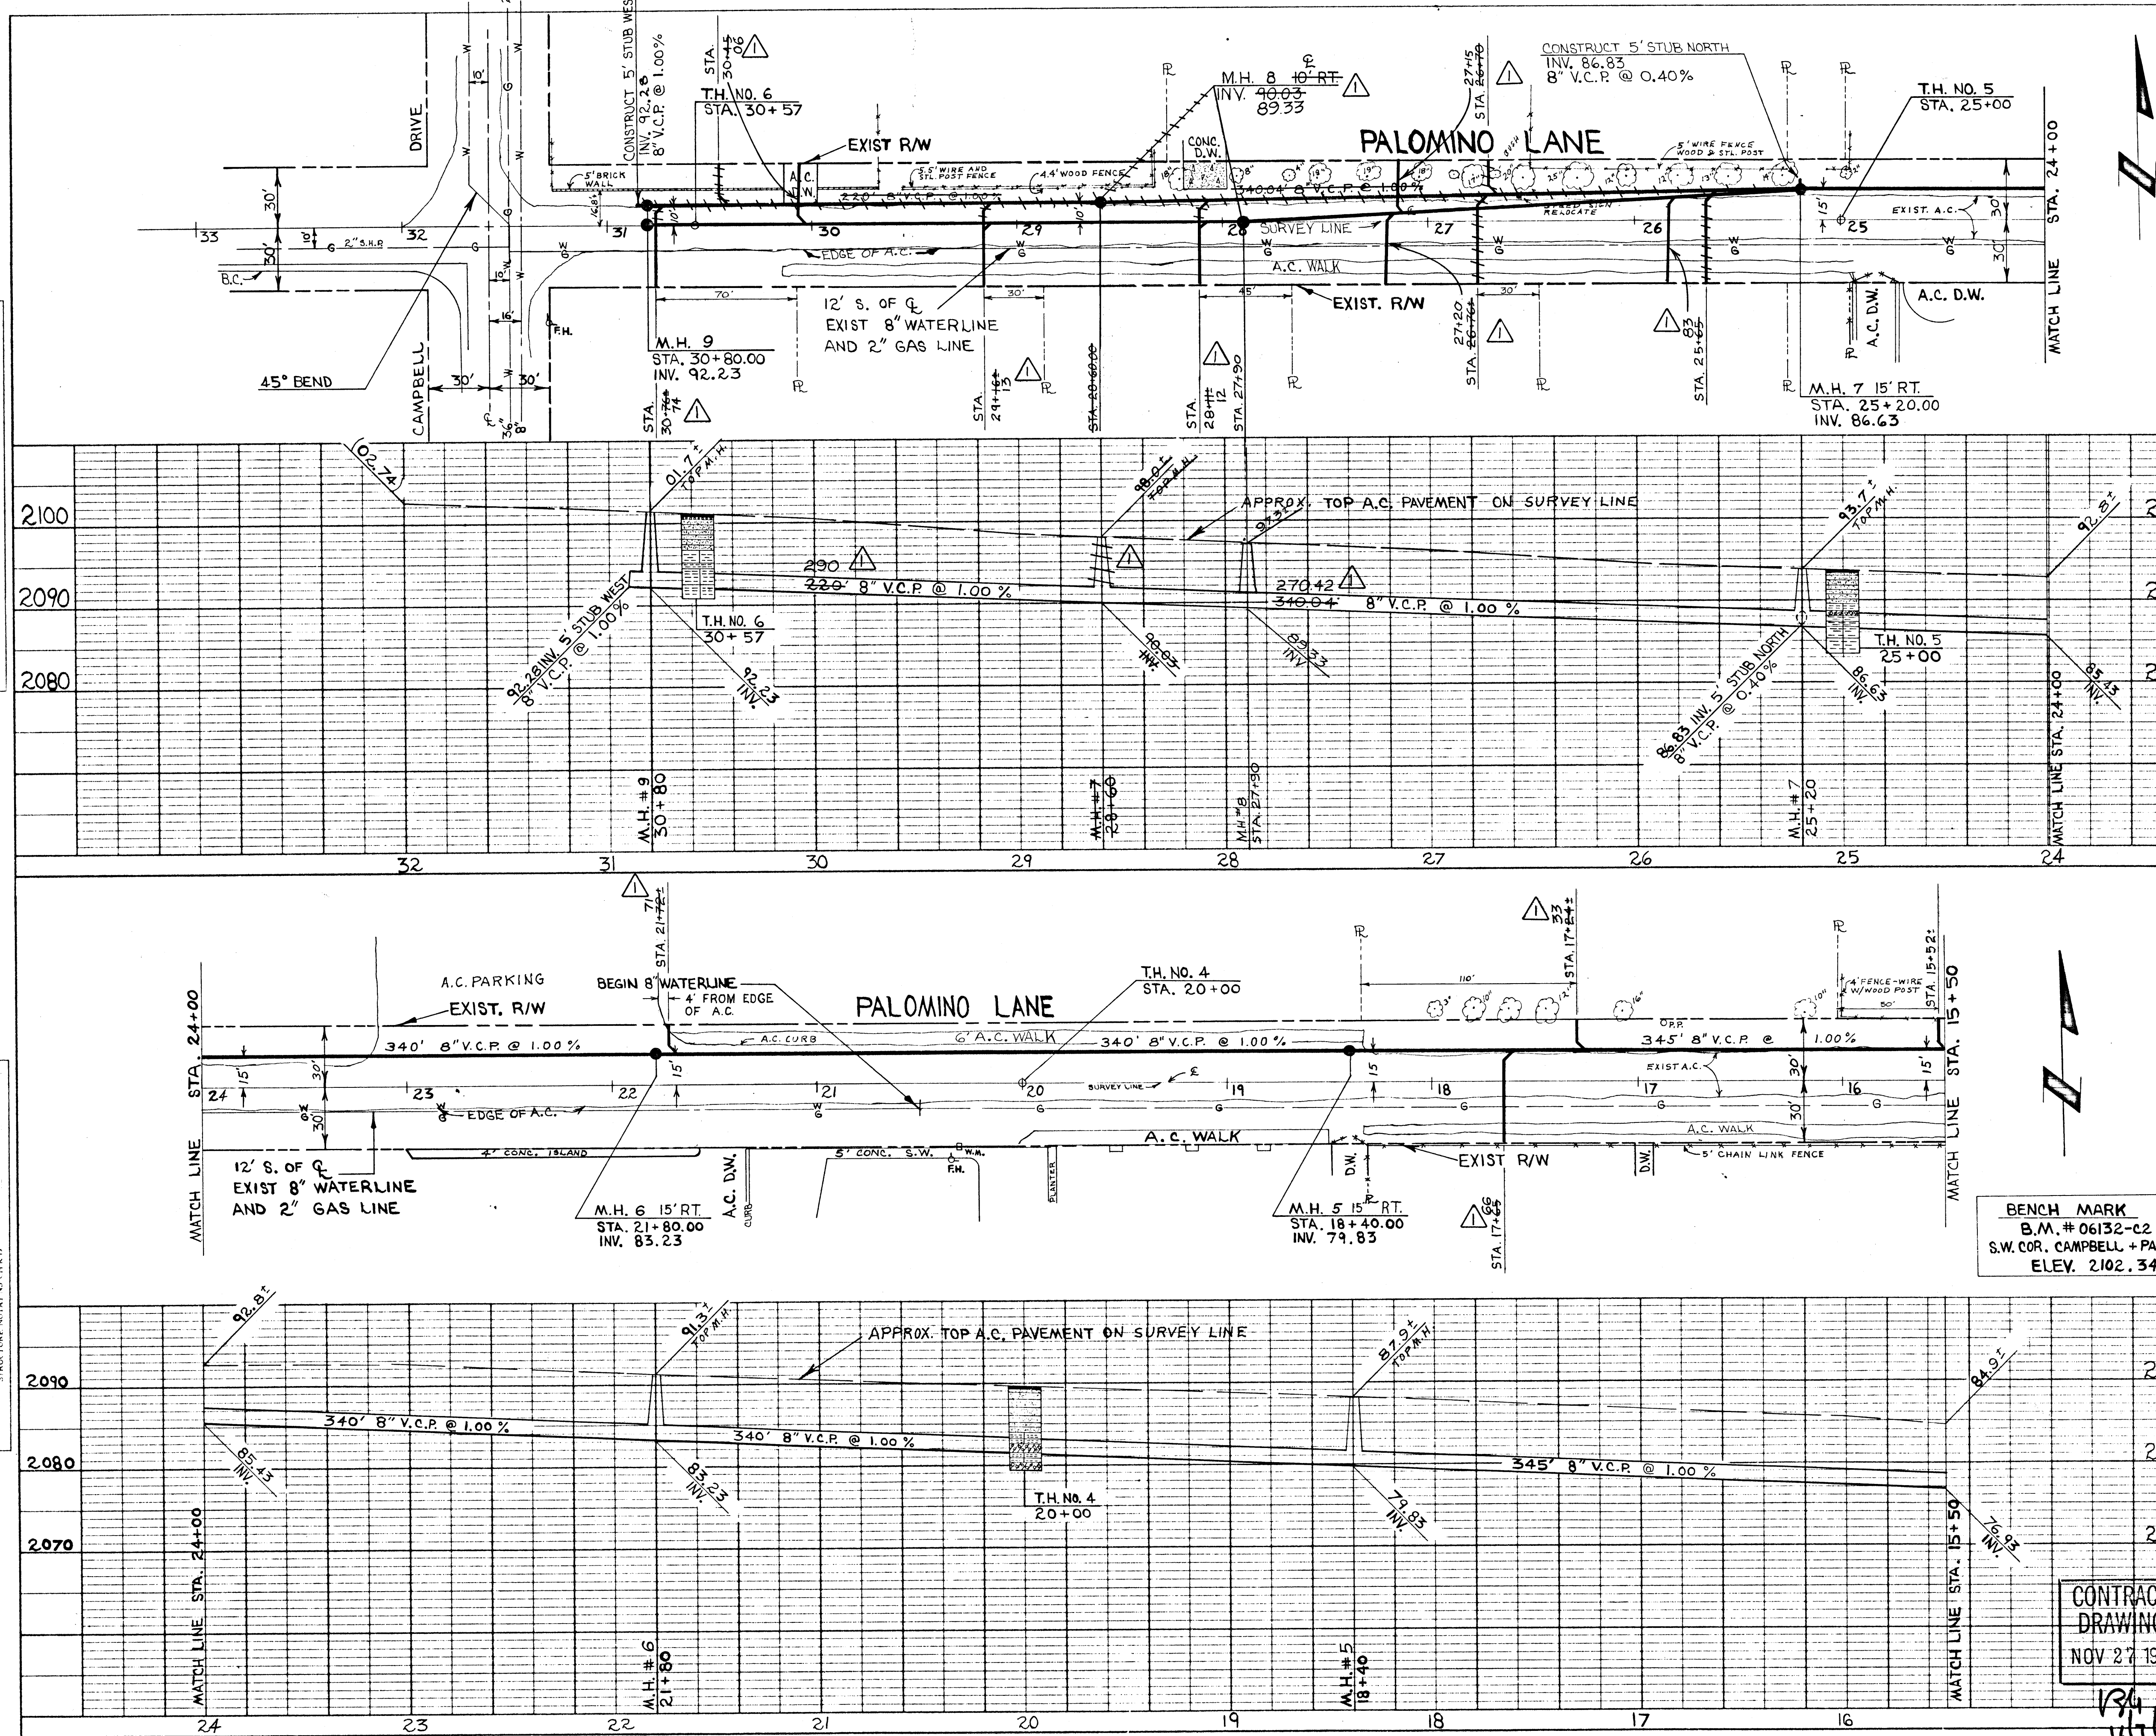

CAUTION: USE DUE CARE FOR SEWER LATERAL EXCAVATION NEAR WATER AND GAS LINE ON SOUTH SIDE OF STREET BETWEEN STAS. 25+00 & 31+00.

NOTE: SEWER LATERAL MARKERS (4"x4" POST, DOUGLAS FIR) SHALL BE INSTALLED AS PER C.L.V. STD. DWG. 512.7. COST OF MARKER TO BE INCLUDED IN PIPE LATERAL COST.

APPROXIMATE QUANTITIES - THIS SHEET			
ITEM	DESCRIPTION	UNIT	QUANTITIES
123.204	4" V.C.P. LATERALS (11 EA.)	L.F.	312

APPROXIMATE QUANTITIES - TOTAL (SHT 3 & 4)			
ITEM	DESCRIPTION	UNIT	QUANTITIES
123.204	4" V.C.P. LATERALS (24 EA.)	L.F.	686

BENCH MARK
 B.M. # 06132-C2
 S.W. COR. CAMPBELL + PALOMINO
 ELEV. 2102.34

"AS BUILT"		M5 10-16-73	
REVISION NO.	DESCRIPTION	BY	DATE APPROVAL
CITY OF LAS VEGAS NEVADA			
DEPARTMENT OF PUBLIC WORKS			
SERVICES DIVISION			
PALOMINO LANE SEWER LATERALS			
WEST OF RANCHO RD. TO CAMPBELL DRIVE			
W.O. NO. 4072	E.B.K. NO. 71-2X	DATE	DRAWING NO.
SC (H) 1" = 40'	SC (V) 1" = 10'	6-28-72	FILE NO.
DR. L. BRADFORD		307-431	
APPROVED BY DIRECTOR OF PUBLIC WORKS		SHEET 4 OF 4	

CONTRACT
 DRAWING
 NOV 27 1972

134
 11/1/72