


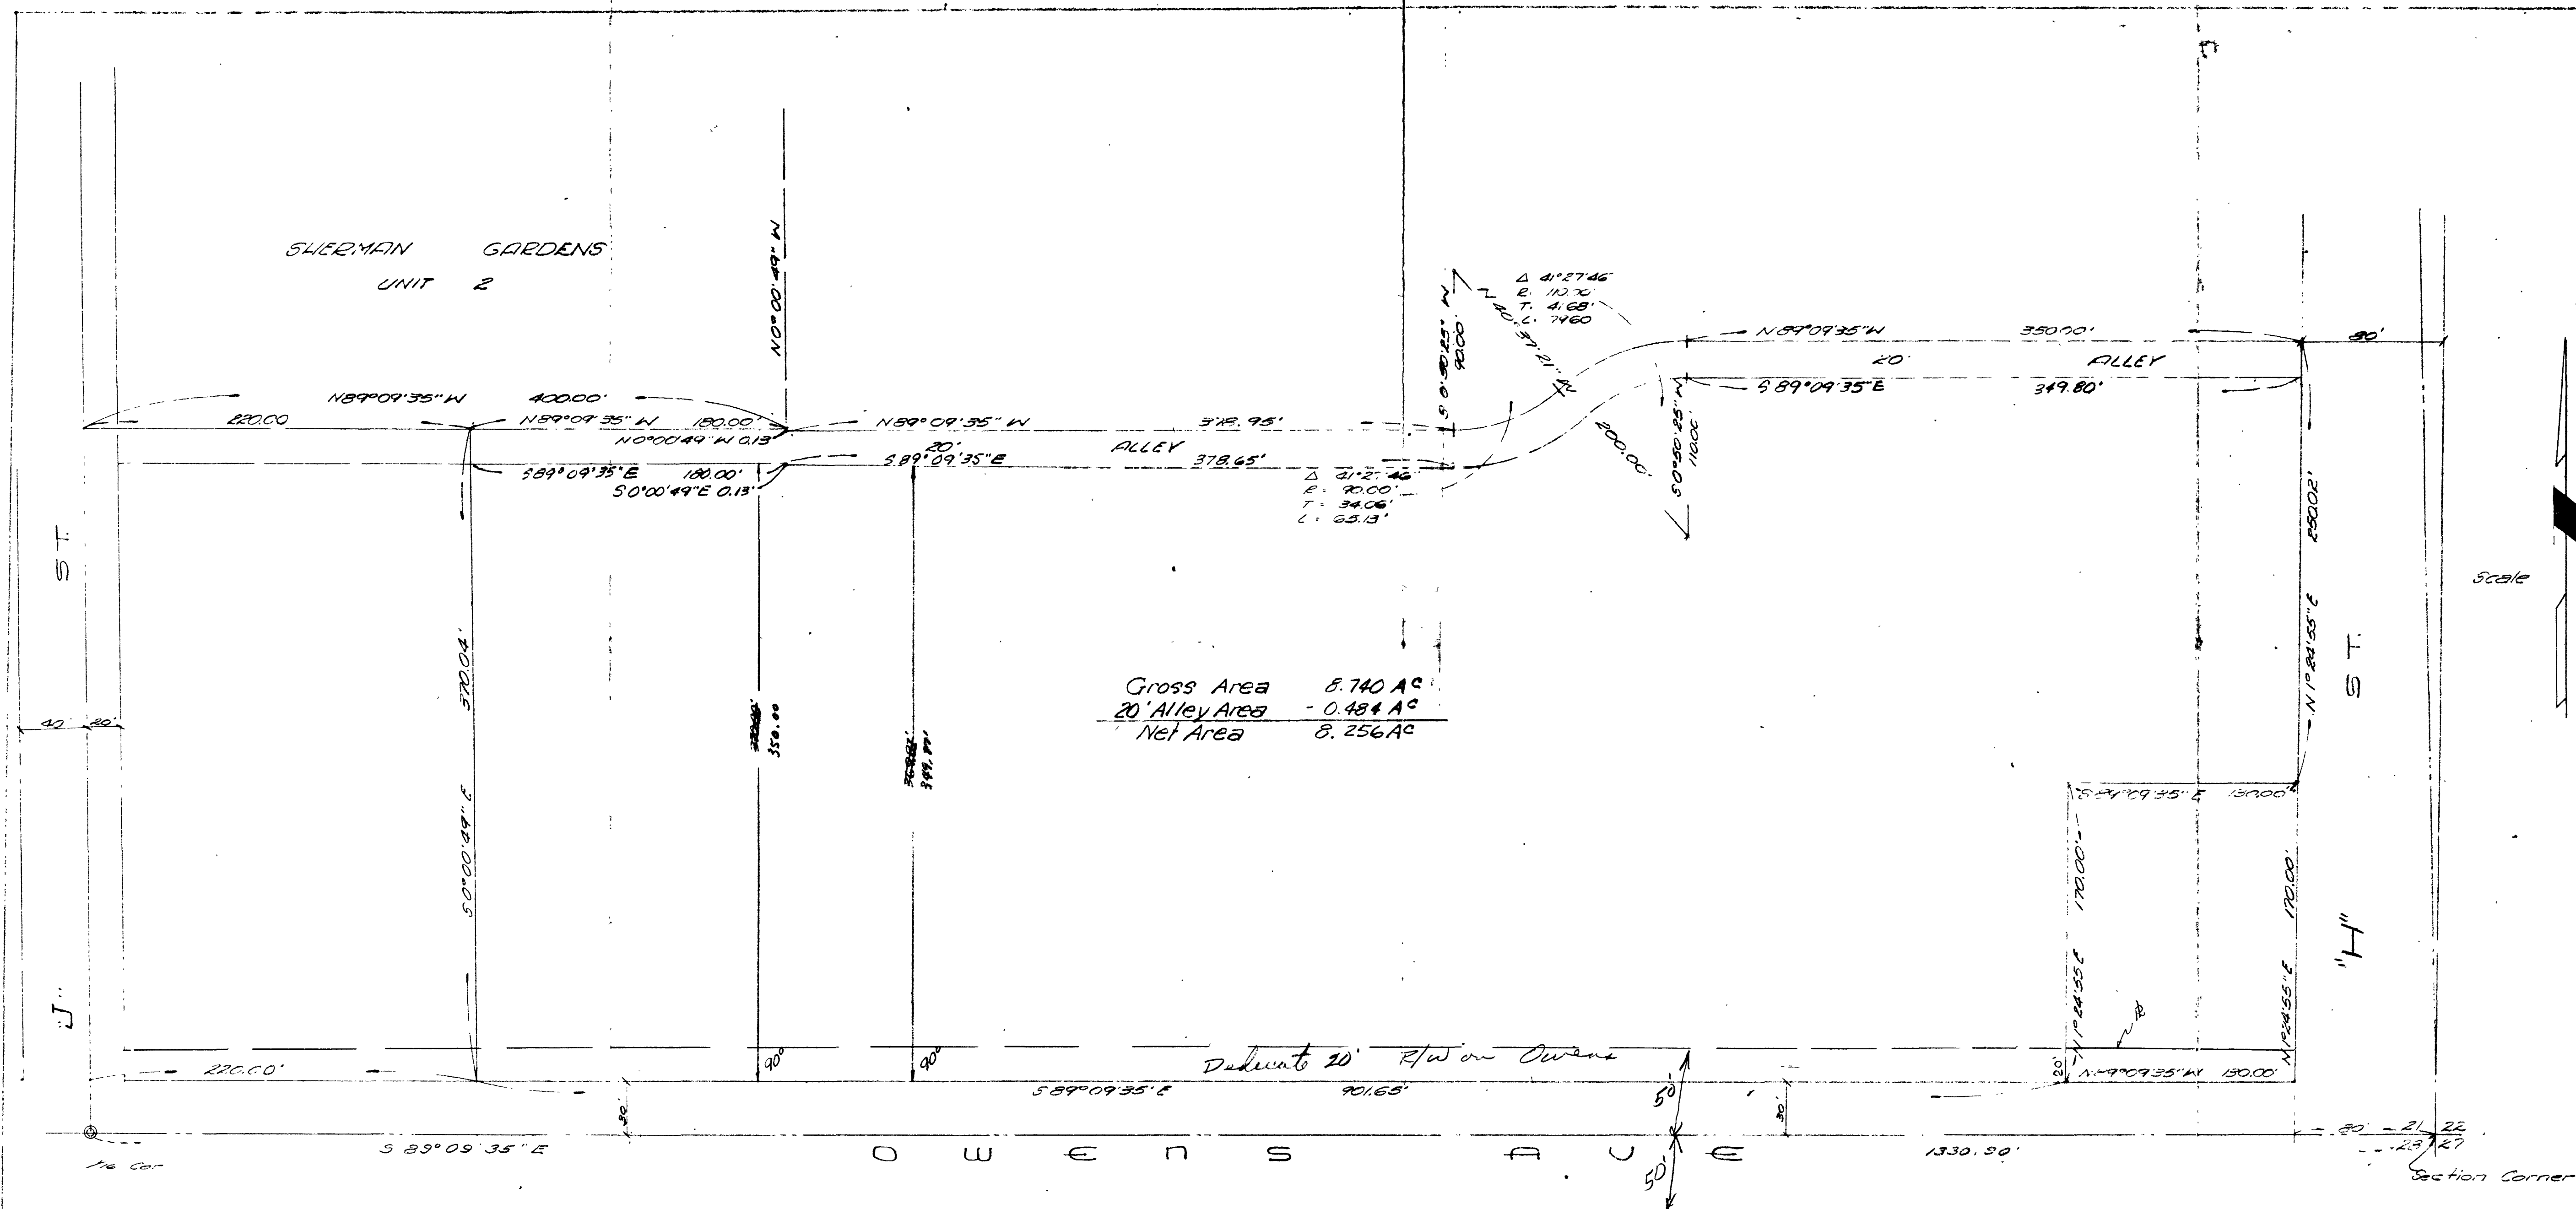


CERTIFICATE

I, Jack K. Leavitt, Registered Professional Engineer and Land Surveyor, do hereby certify that this map is a true and accurate representation of the lands shown hereon. All points found or set are correctly designated. This plat was completed on November 22, 1963 at the instance of Robert Kattenborn.

Jack K. Leavitt
Jack K. Leavitt
Registered Professional Engineer
Land Surveyor R.L.S. 807

383 3646

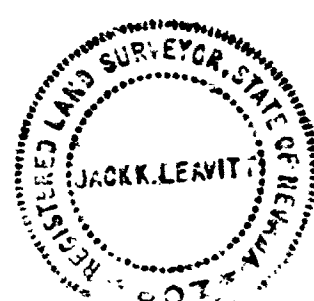

LEGEND

Indicates point found - as shown
Indicates point set - as shown

Scale 1"=50'


Basis of Bearings: The South line of
Section 21, N 89° 09' 35" W

S.M.P.
ONLY COPY

A PORTION OF THE SE 1/4 SE 1/4
OF SEC. 21, T20S. R4W. M.D.B. & M.
CLARK COUNTY, NEVADA

107-V552 4.4-77

107-V552
(also see 035-212)

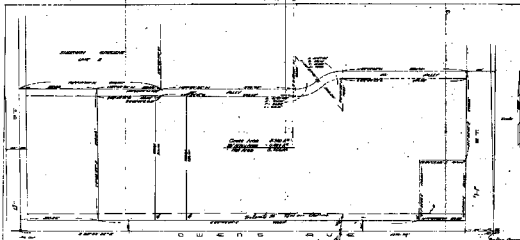

CERTIFICATE
 I, John P. Smith, Registered Professional
 Surveyor in the State of Virginia, do hereby certify that
 the above is a true and correct representation of the
 facts shown herein. All points hereon are shown correctly
 determined. Witness my hand and seal at Alexandria, VA
 this 1st day of March, 1953.

John P. Smith
 Registered Professional Surveyor
 State of Virginia No. 12,345

LEGEND
 Solid line and arrow indicate right of way
 Dashed line and arrow indicate right of way

Scale 1"=50'
 Date of Survey: The South Side of
 Section 8, Town of 15 N

S.M.P.
 ONLY COPY

A PORTION OF THE SET-OUT
 OF THE RIVER FRONT ALLOTMENT
 GREEN COUNTY, VIRGINIA

107-5552-4-179 (1/1/53)