


22-5-143

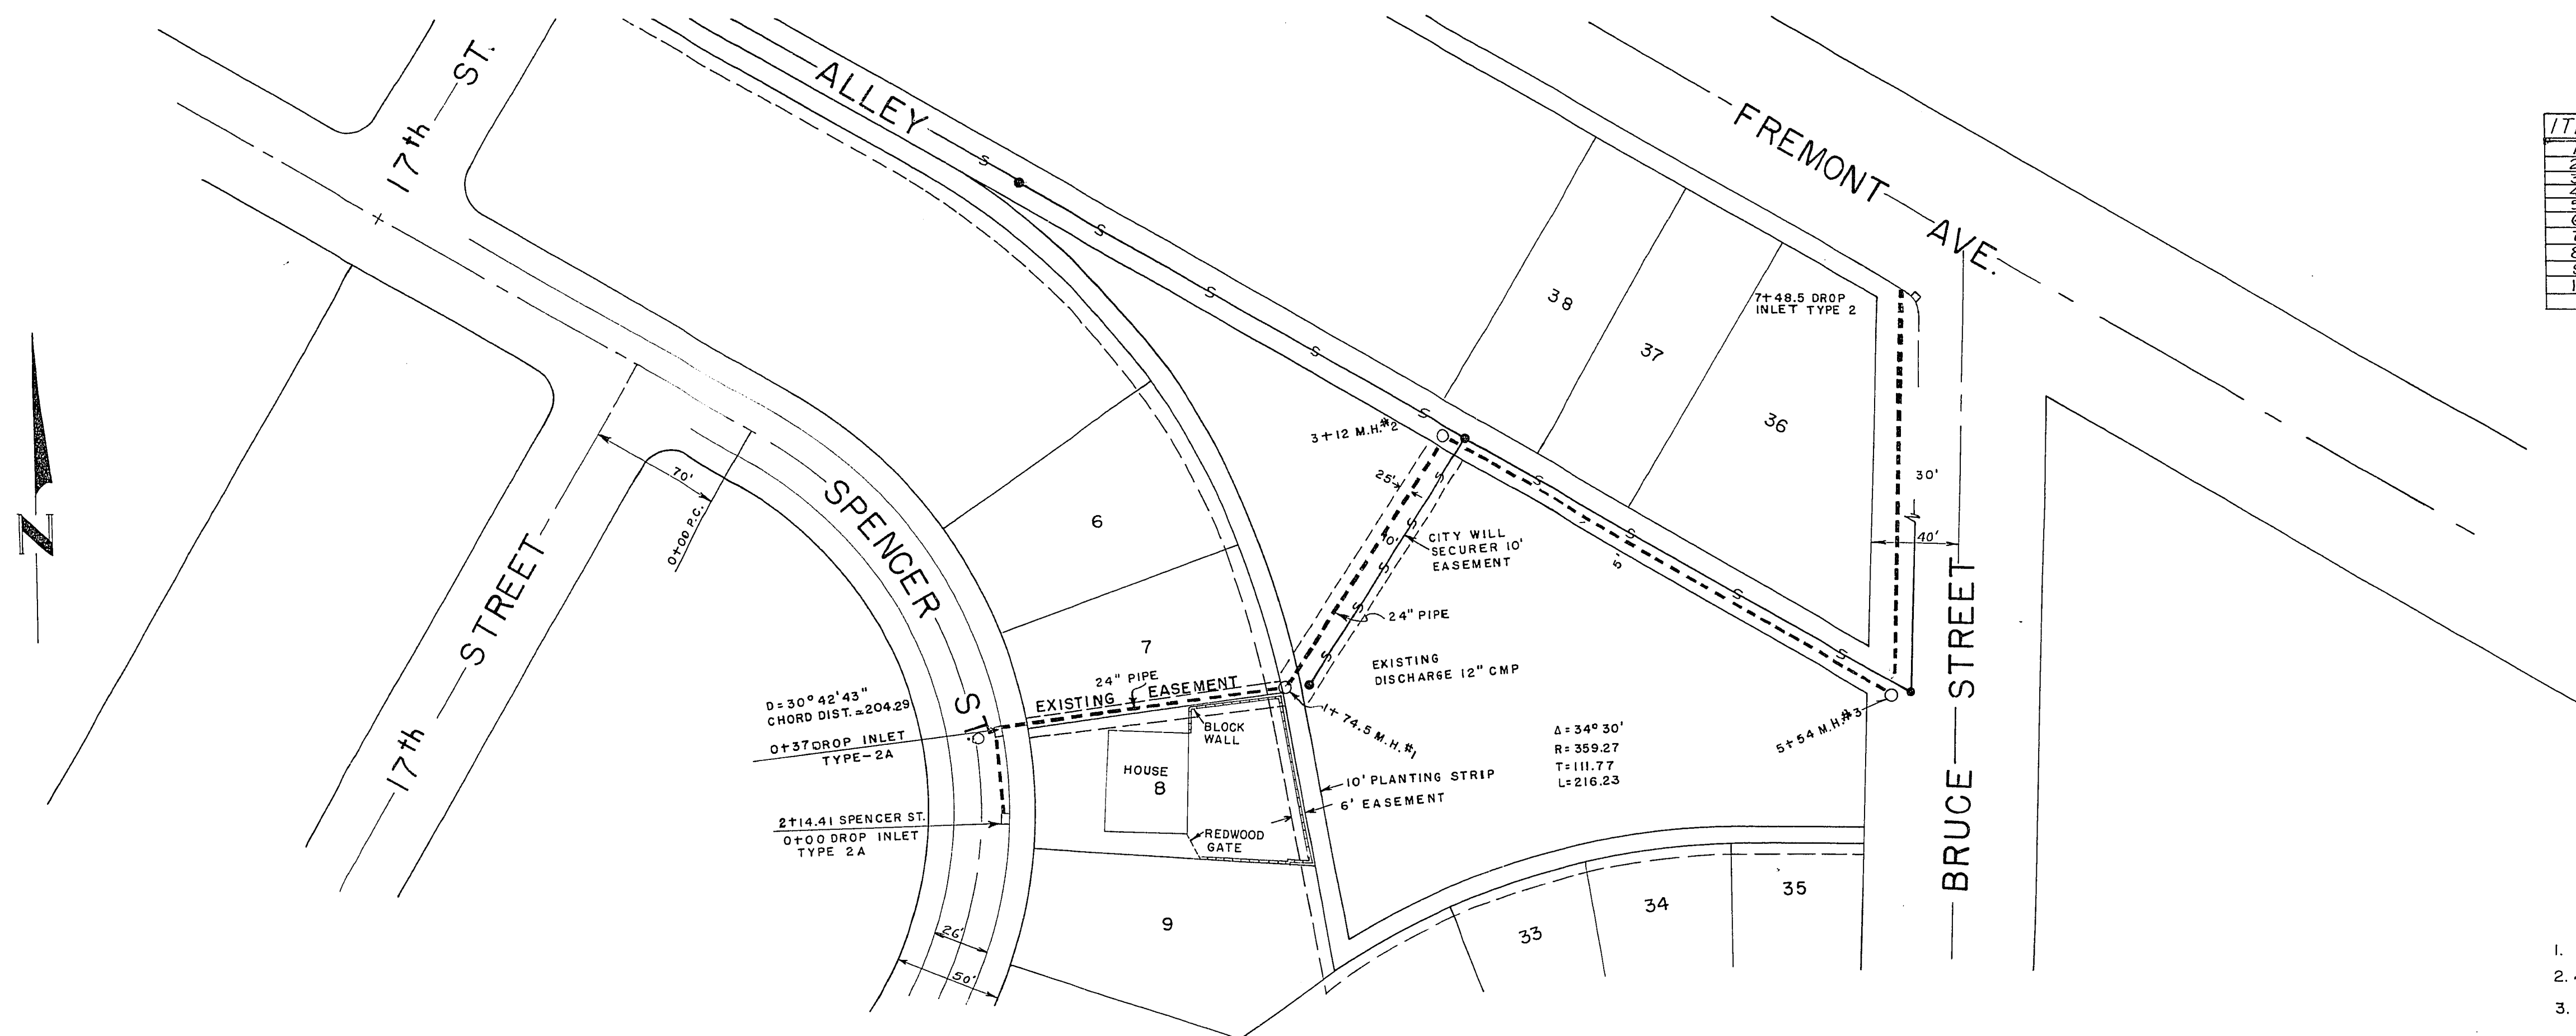

ITEM	ESTIMATE OF QUANTITIES	AMOUNT	UNITS
1	EXCAVATION	2442.10	CU. YDS.
2	PLACE CONC. PIPE	165.00	LIN. FT.
3	MANHOLE CONSTRUCTION	3	EACH
4	DROP INLET CONSTRUCTION	3	EACH
5	PLACE 8" V.C.P.		LIN. FT.
6	PLACE 12" CONCRETE PIPE		LIN. FT.
7	AC PAVING	1.66	SQ. YDS.
8	REMOVE & CONST. CURB & GUTTER	37.00	LIN. FT.
9	REPLACE WALL		SQ. FT.
10	FILL YARD	10.00	CU. YDS.

NOTE

- SEE C-9-28 FOR DROP INLET & MANHOLE DETAILS.
- PROPOSED STORM DRAIN.
- ALL MANHOLES TYPE 2

1915


1910

1905

1900

1895

1890

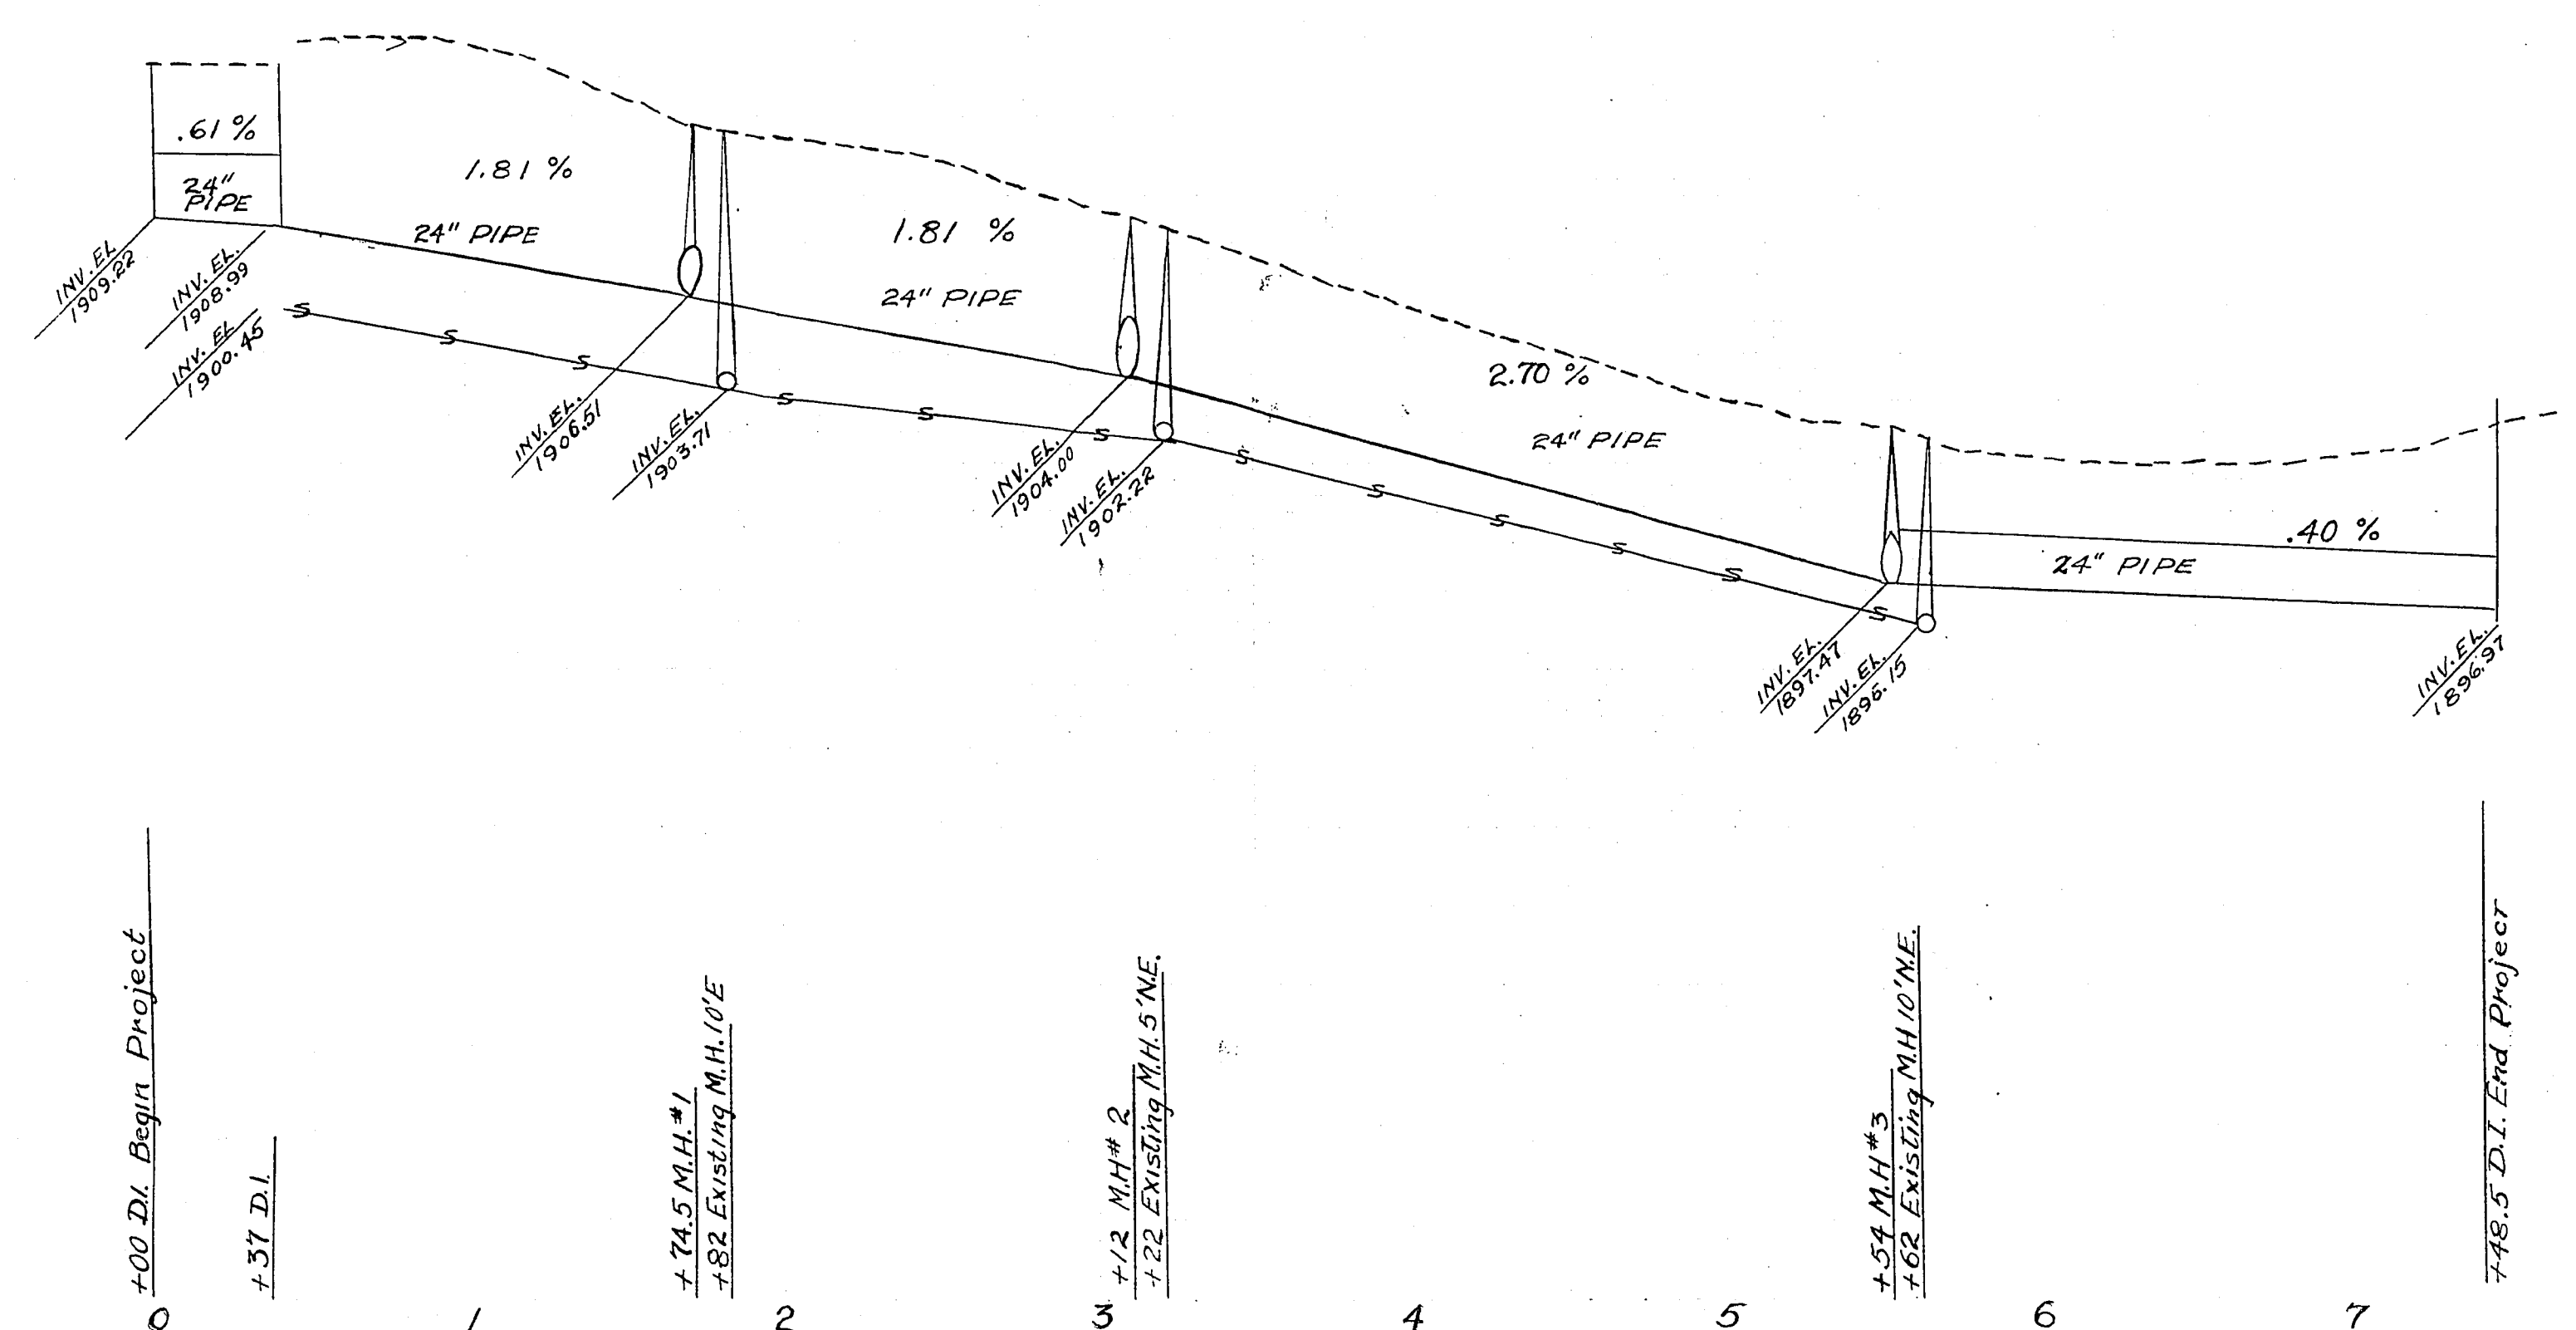

AS BUILT

ALTERNATE "C"

C-14-29C

CITY OF LAS VEGAS, NEVADA
ENGINEERING DEPT.

~~PROPOSED~~ SPENCER ST. STORM DRAIN
POSSIBILITY C

DESIGNED BY	K.C.H.	SCALE	1"=30' HOR. 1"=5' VERT.
DRAWN BY		FIELD BOOK NO.	7-X
CHECKED BY		WORK ORDER NO.	918
APPROVED		DRAWING NO.	327-W/1
CITY ENGR			

REFERENCES
C-9-28
C-16-18
C-18-8