

BENCH MARK

BM #1616B2P - SOUTH EAST
CORNER OAKLEY BLVD &
DECATUR BLVD.
ELEV. = 2215.30 CLV DATUM

APPROVALS*

* PENDING APPROVAL OF ANNEXATION

[Signature] 9/24/83
CITY OF LAS VEGAS - CITY ENGINEER

[Signature] 9/15/83
CITY OF LAS VEGAS - QUALITY CONTROL ENGINEER

[Signature] 9/15/83
CITY OF LAS VEGAS - ELECTRICAL SUPERVISOR

[Signature] 9/15/83
CITY OF LAS VEGAS - FIRE MARSHALL

[Signature] 9/15/83
CITY OF LAS VEGAS - ELECTRICAL COORDINATOR

[Signature] 9/15/83
CITY OF LAS VEGAS - SANITATION CHIEF

[Signature] 9/15/83
NEVADA POWER COMPANY

[Signature] 9/15/83
SOUTHWEST GAS COMPANY

[Signature] 9/15/83
CLV CHIEF - LAND DEVELOPMENT
FIELD CONTROL

[Signature] 9/15/83
ST. NAME SIGN
3 1/2" PULL BOX


GENERAL NOTES

- All Construction shall conform to the latest revised Uniform Standard Specifications and Drawings for City of Las Vegas, Clark County, Nevada.
- Compliance with air pollution controls & regulations will be required at all times.
- Exact locations of all sawcut lines shall be determined in the field by a City of Las Vegas Inspector.
- All construction signing, barricading, & traffic delineation shall conform to the "Nevada Traffic Control Manual".


$\Delta = 89^{\circ}59'13"$
 $R = 15.00$
 $L = 23.50$
 $T = 15.00$

$RCP = 20.00$
 $L = 31.31$
 $T = 20.00$

SCALE
HORIZ. 1" = 30'
VERT. 1" = 3'

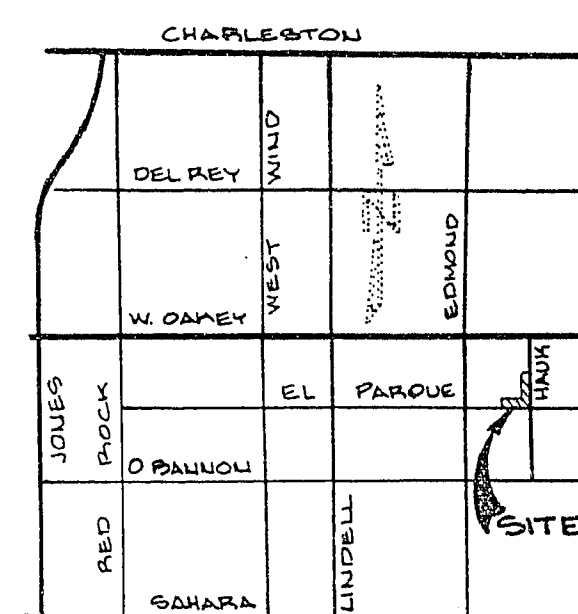

VICINITY MAP
N.T.S.

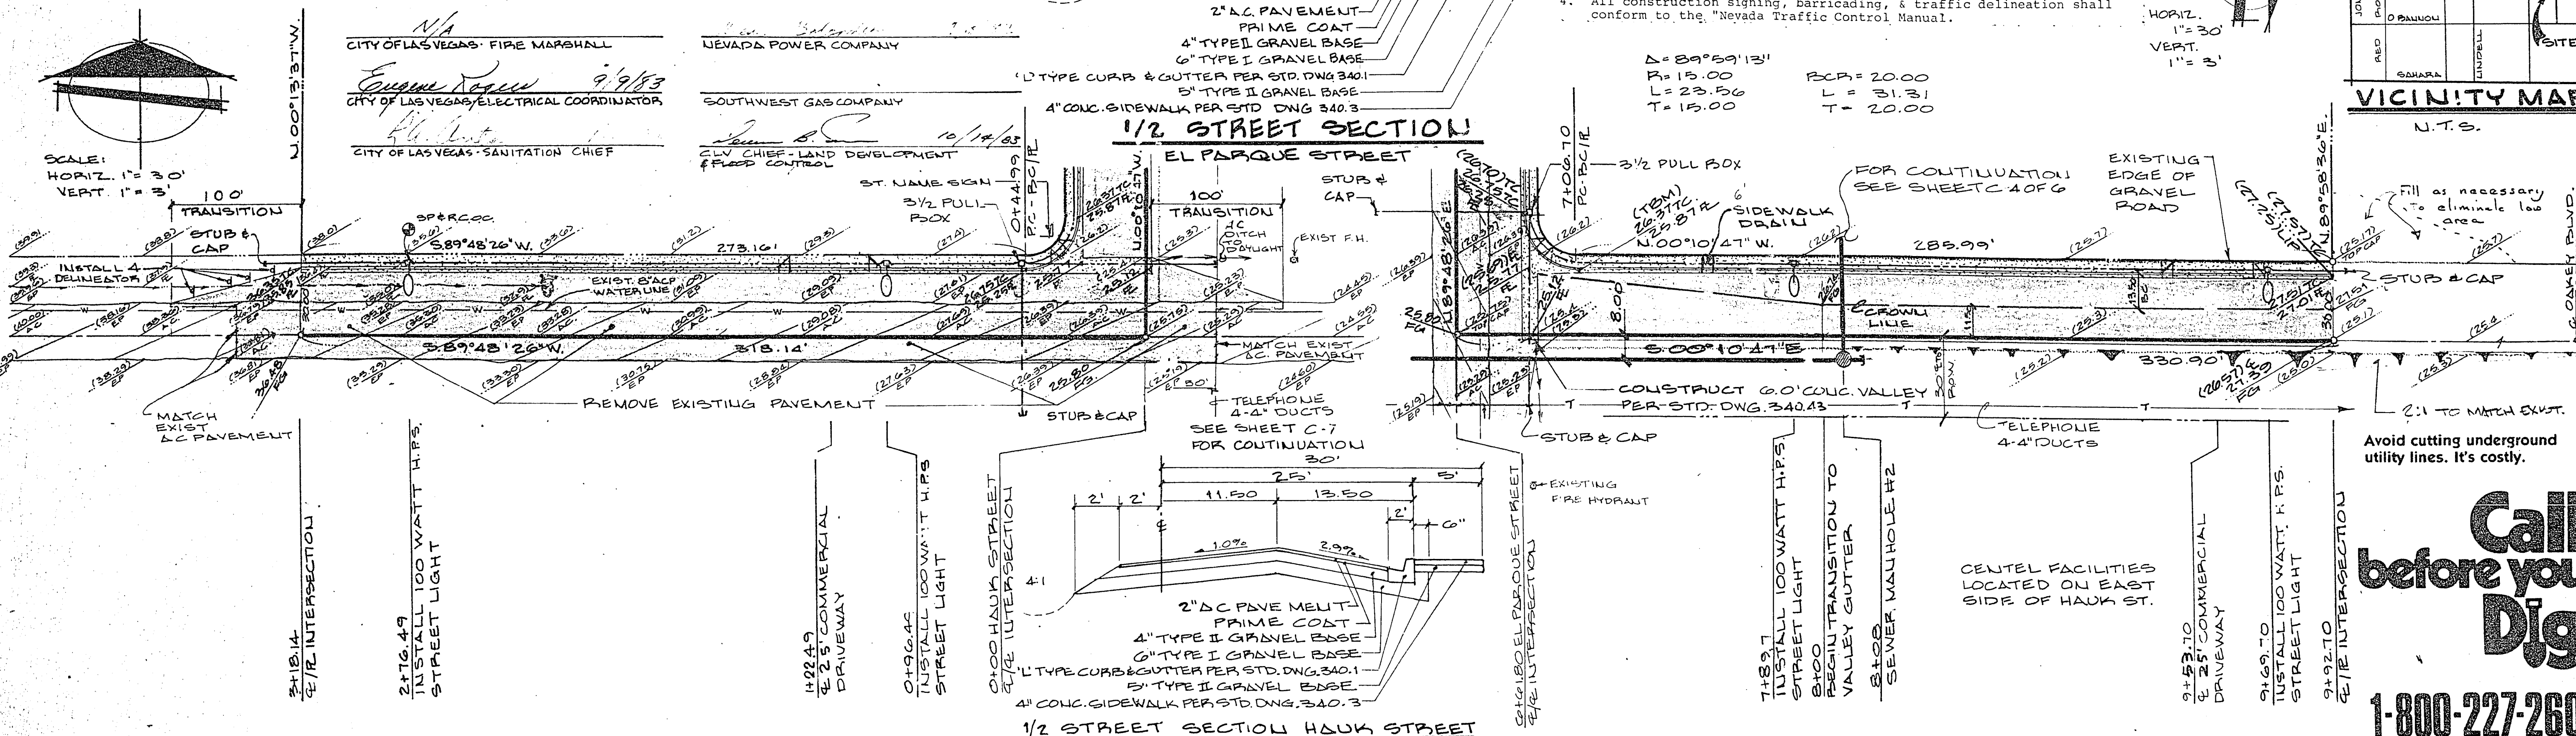

Call before you Dig.
1-800-227-2600
UNDERGROUND SERVICE ALERT (USA)

Avoid cutting underground utility lines. It's costly.

EL PARQUE STREET

HAUK STREET


QUANTITIES

2" DC PAVEMENT	2172.5Y
4" TYPE II GRAVEL BASE	3622Y
6" TYPE I GRAVEL BASE	590LF
CURB & GUTTER	320SF
CONCRETE VALLEY	2562.5'
4" CONC. SIDEWALK	4 EA
STREET SIGNS	1 EA

NOTE: STATIONING ON HAUK STREET IS BASED ON E/E INTERSECTION OF HAUK STREET AND O'BANNION AVENUE = 0+00.

AS-BUILT NOTE

AS-BUILT ELEVATIONS WERE COMPLETED ON MARCH 6, 1984. ALL EXISTING ELEVATIONS SHOWN ARE IN PARENTHESES.

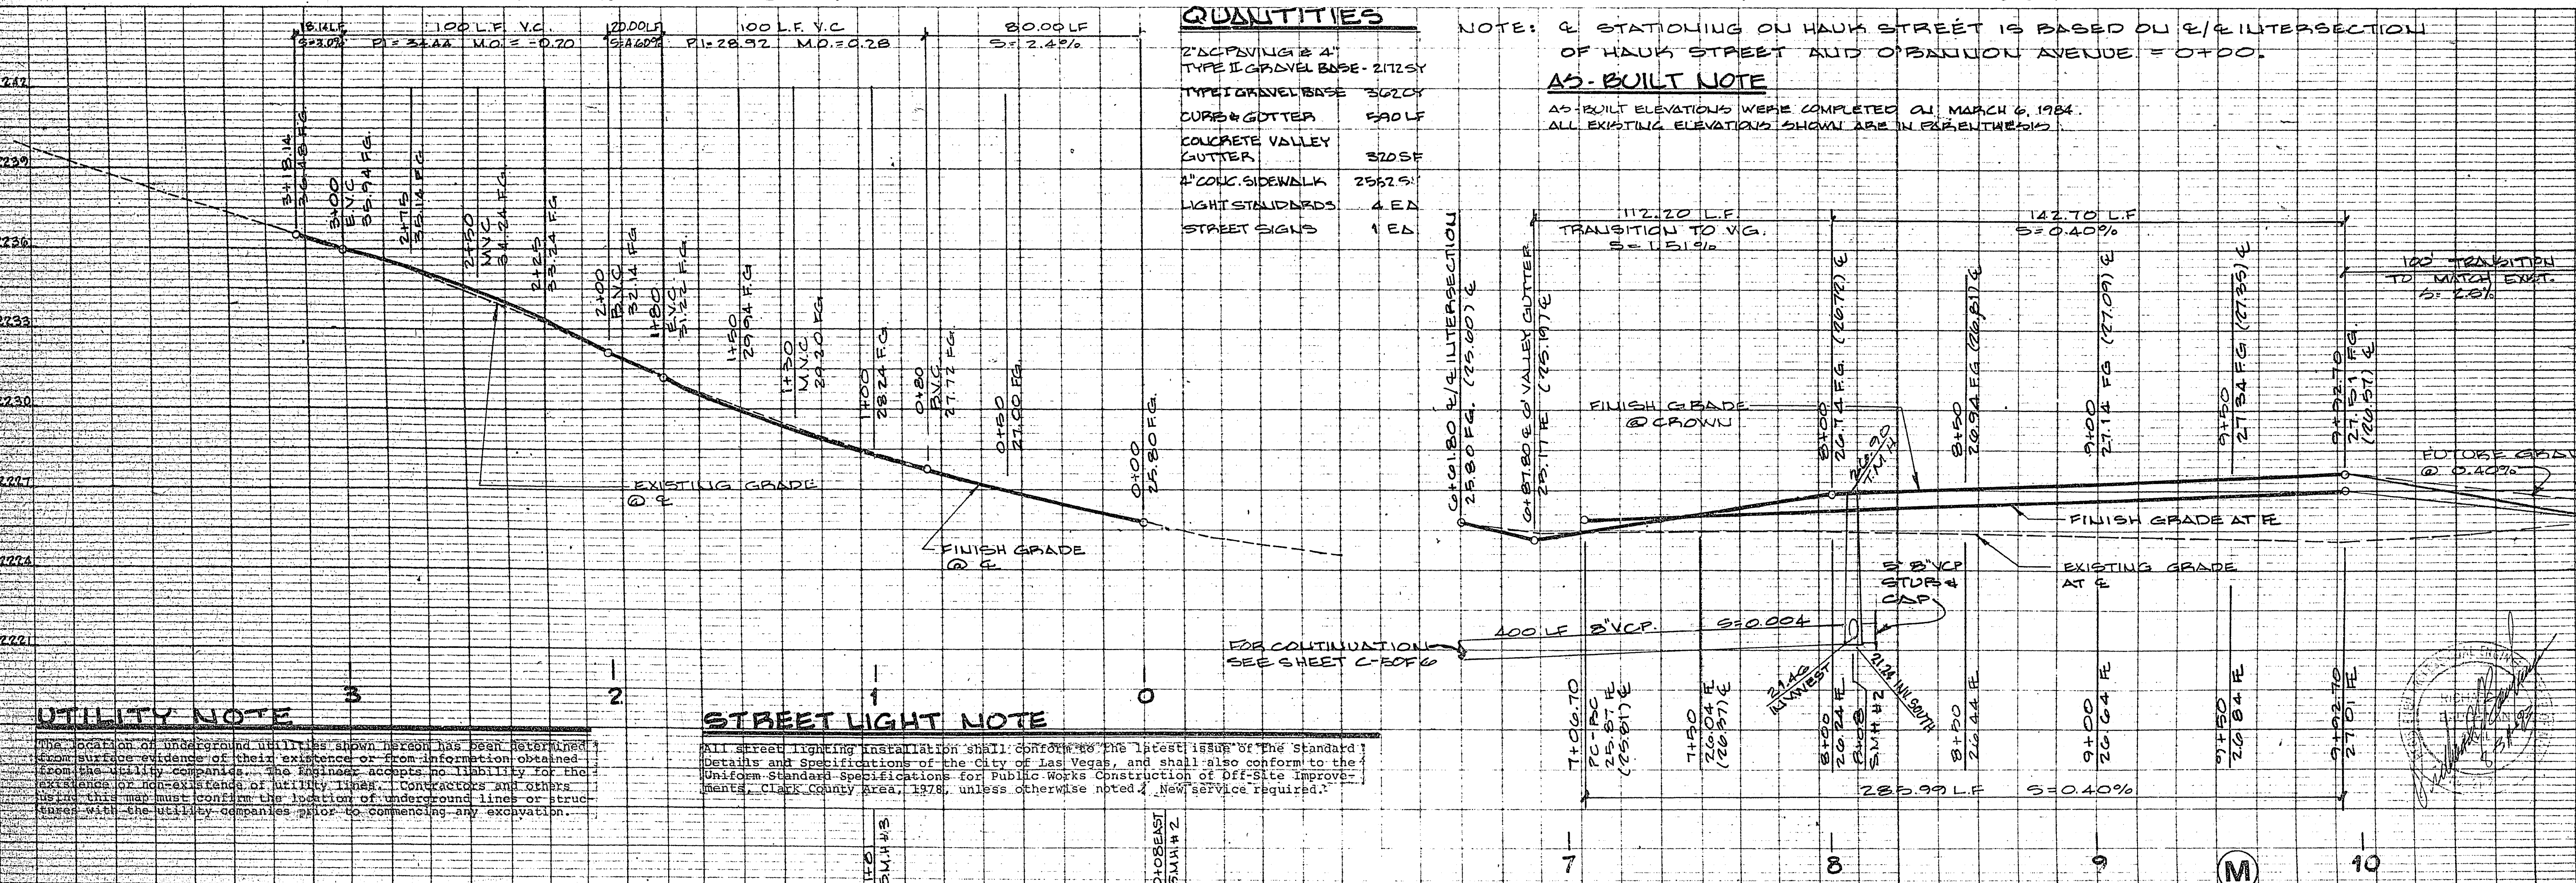

UTILITY NOTE

The location of underground utilities shown herein has been determined from surface evidence of their existence or from information obtained from the utility companies. The Engineer accepts no liability for the existence or non-existence of utility lines. Contractors and others using this map must confirm the location of underground lines or structures with the utility companies prior to commencing any excavation.

STREET LIGHT NOTE

All street lighting installation shall conform to the latest issue of the Standard Details and Specifications of the City of Las Vegas, and shall also conform to the Uniform Standard Specifications for Public Works Construction of Dr-Site Improvements, Clark County Area, 1978, unless otherwise noted. New service required.

RON TIBERTI

DATE AUGUST 1982
DESIGN CAP & GOLF
DRAWN BY
CHECK
LAS VEGAS, NEVADA
8702

BAUGHMAN & TURNER
MINING ENGINEERS
CIVIL ENGINEERS

STREET & STREET LIGHT DESIGN
A PORTION WITHIN THE N.W. 1/4 OF T.1E S.24E OF SECTION 11, TOWNSHIP 21 SOUTH, RANGE 61 EAST, M.D. 114N, CITY OF LAS VEGAS, CLARK COUNTY, NEVADA.

SHEET
PROJ. NO.
FB 141-P49-52