


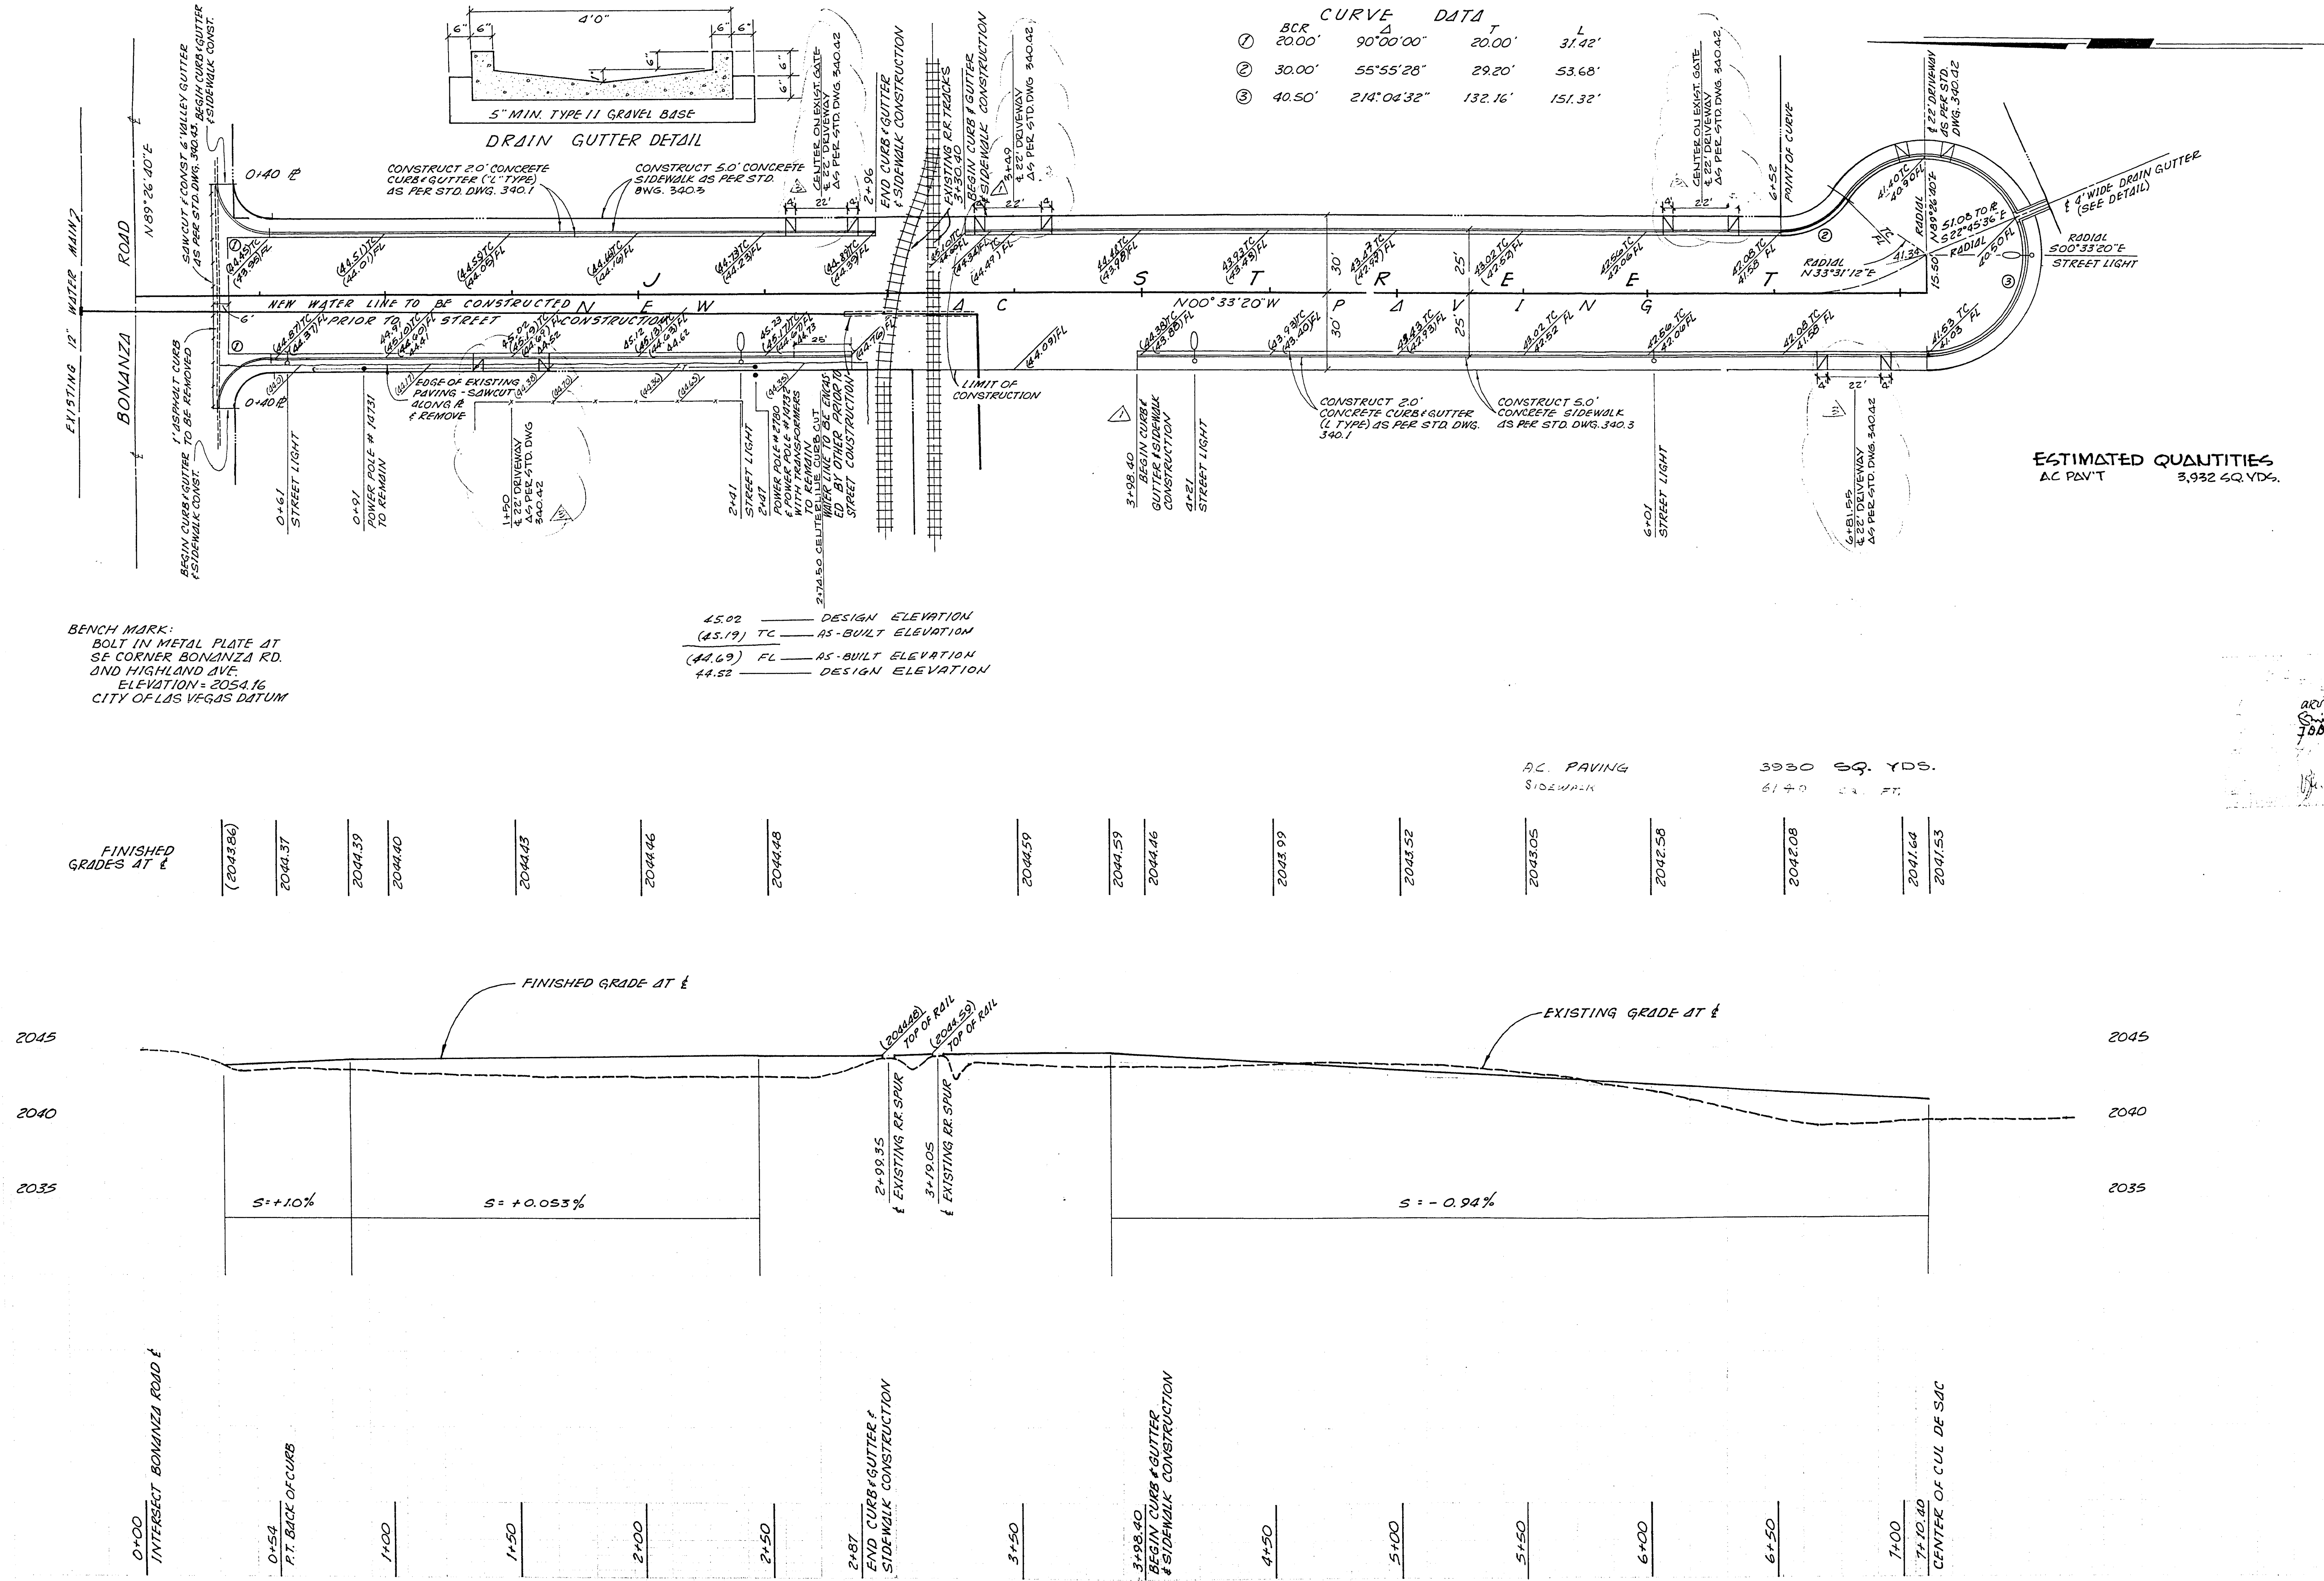

CURVE DATA				
BCR	Δ	T	L	
1 20.00'	90°00'00"	20.00'	31.42'	
2 30.00'	55°55'28"	29.20'	53.68'	
3 40.50'	214°04'32"	132.16'	151.32'	

BENCH MARK:
BOLT IN METAL PLATE AT
SE CORNER BONANZA RD.
AND HIGHLAND AVE.
ELEVATION = 2054.16
CITY OF LAS VEGAS DATUM

25.02 ——— DESIGN ELEVATION
(25.19) TC ——— AS-BUILT ELEVATION
(24.69) FL ——— AS-BUILT ELEVATION
24.52 ——— DESIGN ELEVATION

ESTIMATED QUANTITIES
AC PAV'T 3,932 SQ. YDS.
SIDEWALK 61 ± 0 ± 0 FT.

STREET DESIGN		LEAVITT & ASSOCIATES CONSULTING ENGINEERS • LAND SURVEYORS 596 EAST SAGHARA AVENUE LAS VEGAS, NEVADA PHONE 735-0280	SCALE HORIZ 1"=30' VERT 1"=5'	DATE 11-29-70
J STREET		DESIGNED BY: [Signature] CHECKED BY: [Signature]		
A PORTION OF THE SW 1/4 SEC 4 SECTION 28, TOWNSHIP 20 SOUTH, RANGE 61 EAST CITY OF LAS VEGAS		M.D.M.	NEVADA	DATE 11-29-70
APPROVALS		CITY ENGINEER [Signature]	DISTRICT ENGINEER [Signature]	DATE 11-29-70
REVISIONS		1. 11-23-69 (REMOVE DRIVE- WAY CURB) & REDSIGN NEW RR SPUR	2. 12-00-69 (REMOVE PROPOSED RR SPUR)	
		DWG - 69-101	SHT. 2 OF 4	