


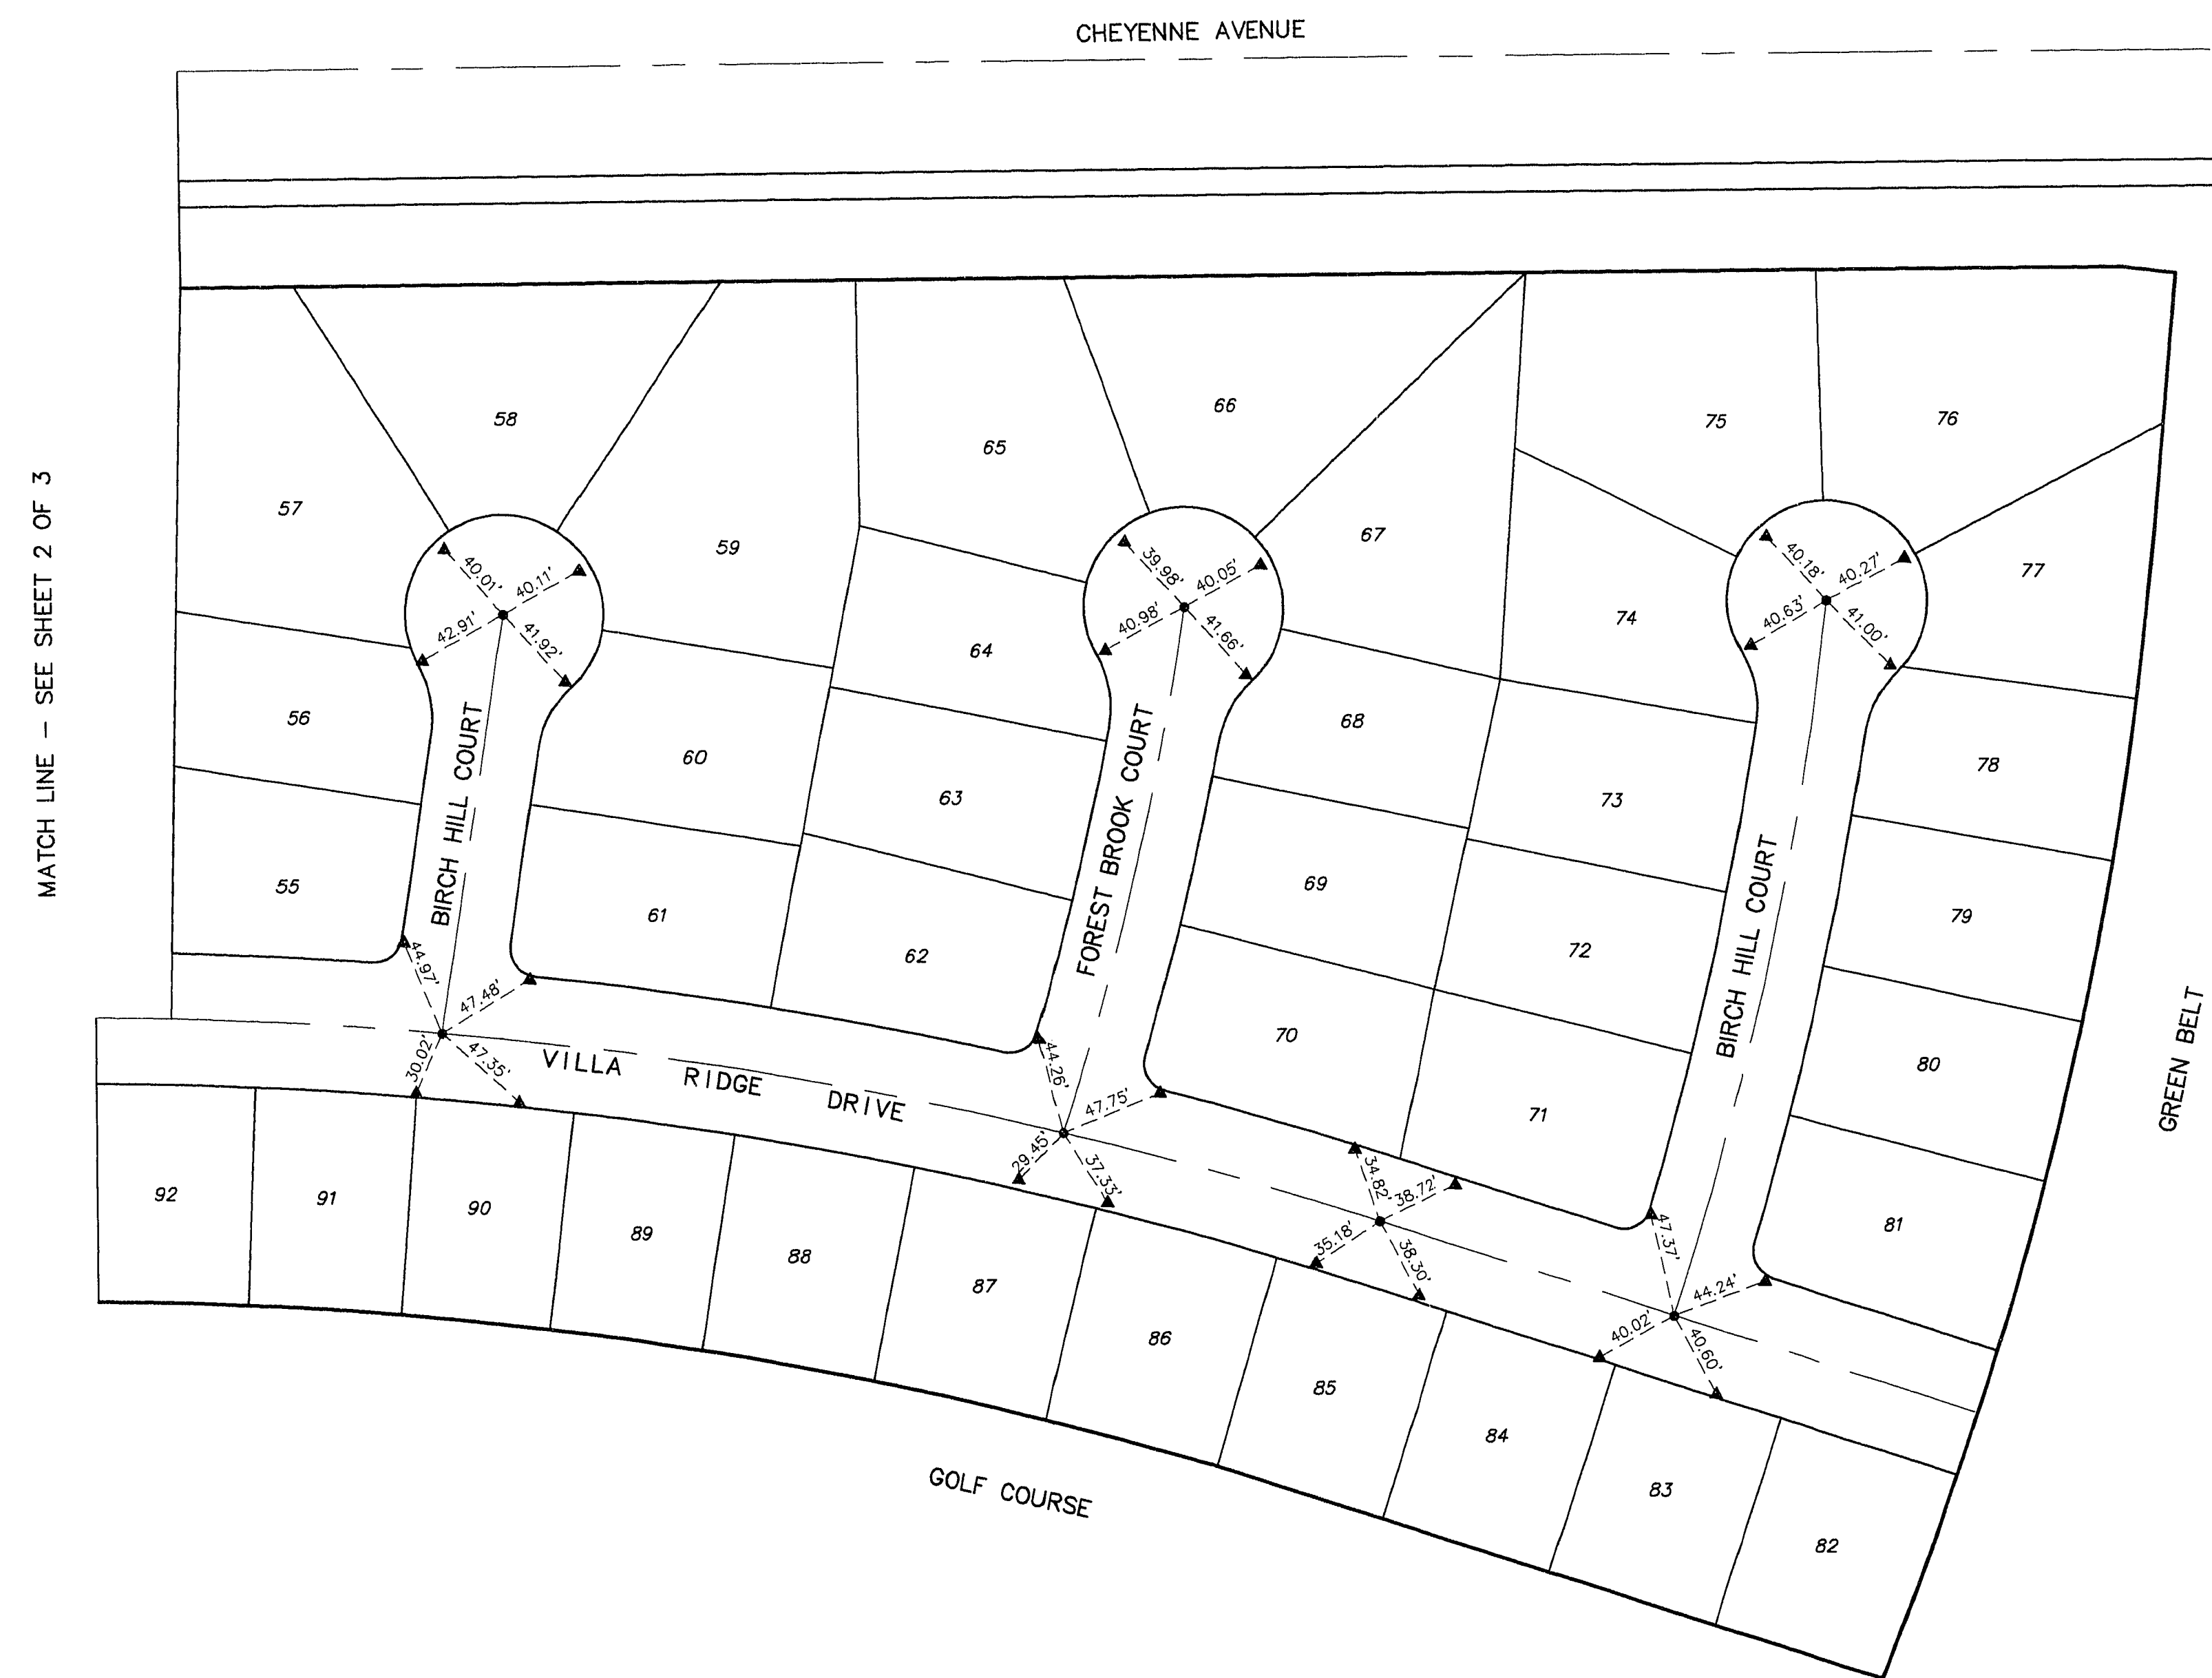

10-6-144