

DEPARTMENT OF PUBLIC WORKS



Mayor:
JAN LAVERTY JONES

Councilmen:
ARNIE ADAMSEN
MICHAEL J. McDONALD
GARY REESE
LARRY BROWN

City Manager:
LARRY K. BARTON

Director of Public Works:
RICHARD D. GOECKE







City Engineer:
DENNIS ANDERSON, P.E.

FUNDED BY:


CITY OF LAS VEGAS—
REDEVELOPMENT AGENCY

SUN PLAZA UTILITIES RELOCATION IMPROVEMENTS

REVIEWED BY:

	3-12-98
CITY ENGINEER	DATE
	2/11/98
NEVADA POWER COMPANY	DATE
	3/3/98
SOUTHWEST GAS CORPORATION	DATE
	3-10-98
LAS VEGAS VALLEY WATER DISTRICT	DATE
	3-10-98
SPRINT TELEPHONE	DATE
	2/9/98
PRIME CABLE	DATE
AMERICAN COMMUNICATION SERVICES INC.	DATE

SCALE (V) N/A
SCALE (H) N/A
FLD. BK. # N/A
W.A. #
DESIGN BY
ENGINEERING DESIGN SECTION
CITY ENGINEER: DENNIS ANDERSON, P.E.
PROJECT MANAGER: DENNIS ATWOOD, P.E.

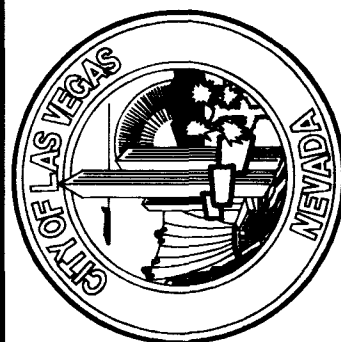

DEPARTMENT OF PUBLIC WORKS
PROJECT: SUN PLAZA
UTILITIES RELOCATION
IMPROVEMENTS

SHEET: BID No. 98.1730.33
COVER SHEET

DRAWING NO.
307-V762
1/8

L:\DEPT\DESIGN\SunPlaza\BIDDING\DWG - REV Jan 28 11:25:43 1998 - EMEYER

AS BUILT

