


T.21S, R.61E, M.D.B.&M.

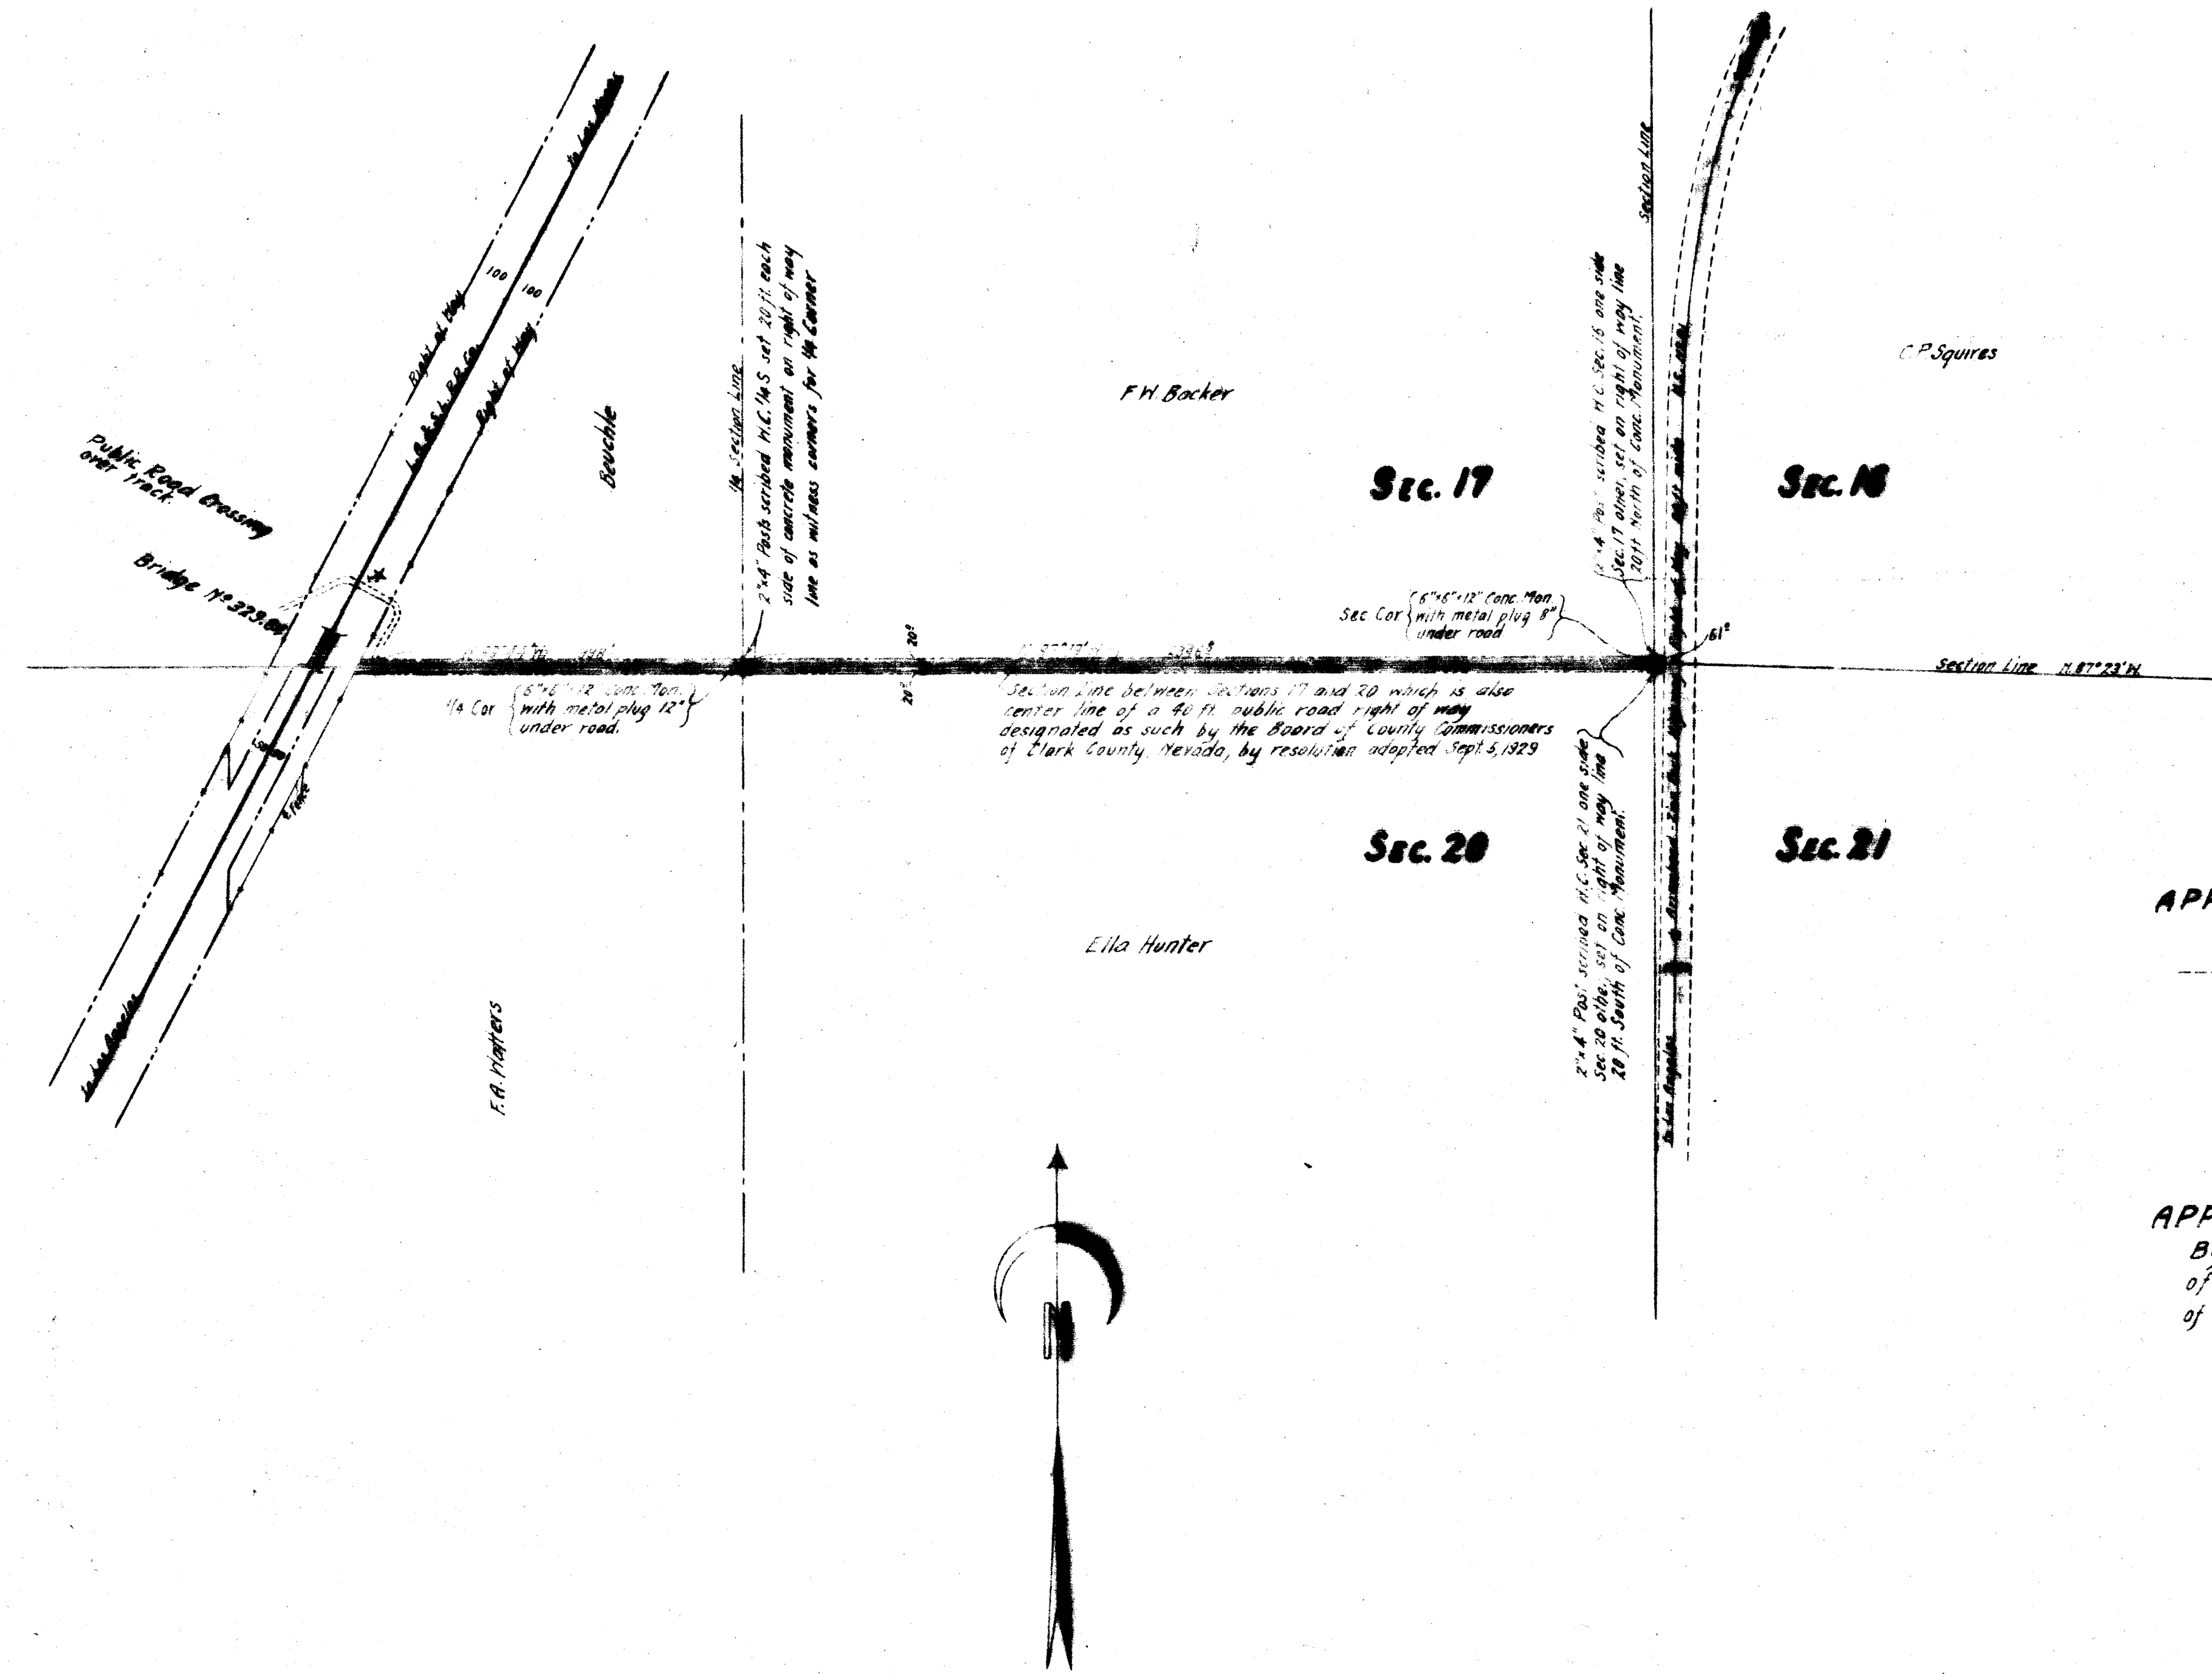

I, Arthur R. Thompson, a Civil Engineer, hereby certify that this plat represents an accurate survey, made by me, of the right of way for a public road as designated by the Board of Commissioners of Clark County, Nevada, by resolution adopted September 5, 1929 at a regular meeting of the board.

Arthur R. Thompson
Civil Engineer

At the South 1/4 Corner of Sec. 17 there was found a 2"x4" post scribed 1/4 S, in a small rock mound. While this was not an original government corner, it has been used for some time in establishing land boundaries in this vicinity and was accepted as the 1/4 corner and replaced with a concrete monument and witness posts as shown hereon.

At the location of the corner common to Sections 16, 17, 20, and 21 nothing was found to indicate a corner and this corner was established as follows; the north line of section 21 from the N 1/4 Corner west through a 1/4 corner, which had been established, was produced west to an intersection with a line run between the west 1/4 corner of Sec. 16 and the west 1/4 corner of Sec. 21 and at this point a concrete monument and witness posts were set as shown hereon. This location is in accordance with lines as run by the State Highway Department. Bearings of lines were established by direct solar observation.

APPROVED.

County Road Supervisor


APPROVED.

By the Board of County Commissioners of Clark County, Nevada, this day of February, 1930.

E. G. M. J. Jr.
Chairman of Board
Wm. L. Scott
Clerk

PUBLIC ROAD
SOUTH LINE SECTION 17 T.21S, R.61E, M.D.B.&M.
DESIGNATED BY BOARD OF COUNTY COMMISSIONERS
CLARK COUNTY NEVADA
Scale 1"=300' January 28, 1930

THIS RELEASE

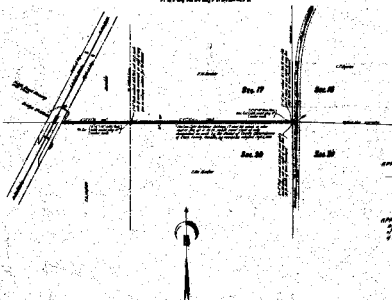

2. *Order of Disposal*. - a. *Old Engines*. - In the early days the old gas engines were usually stored, and it was the rule of the day for a public road to be closed by the State of Massachusetts if that State should be required to adopt Federal law as to the matter of the road.

John A. Thompson
City Editor

In the South West corner of 22.7 there was found a 2' x 4' pit, oriented N-S, in a sand and gravel. While this was not an obvious prehistoric feature, it has been used for many years as a latrine and is abandoned in the vicinity and was accepted as the N corner and replaced with a concrete monument and reference stake in stone house.

in the vicinity of the upper summer residence at
1725 and is nothing, was found to indicate a corner
of a building, and the fact of a corner of a
building, from the old corner and through the
corner, which had been established as a principal
road to an intersection with a new road between the
upper corner of the lot and the main corner of
the lot and of the year a square monument and
yellow paint were set on stone corner. The building
is in accordance with that set over by the State
Highway Department, showing of the corner
indicated by direct angle observation.

APPENDIX

Study design

Abstract

By the Board of County Commissioners
of Clark County, Nevada, this _____ day
of February, 1988.

COPIES
10/10/10

PUBLIC ROAD

Santa Ana Section 17 T.21S, R.61E, M.D.B. #1

Exposure to Noise or Vibration Contaminants

CLARK GUN
and more

and the other

James P. Smith