


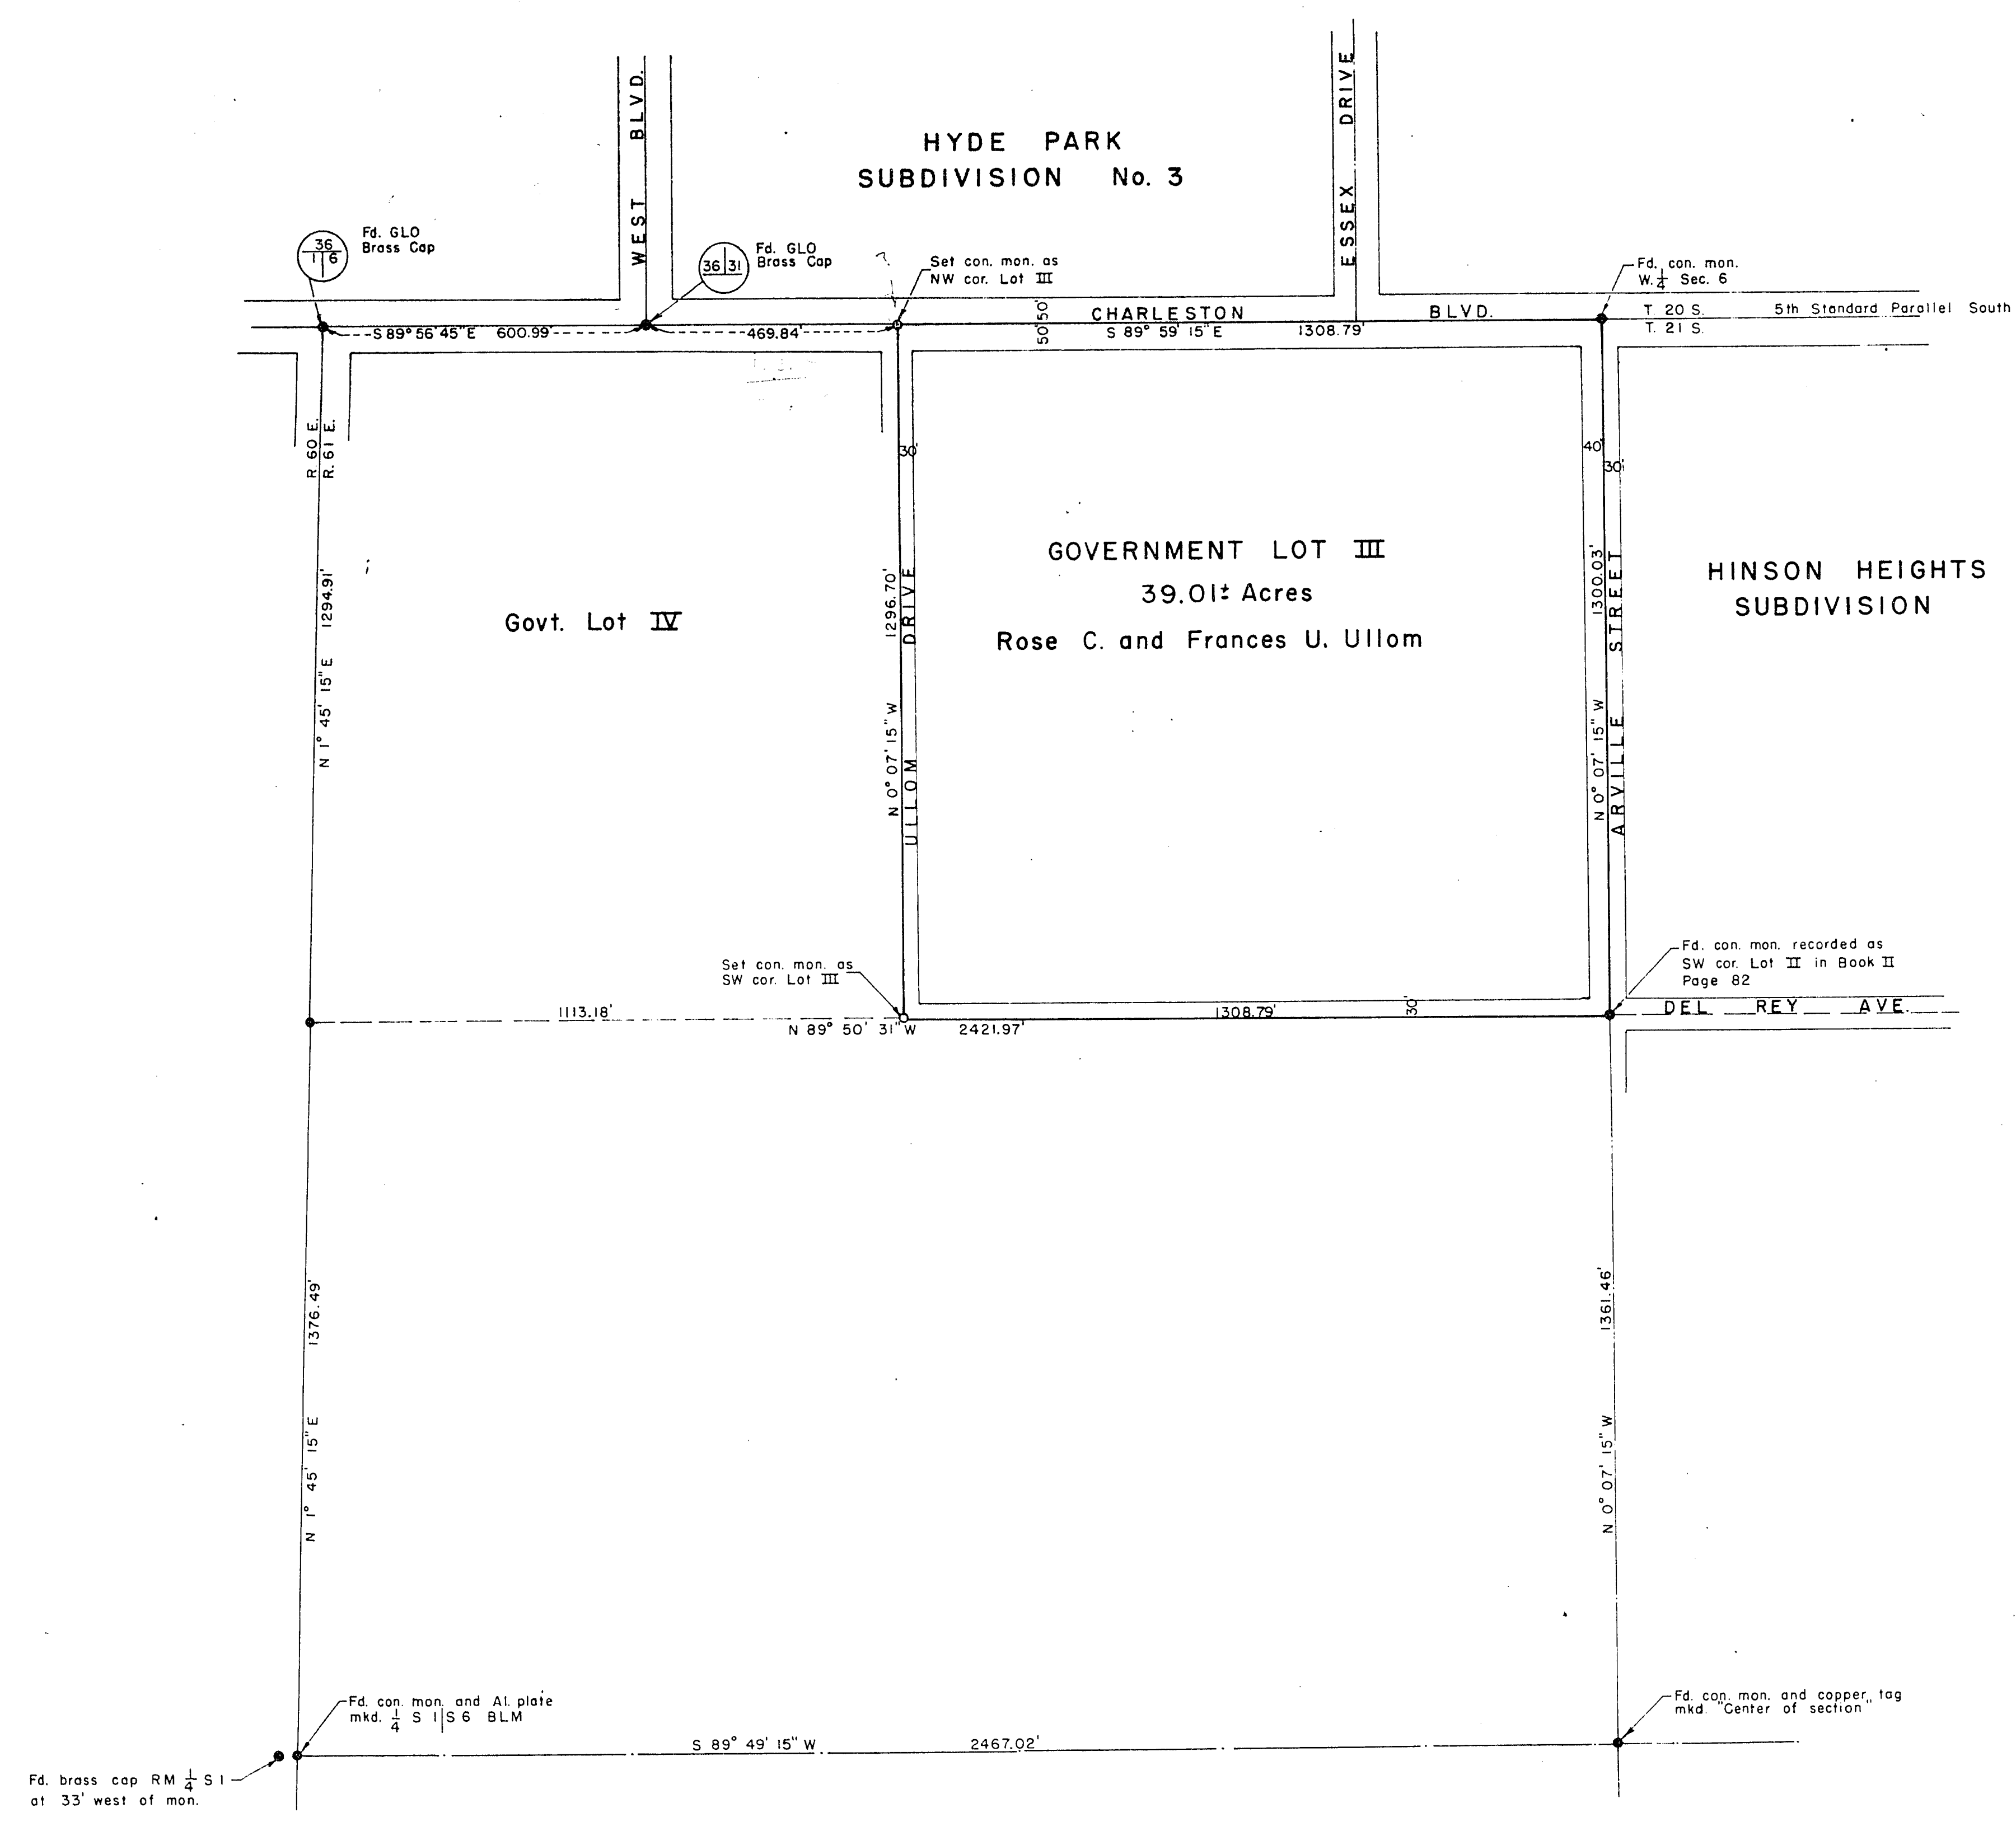


ENGINEER'S CERTIFICATE

I, Robert H. Cordill, Registered Professional Engineer, do hereby certify that this map is a true and accurate map of survey by me, of Government Lot III of Sec. 6, T. 21 S., R. 61 E., M. D. B. & M., at the instance of Rose C. and Frances U. Ullom, and completed April 8, 1955, and that the points found and the points set are correctly shown.

Robert H. Cordill
REGISTERED PROFESSIONAL ENGINEER No. 720
- LAND SURVEYOR -

BASIS OF BEARINGS: Record maps of HINSON HEIGHTS and HYDE PARK No. 3.

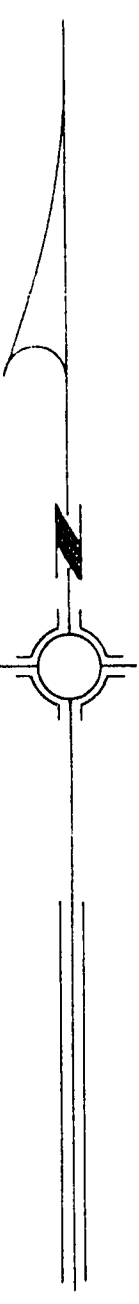

SCALE
1" = 200'

No. 48130
FILED AT REQUEST OF
ROBERT H. CORDILL
DATE 6-2-55 AT 4:01 P.M.
IN FILE 4-195-91
REG. PROF. ENGR. DRAWINGS
CLARK COUNTY NEVADA RECORDS
PAUL C. O'MALLEY, RECORDER
DEPUTY
FEE \$1.60 INDEXED

SURVEY OF GOVT. LOT III
SEC. 6, T. 21 S., R. 61 E., M. D. B. & M.
for
ROSE C. & FRANCES U. ULLOM

055-105

File 4 91