
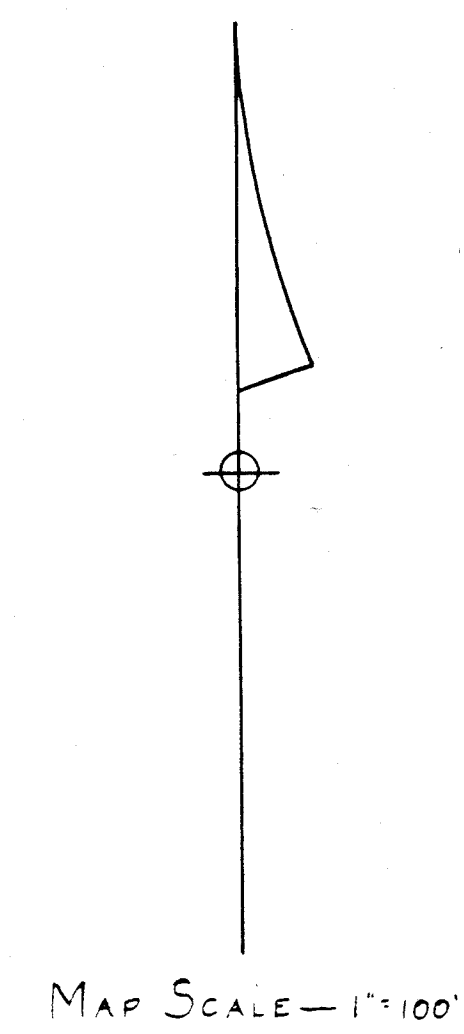


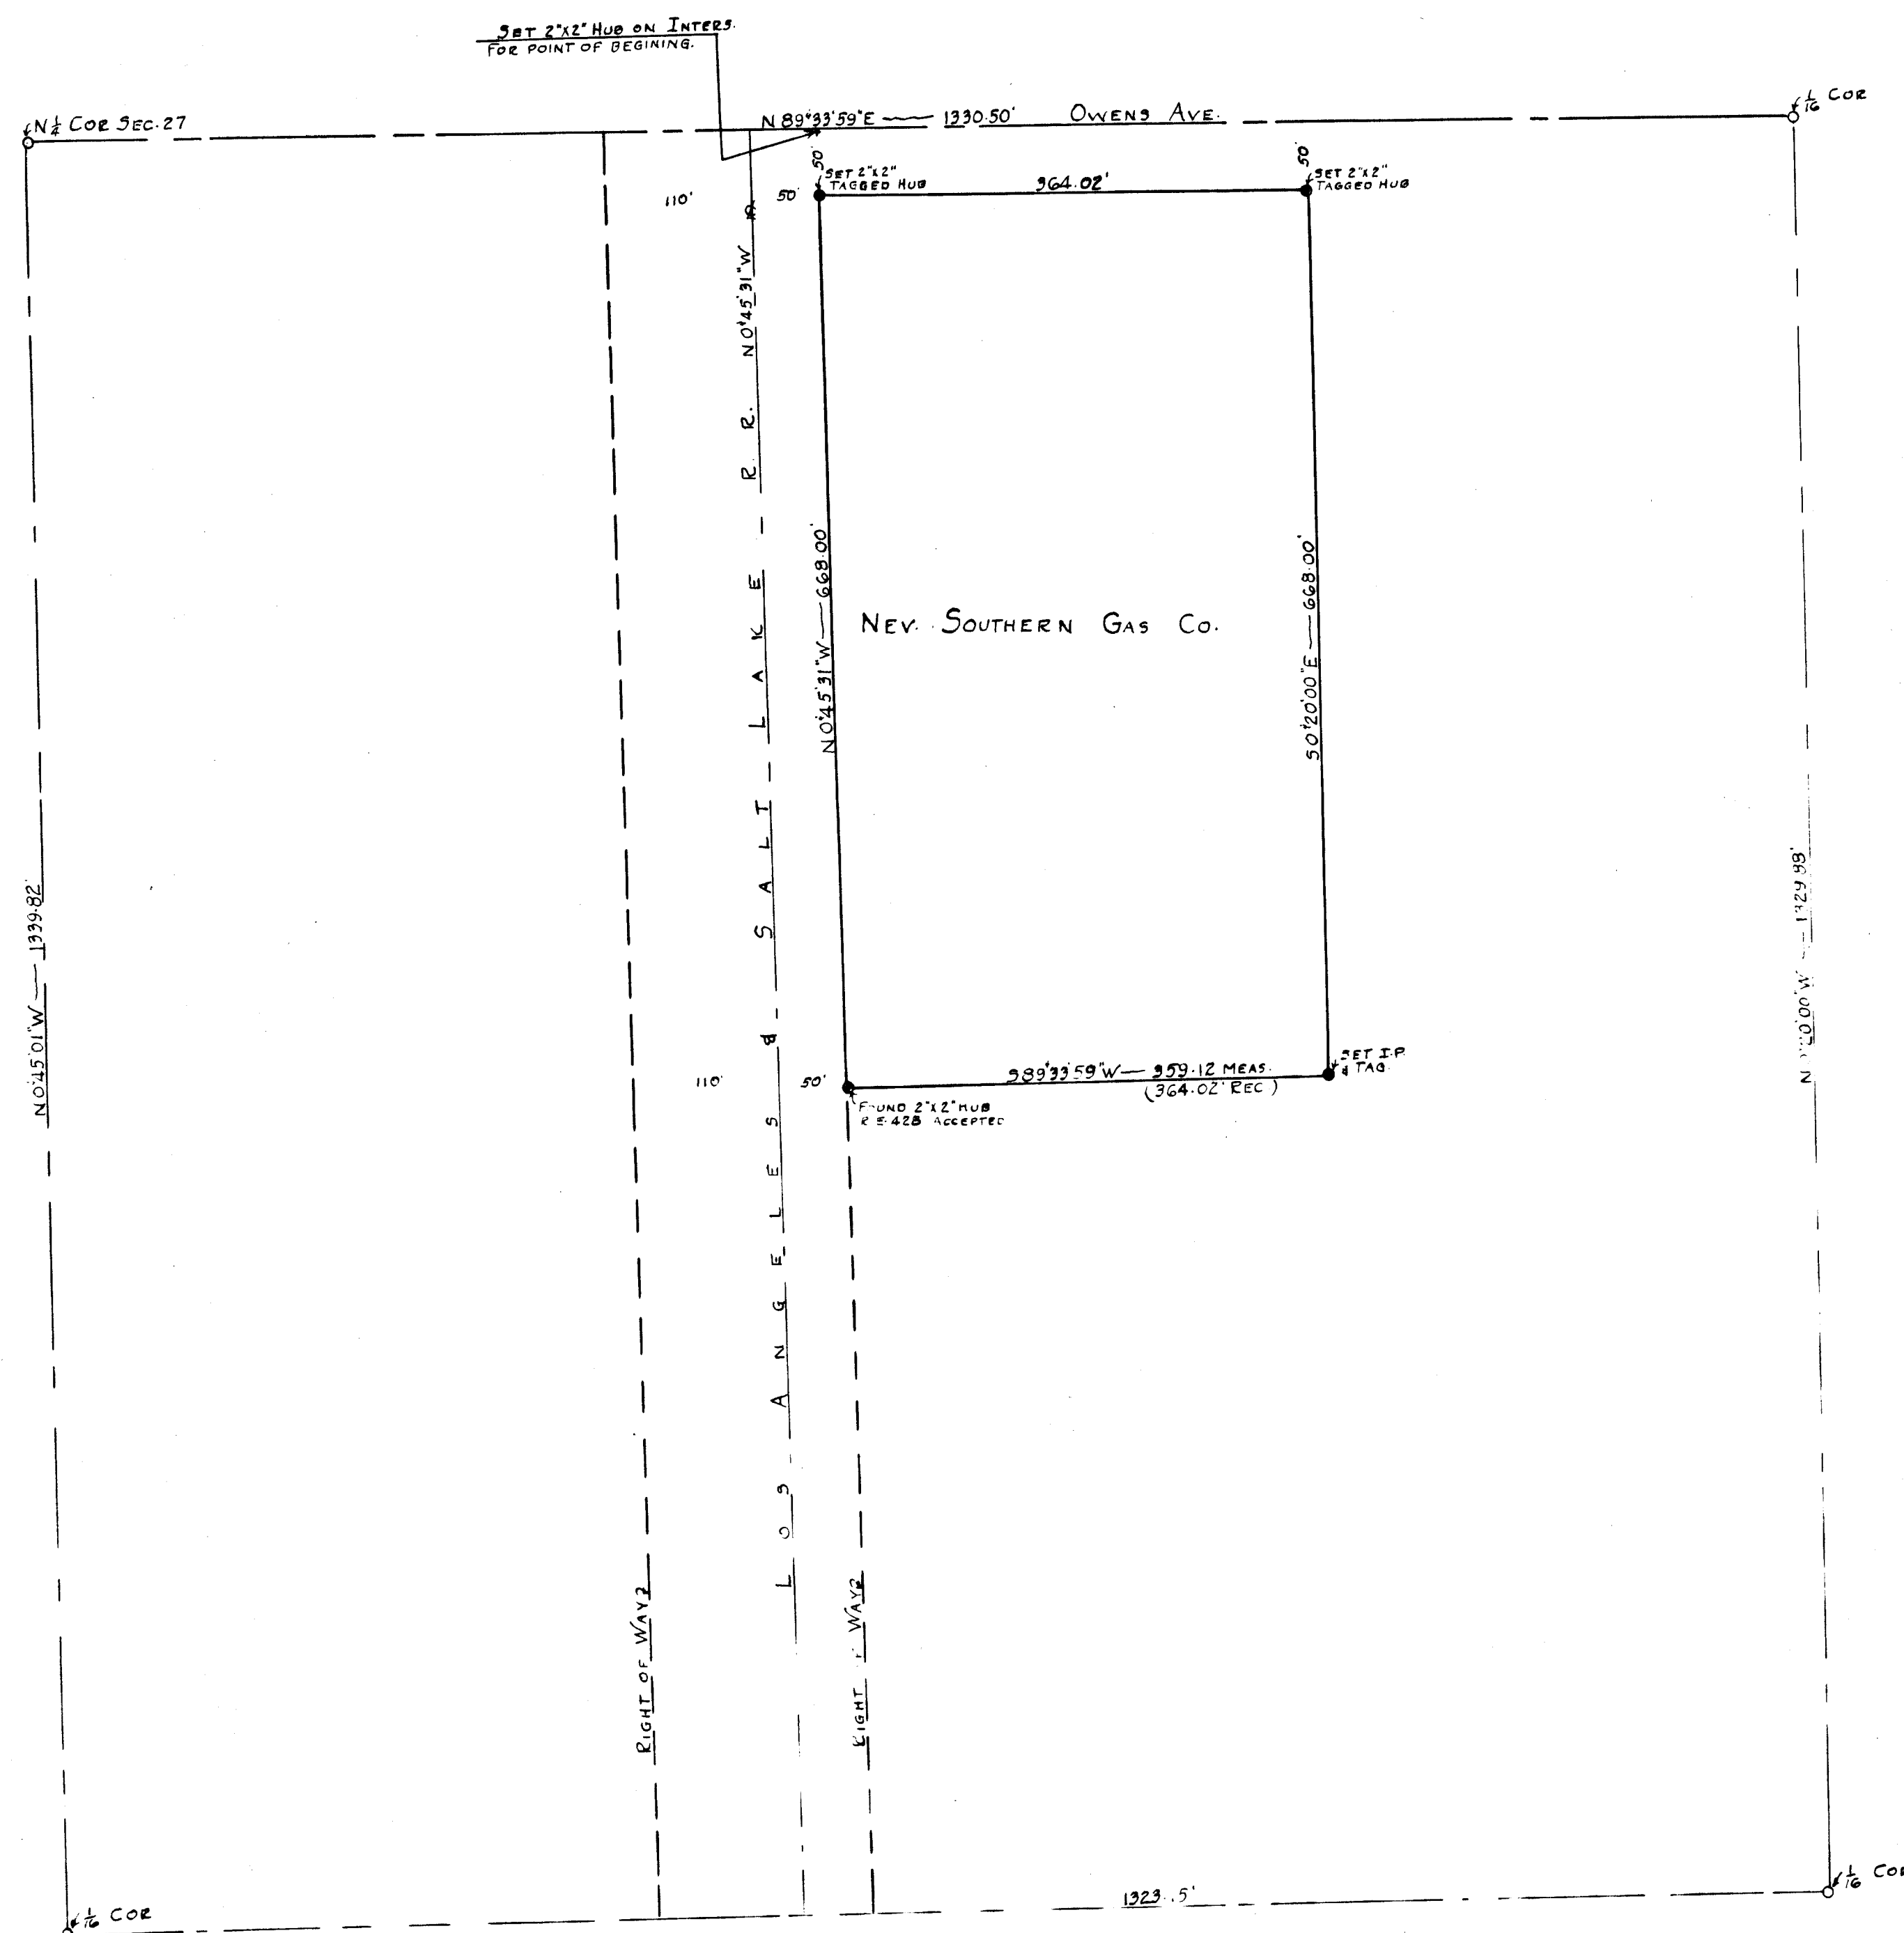

ENGINEERS CERTIFICATE

I JACK PARVIN A REGISTERED PROFESSIONAL ENGINEER AND LAND SURVEYOR IN THE STATE OF NEVADA DO HEREBY CERTIFY THAT I SURVEYED THE PARCEL OF LAND AS SHOWN ON THIS MAP AT THE INSTANCE OF THE NEV. SOUTHERN GAS CO. AND COMPLETED SAID SURVEY ON APRIL 14, 1956. THAT THIS AREA LIES WHOLLY IN THE NW 1/4 OF THE NE 1/4 OF SEC. 27, TOWNSHIP 20 SOUTH, RANGE 61 EAST, M. D. B. & M. DESCRIBED AS FOLLOWS:

BEGINNING AT THE INTERSECTION OF THE EAST LINE OF THE LOS ANGELES & SALT LAKE RAILROAD COMPANY RIGHT OF WAY WITH THE NORTH LINE OF THE SAID NW 1/4 OF NE 1/4, THENCE N 89° 33' 59" E ALONG THE NORTH LINE OF THE NW 1/4 OF NE 1/4 A DISTANCE OF 364.02' TO A POINT, THENCE S 01° 20' 00" E A DISTANCE OF 50.00' TO THE TRUE POINT OF BEGINNING, THENCE CONTINUING S 01° 20' E A DISTANCE OF 668.00', TO A POINT, THENCE S 89° 33' 59" W A DISTANCE OF 359.12' TO A POINT, (RECORD DIST. 364.02) THENCE N 04° 51' 31" W ALONG THE EAST LINE OF THE RAILROAD RIGHT OF WAY A DISTANCE OF 668.00' TO A POINT, THENCE N 89° 33' 59" E A DISTANCE OF 364.02' TO THE TRUE POINT OF BEGINNING.

Jack Parvin
REG. PROF. ENGR. & LAND SURVEYOR NO. 286

BEARING DATA

BASIS OF BEARING FOR THIS MAP IS THE BOUNDARY SURVEY OF THE NE 1/4 SEC. 27, T20S, R6E, M.D.B. & M. BY THE CITY OF LAS VEGAS AND FILED AS DRAWING NO A-5A-16.

75746
Jack Parvin
4-18-56 4:02P
6 6
Jack Parvin

RECORD OF SURVEY
— MAP —
FOR A PORTION
THE NW 1/4 OF THE NE 1/4
SEC 27, T20S, R6E
CLARK CO. NEV.