


PLAT


278910

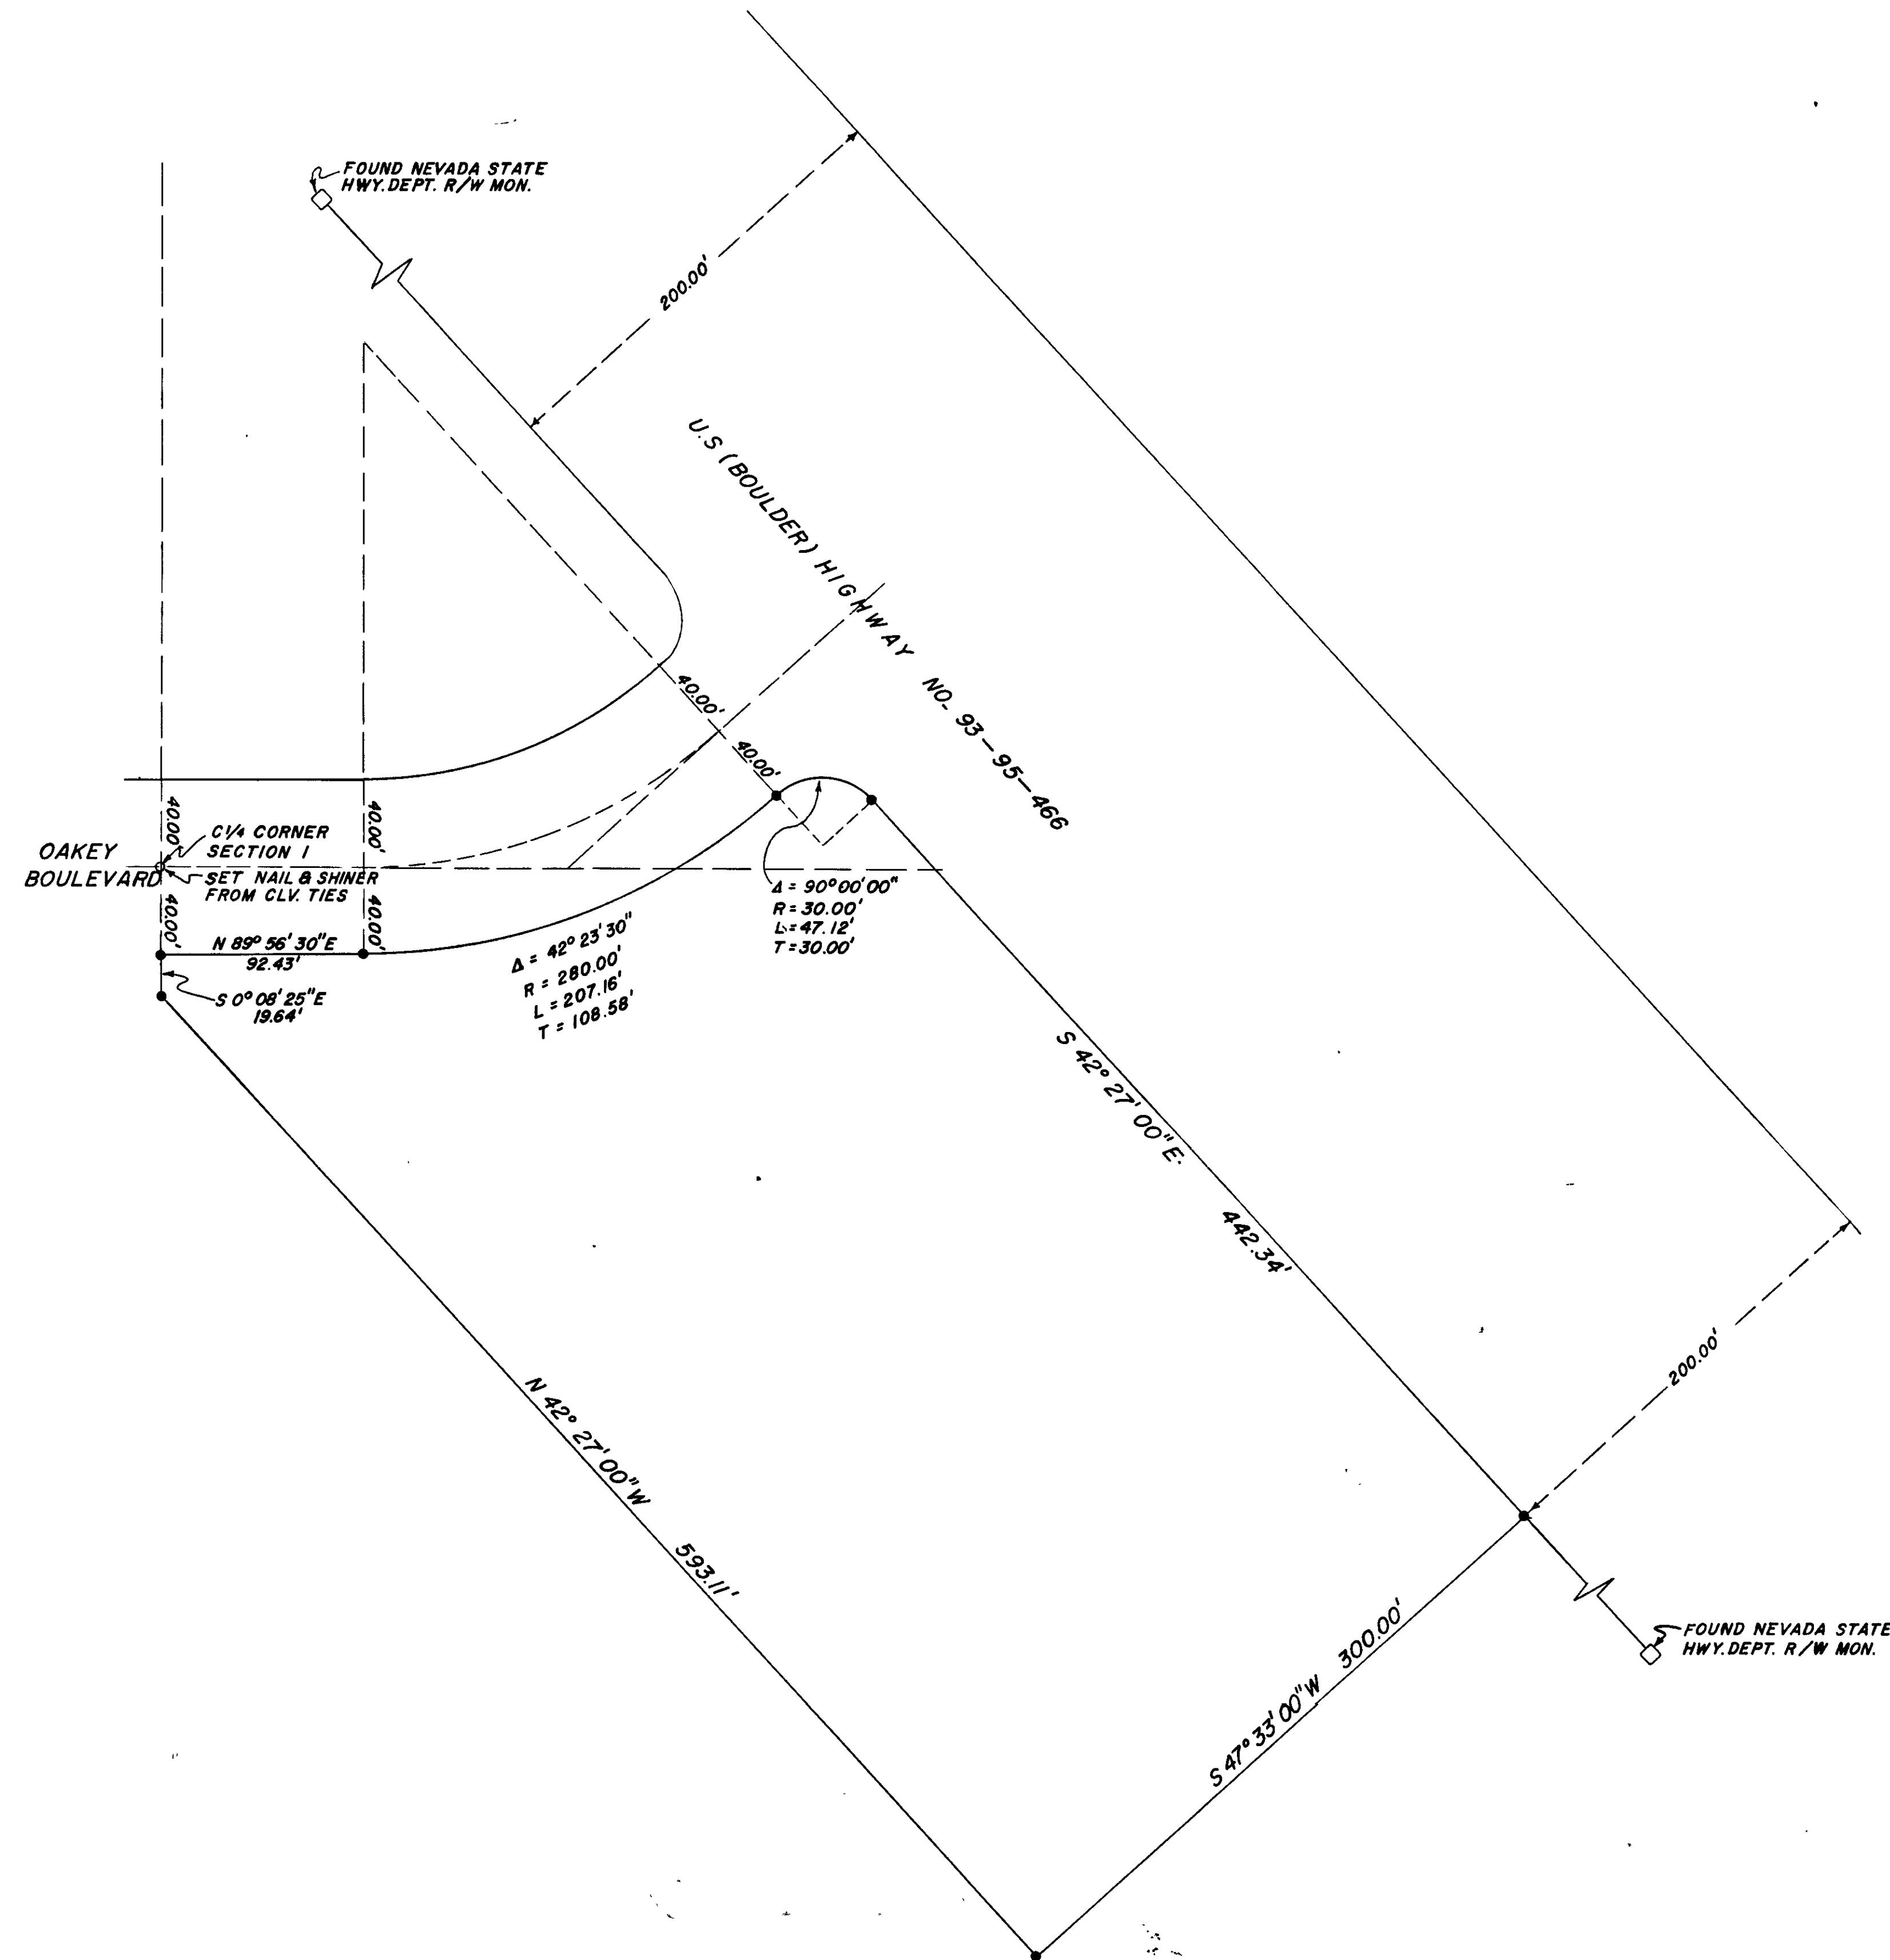

CERTIFICATE


I, Jack K. Leavitt, a registered professional engineer—land surveyor of the State of Nevada do hereby certify that this map is a true and accurate representation of the lands shown hereon. All points found or set are correctly designated. This survey was completed on Feb. 15, 1962 at the instance of Campbell Realty Company. This survey does not constitute a subdivision as defined by Nevada State laws.

Jack K. Leavitt
JACK K. LEAVITT
Registered professional engineer
land surveyor. RLS 807

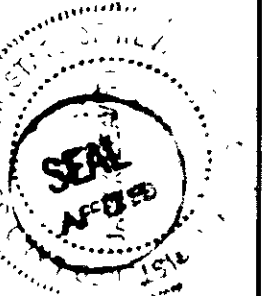

LEGEND

- Indicates point set— $\frac{3}{4}$ " iron pipe tagged RLS 807
 - o Indicates point found as shown.
- Scale : 1" = 50'
Basis of Bearings: US Highway 93-95-466 N42°27'00"W

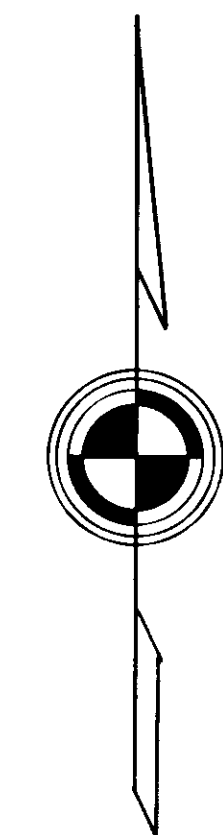

SURVEY MAP

PART SECTION 1, T.21S., R.61E.
M.D.B. & M.

CLARK COUNTY, NEVADA

Surveyed by JACK K. LEAVITT
Registered Professional Engineer
Land Surveyor RLS 807

NO. 278910
FILED AT THE REGISTRY OF
JACK K. LEAVITT
Date 2-27-62 at 2:37 PM
PL 11 5
OFFICE OF THE CLERK OF THE CLARK COUNTY, NEVADA
PAUL C. O'MALLEY, RECORDER
Fee \$2.50 J.K.L. Deput.