


10-26

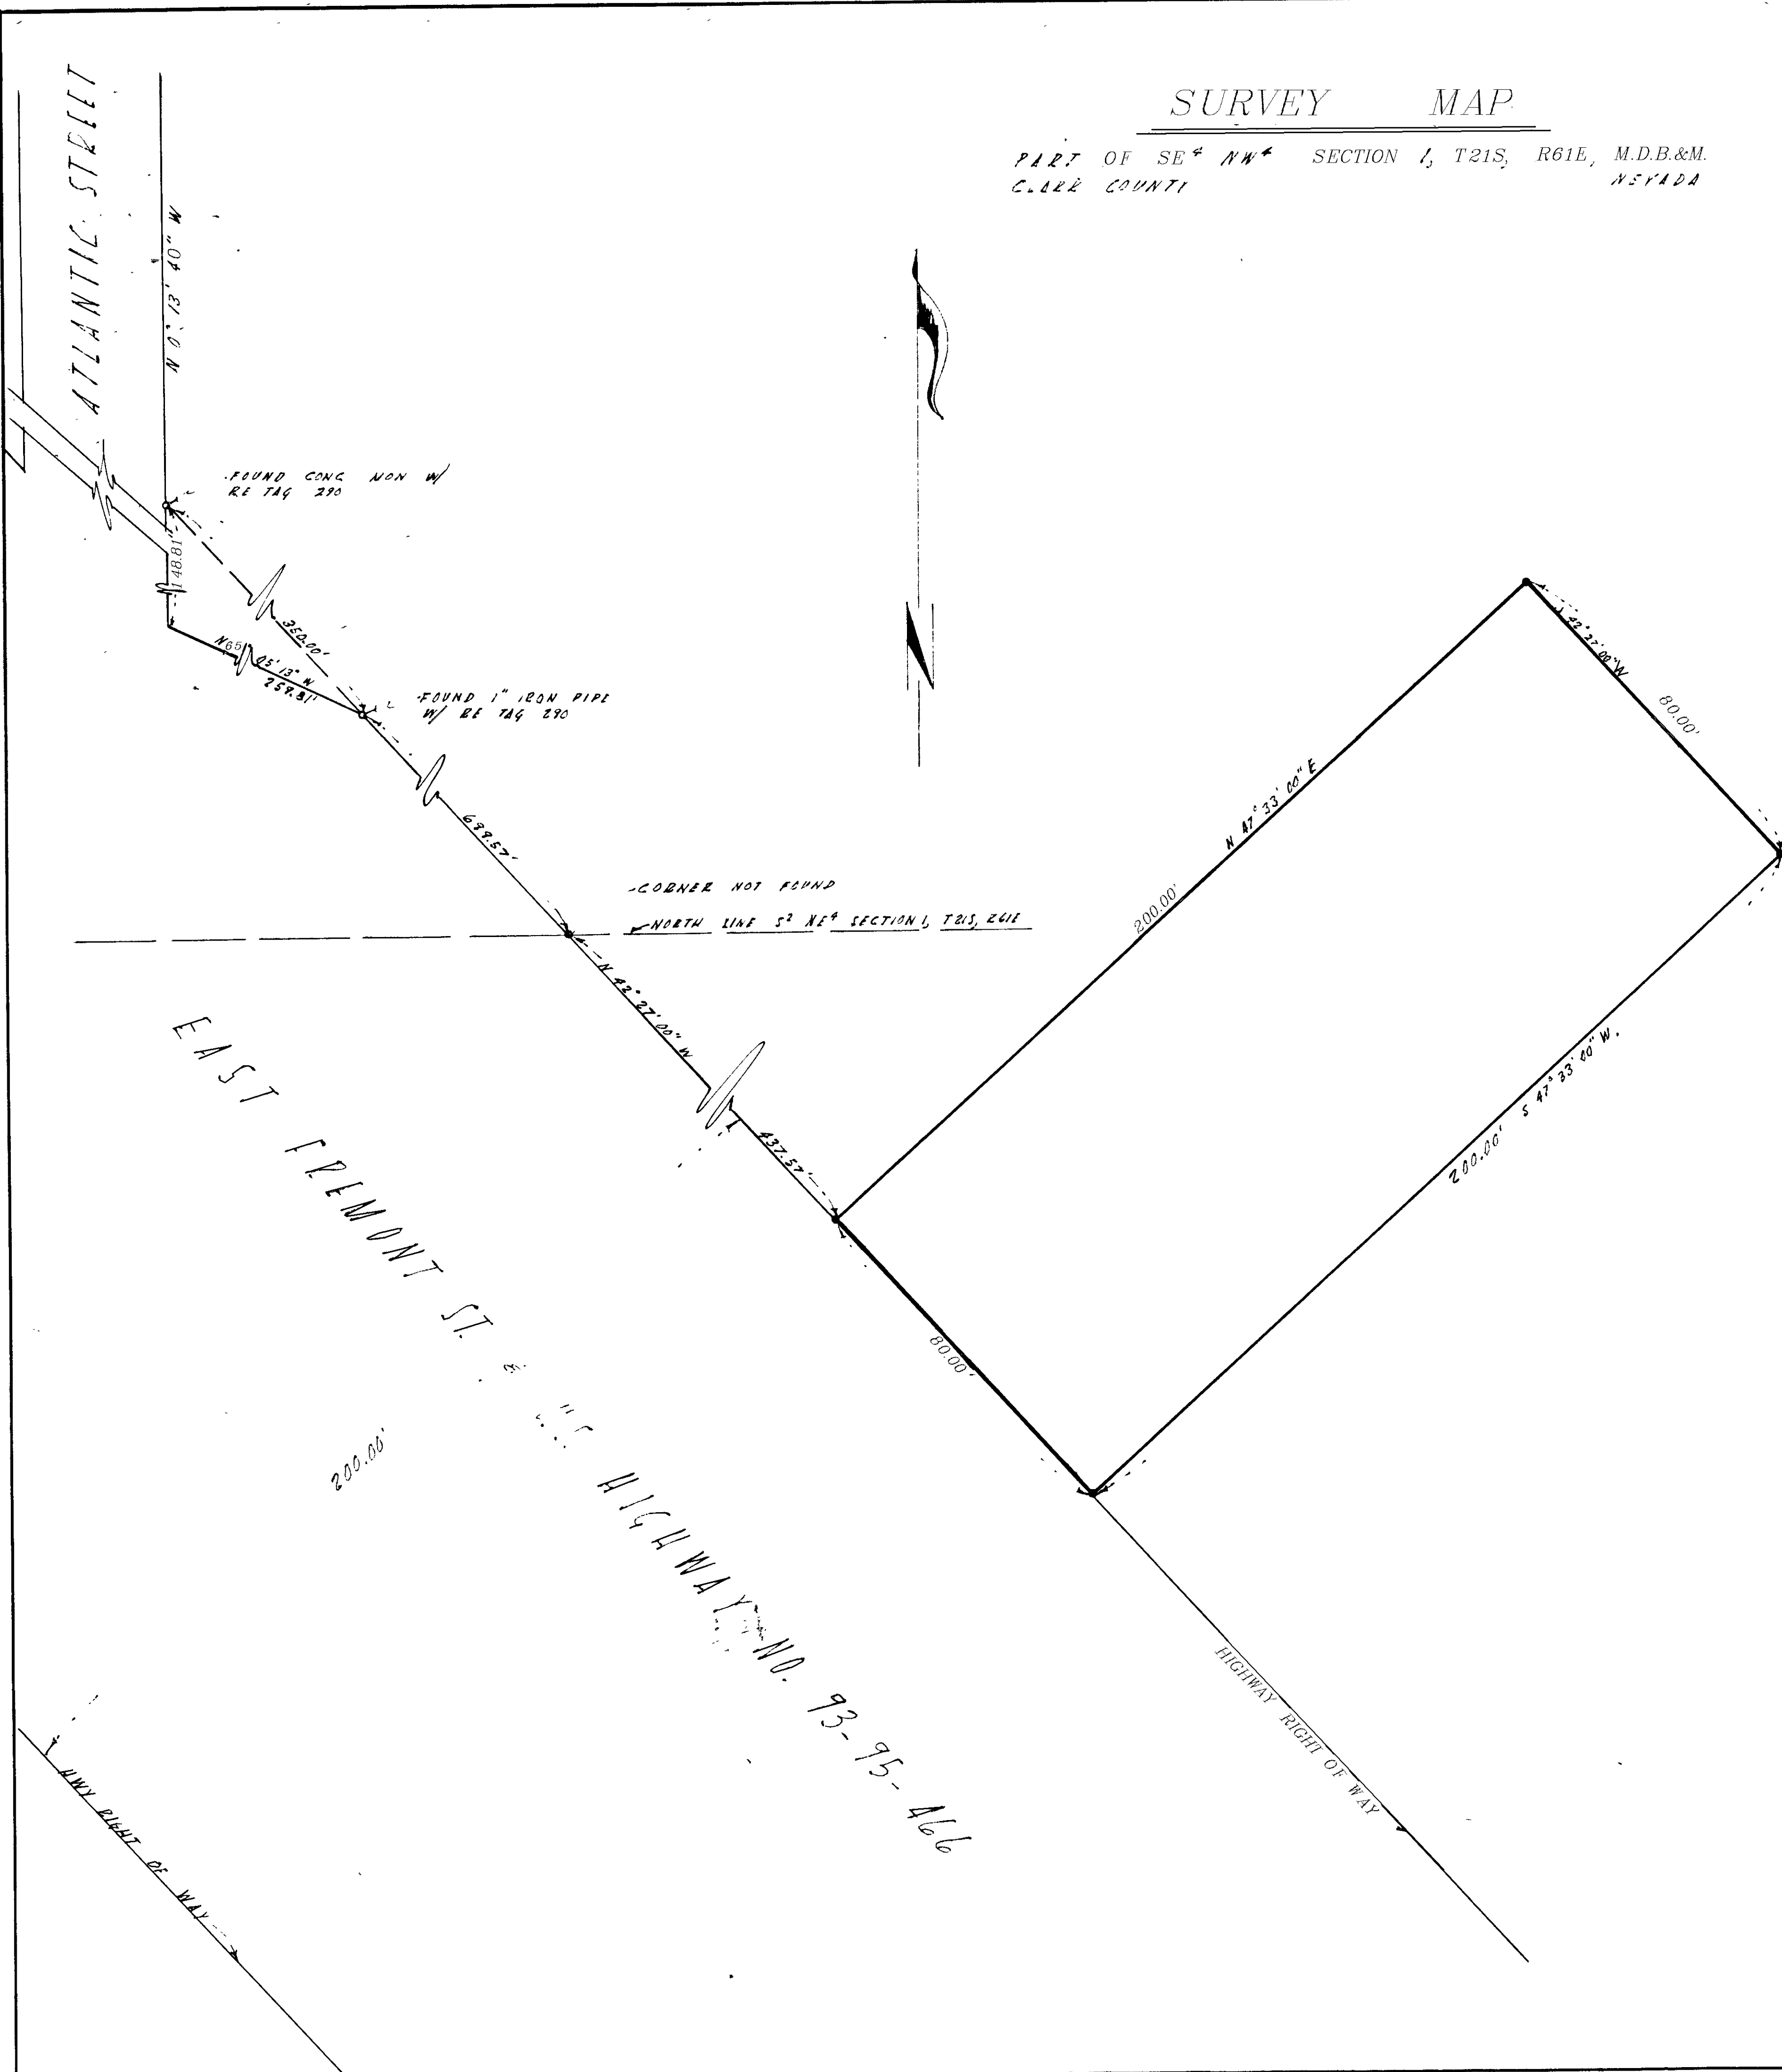


SURVEY MAP

PART OF SE⁴ NW⁴ SECTION 1, T21S, R61E, M.D.B.&M.
CLARK COUNTY NEVADA

CERTIFICATE

I, JACK K. LEAVITT, A REGISTERED PROFESSIONAL ENGINEER-LAND SURVEYOR OF THE STATE OF NEVADA DO HEREBY CERTIFY THAT THIS MAP IS A TRUE AND ACCURATE REPRESENTATION OF THE LANDS SHOWN HEREON. ALL POINTS FOUND OR SET ARE CORRECTLY DESIGNATED. THIS SURVEY WAS COMPLETED ON DECEMBER 13, 1961 AT THE INSTANCE OF M. D. CLOSE. THIS SURVEY DOES NOT CONSTITUTE A SUBDIVISION AS DEFINED BY NEVADA STATE LAW.

Jack K. Leavitt
JACK K. LEAVITT
REGISTERED PROFESSIONAL ENGINEER
LAND SURVEYOR ELS 807

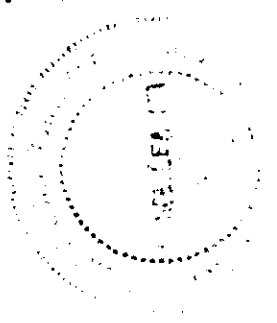

LEGEND

- INDICATES POINT SET - 3/4" IRON PIPE TAGGED ELS 807
- INDICATES POINT FOUND
- SCALE 1"= 20.00'
- BASIC OF BEARING: RPE FILE 5, P. 64

NOTE

THE PARCELS INDICATED HEREON ARE NOT DIVIDED FOR THE PURPOSE OF SALE AND DO NOT CONSTITUTE A SUBDIVISION AS DEFINED BY NEVADA STATE LAWS. THEREFORE, NO REFERENCE TO THIS MAP SHOULD BE MADE IN ANY DEED OR CONVEYANCE.

REFERENCE FILE

RPE FILE 5 PAGE 64

SURVEY MAP

PART OF SE⁴ NW⁴ SECTION 1, T21S, R61E
M.D.B.&M.
CLARK COUNTY NEVADA

JACK K. LEAVITT
1-2-62 3:54 P.M.
10 81
335
FARM & CATTLE RECORDER
FILE 5 259 P.E.H. Deputy

SURVEYED BY JACK K. LEAVITT
REGISTERED PROFESSIONAL ENGINEER
LAND SURVEYOR ELS 807