
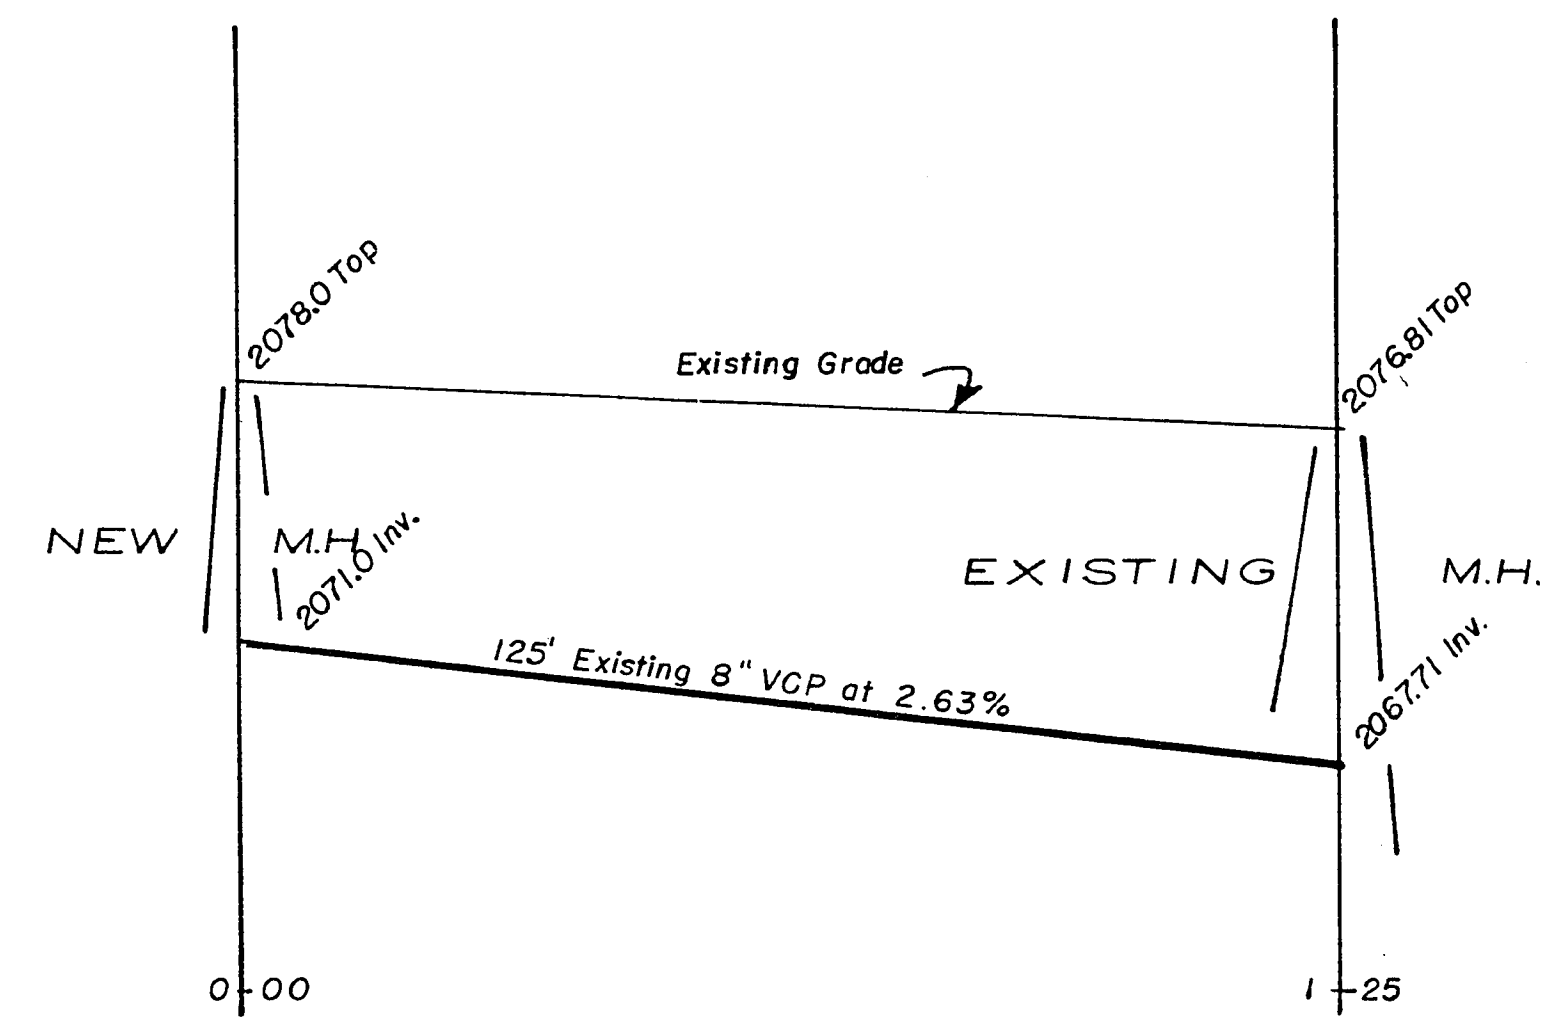


SAHARA

AVENUE

TEXACO SERVICE STATION

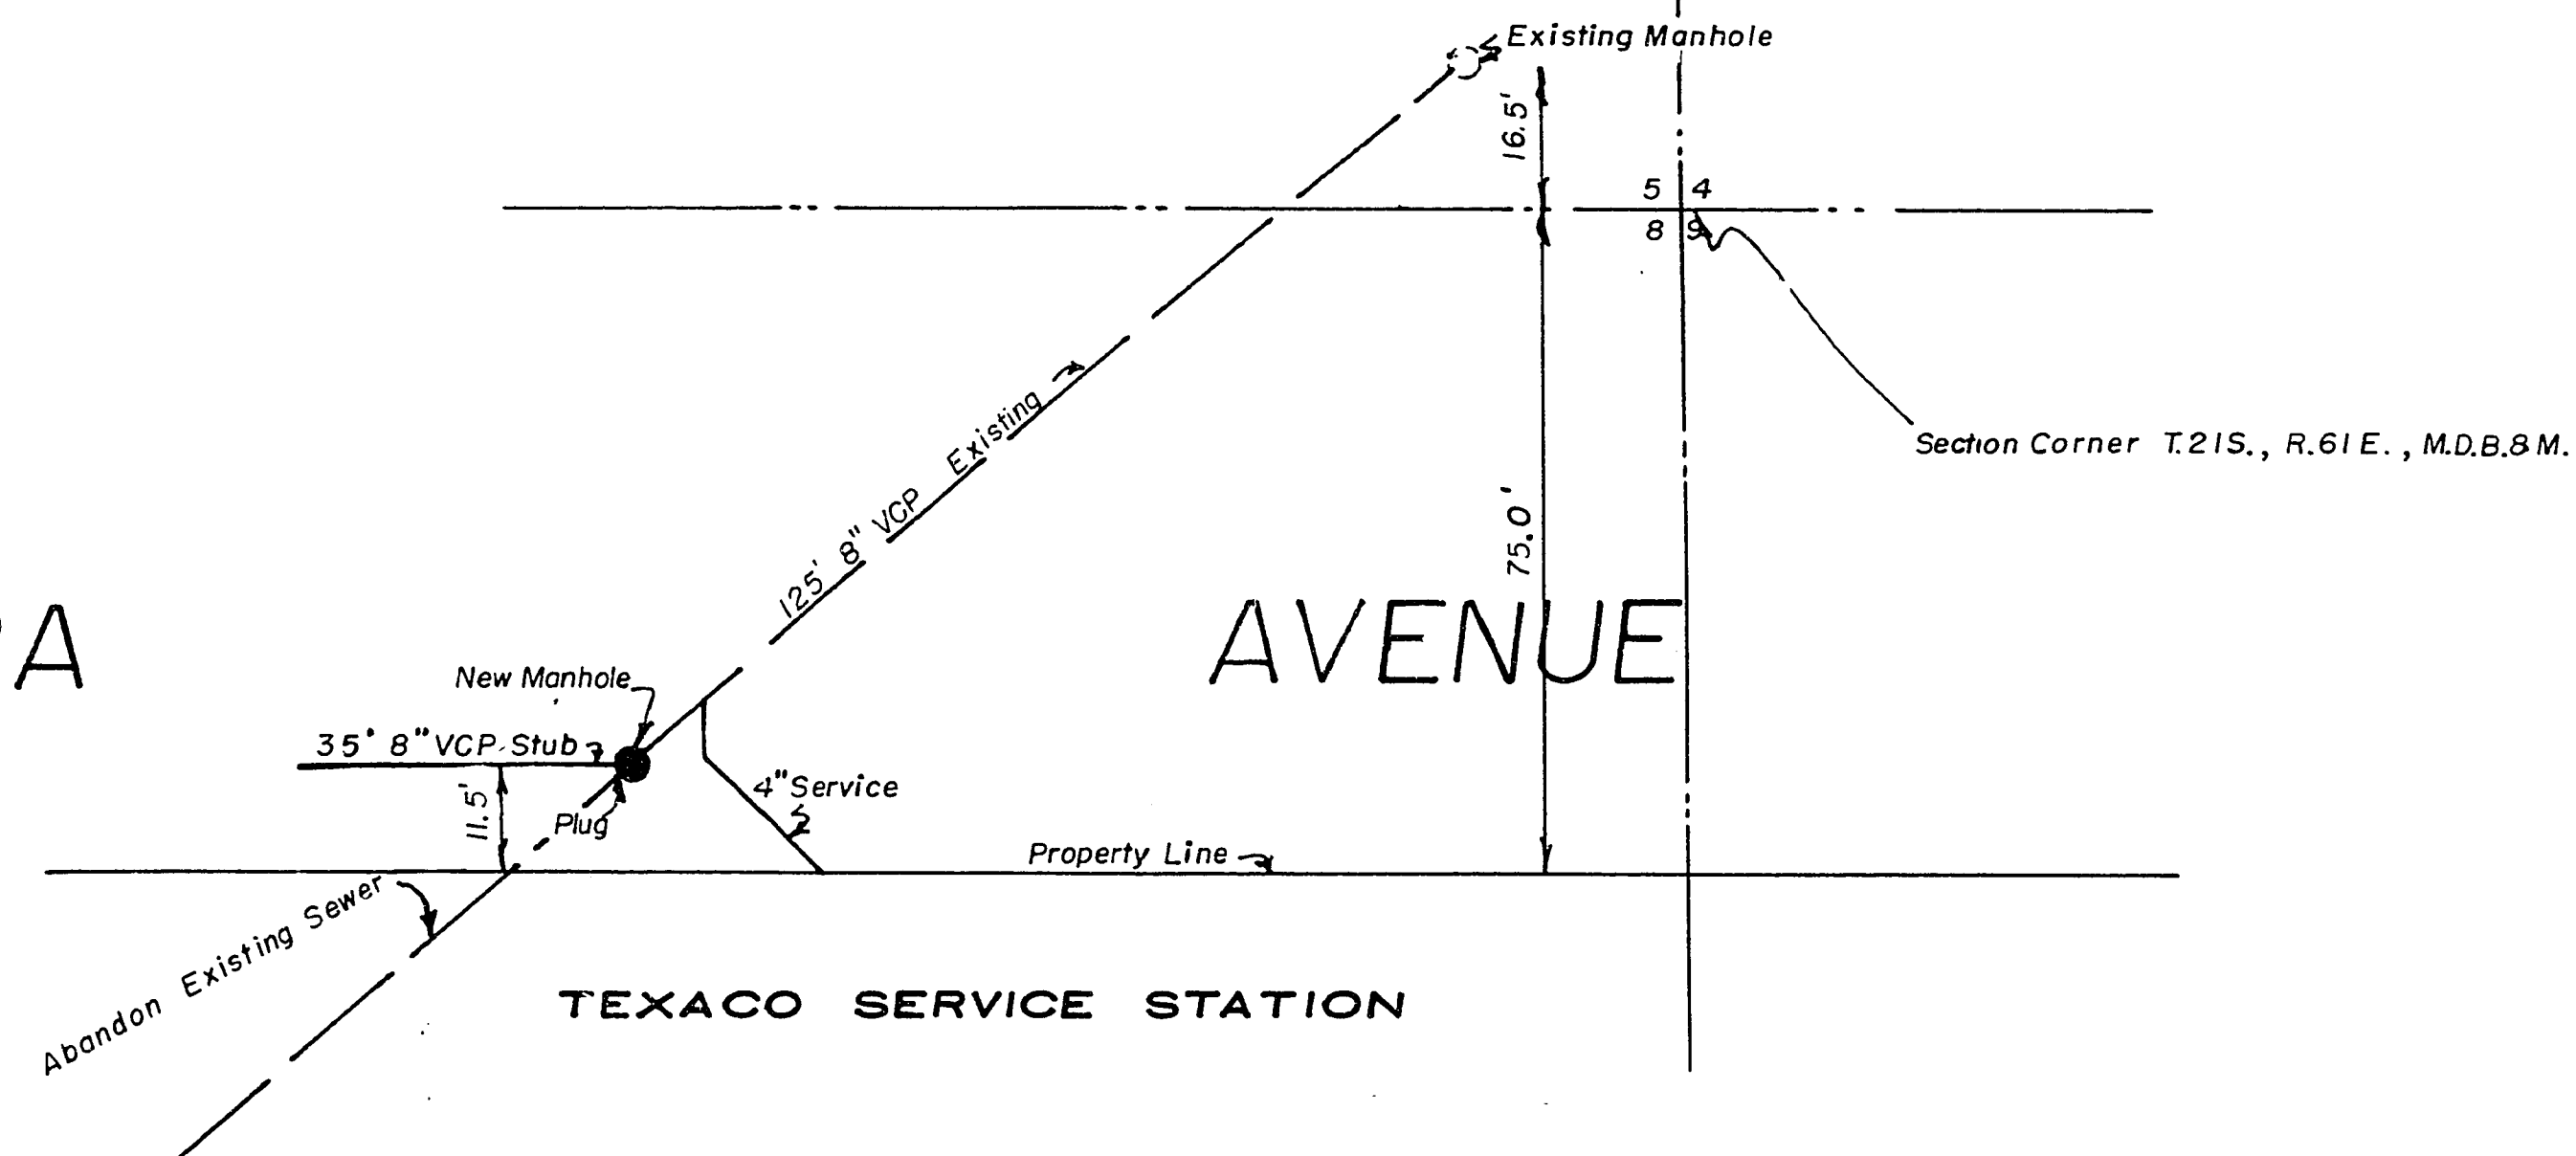


Horizontal Scale 1" = 20.0'
Vertical Scale 1" = 5.0'

APPROVALS

Supt. Sanitation	Date
City Engineer	Date

KARSTEN T. BRONKEN
CONSULTING ENGINEER'S

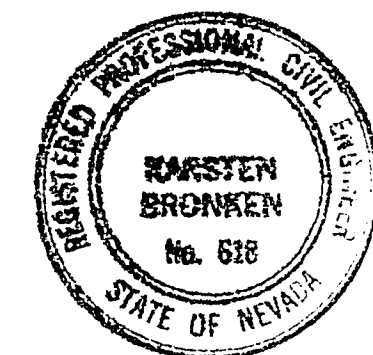

Karsten T. Bronken

AS CONSTRUCTED
SEWER LINE EXTENSION
TAB CONSTRUCTION CO.

307V372

16-1-16