
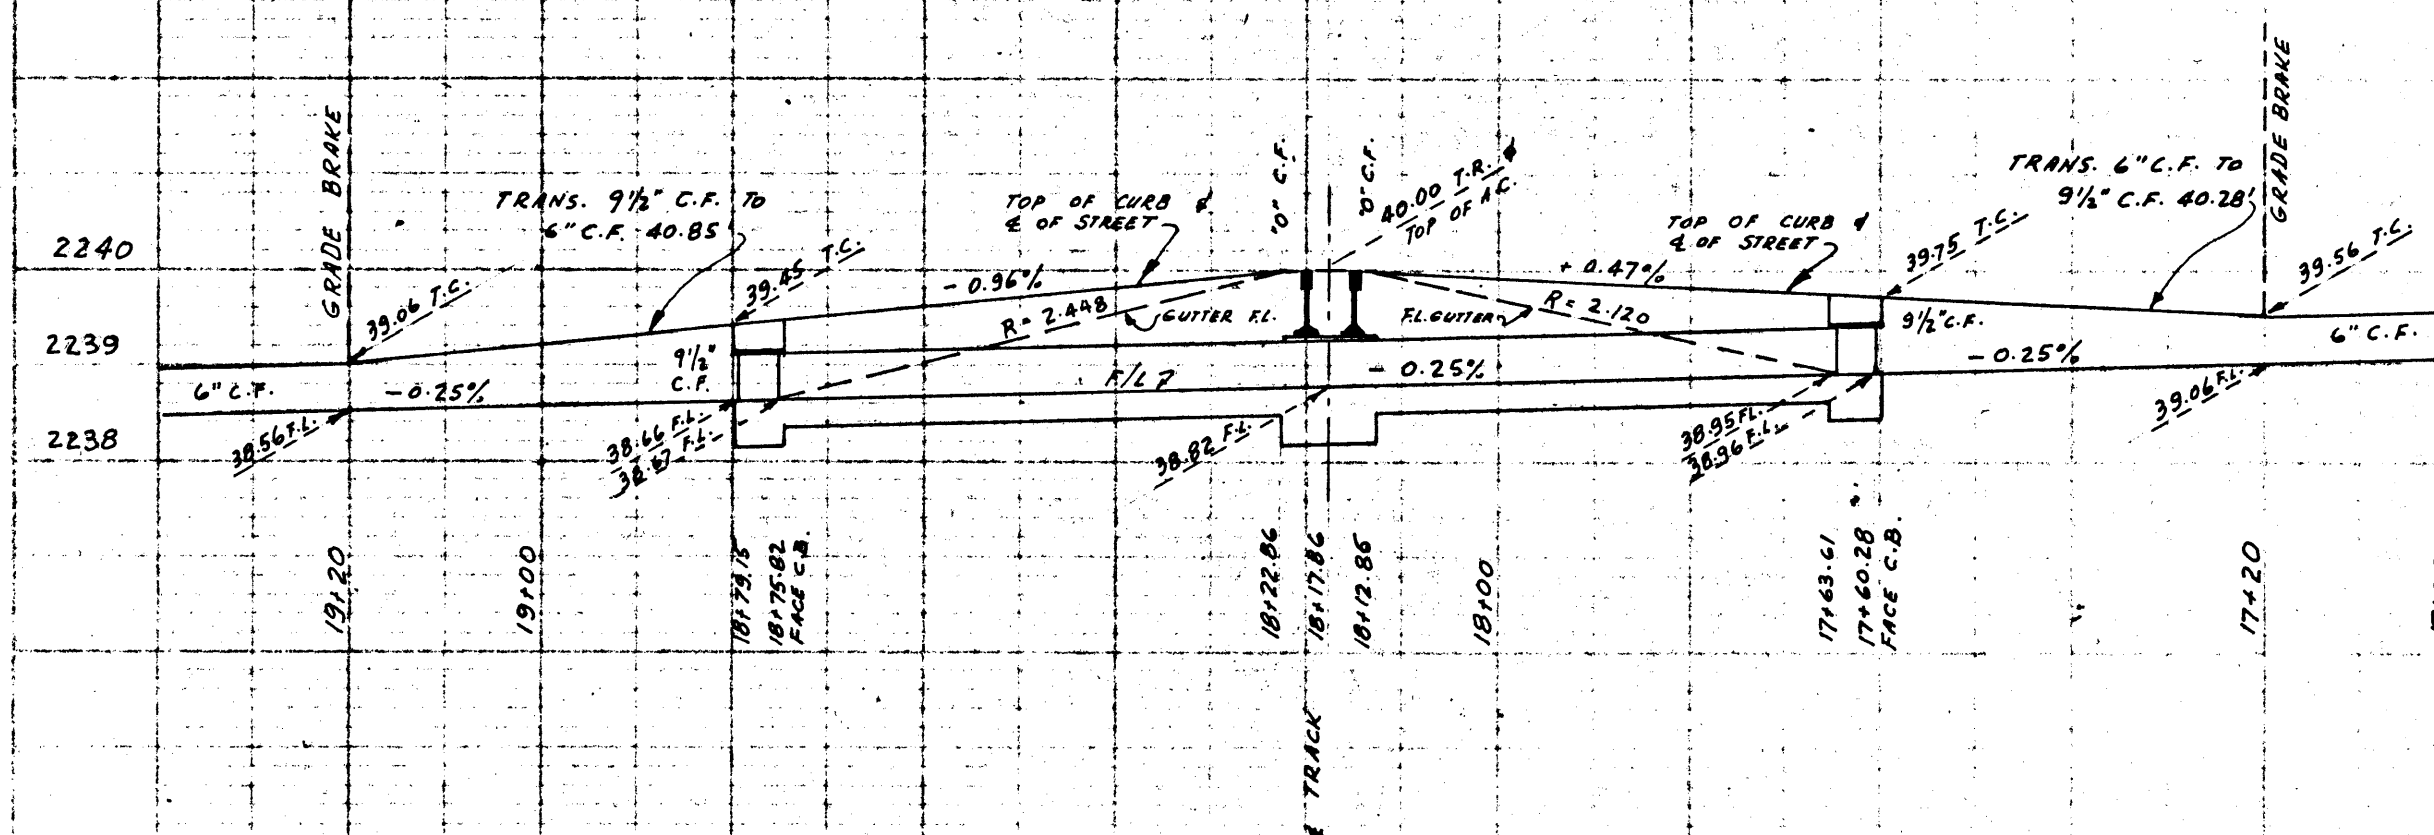
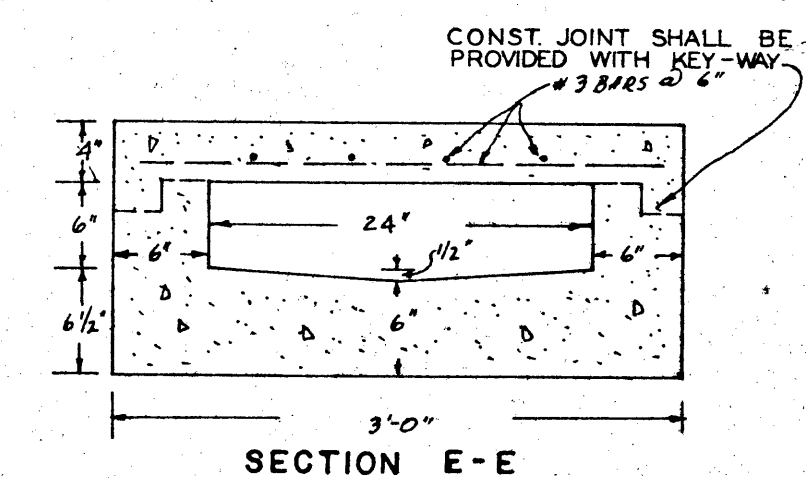
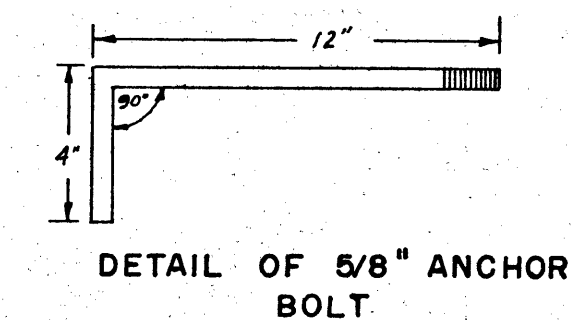
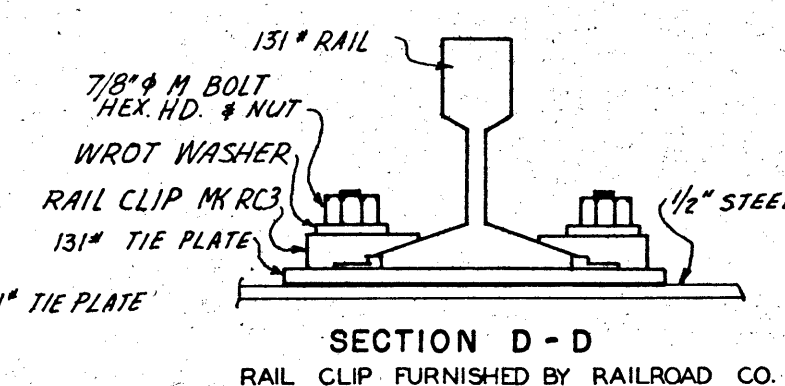
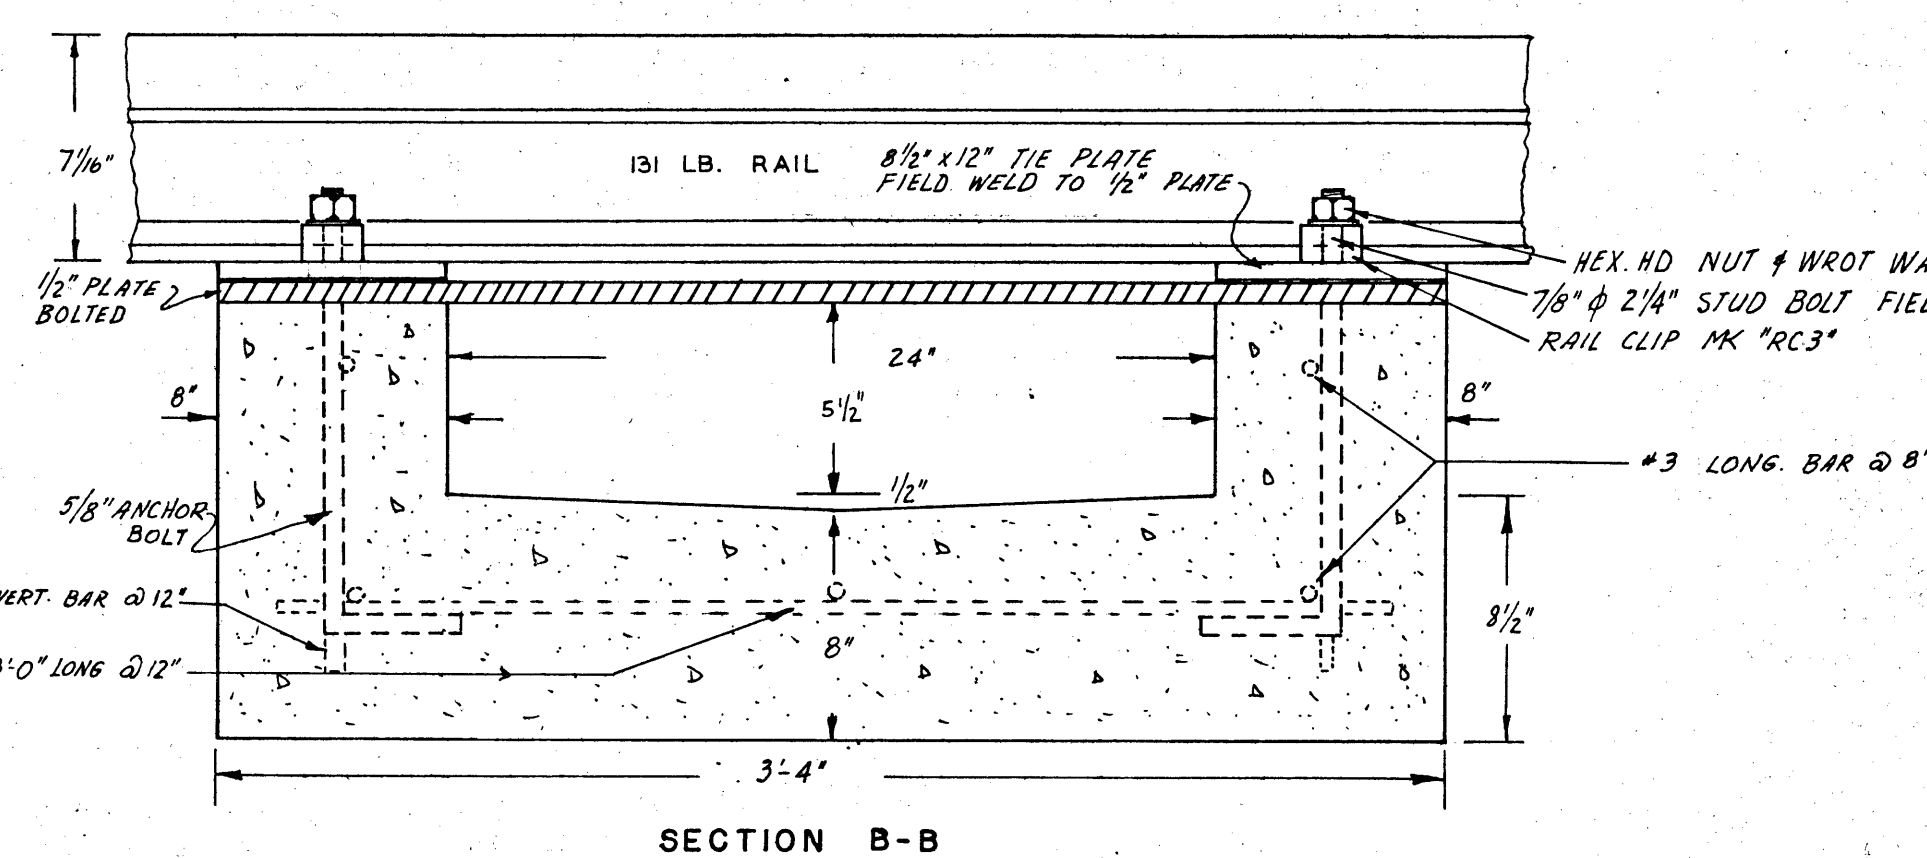
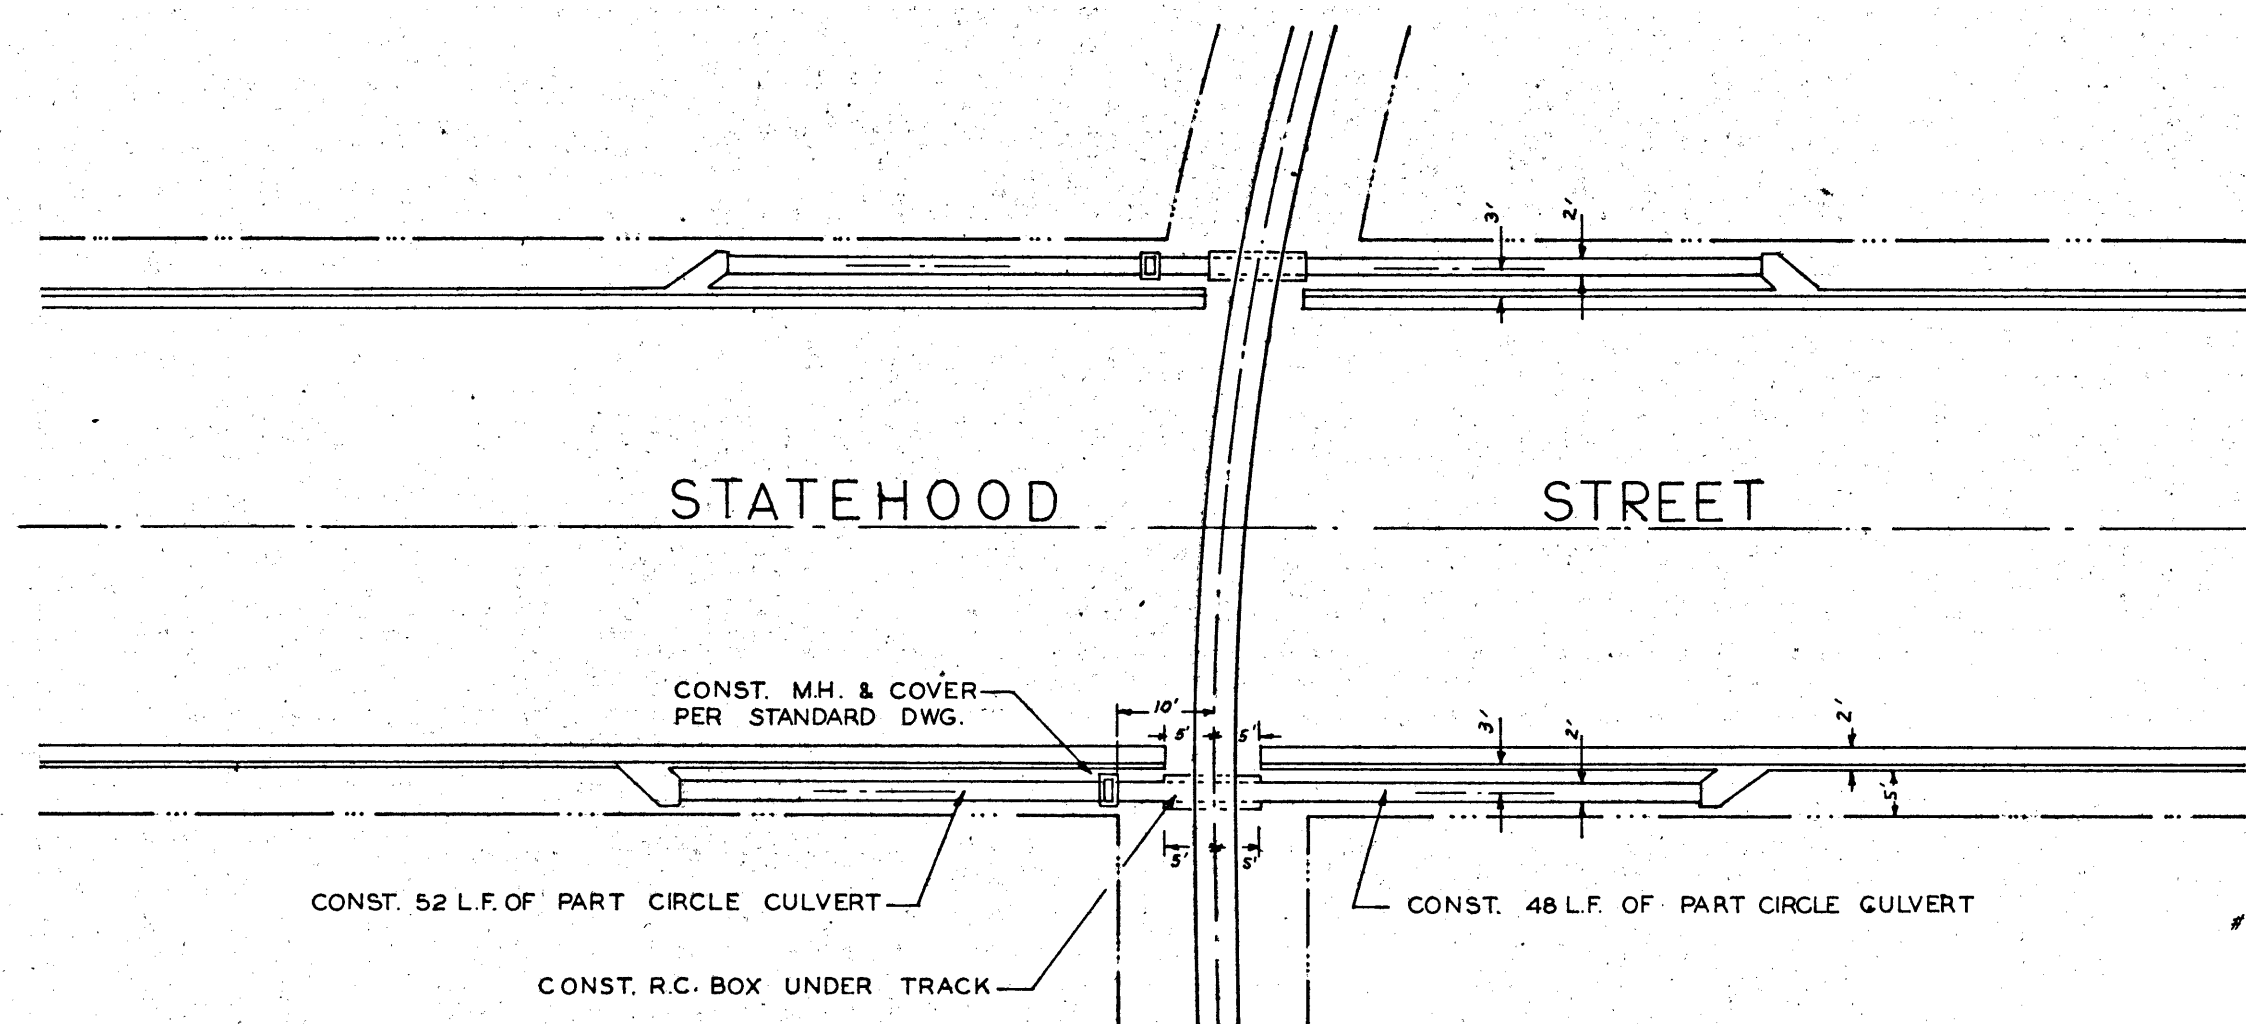
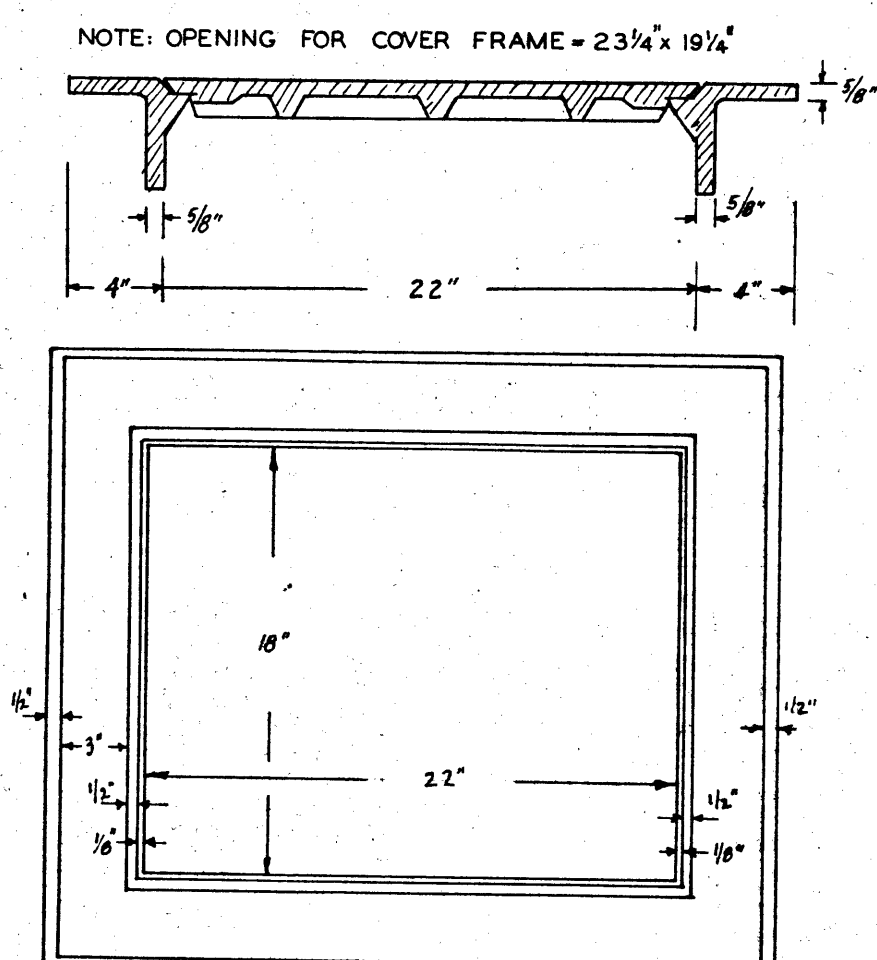
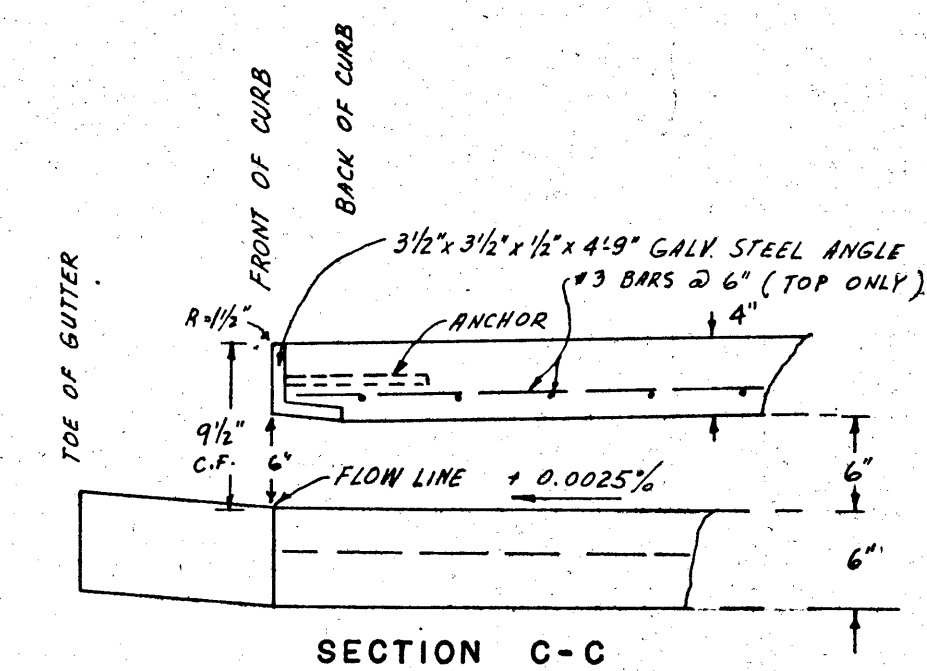


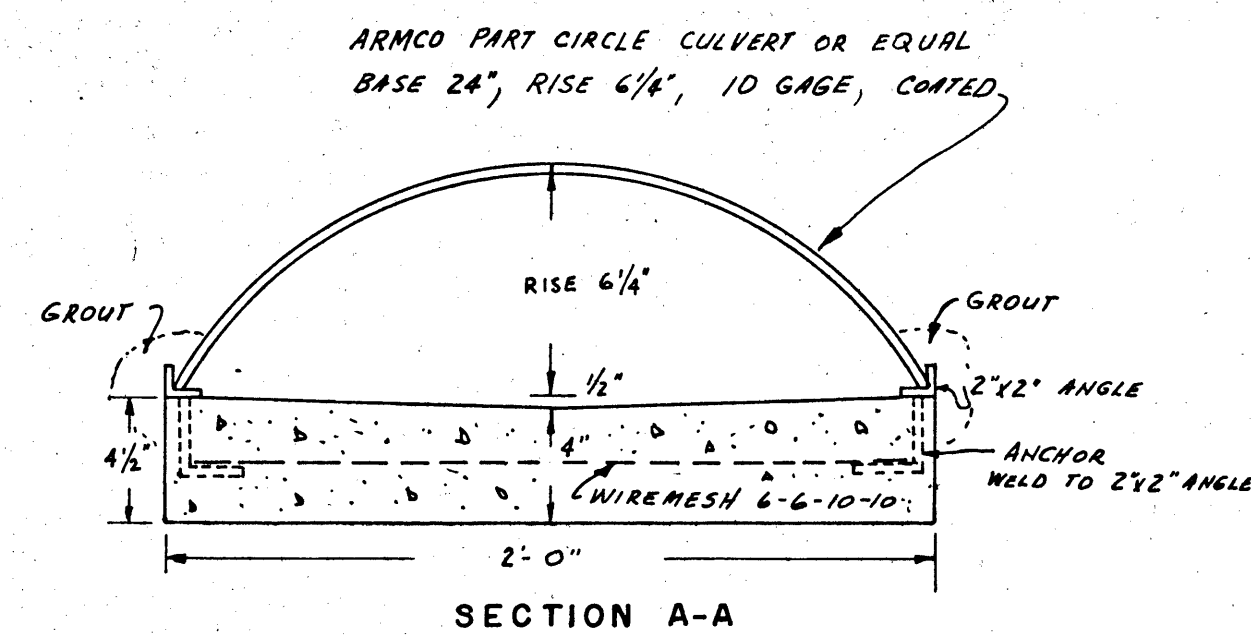

AS BUILT
JULY 23 1970 *F.D. Suck*

This drawing revised & redrawn in its
entirety 10/9/69
Revised Sheet 12 10/11/69

UNION PACIFIC RAILROAD CO.
CITY OF LAS VEGAS NEVADA
ENGINEERING DEPT.

STATEHOOD		STREET RAILROAD	
CROSSING			
DES.	DATE	S.C. NO.	
W. B. C. 100-100	10/14/69	S.C. IV	
APPROVED BY CITY ENGR.		F.B.K. NO.	
		P.C. NO.	
		DRAWING NO.	
V.B. C. 100-100	10/14/69	107-1799	

15-4-113 sh 12A