


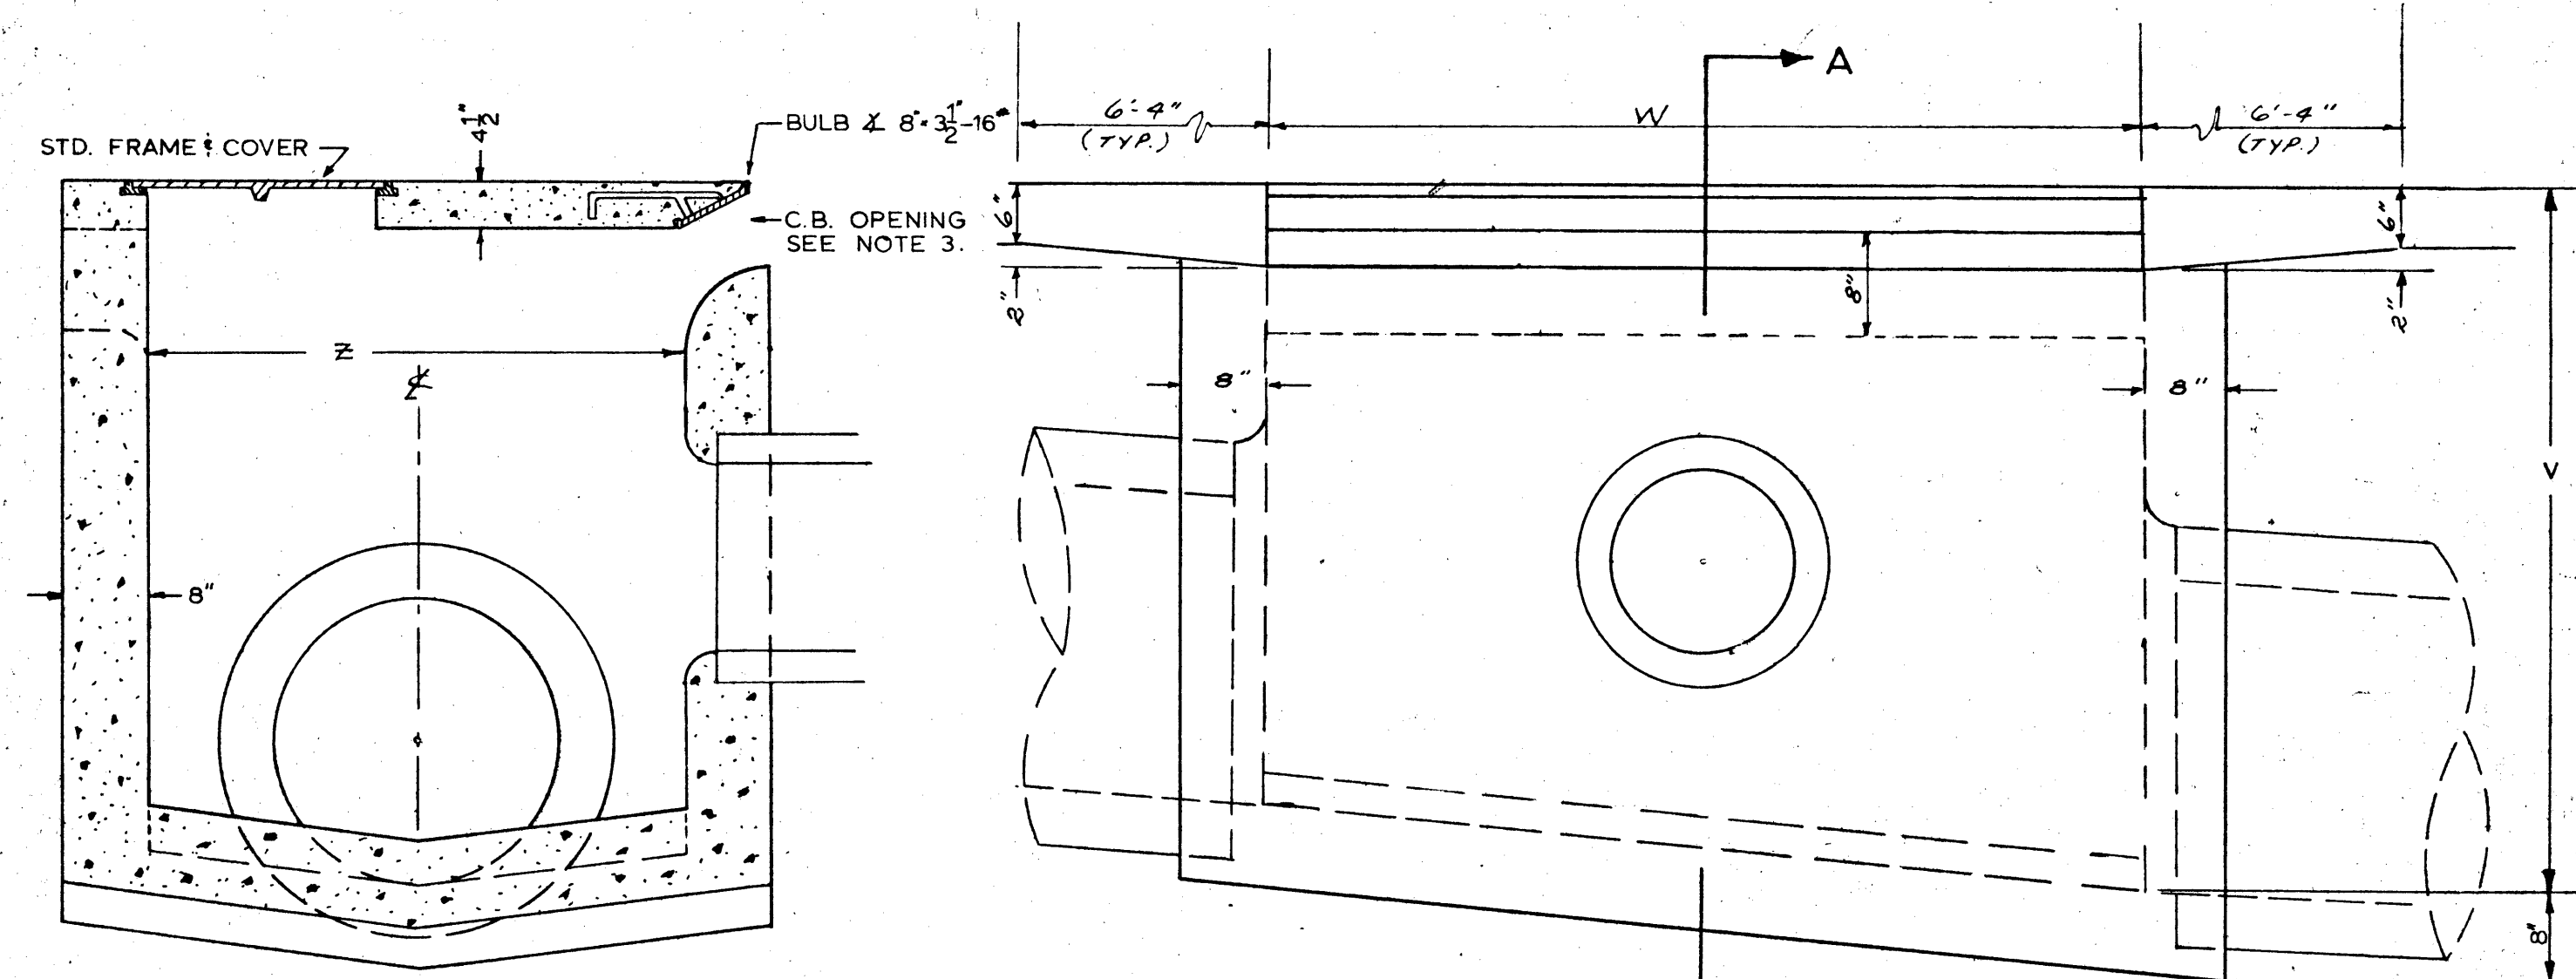

SECTION-A-A

NO. 2 CATCH BASIN
FOR 36" R.C.P. AND SMALLER.
NOTE: SEE SH. 21 FOR LARGER SIZES
UNDER DETAIL OF C.B. NO. 2 MODIFIED
NOTES

1. CATCH BASIN NO. 2 PER L.A. CO. FL. CONT. DIST. DWG. 2-D162.
2. REINFORCING PER L.A. CO. FL. CONT. DIST. DWG. 2-D172.
3. CATCH BASIN OPENING PER L.A. CO. FL. CONT. DIST. DWG. 2-D215.
4. M.H. FRAME COVER PER L.A. CO. FL. CONT. DIST. DWG. 2-D156.
5. REINFORCING AROUND M.H. PER L.A. CO. FL. CONT. DIST. DWG. 2-D157.
6. STEPS PER L.A. CO. FL. CONT. DIST. DWG. 2-D96.

NOT APPLICABLE

NOT APPLICABLE

SYMBOL	STREET	STATION	TYPE				REMARKS
SD 1	Embrey Ave.	13+46.00	No. 2 Catch Basin	4.0	6.67	10.33	2-60" RCP, 1-24" RCP
SD 1A	"	13+46.00	"	8.0	4.33	5.12	1-24" RCP
SD 2	"	6+51.00	"	4.0	6.67	11.37	2-60" RCP, 1-27" RCP
SD 2A	"	6+51.00	"	10.0	4.33	5.58	1-27" RCP
SD 3	"	14+85.37	Manhole	6.67	6.67	13.61	2-60" RCP, 1-18" RCP
SD 3A	"	15+79.70	No. 2 Catch Basin	4.0	4.33	5.00	1-18" RCP
SD 4	Pacific Street	5+26.00	"	4.0	6.67	12.55	2-60" RCP, 1-24" RCP
SD 4A	"	5+26.00	"	8.0	4.33	5.00	1-24" RCP
SD 5	"	10+00.00	"	4.0	6.67	10.15	2-60" RCP, 1-27" RCP
SD 5A	"	10+00.00	"	10.0	4.33	7.25	1-27" RCP
SD 6	"	19+83.09	"	7.0	6.67	8.66	1-60" RCP, 1-54" RCP
SD 7	Alta Drive	20+73.27	Catch Basin No. 5A	4.0	6.67	8.00	2-54" RCP
SD 8	"	18+40.27	"	4.0	6.67	8.49	2-54" RCP, 1-15" RCP
SD 8A	"	18+40.27	"	2.75	2.75	4.17	1-15" RCP
SD 9	"	16+89.27	"	4.0	6.67	9.03	2-54" RCP, 1-15" RCP
SD 9A	"	16+89.27	"	2.75	2.75	4.15	1-15" RCP
SD 10	"	16+09.27	No. 2 Catch Basin	16.0	6.67	9.26	2-54" RCP, 1-18" RCP
SD 10A	"	16+09.27	"	4.0	4.33	4.19	1-18" RCP
SD 11	"	13+44.00	Manhole	6.67	6.67	10.47	1-54" RCP, 1-48" RCP, 1-27" RCP
SD 12	"	12+45.00	No. 2 Catch Basin	14.0	4.33	5.45	1-27" RCP, 1-24" RCP, 1-18" RCP
SD 12A	"	12+45.00	"	4.0	4.33	4.82	1-18" RCP
SD 13	"	9+51.00	"	12.0	4.33	5.48	1-24" RCP, 1-18" RCP
SD 14	"	9+51.00	"	4.0	4.33	4.70	2-18" RCP
SD 15	"	6+15.00	"	4.0	4.33	4.85	1-18" RCP
SD 11-1	Prospect Street	24+62.15	"	6.0	6.67	10.05	2-48" RCP, 1-15" RCP
SD 11-1A	"	25+09.15	"	4.0	4.33	6.91	1-15" RCP
SD 11-2	"	36+49.15	"	14.0	6.67	6.80	1-48" RCP, 1-42" RCP, 1-36" RCP
SD 11-2A	"	36+42.39	"	10.0	4.33	4.22	1-36" RCP, 1-33" RCP
SD 11-3	"	39+43.53	"	10.0	6.67	6.19	1-42" RCP, 1-24" RCP
SD 11-3A	"	39+09.53	"	6.0	4.33	3.45	1-24" RCP
SD 11-2B	Adj. Tract A-317		Catch Basin No. 5A	5.25	3.67	4.52	1-33" RCP, 1-27" RCP
SD 11-2C	Statehood Street	18+11.21	No. 2 Catch Basin	4.0	4.33	5.21	2-27" RCP
SD 11-2D	"	17+95.00	"	12.0	4.33	5.14	1-27" RCP, 1-21" RCP
SD 11-2E	"	18+35.00	"	5.0	4.33	5.04	1-21" RCP
	Embrey Ave.	3+94.54W	"	7.0	4.33	4.40	1-18" RCP
	"	3+94.54E	"	7.0	4.33	4.60	2-18" RCP
	"	20+75.00N	"	4.0	4.33	2.85	2-22X13-CMPA
SD-16	"	20+75.00S	"	4.0	4.33	2.65	1-22X13-CMPA
SD-16A	ALTA DRIVE	13+86.2	"	16.0	6.67	10.73	2-54" RCP, 1-18" RCP
	"	13+86.2	"	4.0	4.33	4.89	1-18" RCP

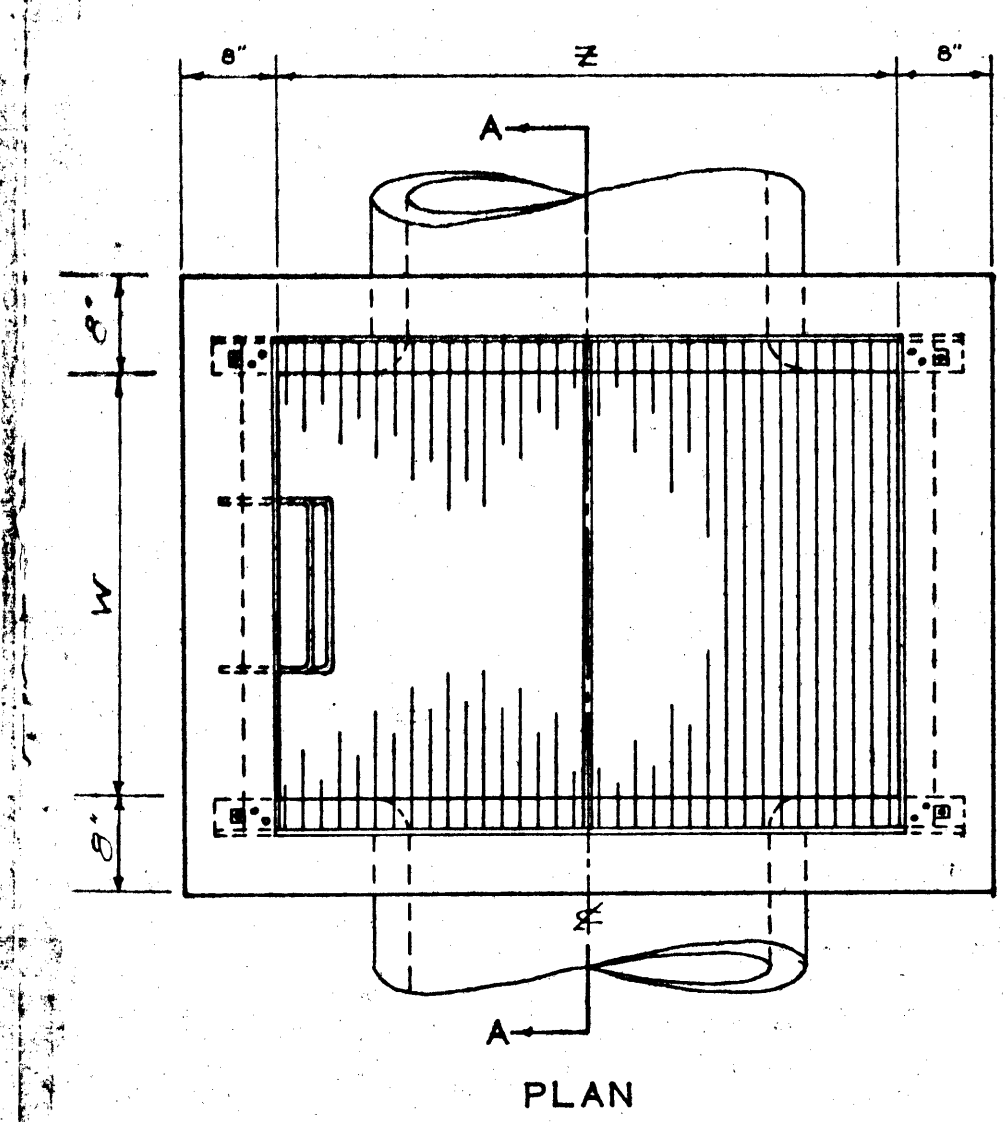



- NOTES
1. CATCH BASIN NO. 5-A PER L.A. CO. FL. CONT. DIST. DWG. 2-D195.
 2. REINFORCING PER L.A. CO. FL. CONT. DIST. DWG. 2-D172.
 3. STD. FRAME GRATING PER L.A. CO. FL. CONT. DIST. DWG. 2-D227.
 4. STEPS PER L.A. CO. FL. CONT. DIST. DWG. 2-D96.

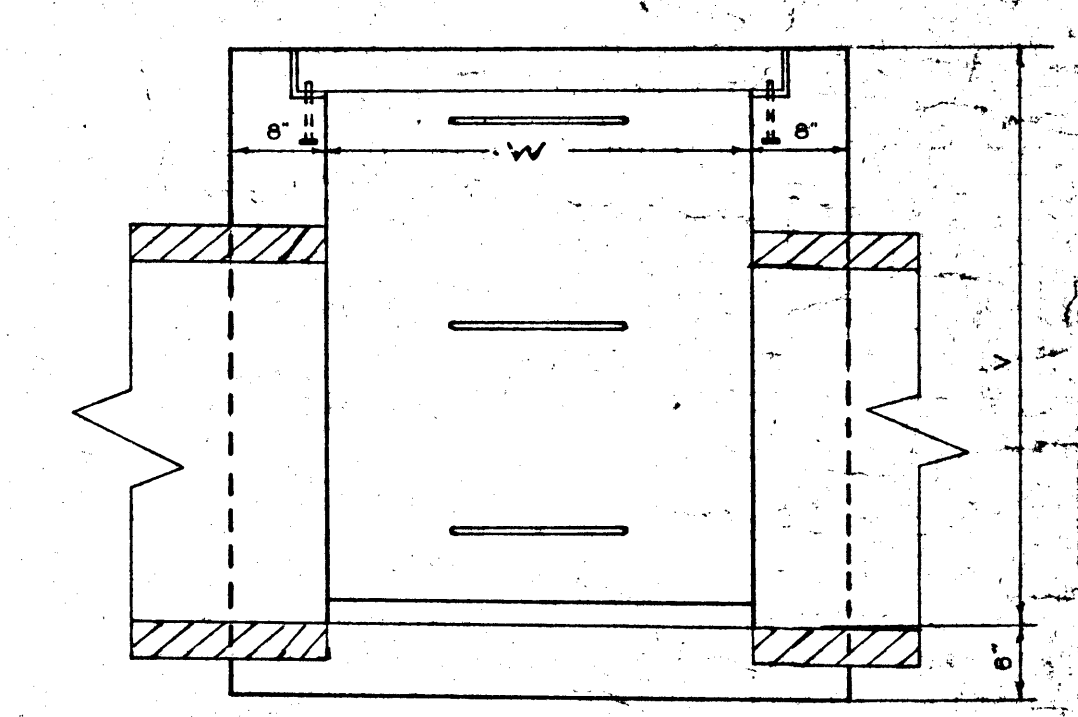

CATCH BASIN NO. 5-A

APPROVED BY _____
FIRE CHIEF DATE _____

AS BUILT
JULY 23 1970

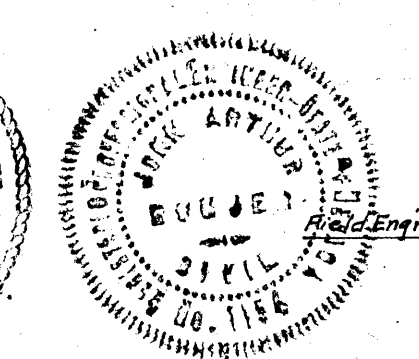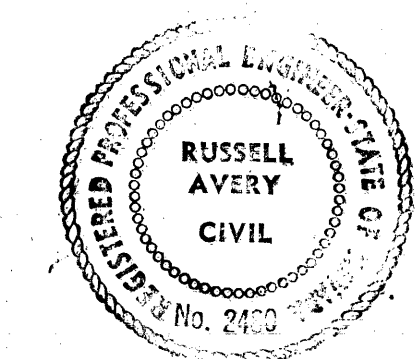

UNION PACIFIC RAILROAD CO. CITY OF LAS VEGAS NEVADA ENGINEERING DEPT.		
DETAILS		
DES. Russell Avery, E.P.E. #2400	DATE 10-1-68	SC(H) AS NOTED
DR. J. O. Barker	6-12-69	SC(V) AS NOTED
CHKD. J. O. Barker		F.B.K. NO.
APPROVED BY CITY ENGR.		P.J.O. NO.
	6-20-69	DRAWING NO. 18

107-1117

107-V 799