


PLAN

DATE


BY

PROFILE  
SOURCES  
NOTE BOOK  
DATE  
BY  
NO.

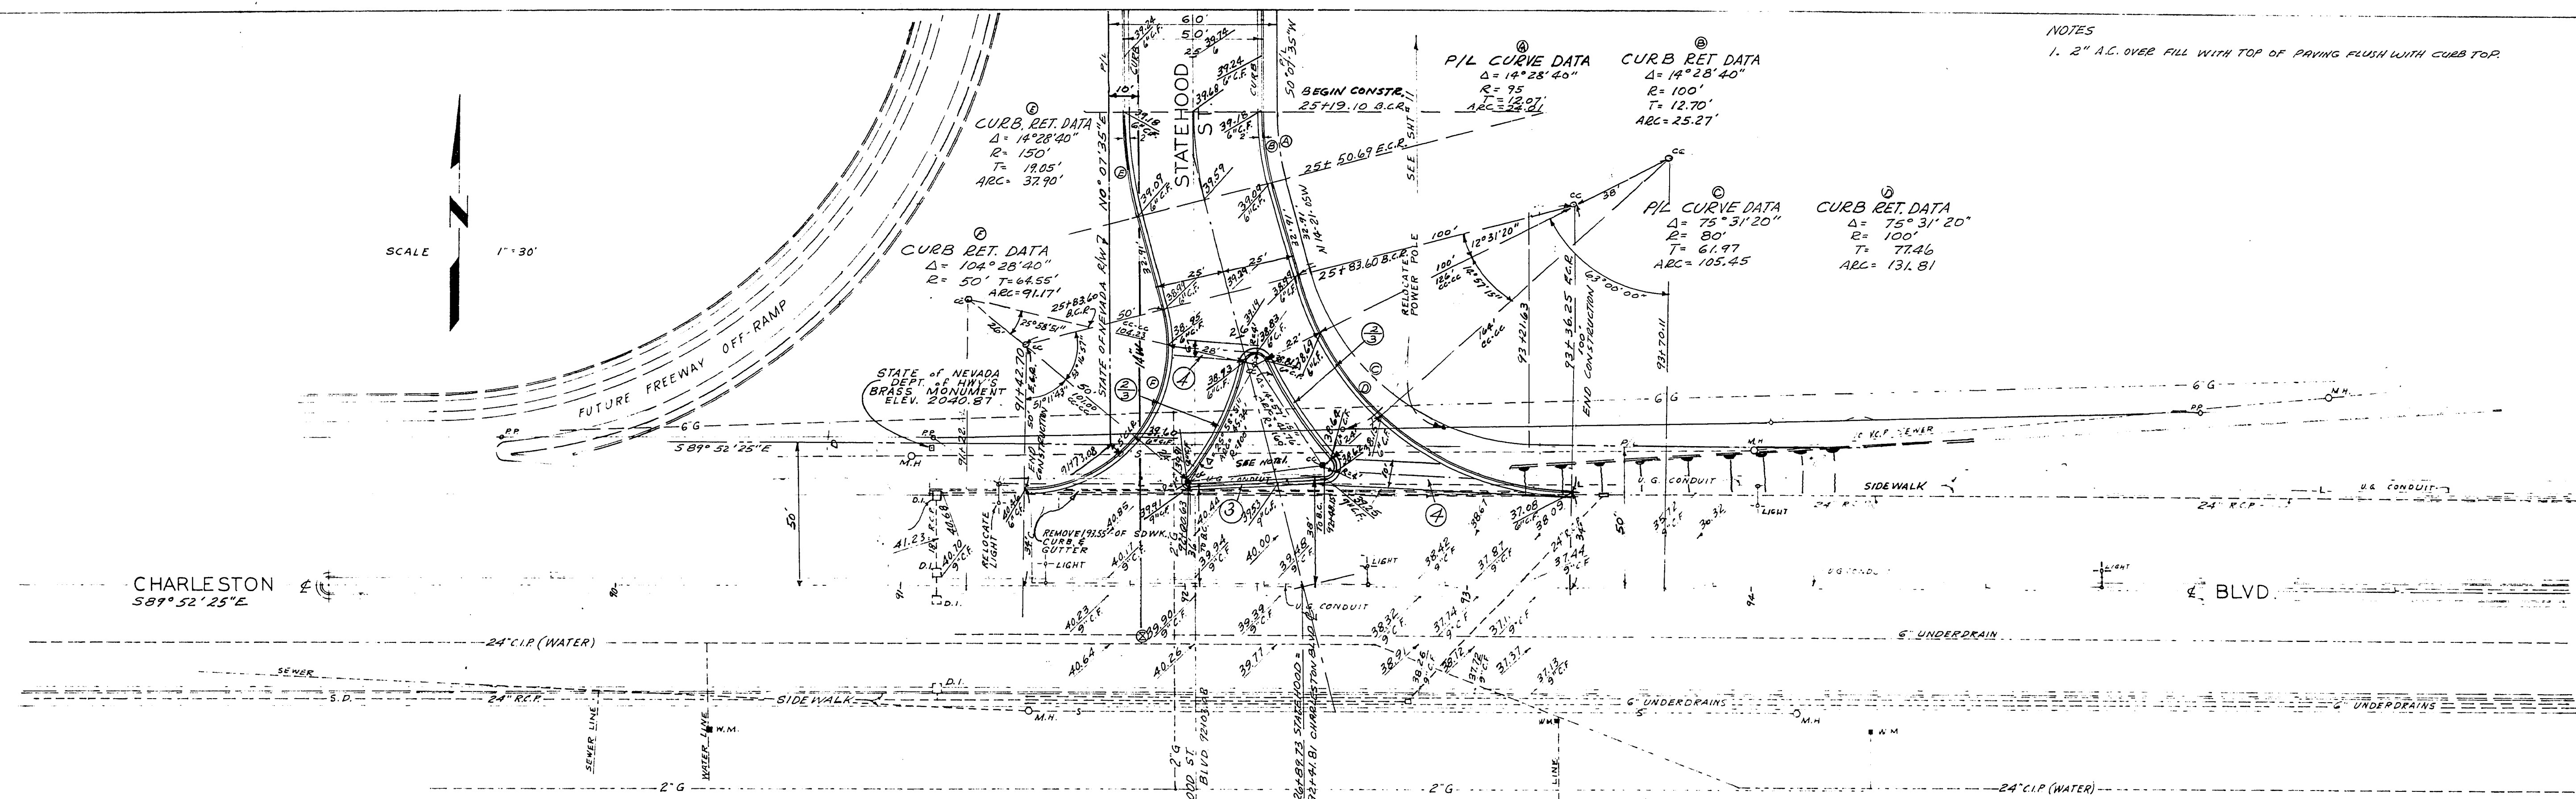

NOTES  
1. 2" A.C. OVER FILL WITH TOP OF PAVING FLUSH WITH CURB TOP.

NOTE! UTILITY INFORMATION WAS DERIVED FROM DATA FURNISHED BY UTILITY COMPANIES. CONTRACTOR MUST CONFIRM LOCATION OF UTILITIES BEFORE COMMENCING EXCAVATION.

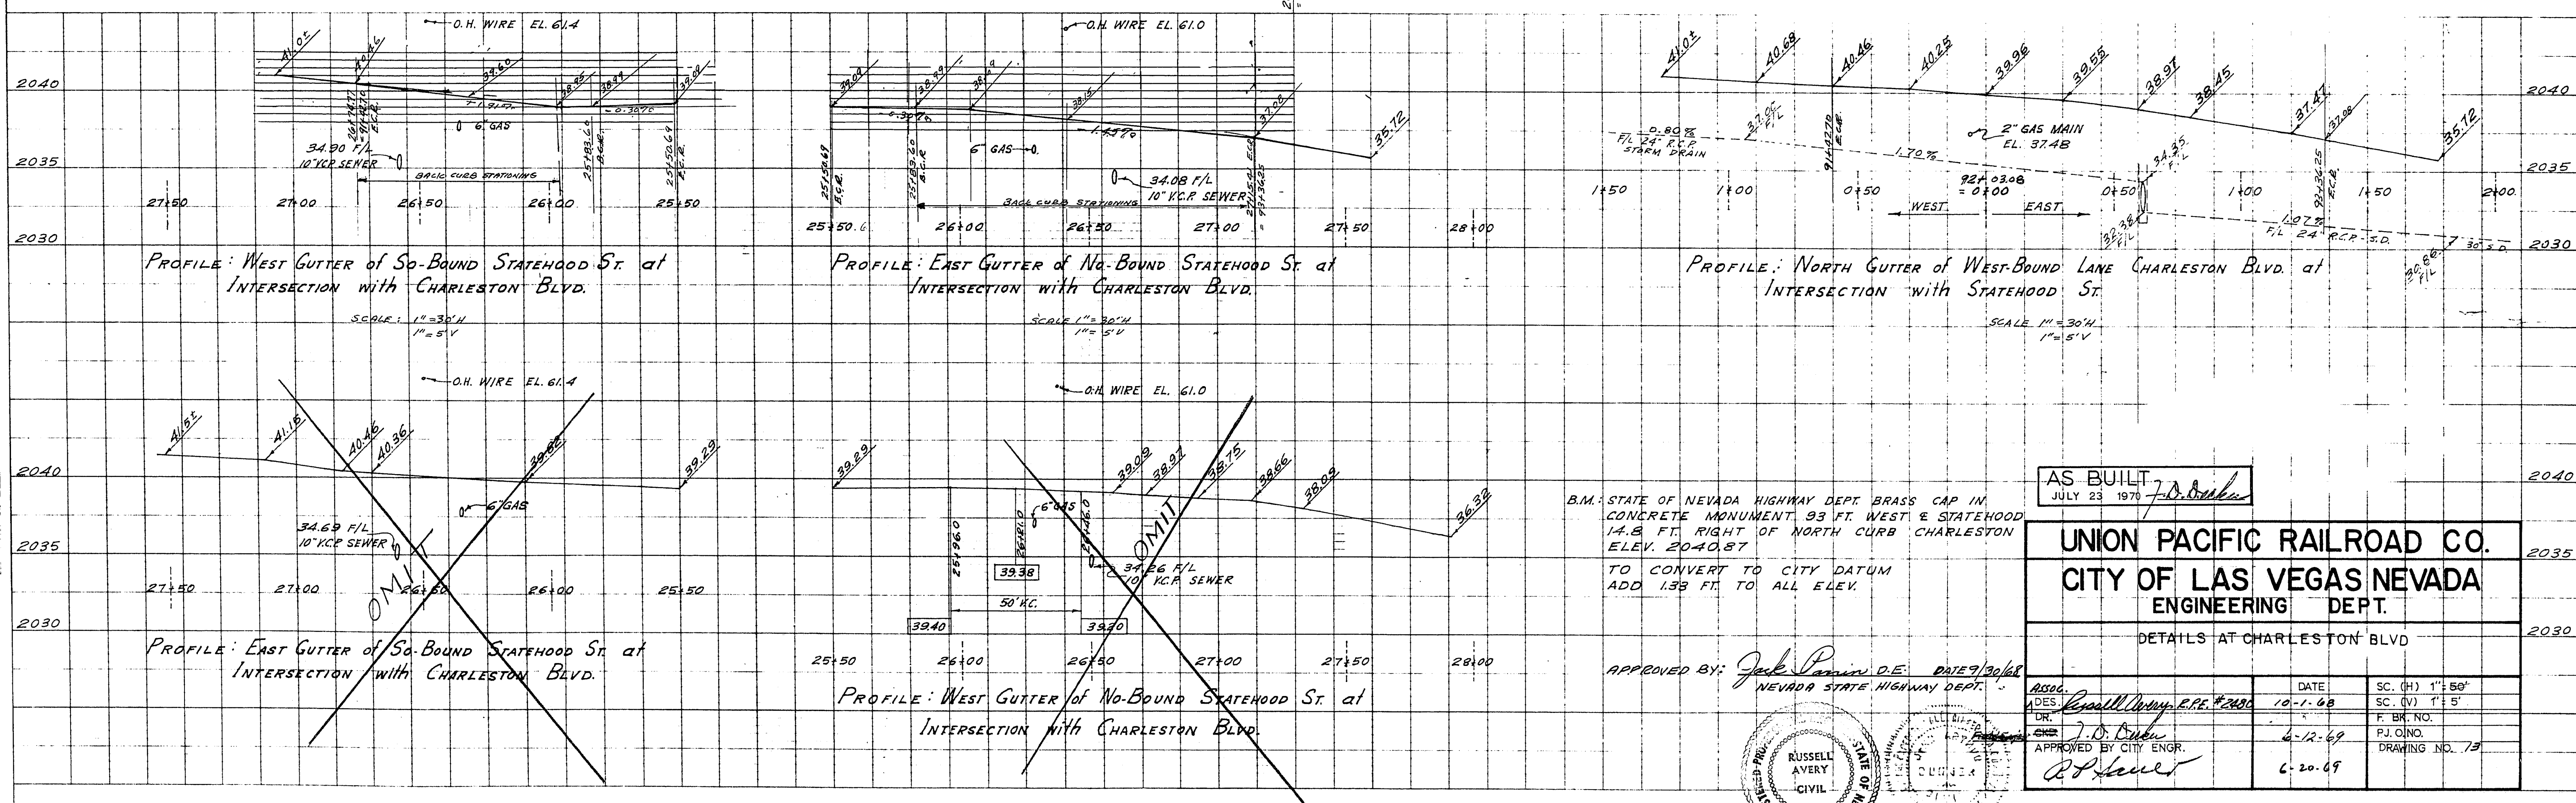


B.M. STATE OF NEVADA HIGHWAY DEPT. BRASS CAP IN CONCRETE MONUMENT 93 FT. WEST & STATEHOOD 14.8 FT. RIGHT OF NORTH CURB CHARLESTON ELEV. 2040.87  
TO CONVERT TO CITY DATUM  
ADD 1.33 FT. TO ALL ELEV.

AS BUILT  
JULY 23 1970

UNION PACIFIC RAILROAD CO.  
CITY OF LAS VEGAS NEVADA  
ENGINEERING DEPT.  
DETAILS AT CHARLESTON BLVD

APPROVED BY: Jack Pannin D.E. DATE 9/30/68  
NEVADA STATE HIGHWAY DEPT.

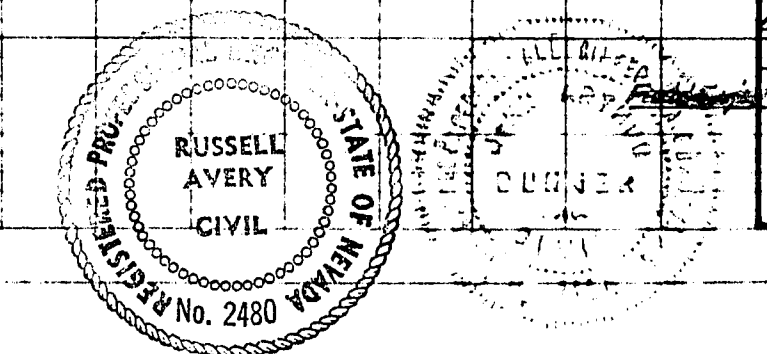

|             |         |                  |
|-------------|---------|------------------|
| DESIGNED BY | DATE    | SC. (H) 1" = 50' |
| CHECKED BY  | 10-1-68 | SC. (V) 1" = 5'  |
| APPROVED BY | 6-12-69 | F. BR. NO.       |
|             | 6-20-69 | P.J. Q.NO.       |
|             |         | DRAWING NO. 73   |

154415

107 V 799