


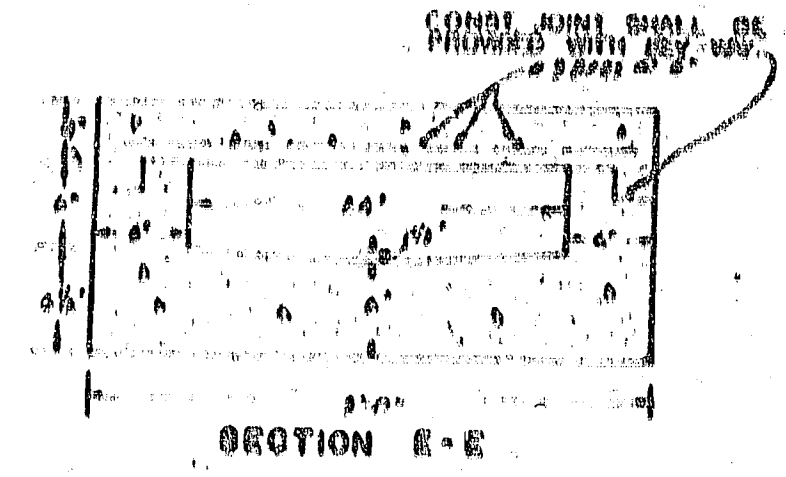
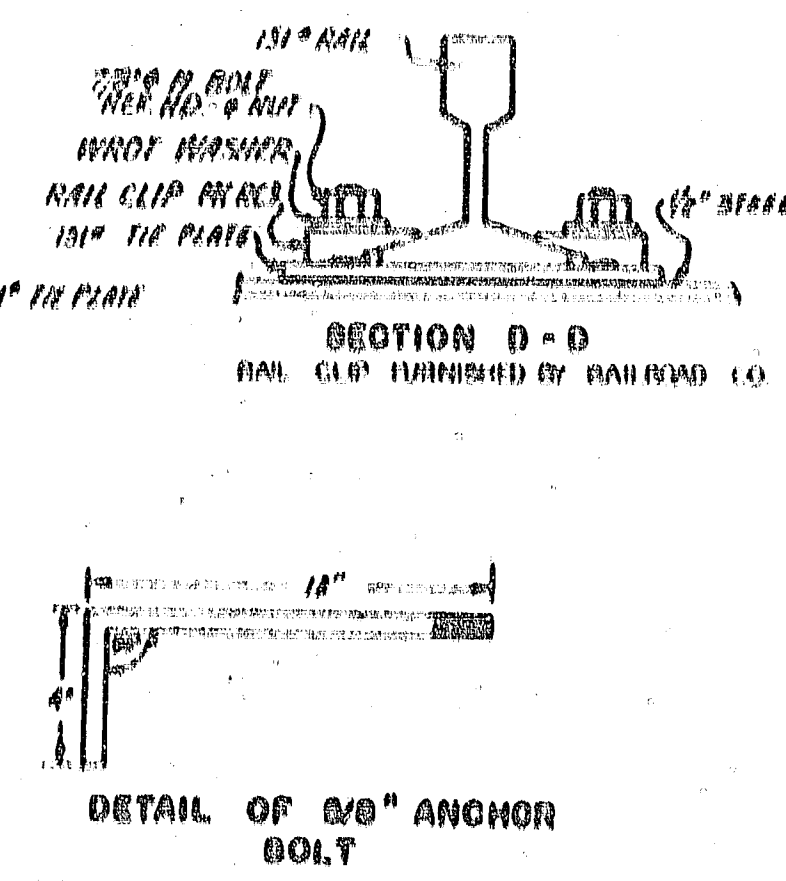
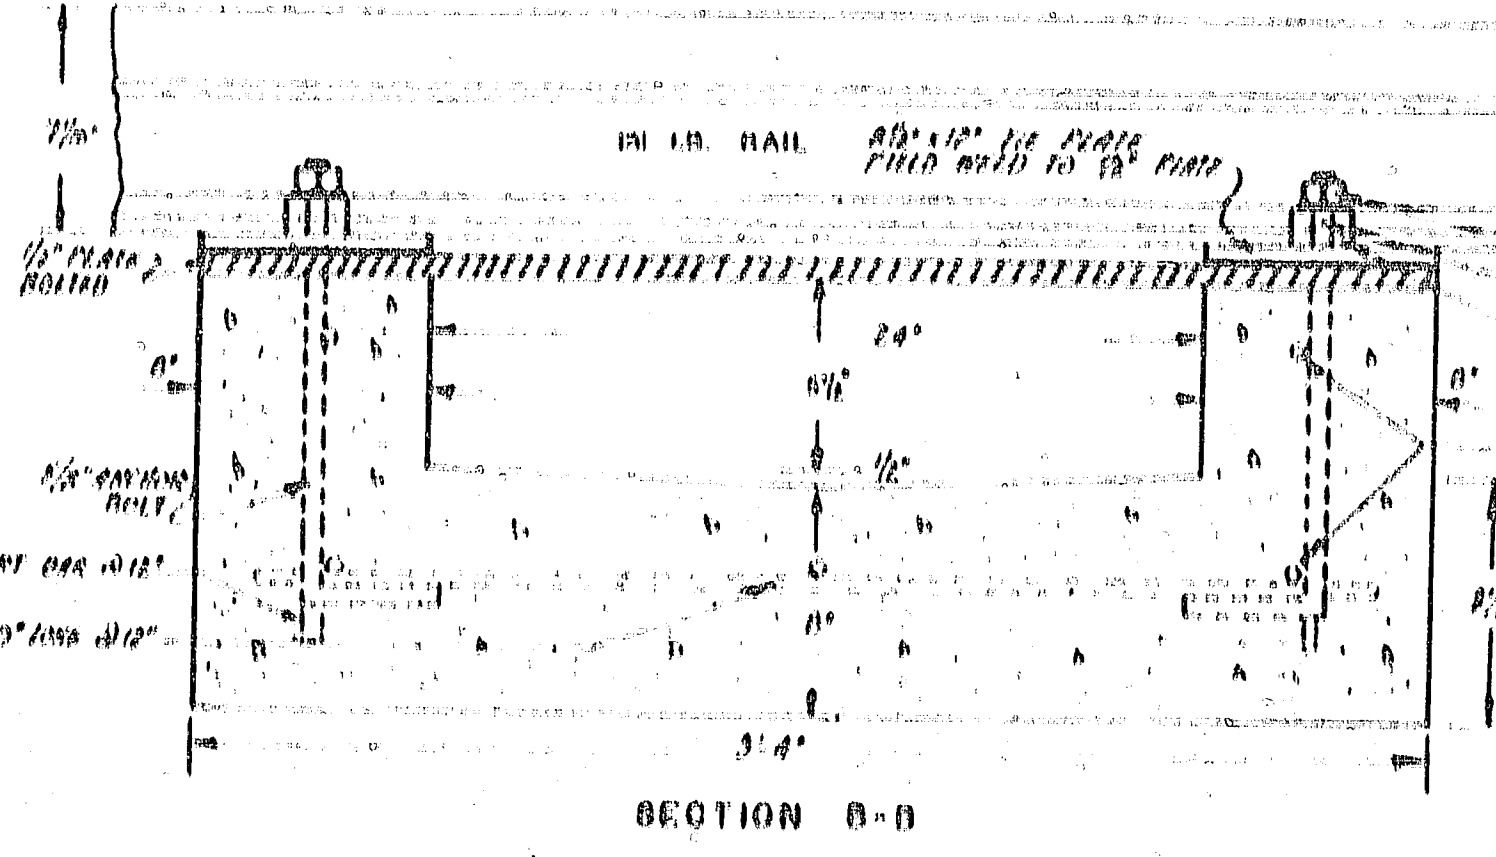
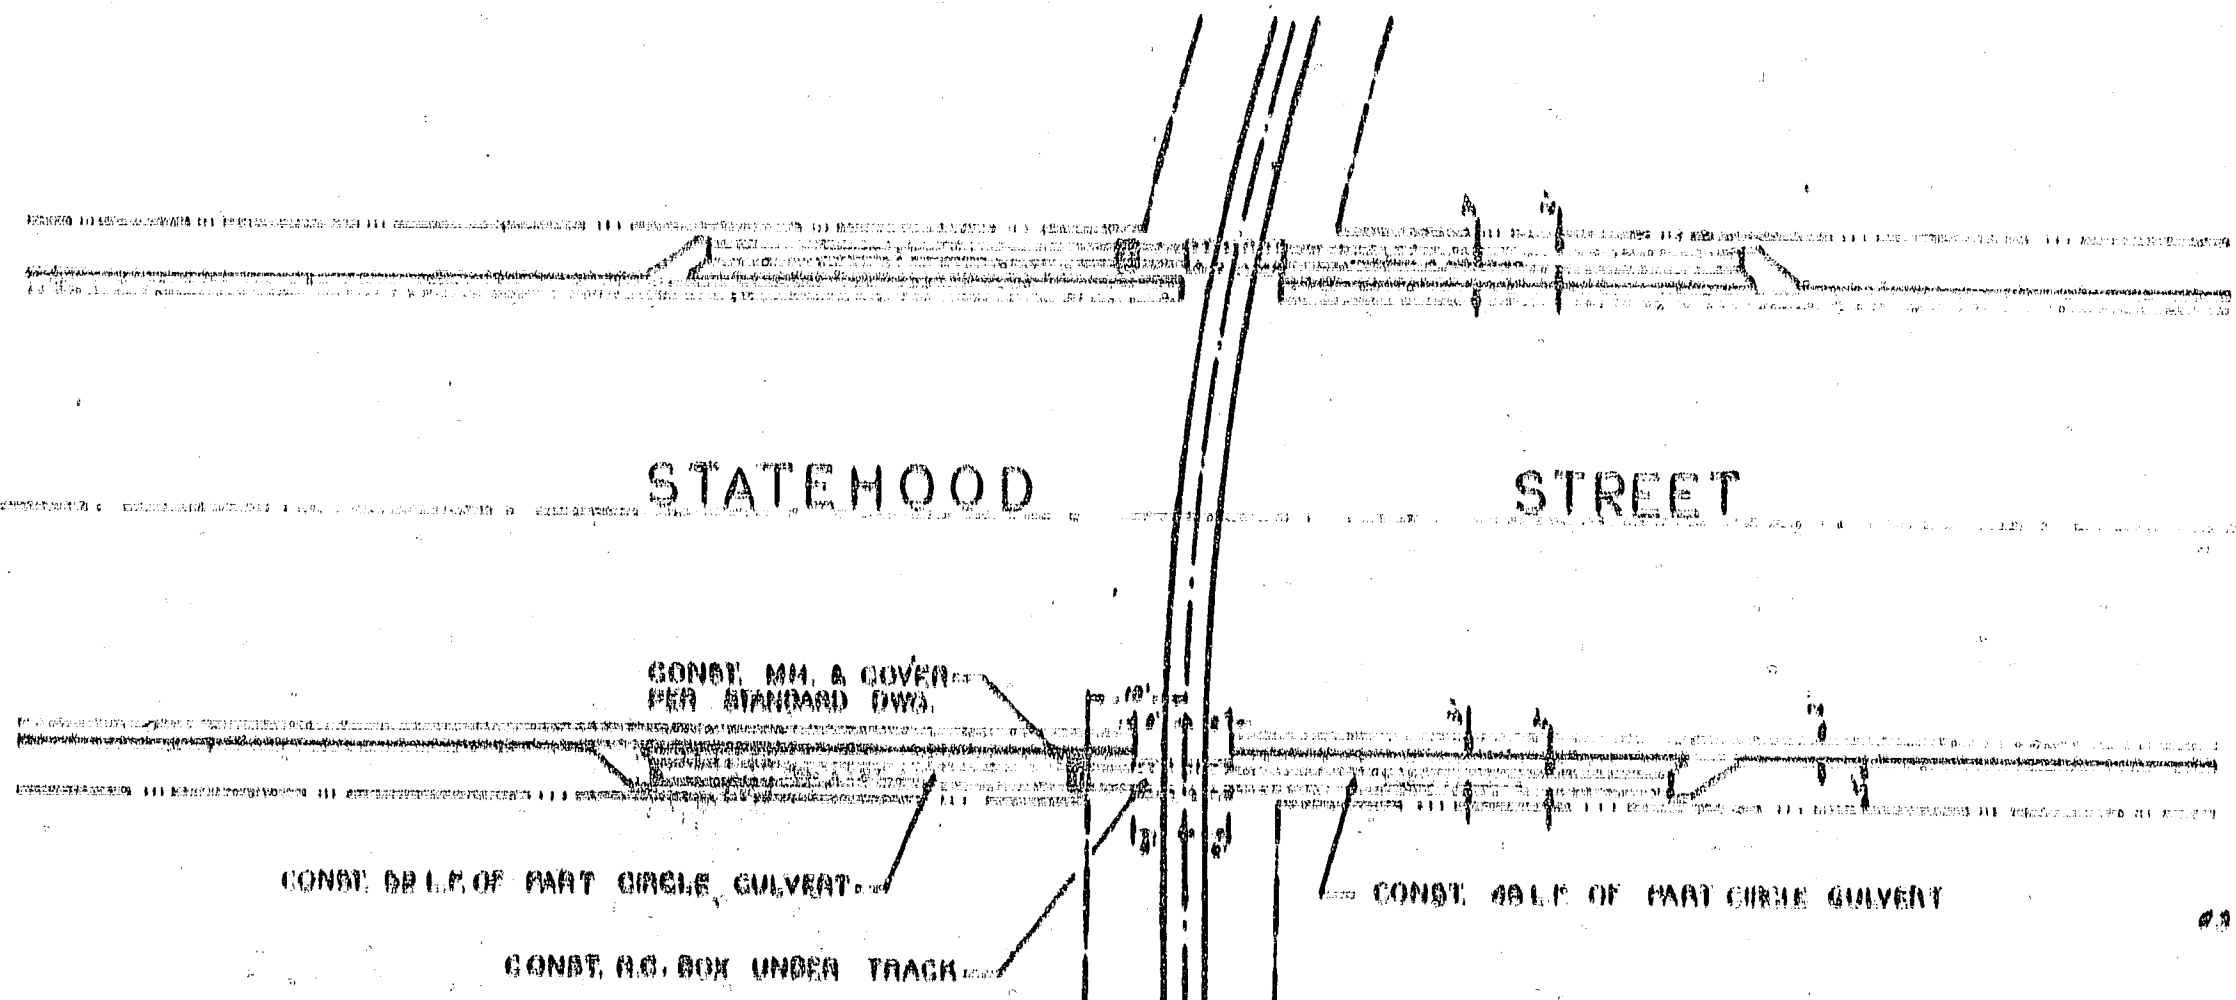
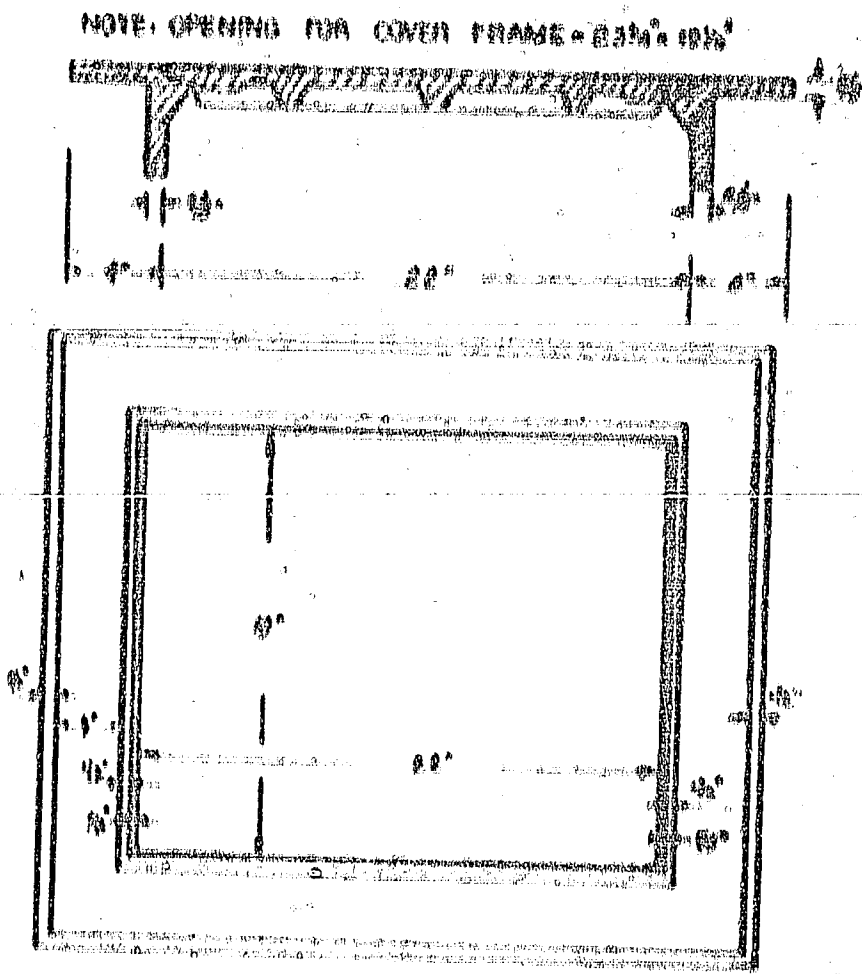
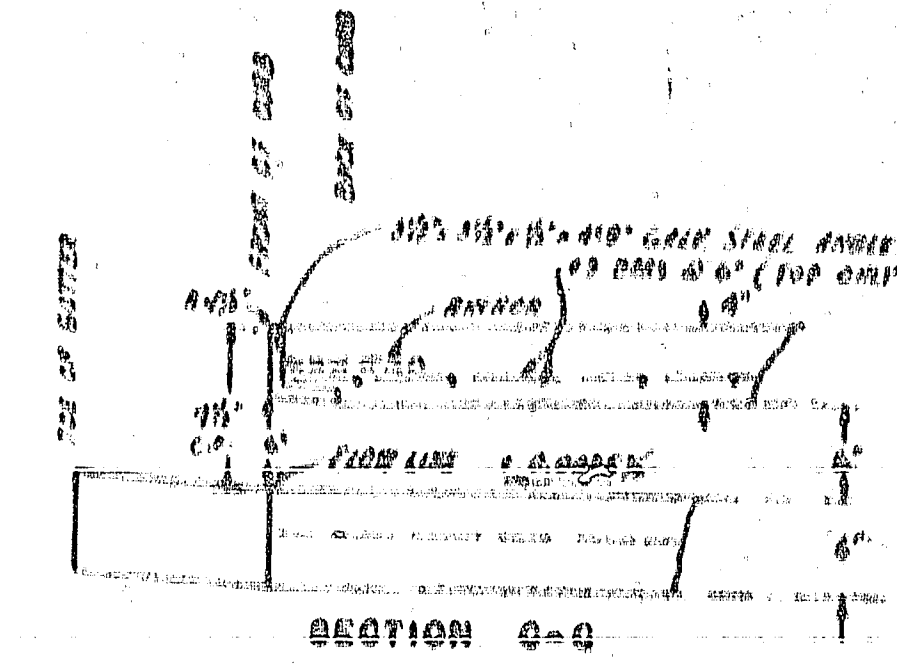


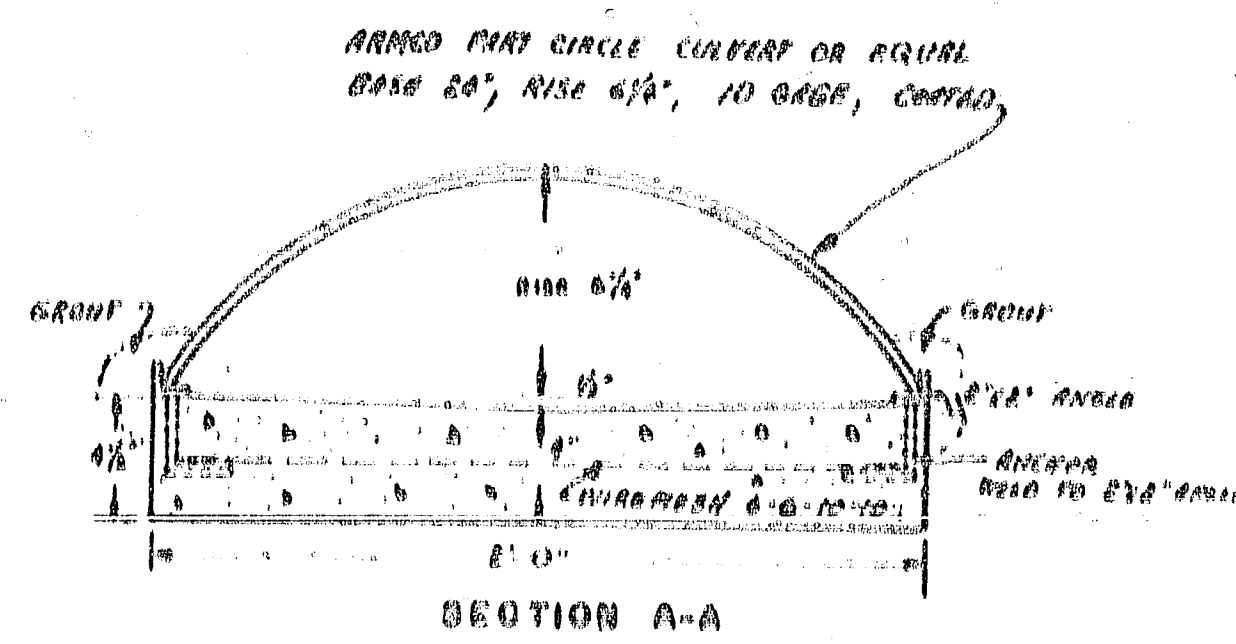

DETAIL OF 2 1/2" ANCHOR BOLT

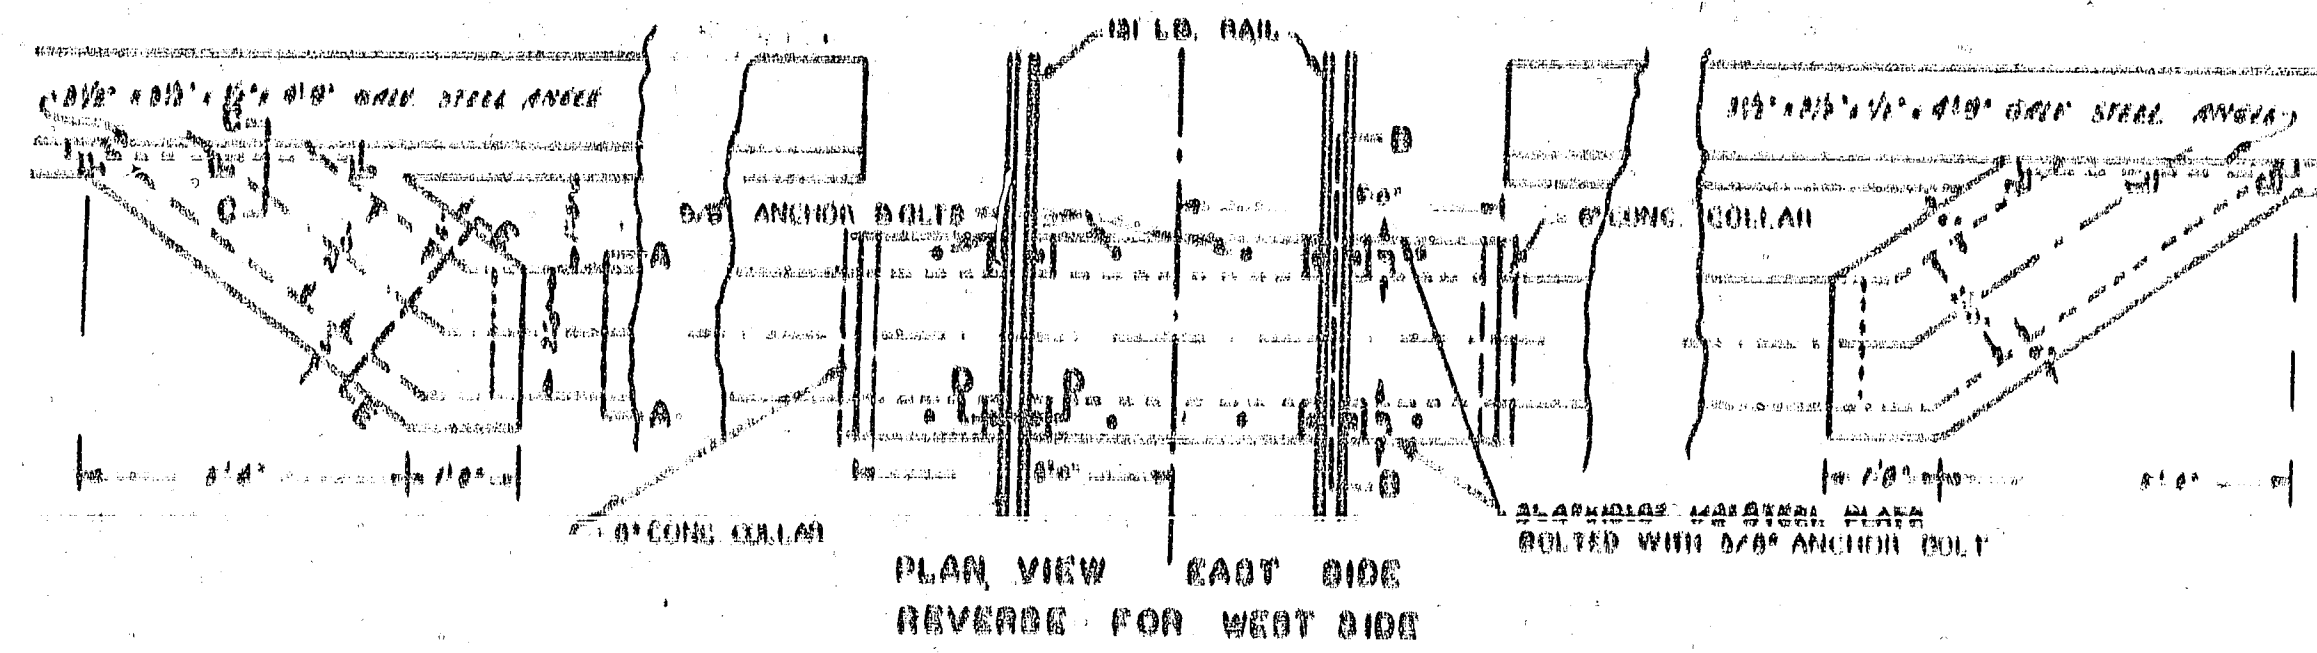

AS BUILT		JULY 21, 1910	
UNION PACIFIC RAILROAD CO.			
CITY OF LAS VEGAS, NEVADA			
ENGINEERING DEPT.			
STATEHOOD STREET RAILROAD			
DESIGNED BY		JULY 21, 1910	
CHECKED BY		JULY 21, 1910	
APPROVED BY		JULY 21, 1910	
V.P.C. 10		107-V799	

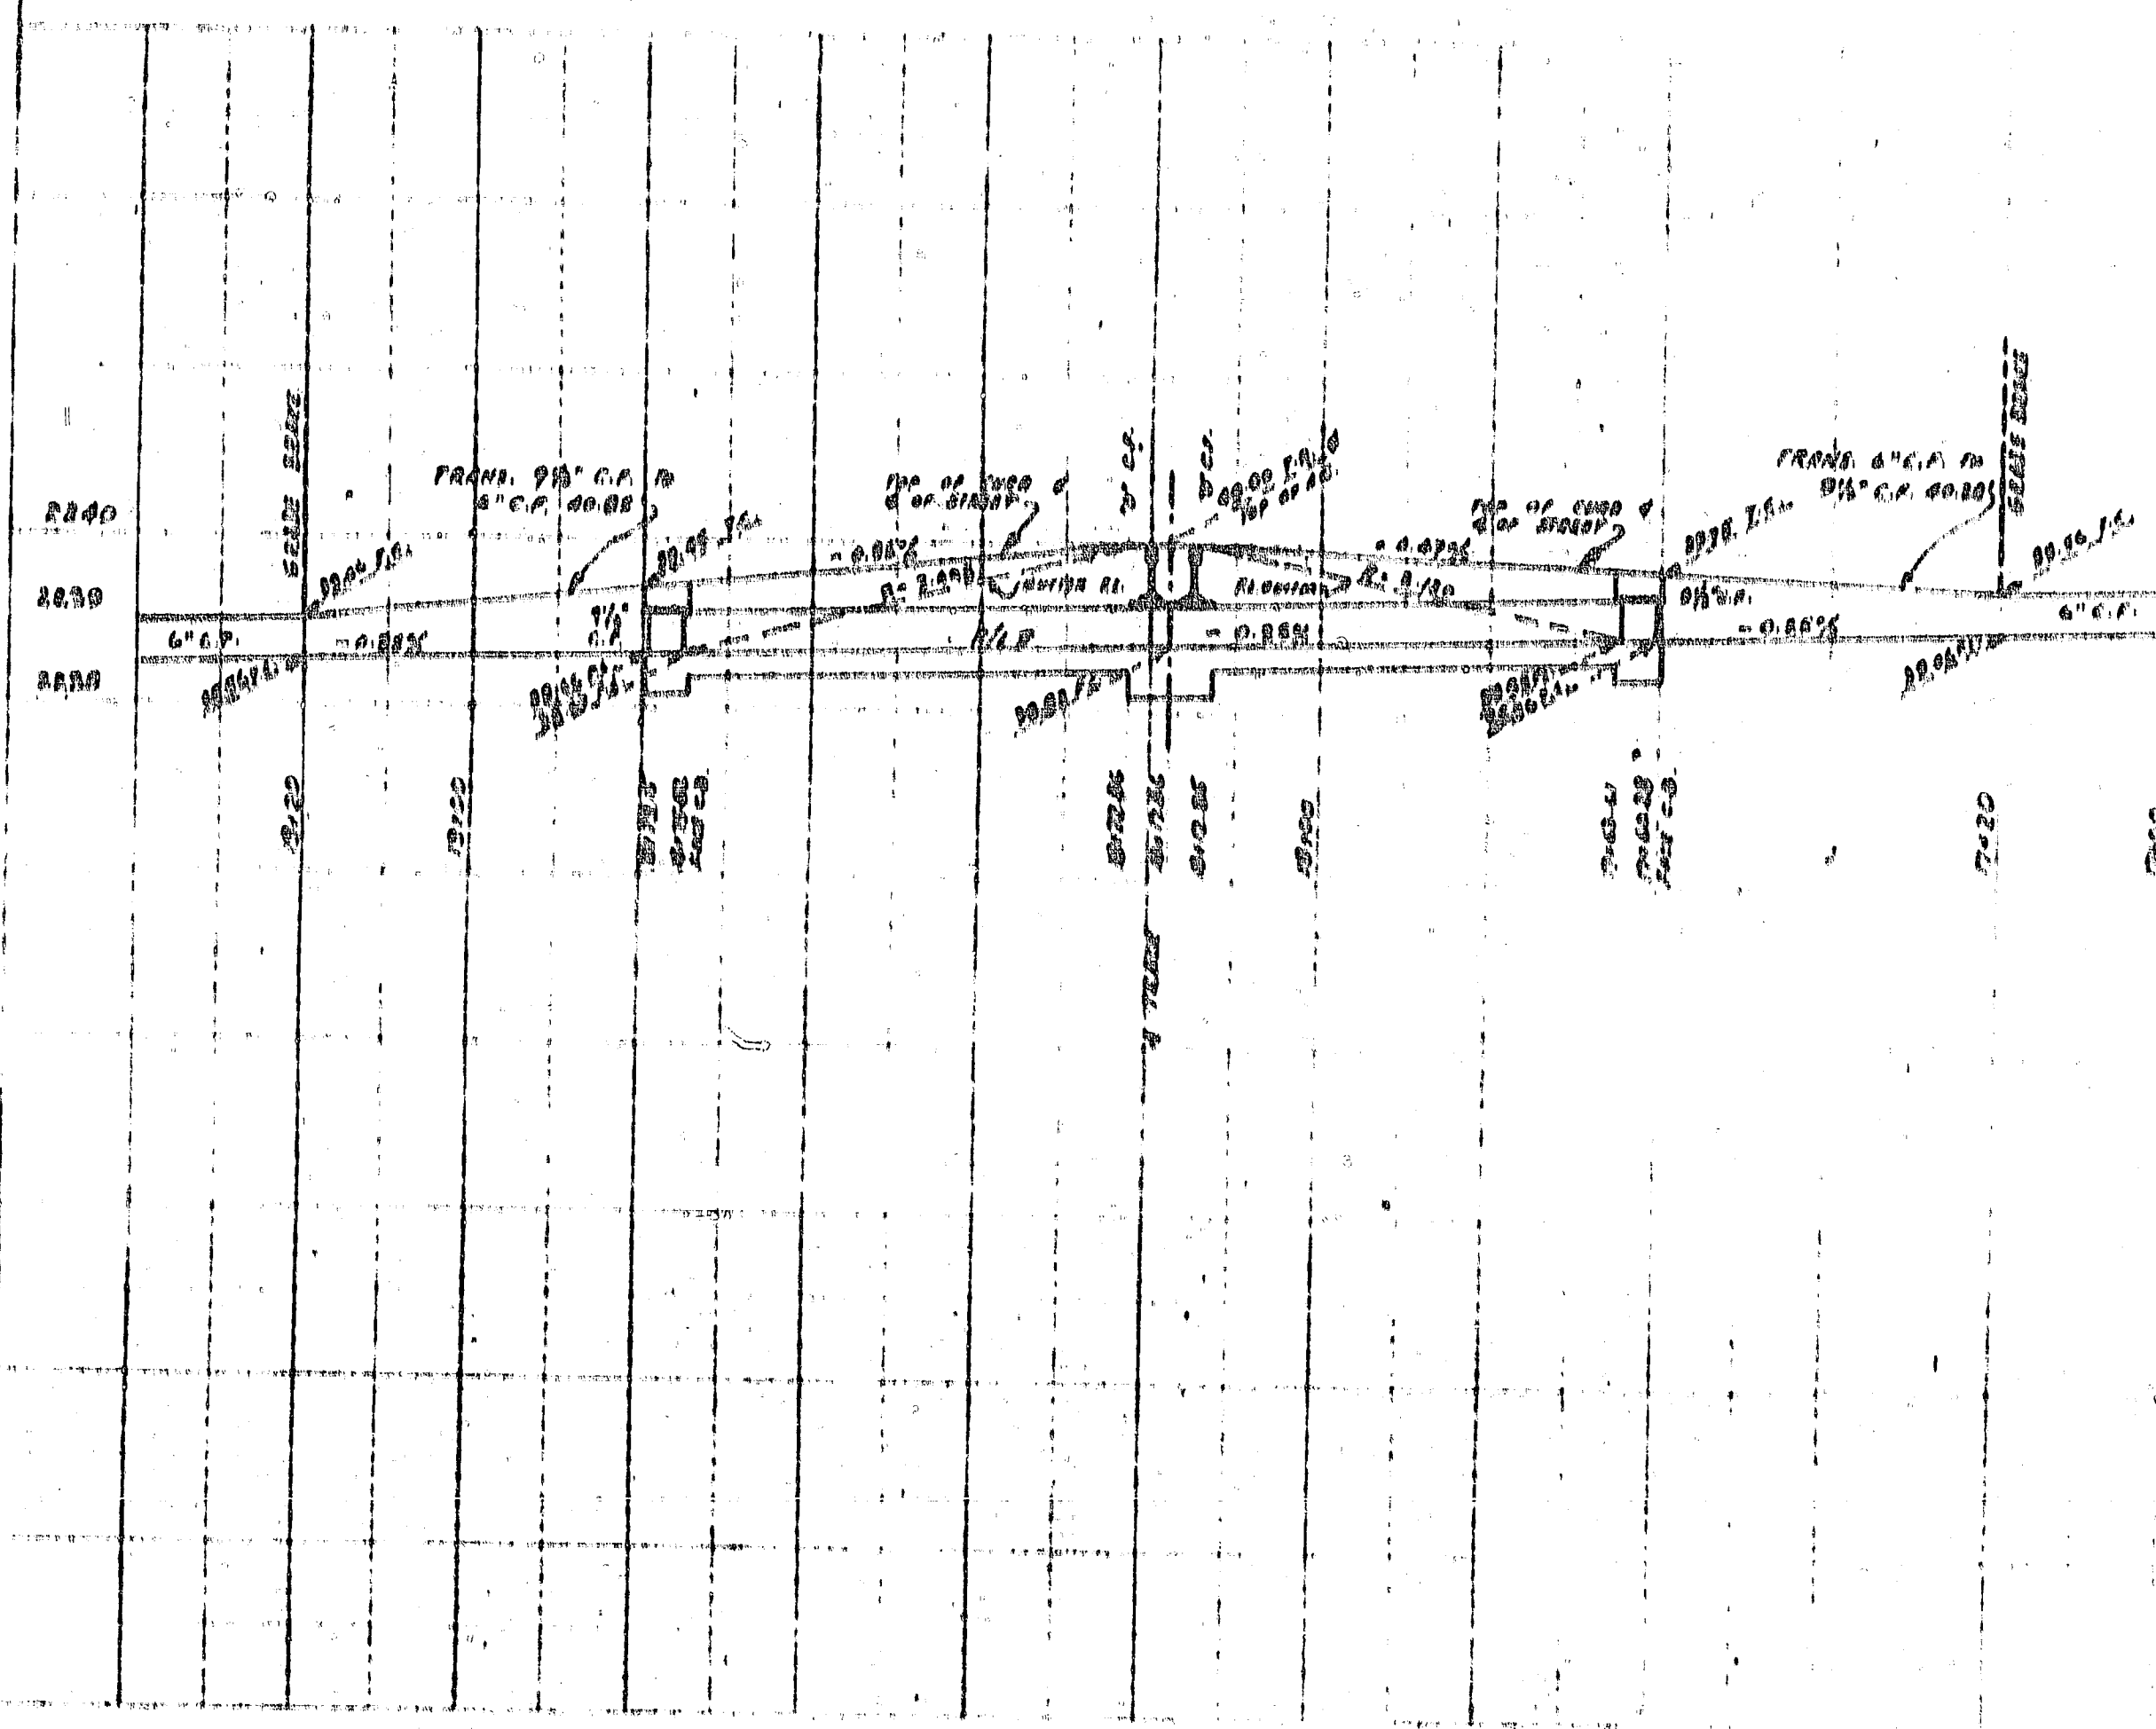